


VICINITY MAP



LEGEND

- Centerline Mileposts
- Updated Proposed Project Route 08/15/2023
- October 17, 2023 Original PSC Application Route
- Section Line
- Avoidance Area
- PEM Wetland
- 200-foot Siting Corridor

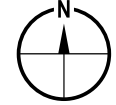

REVISIONS

Date:	2023-08-17	Revised by:	CW	Checked by:	RC
A - Issued for Review					
Date:		Revised by:		Checked by:	
Date:		Revised by:		Checked by:	

PREPARED BY

**Summit Carbon Solutions**  
2321 North Loop Drive, Suite 221  
Ames, Iowa 50010  
United States of America  
[www.summitcarbonsolutions.com](http://www.summitcarbonsolutions.com)




**SUMMIT CARBON**  
SOLUTIONS

PROJECT INFORMATION

Figure Title: <b>ND PSC - Aerial Map Book - NDM-106</b>	
Figure Number: <b>Map Book 1</b>	
Scale: <b>1 : 12,000</b> 1 inch equals 1,000 feet	Projection: <b>Transverse Mercator</b> NAD 1983 UTM Zone 14N
Sheet: <b>1</b> 1 of 139	Drawing Number: <b>1001-01-003</b> Revision A



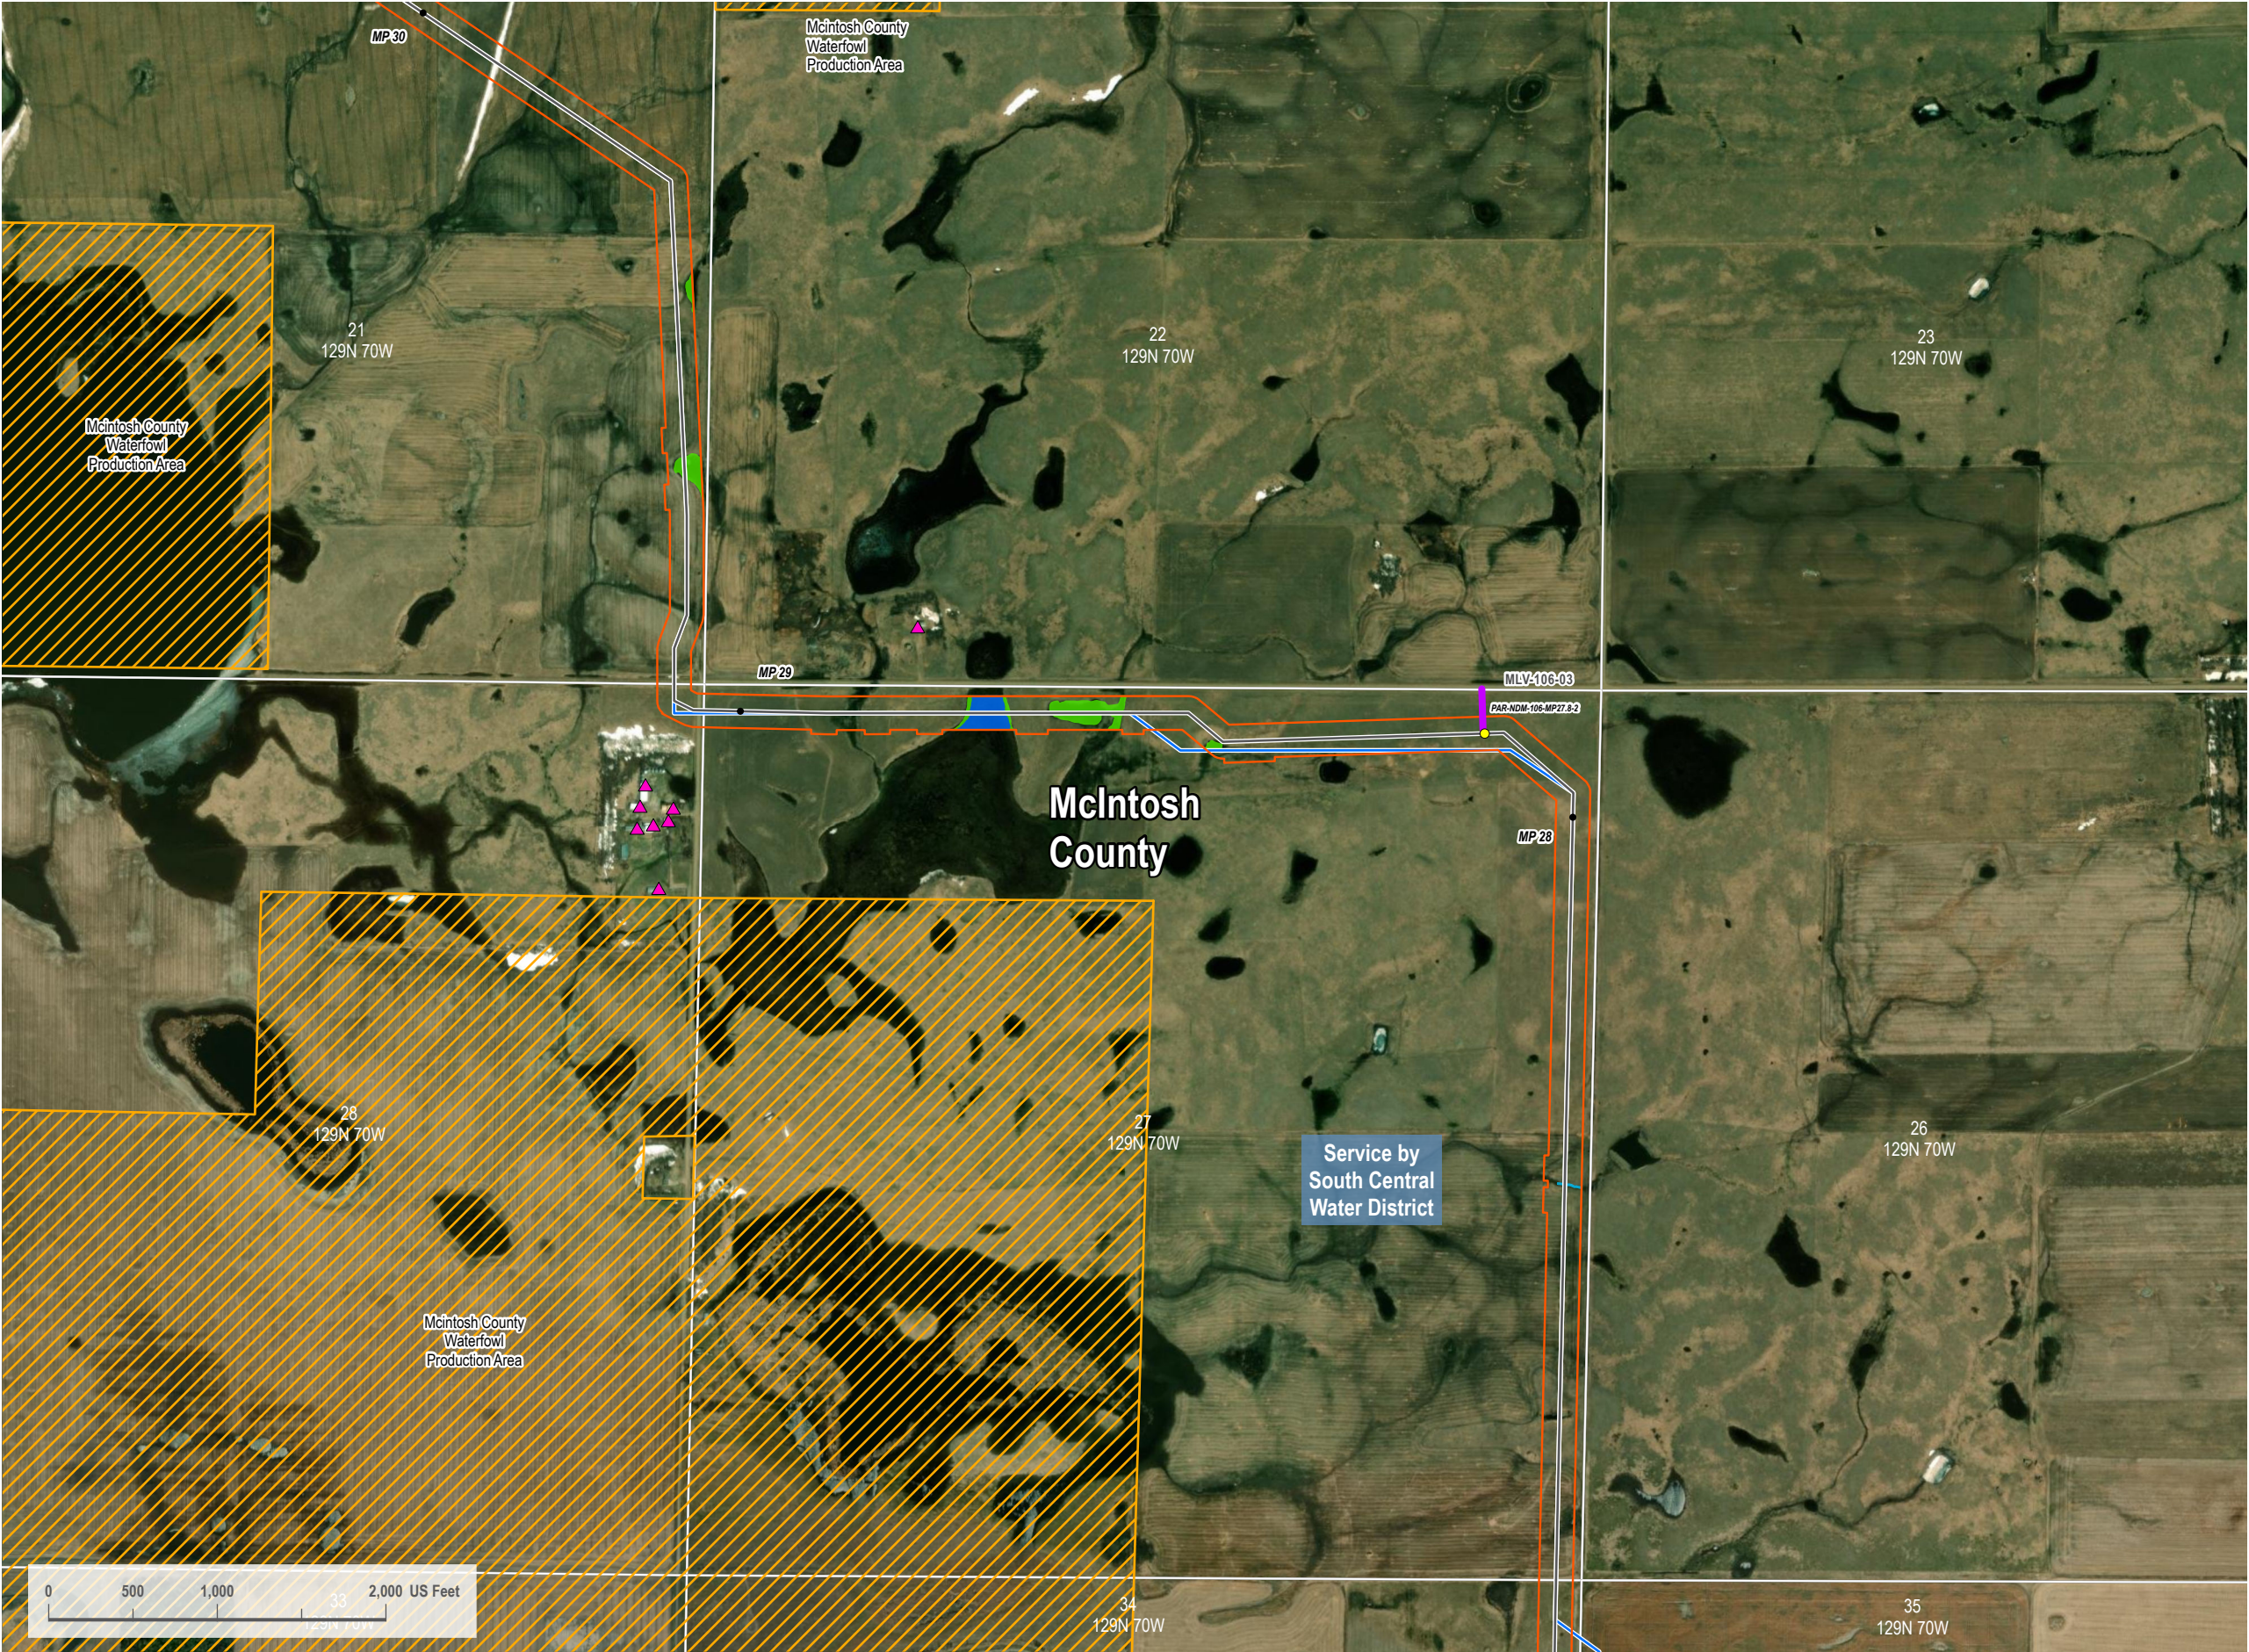

VICINITY MAP



LEGEND

- Centerline Mileposts
- Mainline Valve Location
- Domestic Structure or Business (Avoidance)
- Updated Proposed Project Route 08/15/2023
- October 17, 2023 Original PSC Application Route
- Section Line
- Access Road
- Avoidance Area
- Open Water
- PEM Wetland
- Stream
- 200-foot Siting Corridor



REVISIONS

Date:	2023-08-17	Revised by:	CW	Checked by:	RC
A - Issued for Review					
Date:		Revised by:		Checked by:	
Date:		Revised by:		Checked by:	

PREPARED BY

**Summit Carbon Solutions**  
2321 North Loop Drive, Suite 221  
Ames, Iowa 50010  
United States of America  
[www.summitcarbonsolutions.com](http://www.summitcarbonsolutions.com)




**SUMMIT CARBON**  
SOLUTIONS

PROJECT INFORMATION

Figure Title: <b>ND PSC - Aerial Map Book - NDM-106</b>	
Figure Number: <b>Map Book 1</b>	
Scale: <b>1 : 12,000</b> 1 inch equals 1,000 feet	Projection: <b>Transverse Mercator</b> NAD 1983 UTM Zone 14N
Sheet: <b>2</b> 2 of 139	Drawing Number: <b>1001-01-003</b> Revision A



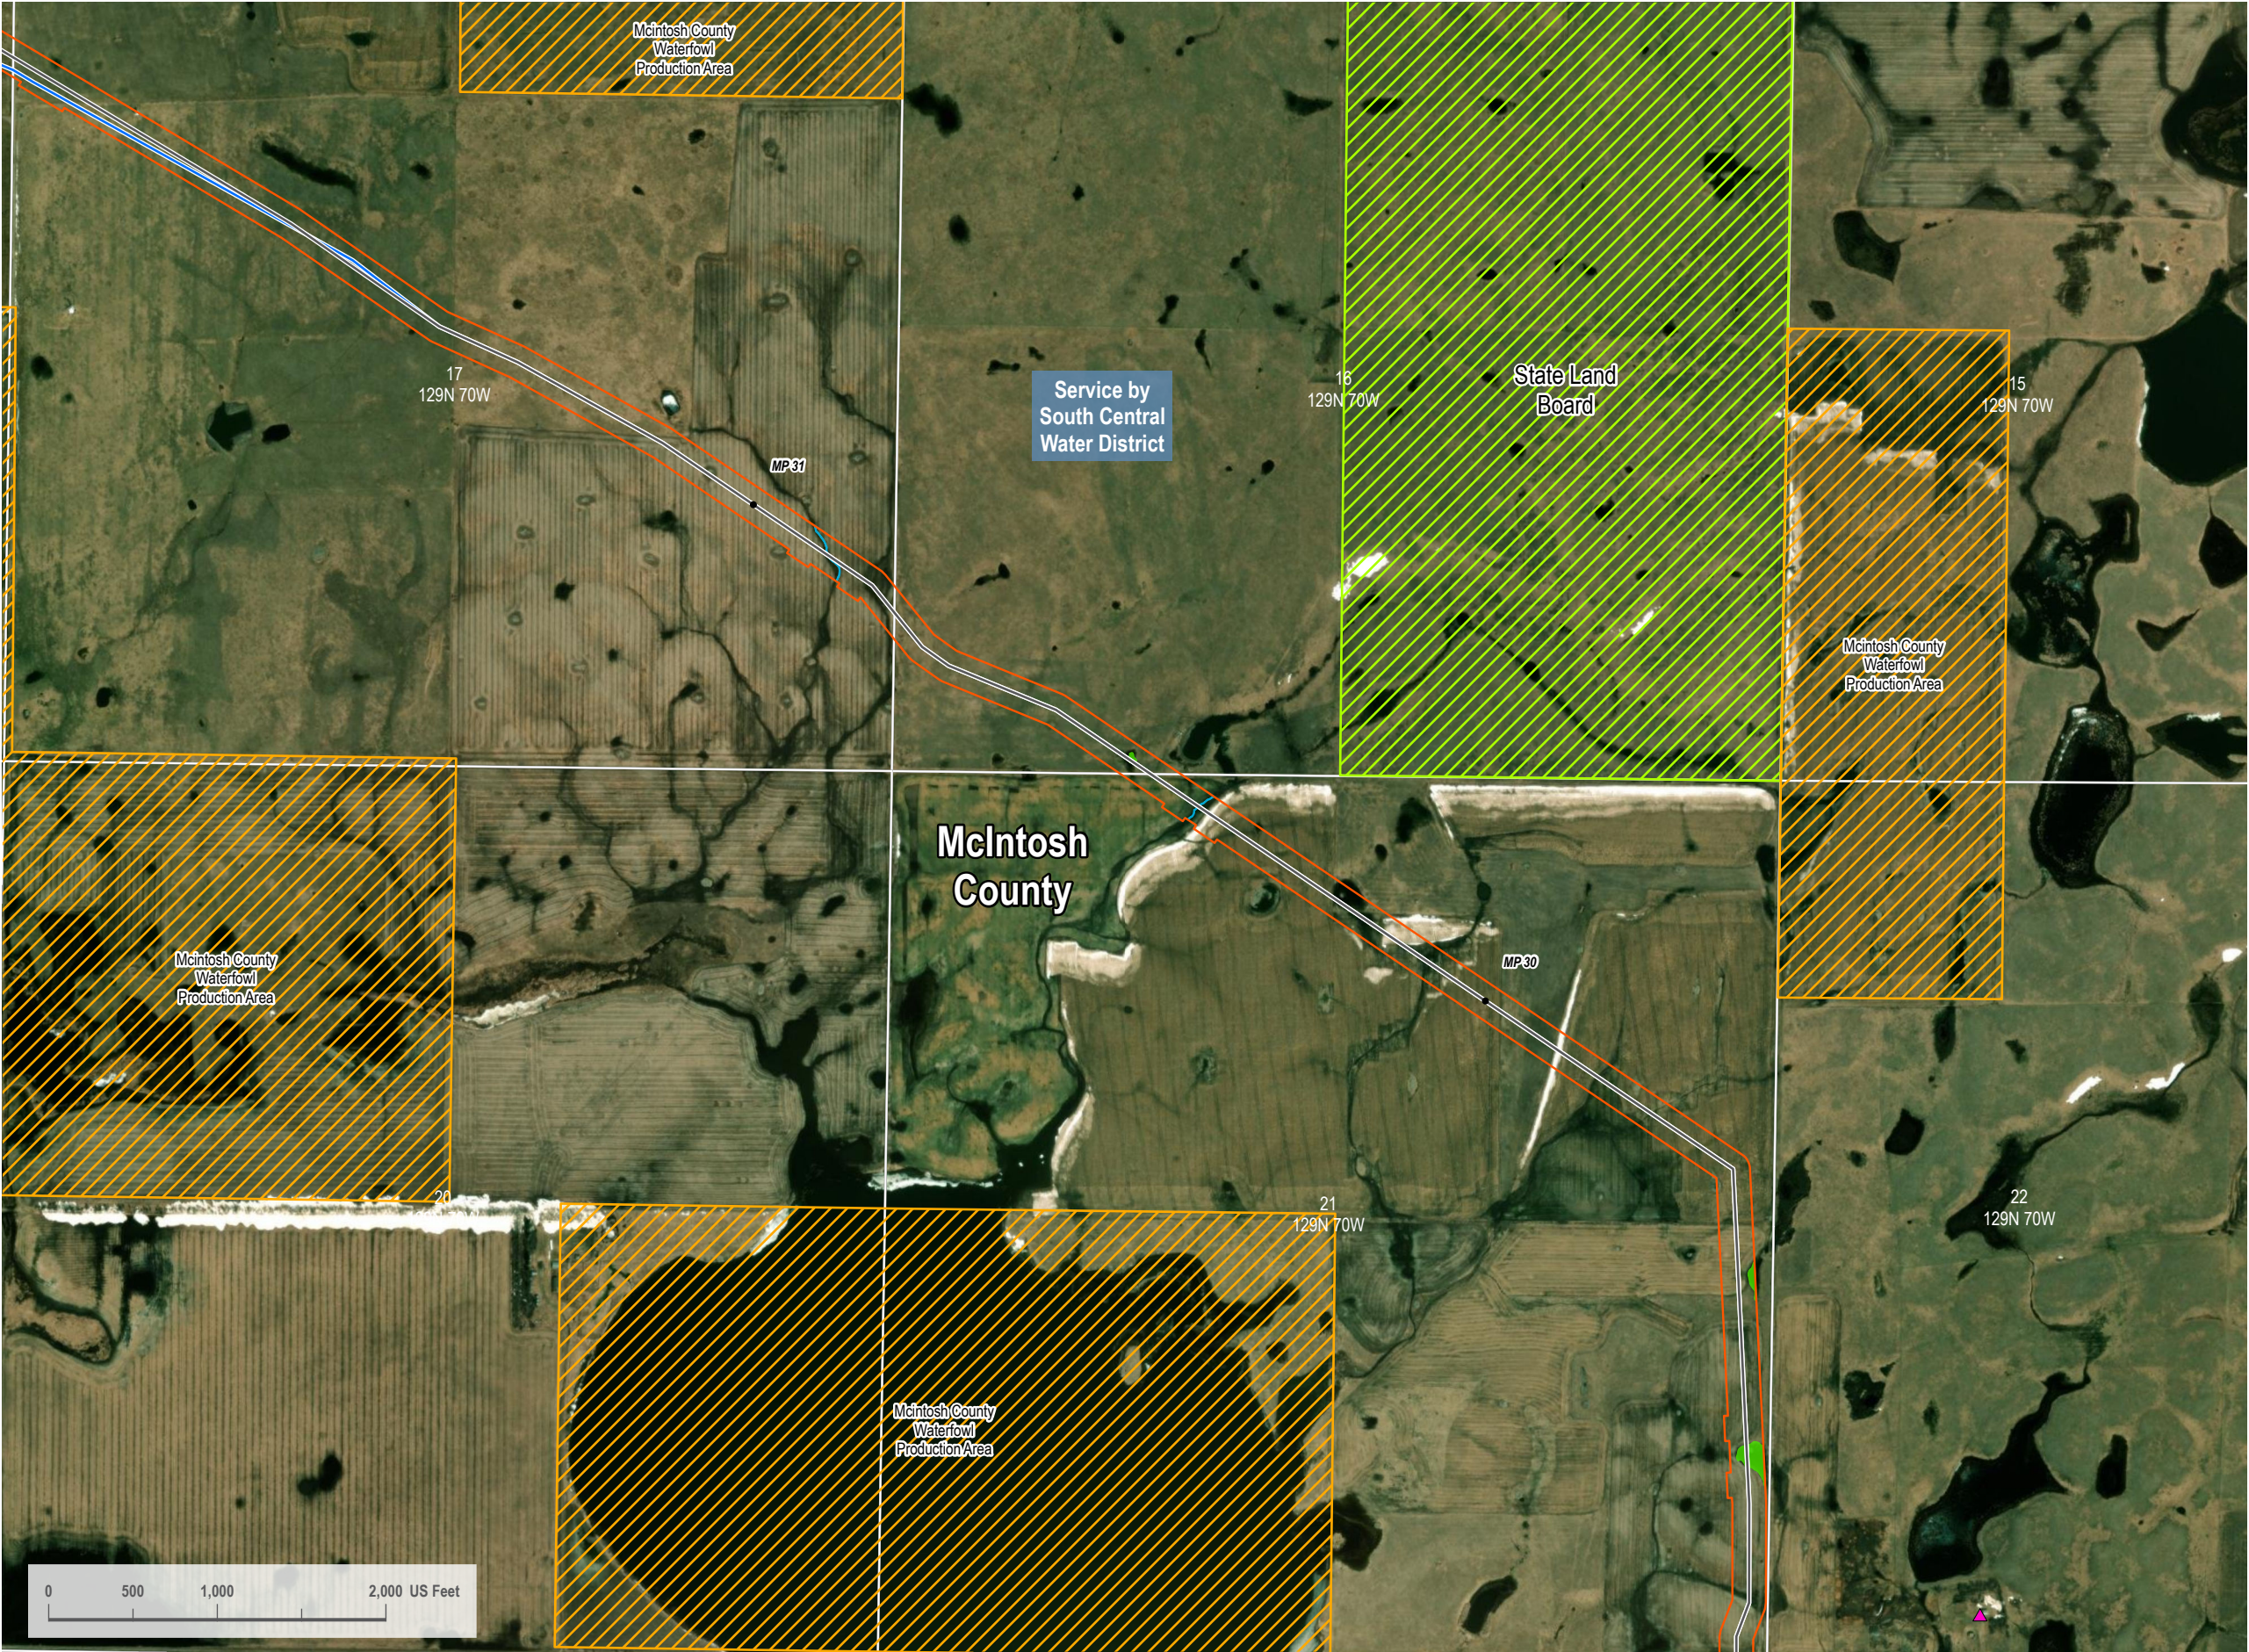

Service by  
South Central  
Water District

State Land  
Board


McIntosh  
County

McIntosh County  
Waterfowl  
Production Area

McIntosh County  
Waterfowl  
Production Area

McIntosh County  
Waterfowl  
Production Area

McIntosh County  
Waterfowl  
Production Area

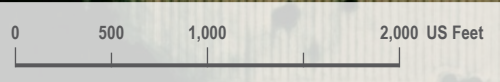

VICINITY MAP



LEGEND

- Centerline Mileposts
- Domestic Structure or Business (Avoidance)
- Updated Proposed Project Route 08/15/2023
- October 17, 2023 Original PSC Application Route
- Section Line
- Avoidance Area
- PEM Wetland
- Stream
- 200-foot Siting Corridor
- State Resource Management Area



REVISIONS

Date: 2023-08-17 Revised by: CW Checked by: RC  
A - Issued for Review

Date: Revised by: Checked by:

Date: Revised by: Checked by:

PREPARED BY

Summit Carbon Solutions  
2321 North Loop Drive, Suite 221  
Ames, Iowa 50010  
United States of America  
www.summitcarbonsolutions.com



PROJECT INFORMATION

Figure Title:  
ND PSC - Aerial Map Book - NDM-106

Figure Number:  
Map Book 1


Scale:  
1 : 12,000  
1 inch equals 1,000 feet

Projection:  
Transverse Mercator  
NAD 1983 UTM Zone 14N

Sheet:  
3  
3 of 139

Drawing Number:  
1001-01-003  
Revision A



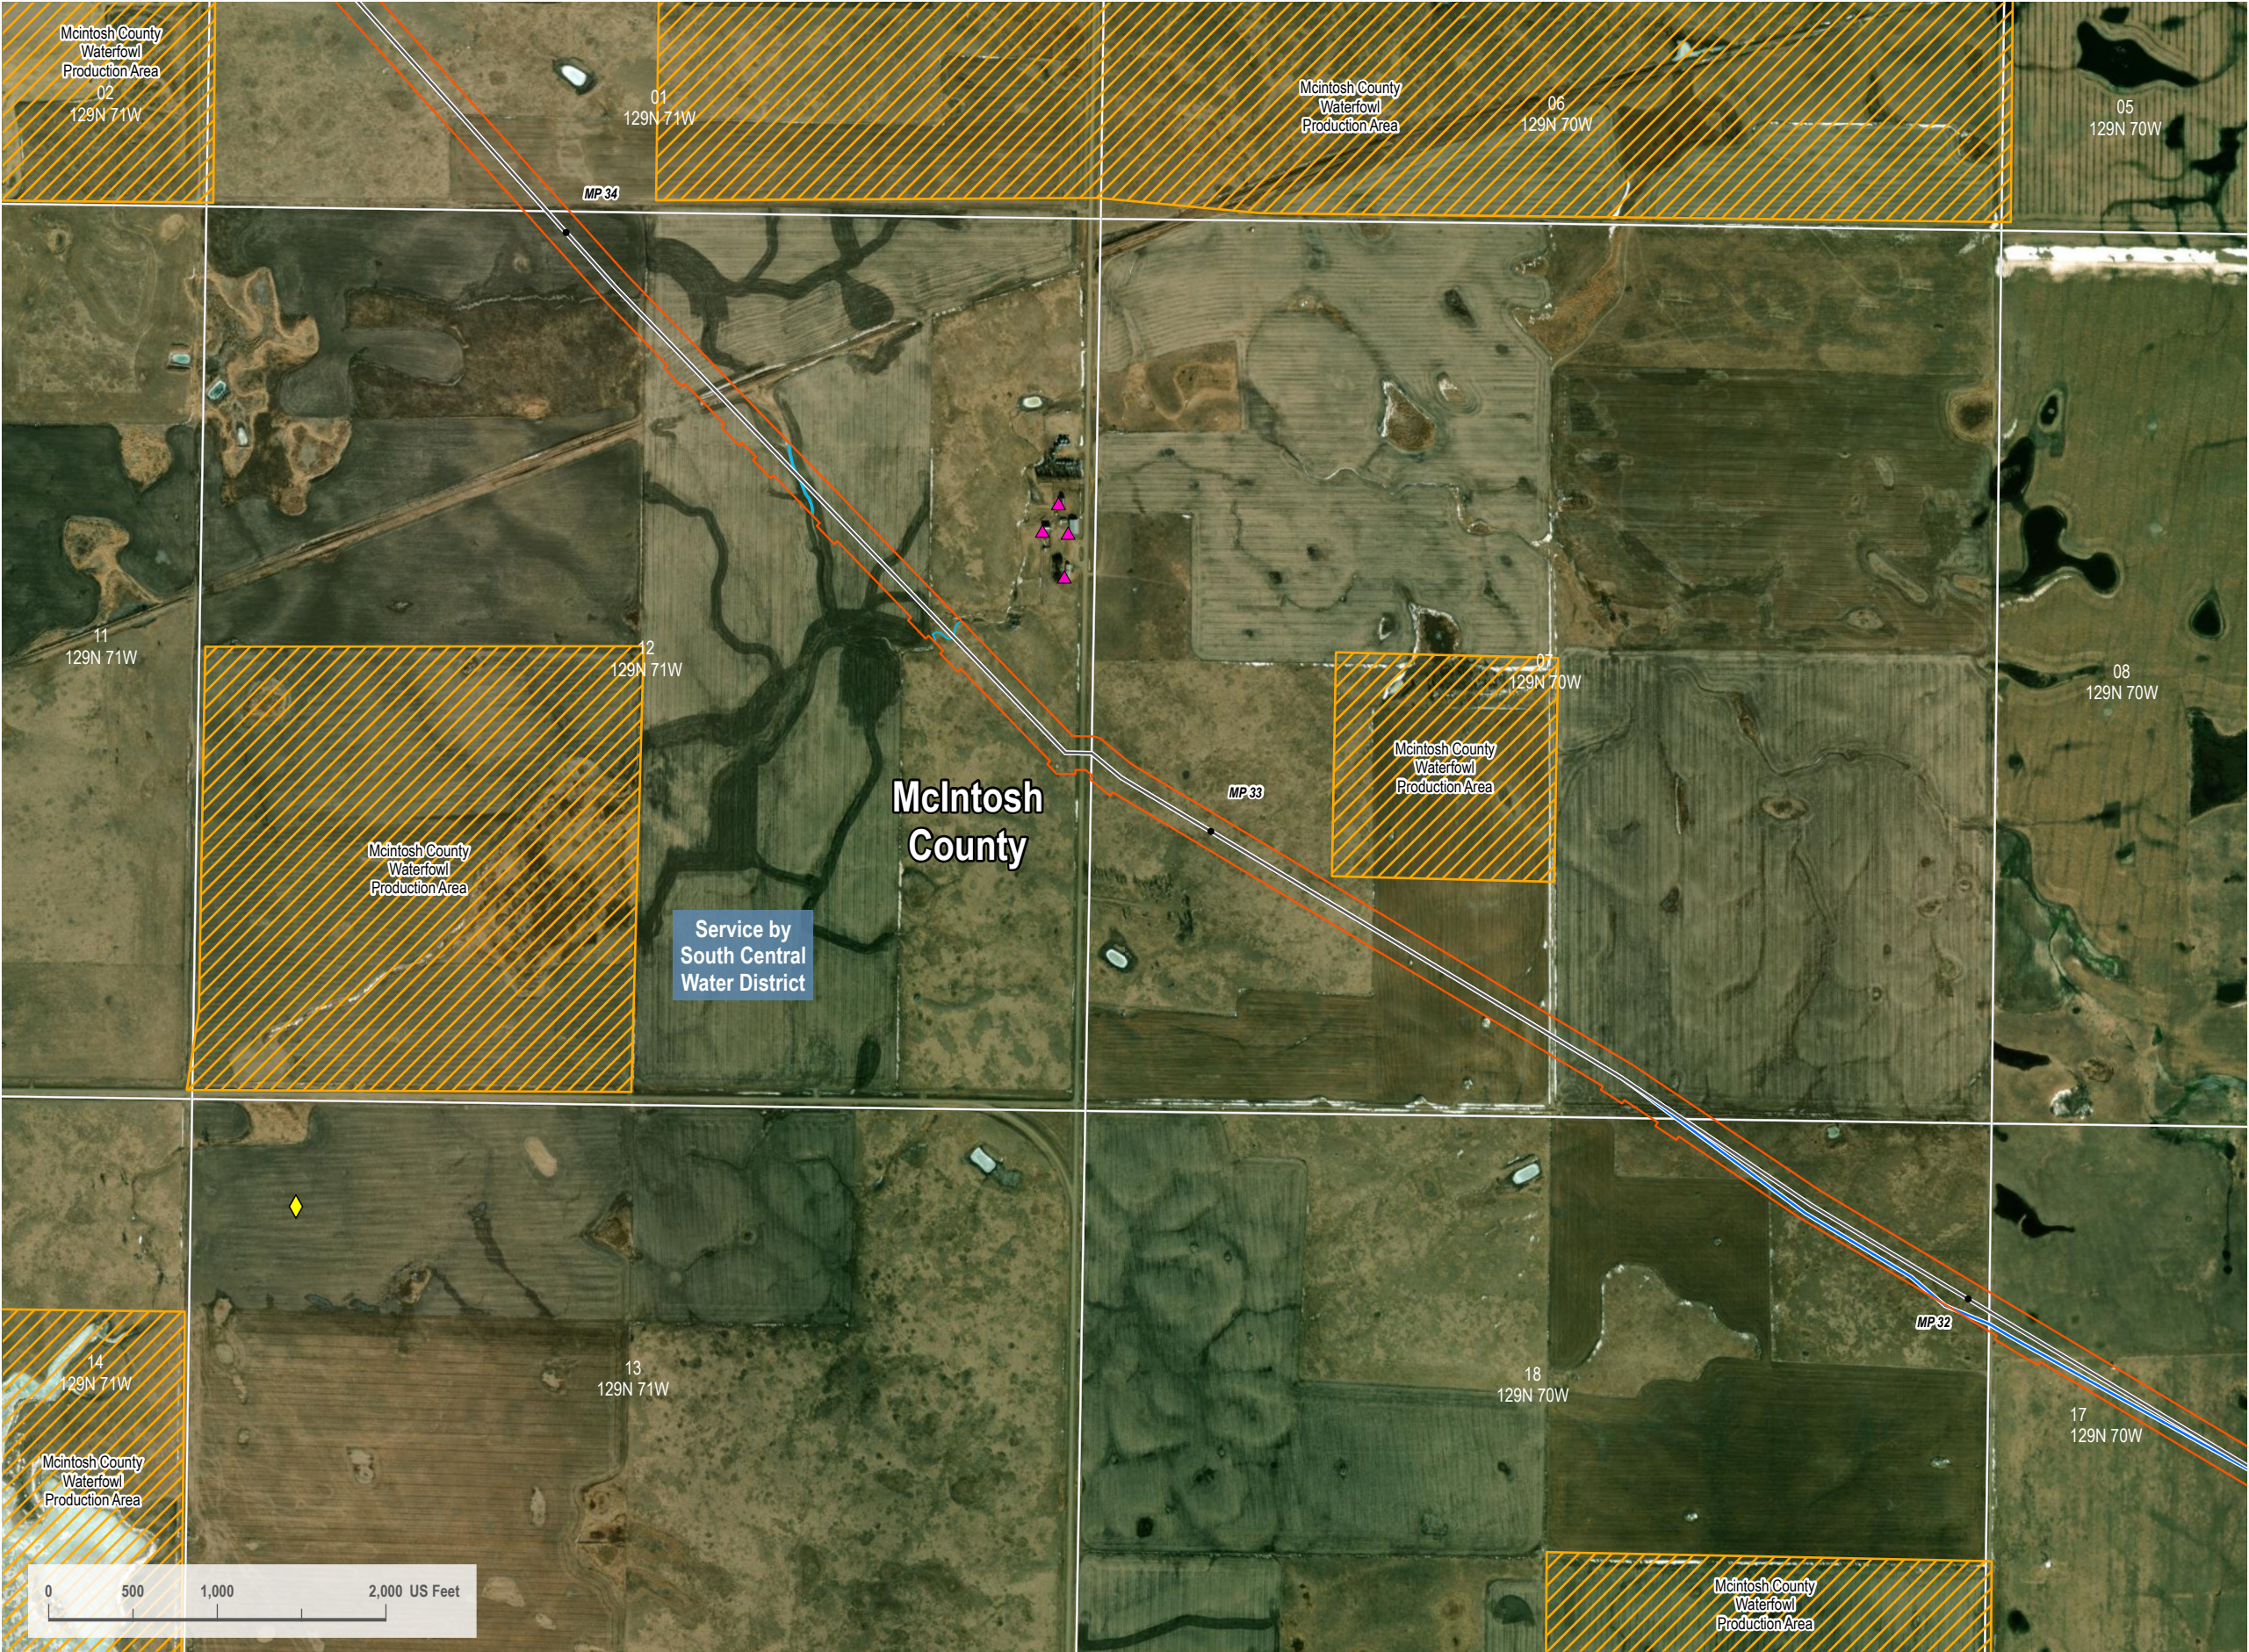

VICINITY MAP



LEGEND

- Centerline Mileposts
- Water Well (Avoidance)
- Domestic Structure or Business (Avoidance)
- Updated Proposed Project Route 08/15/2023
- October 17, 2023 Original PSC Application Route
- Section Line
- Avoidance Area
- Stream
- 200-foot Siting Corridor



REVISIONS

Date: 2023-08-17	Revised by: CW	Checked by: RC
A - Issued for Review		
Date:	Revised by:	Checked by:
Date:	Revised by:	Checked by:

PREPARED BY

**Summit Carbon Solutions**  
2321 North Loop Drive, Suite 221  
Ames, Iowa 50010  
United States of America  
[www.summitcarbonsolutions.com](http://www.summitcarbonsolutions.com)




**SUMMIT CARBON**  
SOLUTIONS

PROJECT INFORMATION

Figure Title: <b>ND PSC - Aerial Map Book - NDM-106</b>	
Figure Number: <b>Map Book 1</b>	
Scale: <b>1 : 12,000</b> 1 inch equals 1,000 feet	Projection: <b>Transverse Mercator</b> NAD 1983 UTM Zone 14N
Sheet: <b>4</b> 4 of 139	Drawing Number: <b>1001-01-003</b> Revision A



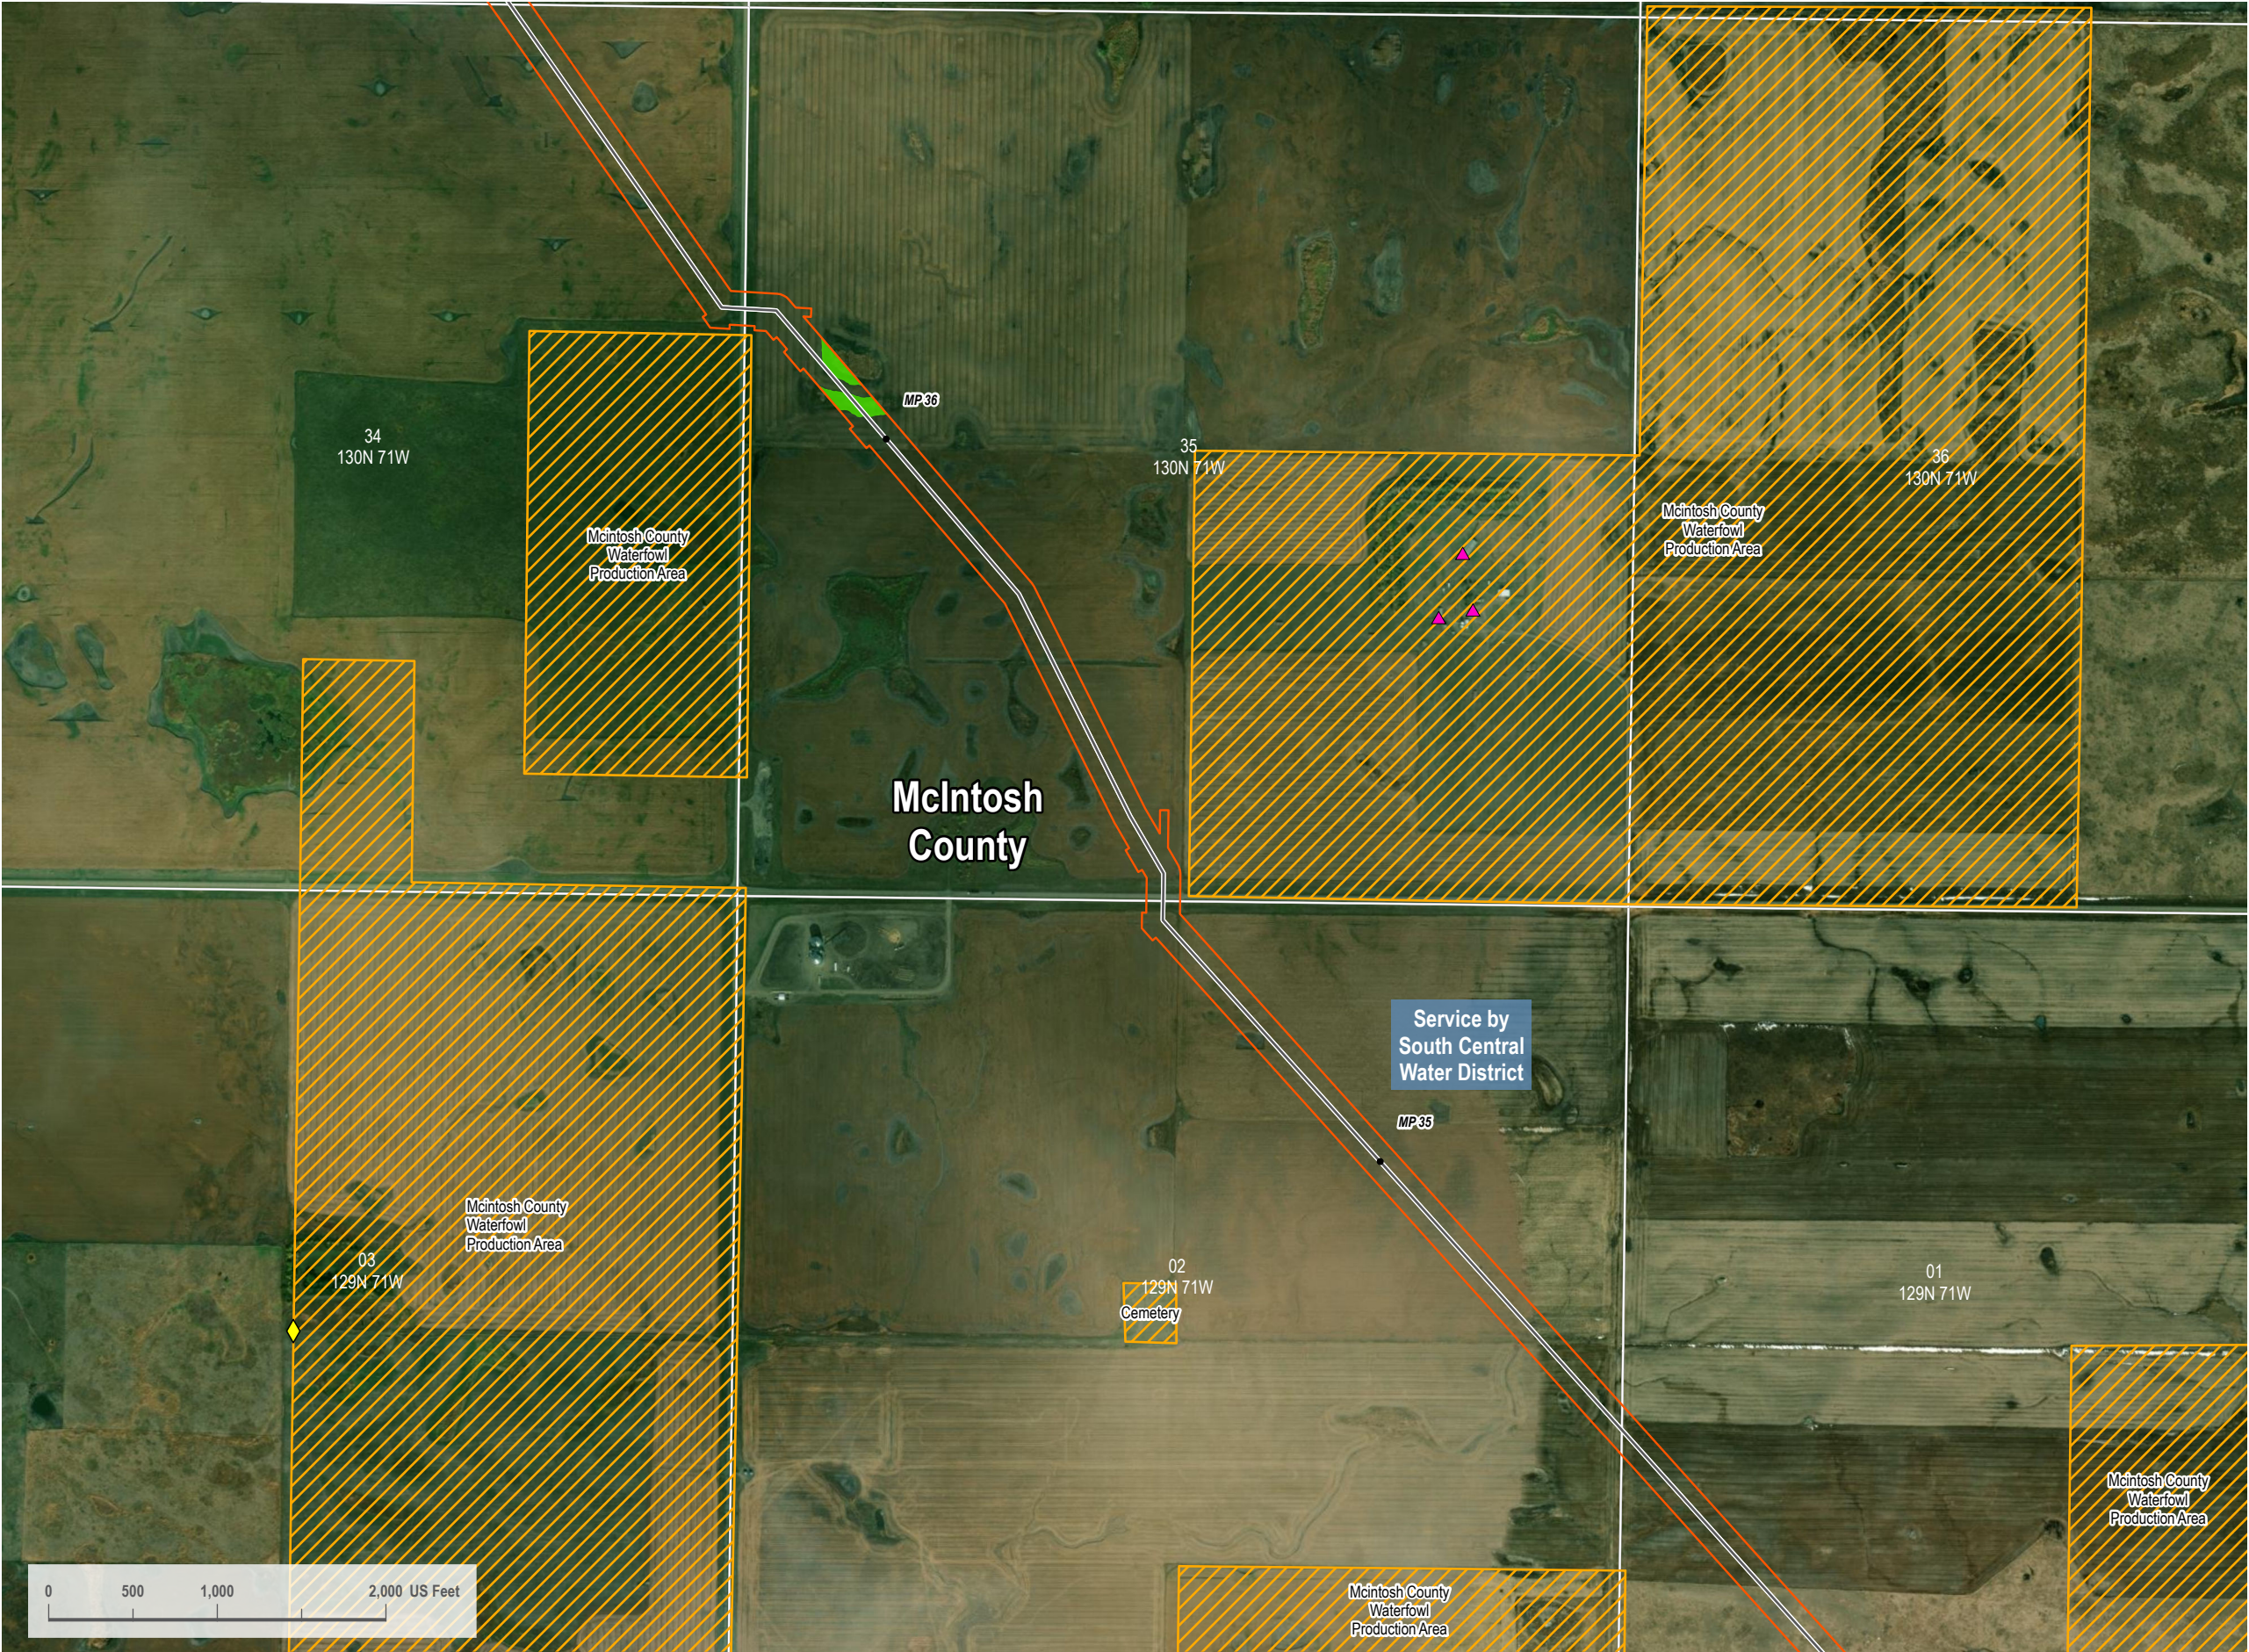

VICINITY MAP



LEGEND

- Centerline Mileposts
- Water Well (Avoidance)
- Domestic Structure or Business (Avoidance)
- Updated Proposed Project Route 08/15/2023
- October 17, 2023 Original PSC Application Route
- Section Line
- Avoidance Area
- PEM Wetland
- 200-foot Siting Corridor



REVISIONS

Date:	2023-08-17	Revised by:	CW	Checked by:	RC
A - Issued for Review					
Date:		Revised by:		Checked by:	
Date:		Revised by:		Checked by:	

PREPARED BY

**Summit Carbon Solutions**  
2321 North Loop Drive, Suite 221  
Ames, Iowa 50010  
United States of America  
[www.summitcarbonsolutions.com](http://www.summitcarbonsolutions.com)



**SUMMIT CARBON**  
SOLUTIONS

PROJECT INFORMATION

Figure Title: <b>ND PSC - Aerial Map Book - NDM-106</b>	
Figure Number: <b>Map Book 1</b>	
Scale: <b>1 : 12,000</b> 1 inch equals 1,000 feet	Projection: <b>Transverse Mercator</b> NAD 1983 UTM Zone 14N
Sheet: <b>5</b> 5 of 139	Drawing Number: <b>1001-01-003</b> Revision A





VICINITY MAP



LEGEND

- Centerline Mileposts
- Updated Proposed Project Route 08/15/2023
- October 17, 2023 Original PSC Application Route
- Section Line
- Avoidance Area
- Open Water
- PEM Wetland
- Stream
- 200-foot Stiling Corridor



REVISIONS

Date: 2023-08-17 Revised by: CW Checked by: RC  
A - Issued for Review

Date: Revised by: Checked by:

Date: Revised by: Checked by:

PREPARED BY

**Summit Carbon Solutions**  
2321 North Loop Drive, Suite 221  
Ames, Iowa 50010  
United States of America  
www.summitcarbonsolutions.com



**SUMMIT CARBON SOLUTIONS**

PROJECT INFORMATION

Figure Title:  
ND PSC - Aerial Map Book - NDM-106

Figure Number:  
Map Book 1


Scale:  
1 : 12,000  
1 inch equals 1,000 feet

Projection:  
Transverse Mercator  
NAD 1983 UTM Zone 14N

Sheet:  
6  
6 of 139

Drawing Number:  
1001-01-003  
Revision A



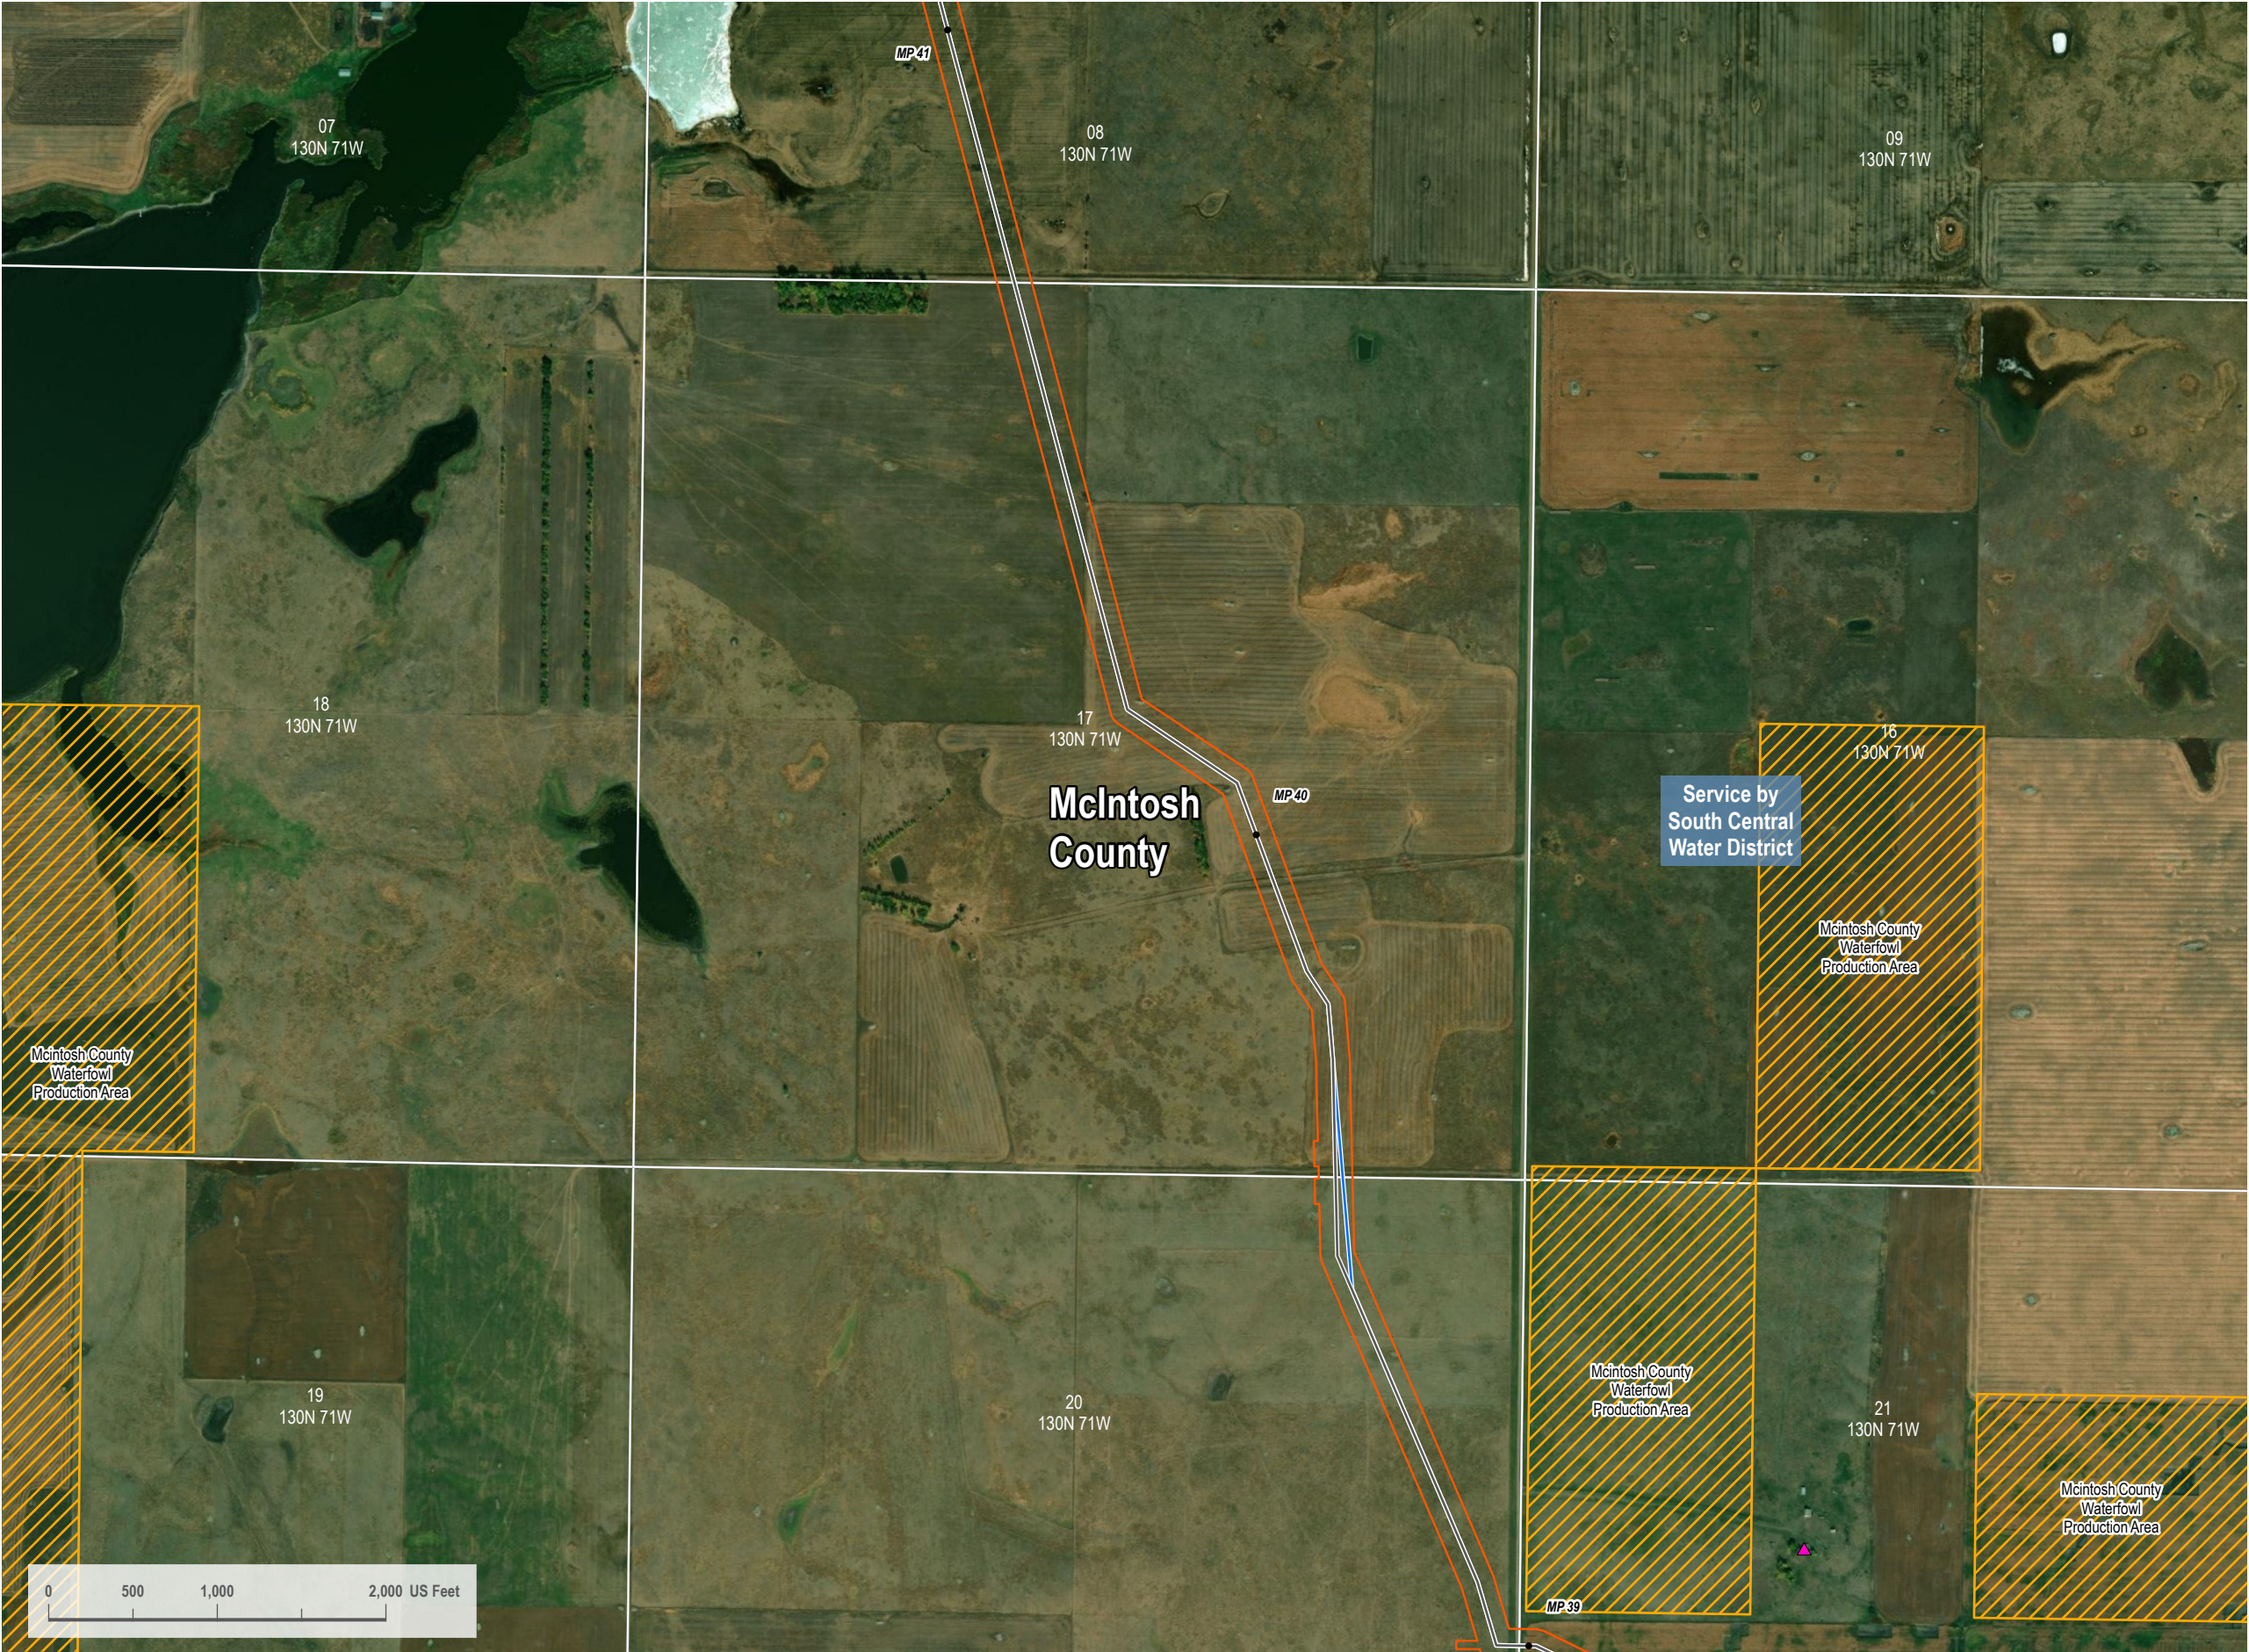

VICINITY MAP



LEGEND

- Centerline Mileposts
- Domestic Structure or Business (Avoidance)
- Updated Proposed Project Route 08/15/2023
- October 17, 2023 Original PSC Application Route
- Section Line
- Avoidance Area
- 200-foot Siting Corridor



REVISIONS

Date:	2023-08-17	Revised by:	CW	Checked by:	RC
A - Issued for Review					
Date:		Revised by:		Checked by:	
Date:		Revised by:		Checked by:	

PREPARED BY

**Summit Carbon Solutions**  
2321 North Loop Drive, Suite 221  
Ames, Iowa 50010  
United States of America  
[www.summitcarbonsolutions.com](http://www.summitcarbonsolutions.com)



**SUMMIT CARBON**  
SOLUTIONS

PROJECT INFORMATION

Figure Title: <b>ND PSC - Aerial Map Book - NDM-106</b>	
Figure Number: <b>Map Book 1</b>	
Scale: <b>1 : 12,000</b> 1 inch equals 1,000 feet	Projection: <b>Transverse Mercator</b> NAD 1983 UTM Zone 14N
Sheet: <b>7</b> 7 of 139	Drawing Number: <b>1001-01-003</b> Revision A





VICINITY MAP



LEGEND

- Centerline Mileposts
- Domestic Structure or Business (Avoidance)
- Updated Proposed Project Route 08/15/2023
- October 17, 2023 Original PSC Application Route
- Section Line
- Avoidance Area
- 200-foot Siting Corridor



REVISIONS

Date:	2023-08-17	Revised by:	CW	Checked by:	RC
A - Issued for Review					
Date:		Revised by:		Checked by:	
Date:		Revised by:		Checked by:	

PREPARED BY

**Summit Carbon Solutions**  
2321 North Loop Drive, Suite 221  
Ames, Iowa 50010  
United States of America  
[www.summitcarbonsolutions.com](http://www.summitcarbonsolutions.com)




**SUMMIT CARBON**  
SOLUTIONS

PROJECT INFORMATION

Figure Title: <b>ND PSC - Aerial Map Book - NDM-106</b>	
Figure Number: <b>Map Book 1</b>	
Scale: <b>1 : 12,000</b> 1 inch equals 1,000 feet	Projection: <b>Transverse Mercator</b> NAD 1983 UTM Zone 14N
Sheet: <b>8</b> 8 of 139	Drawing Number: <b>1001-01-003</b> Revision A



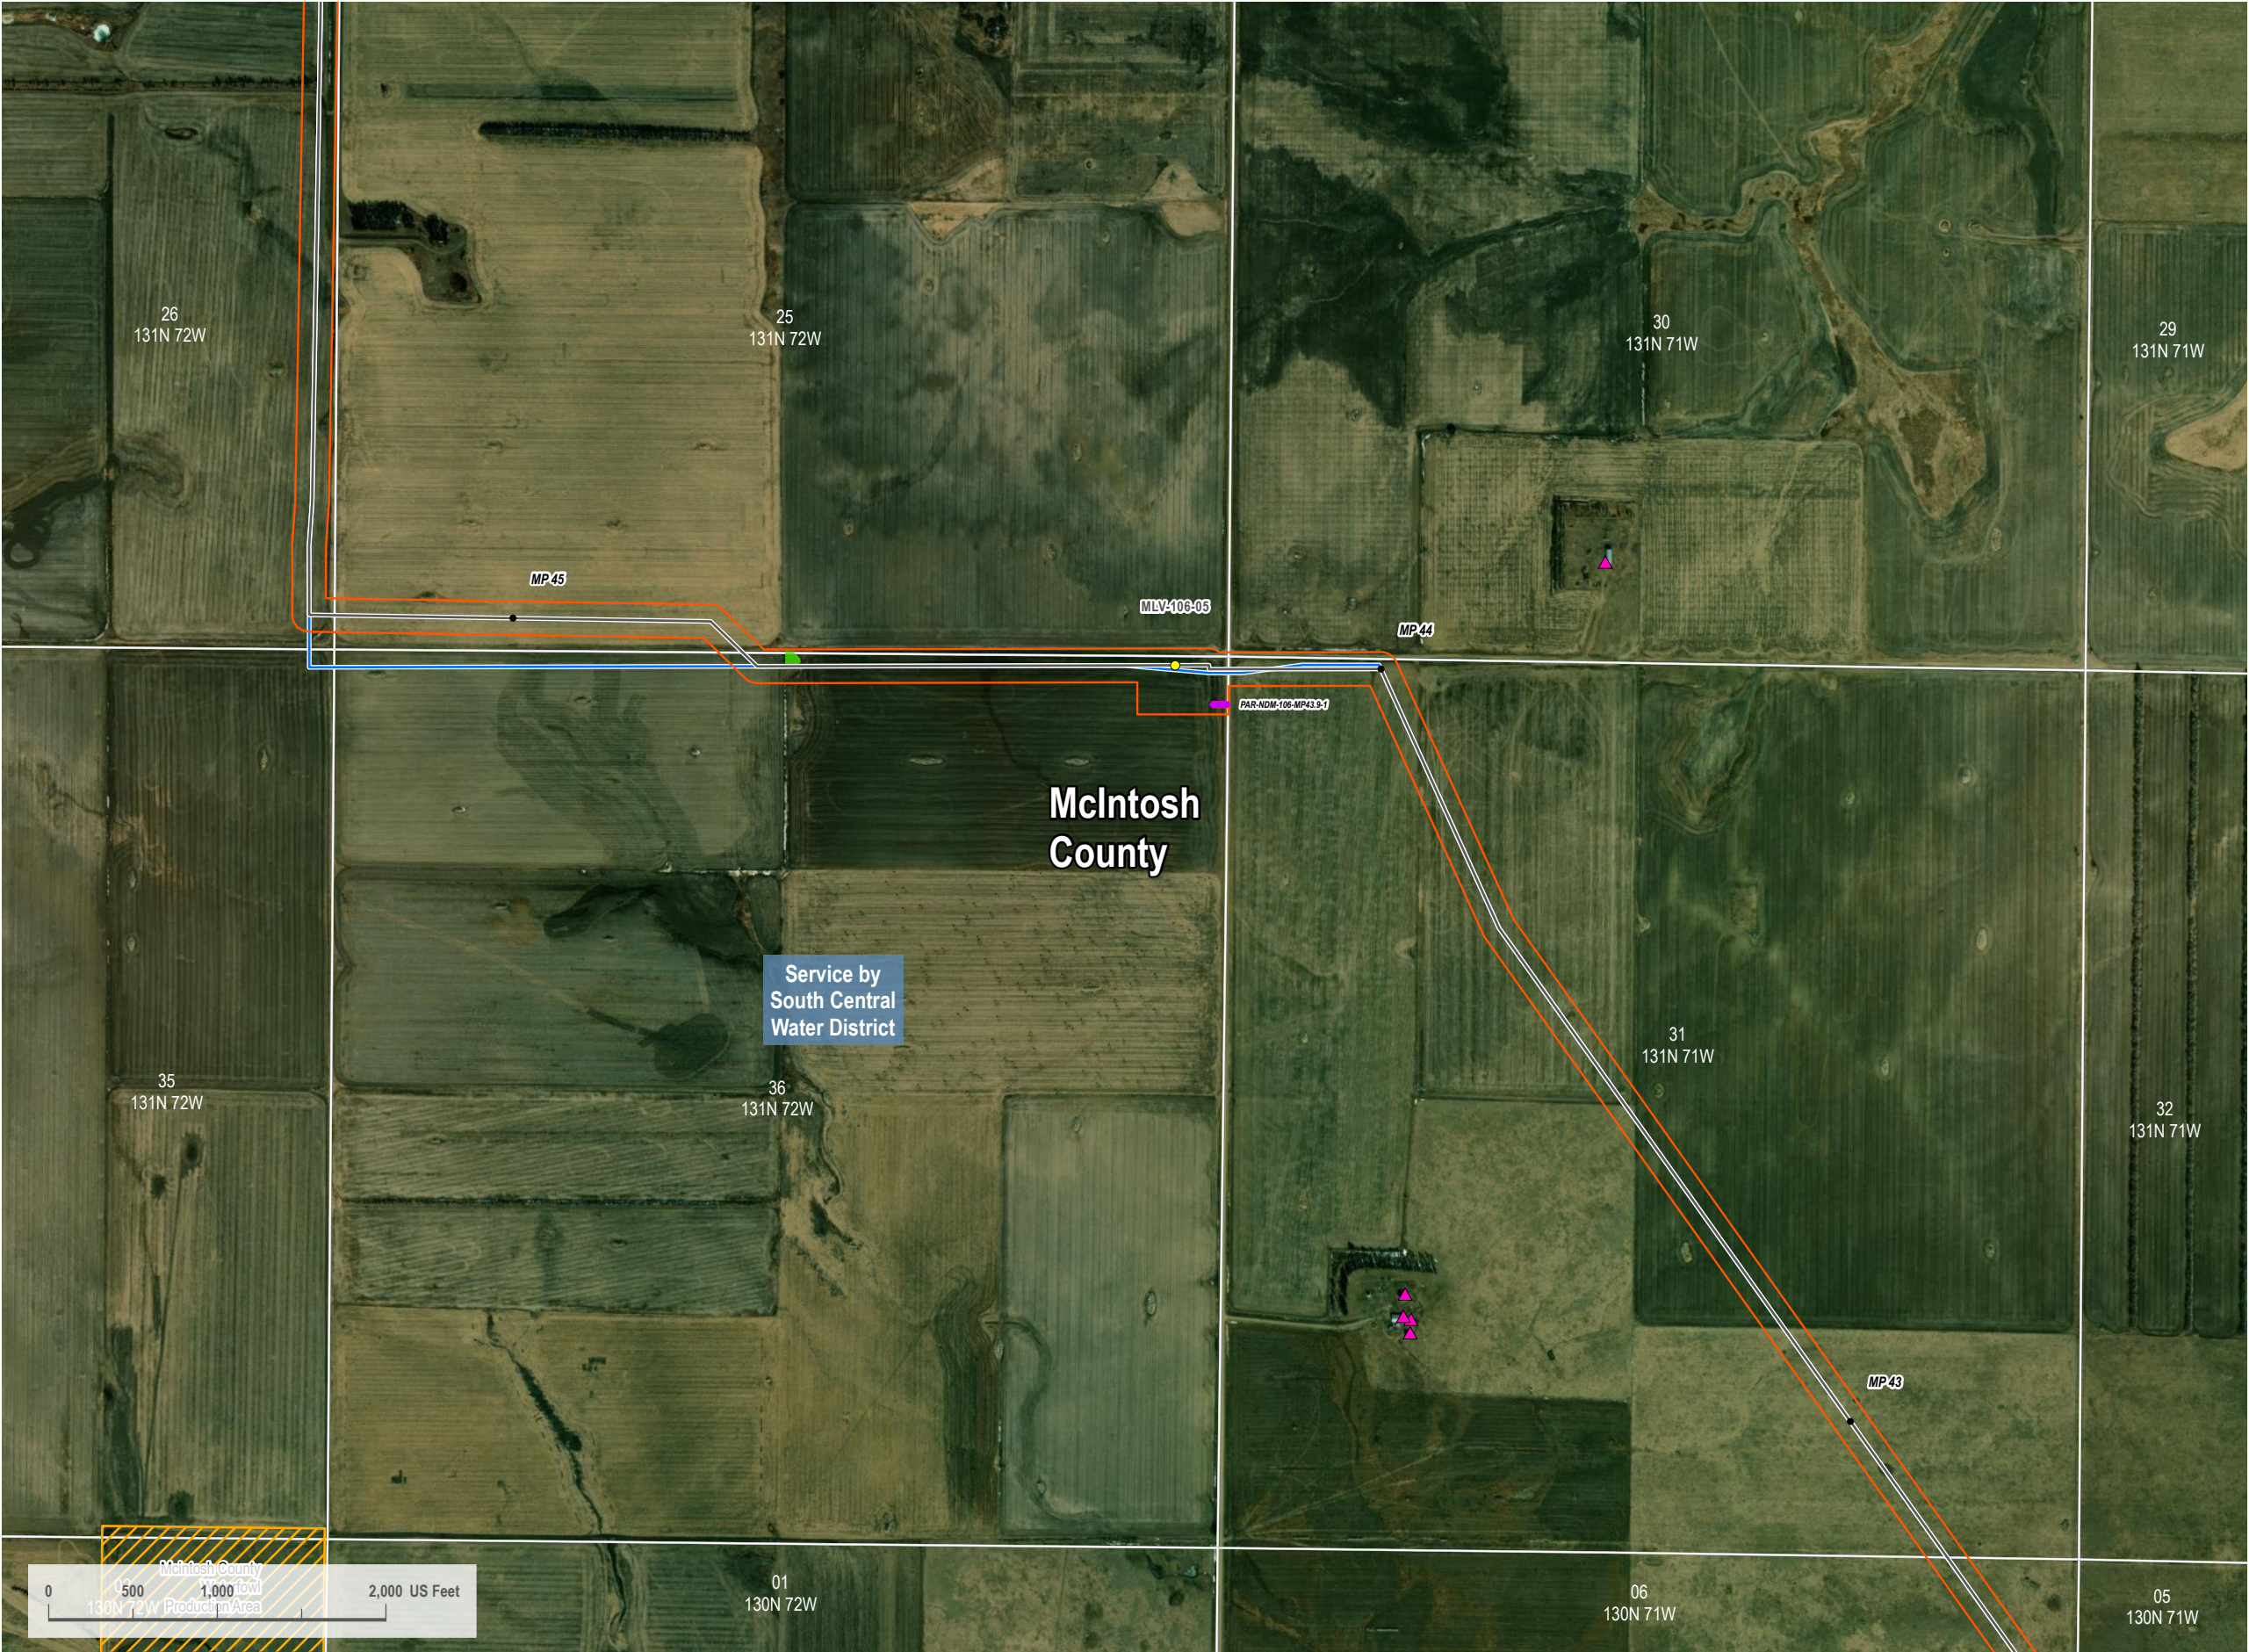

VICINITY MAP

LEGEND

Centerline Mileposts	Avoidance Area
Mainline Valve Location	PEM Wetland
Domestic Structure or Business (Avoidance)	200-foot Stiling Corridor
Updated Proposed Project Route 08/15/2023	
October 17, 2023 Original PSC Application Route	
Section Line	
Access Road	

REVISIONS

Date: 2023-08-17	Revised by: CW	Checked by: RC
A - Issued for Review		
Date:	Revised by:	Checked by:
Date:	Revised by:	Checked by:

PREPARED BY

Summit Carbon Solutions

2321 North Loop Drive, Suite 221  
Ames, Iowa 50010  
United States of America

[www.summitcarbonsolutions.com](http://www.summitcarbonsolutions.com)

PROJECT INFORMATION

Figure Title:  
ND PSC - Aerial Map Book - NDM-106

Figure Number:  
Map Book 1

Scale: 1 : 12,000 1 inch equals 1,000 feet	Projection: Transverse Mercator NAD 1983 UTM Zone 14N
Sheet: 9 9 of 139	Drawing Number: 1001-01-003 Revision A





VICINITY MAP

LEGEND

- Centerline Mileposts
- Domestic Structure or Business (Avoidance)
- Updated Proposed Project Route 08/15/2023
- October 17, 2023 Original PSC Application Route
- Section Line
- 200-foot Siting Corridor

REVISIONS

Date: 2023-08-17	Revised by: CW	Checked by: RC
A - Issued for Review		
Date:	Revised by:	Checked by:
Date:	Revised by:	Checked by:

PREPARED BY

Summit Carbon Solutions

2321 North Loop Drive, Suite 221  
Ames, Iowa 50010  
United States of America

www.summitcarbonsolutions.com

PROJECT INFORMATION

Figure Title:  
ND PSC - Aerial Map Book - NDM-106

Figure Number:  
Map Book 1

Scale: 1 : 12,000 1 inch equals 1,000 feet	Projection: Transverse Mercator NAD 1983 UTM Zone 14N
Sheet: 10 10 of 139	Drawing Number: 1001-01-003 Revision A





VICINITY MAP



LEGEND

- Centerline Mileposts
- Domestic Structure or Business (Avoidance)
- Updated Proposed Project Route 08/15/2023
- October 17, 2023 Original PSC Application Route
- Section Line
- PEM Wetland
- Stream
- 200-foot Siting Corridor



REVISIONS

Date: 2023-08-17	Revised by: CW	Checked by: RC
A - Issued for Review		
Date:	Revised by:	Checked by:
Date:	Revised by:	Checked by:

PREPARED BY

**Summit Carbon Solutions**  
 2321 North Loop Drive, Suite 221  
 Ames, Iowa 50010  
 United States of America  
[www.summitcarbonsolutions.com](http://www.summitcarbonsolutions.com)



PROJECT INFORMATION

Figure Title: <b>ND PSC - Aerial Map Book - NDM-106</b>	
Figure Number: <b>Map Book 1</b>	
Scale: <b>1 : 12,000</b> 1 inch equals 1,000 feet	Projection: <b>Transverse Mercator</b> NAD 1983 UTM Zone 14N
Sheet: <b>11</b> 11 of 139	Drawing Number: <b>1001-01-003</b> Revision A





VICINITY MAP



LEGEND

- Centerline Mileposts
- Mainline Valve Location
- Domestic Structure or Business (Avoidance)
- Updated Proposed Project Route 08/15/2023
- October 17, 2023 Original PSC Application Route
- Section Line
- Access Road
- PEM Wetland
- 200-foot Siting Corridor



REVISIONS

Date:	2023-08-17	Revised by:	CW	Checked by:	RC
A - Issued for Review					
Date:		Revised by:		Checked by:	
Date:		Revised by:		Checked by:	

PREPARED BY

**Summit Carbon Solutions**  
2321 North Loop Drive, Suite 221  
Ames, Iowa 50010  
United States of America  
[www.summitcarbonsolutions.com](http://www.summitcarbonsolutions.com)



**SUMMIT CARBON**  
SOLUTIONS

PROJECT INFORMATION

Figure Title: <b>ND PSC - Aerial Map Book - NDM-106</b>	
Figure Number: <b>Map Book 1</b>	
Scale: <b>1 : 12,000</b> 1 inch equals 1,000 feet	Projection: <b>Transverse Mercator</b> NAD 1983 UTM Zone 14N
Sheet: <b>12</b> 12 of 139	Drawing Number: <b>1001-01-003</b> Revision A





VICINITY MAP



LEGEND

- Centerline Mileposts
- Updated Proposed Project Route 08/15/2023
- October 17, 2023 Original PSC Application Route
- Section Line
- 200-foot Siting Corridor



REVISIONS

Date: 2023-08-17	Revised by: CW	Checked by: RC
A - Issued for Review		
Date:	Revised by:	Checked by:
Date:	Revised by:	Checked by:

PREPARED BY

**Summit Carbon Solutions**  
2321 North Loop Drive, Suite 221  
Ames, Iowa 50010  
United States of America  
[www.summitcarbonsolutions.com](http://www.summitcarbonsolutions.com)



**SUMMIT CARBON**  
SOLUTIONS

PROJECT INFORMATION

Figure Title: <b>ND PSC - Aerial Map Book - NDM-106</b>	
Figure Number: <b>Map Book 1</b>	
Scale: <b>1 : 12,000</b> 1 inch equals 1,000 feet	Projection: <b>Transverse Mercator</b> NAD 1983 UTM Zone 14N
Sheet: <b>13</b> 13 of 139	Drawing Number: <b>1001-01-003</b> Revision A






VICINITY MAP



LEGEND

- Centerline Mileposts
- Domestic Structure or Business (Avoidance)
- Updated Proposed Project Route 08/15/2023
- October 17, 2023 Original PSC Application Route
- Section Line
- PEM Wetland
- 200-foot Siting Corridor

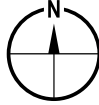

REVISIONS

Date:	2023-08-17	Revised by:	CW	Checked by:	RC
A - Issued for Review					
Date:		Revised by:		Checked by:	
Date:		Revised by:		Checked by:	

PREPARED BY

**Summit Carbon Solutions**  
2321 North Loop Drive, Suite 221  
Ames, Iowa 50010  
United States of America  
[www.summitcarbonsolutions.com](http://www.summitcarbonsolutions.com)



**SUMMIT CARBON**  
SOLUTIONS

PROJECT INFORMATION

Figure Title: <b>ND PSC - Aerial Map Book - NDM-106</b>	
Figure Number: <b>Map Book 1</b>	
Scale: <b>1 : 12,000</b> 1 inch equals 1,000 feet	Projection: <b>Transverse Mercator</b> NAD 1983 UTM Zone 14N
Sheet: <b>14</b> 14 of 139	Drawing Number: <b>1001-01-003</b> Revision A






VICINITY MAP



LEGEND

- Centerline Mileposts
- Domestic Structure or Business (Avoidance)
- Updated Proposed Project Route 08/15/2023
- October 17, 2023 Original PSC Application Route
- Section Line
- Stream
- 200-foot Siting Corridor

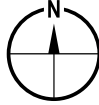

REVISIONS

Date: 2023-08-17	Revised by: CW	Checked by: RC
A - Issued for Review		
Date:	Revised by:	Checked by:
Date:	Revised by:	Checked by:

PREPARED BY

**Summit Carbon Solutions**  
2321 North Loop Drive, Suite 221  
Ames, Iowa 50010  
United States of America  
[www.summitcarbonsolutions.com](http://www.summitcarbonsolutions.com)



**SUMMIT CARBON**  
SOLUTIONS

PROJECT INFORMATION

Figure Title: <b>ND PSC - Aerial Map Book - NDM-106</b>	
Figure Number: <b>Map Book 1</b>	
Scale: <b>1 : 12,000</b> 1 inch equals 1,000 feet	Projection: <b>Transverse Mercator</b> NAD 1983 UTM Zone 14N
Sheet: <b>15</b> 15 of 139	Drawing Number: <b>1001-01-003</b> Revision A





VICINITY MAP



LEGEND

- Centerline Mileposts
- Water Well (Avoidance)
- Domestic Structure or Business (Avoidance)
- Updated Proposed Project Route 08/15/2023
- October 17, 2023 Original PSC Application Route
- Section Line
- Access Road
- Avoidance Area
- PEM Wetland
- Stream
- 200-foot Siting Corridor



REVISIONS

Date: 2023-08-17	Revised by: CW	Checked by: RC
A - Issued for Review		
Date:	Revised by:	Checked by:
Date:	Revised by:	Checked by:

PREPARED BY

**Summit Carbon Solutions**  
2321 North Loop Drive, Suite 221  
Ames, Iowa 50010  
United States of America  
[www.summitcarbonsolutions.com](http://www.summitcarbonsolutions.com)



**SUMMIT CARBON**  
SOLUTIONS

PROJECT INFORMATION

Figure Title: <b>ND PSC - Aerial Map Book - NDM-106</b>	
Figure Number: <b>Map Book 1</b>	
Scale: <b>1 : 12,000</b> 1 inch equals 1,000 feet	Projection: <b>Transverse Mercator</b> NAD 1983 UTM Zone 14N
Sheet: <b>16</b> 16 of 139	Drawing Number: <b>1001-01-003</b> Revision A





VICINITY MAP



LEGEND

- Centerline Mileposts
- Water Well (Avoidance)
- Updated Proposed Project Route 08/15/2023
- October 17, 2023 Original PSC Application Route
- Section Line
- Access Road
- 200-foot Siting Corridor



REVISIONS

Date:	2023-08-17	Revised by:	CW	Checked by:	RC
A - Issued for Review					
Date:		Revised by:		Checked by:	
Date:		Revised by:		Checked by:	

PREPARED BY

**Summit Carbon Solutions**  
2321 North Loop Drive, Suite 221  
Ames, Iowa 50010  
United States of America  
[www.summitcarbonsolutions.com](http://www.summitcarbonsolutions.com)




**SUMMIT CARBON**  
SOLUTIONS

PROJECT INFORMATION

Figure Title: <b>ND PSC - Aerial Map Book - NDM-106</b>	
Figure Number: <b>Map Book 1</b>	
Scale: <b>1 : 12,000</b> 1 inch equals 1,000 feet	Projection: <b>Transverse Mercator</b> NAD 1983 UTM Zone 14N
Sheet: <b>17</b> 17 of 139	Drawing Number: <b>1001-01-003</b> Revision A



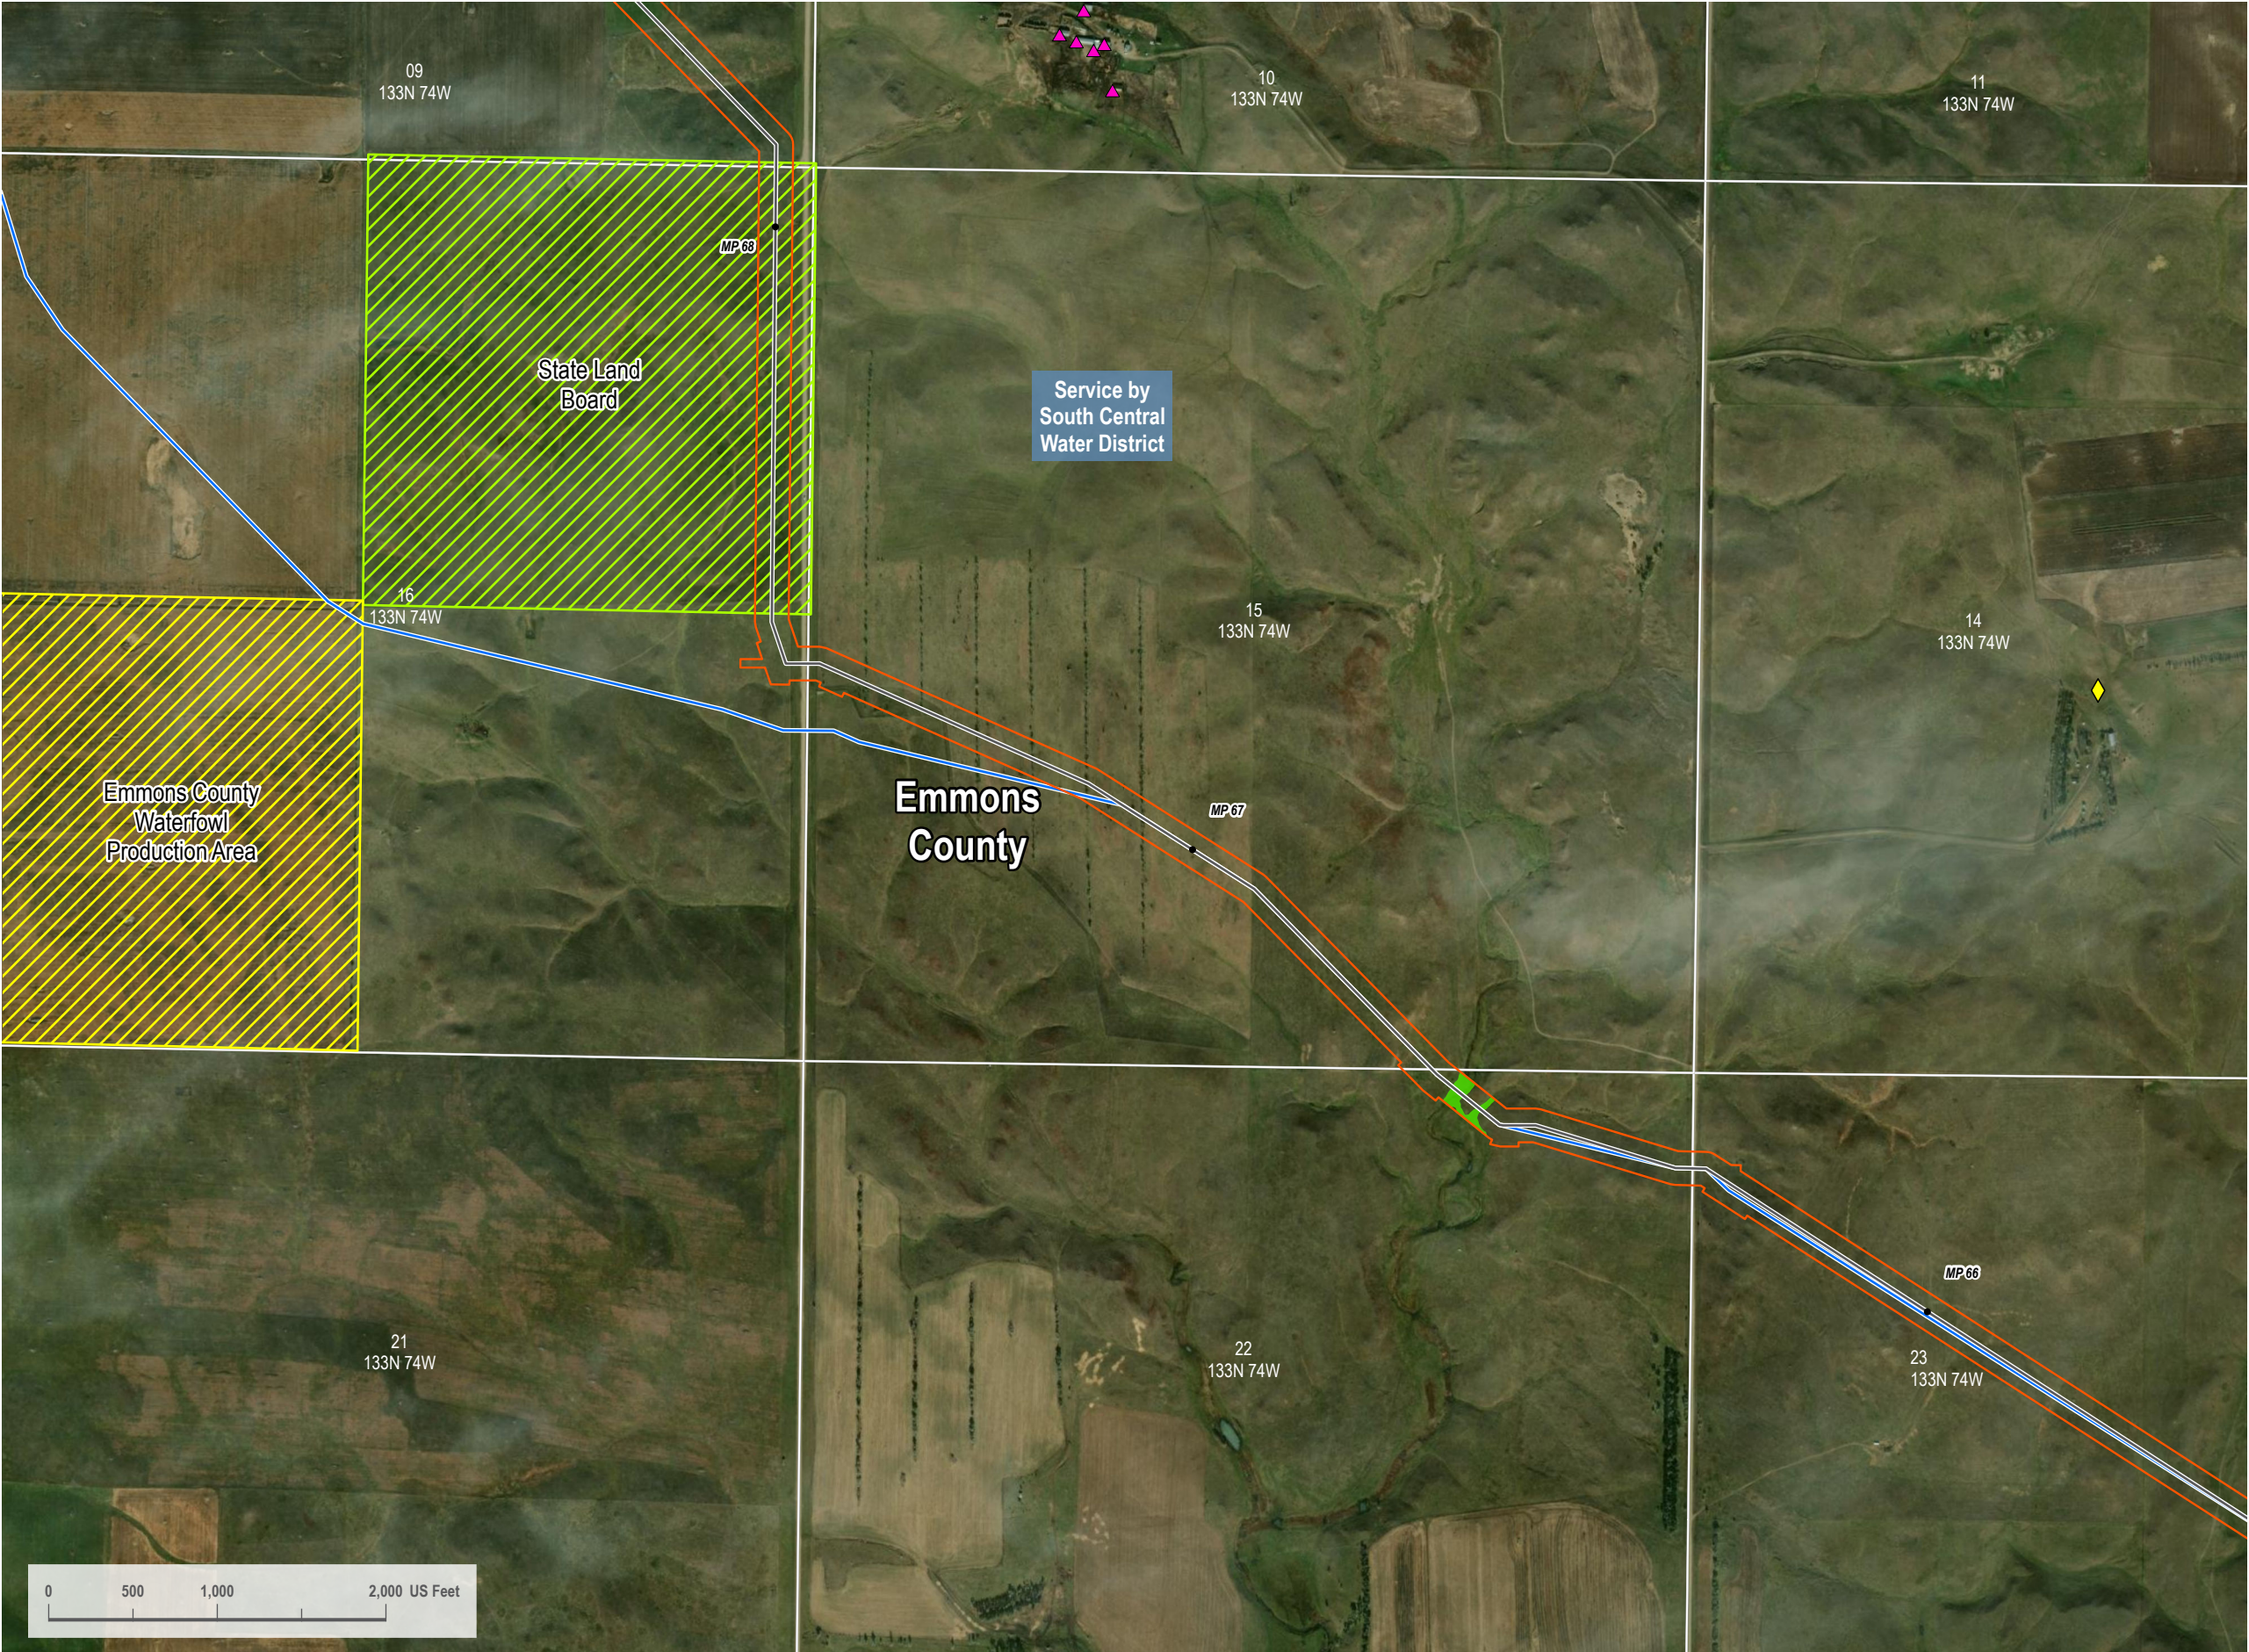

VICINITY MAP



LEGEND

- Centerline Mileposts
- Water Well (Avoidance)
- Domestic Structure or Business (Avoidance)
- Updated Proposed Project Route 08/15/2023
- October 17, 2023 Original PSC Application Route
- Section Line
- PEM Wetland
- 200-foot Siting Corridor
- Resource Management Area
- State Resource Management Area



REVISIONS

Date: 2023-08-17	Revised by: CW	Checked by: RC
A - Issued for Review		
Date:	Revised by:	Checked by:
Date:	Revised by:	Checked by:

PREPARED BY

**Summit Carbon Solutions**  
2321 North Loop Drive, Suite 221  
Ames, Iowa 50010  
United States of America  
[www.summitcarbonsolutions.com](http://www.summitcarbonsolutions.com)



**SUMMIT CARBON**  
SOLUTIONS

PROJECT INFORMATION

Figure Title: <b>ND PSC - Aerial Map Book - NDM-106</b>	
Figure Number: <b>Map Book 1</b>	
Scale: <b>1 : 12,000</b> 1 inch equals 1,000 feet	Projection: <b>Transverse Mercator</b> NAD 1983 UTM Zone 14N
Sheet: <b>18</b> 18 of 139	Drawing Number: <b>1001-01-003</b> Revision A














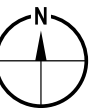


## VICINITY MAP



### LEGEND

- 
- |   |   |   |                                |
|---|---|---|--------------------------------|
|  | HDD Entry/Exit                                  |  | Avoidance Area                 |
|  | Centerline Mileposts                            |  | PEM Wetland                    |
|  | Water Well (Avoidance)                          |  | 200-foot Siling Corridor       |
|  | Domestic Structure or Business (Avoidance)      |  | Resource Management Area       |
|  | Updated Proposed Project Route 08/15/2023       |  | State Resource Management Area |
|  | October 17, 2023 Original PSC Application Route |   |                                |
|  | Section Line                                    |   |                                |



## REVISIONS

Date: 2023-08-17      Revised by: CW      Checked by: RC

**A - Issued for Review**

Date: \_\_\_\_\_ Revised by: \_\_\_\_\_ Checked by: \_\_\_\_\_

Date: \_\_\_\_\_ Revised by: \_\_\_\_\_ Checked by: \_\_\_\_\_

PREPARED BY

**Summit Carbon Solutions**  
2321 North Loop Drive, Suite 221  
Ames, Iowa 50010  
United States of America

The logo consists of a stylized blue hexagon with white geometric shapes inside, forming a larger hexagonal pattern.

**SUMMIT CARBON**  
SOLUTIONS

[www.summitcarbonsolutions.com](http://www.summitcarbonsolutions.com)



**SUMMIT CARBON**  
SOLUTIONS

[www.summitcarbonsolutions.com](http://www.summitcarbonsolutions.com)

## PROJECT INFORMATION

Figure Title:

ND PSC - Aerial Map Book - NDM-106

ND PSC - Aerial Map Book - NDM-106

Figure Number: **Map Book 1**

Map Book 1

**Scale:**  
**1 : 12,000**  
1 inch equals 1,000 feet

**Projection:**  
**Transverse Mercator**  
NAD 1983 UTM Zone 14N


Projection:  
Transverse Mercator  
AD 1983 UTM Zone 14N

Sheet: **19**  
19 of 139

Drawing Number: **1001-01-003**  
Revision A

Drawing Number:  
**001-01-003**  
Revision A



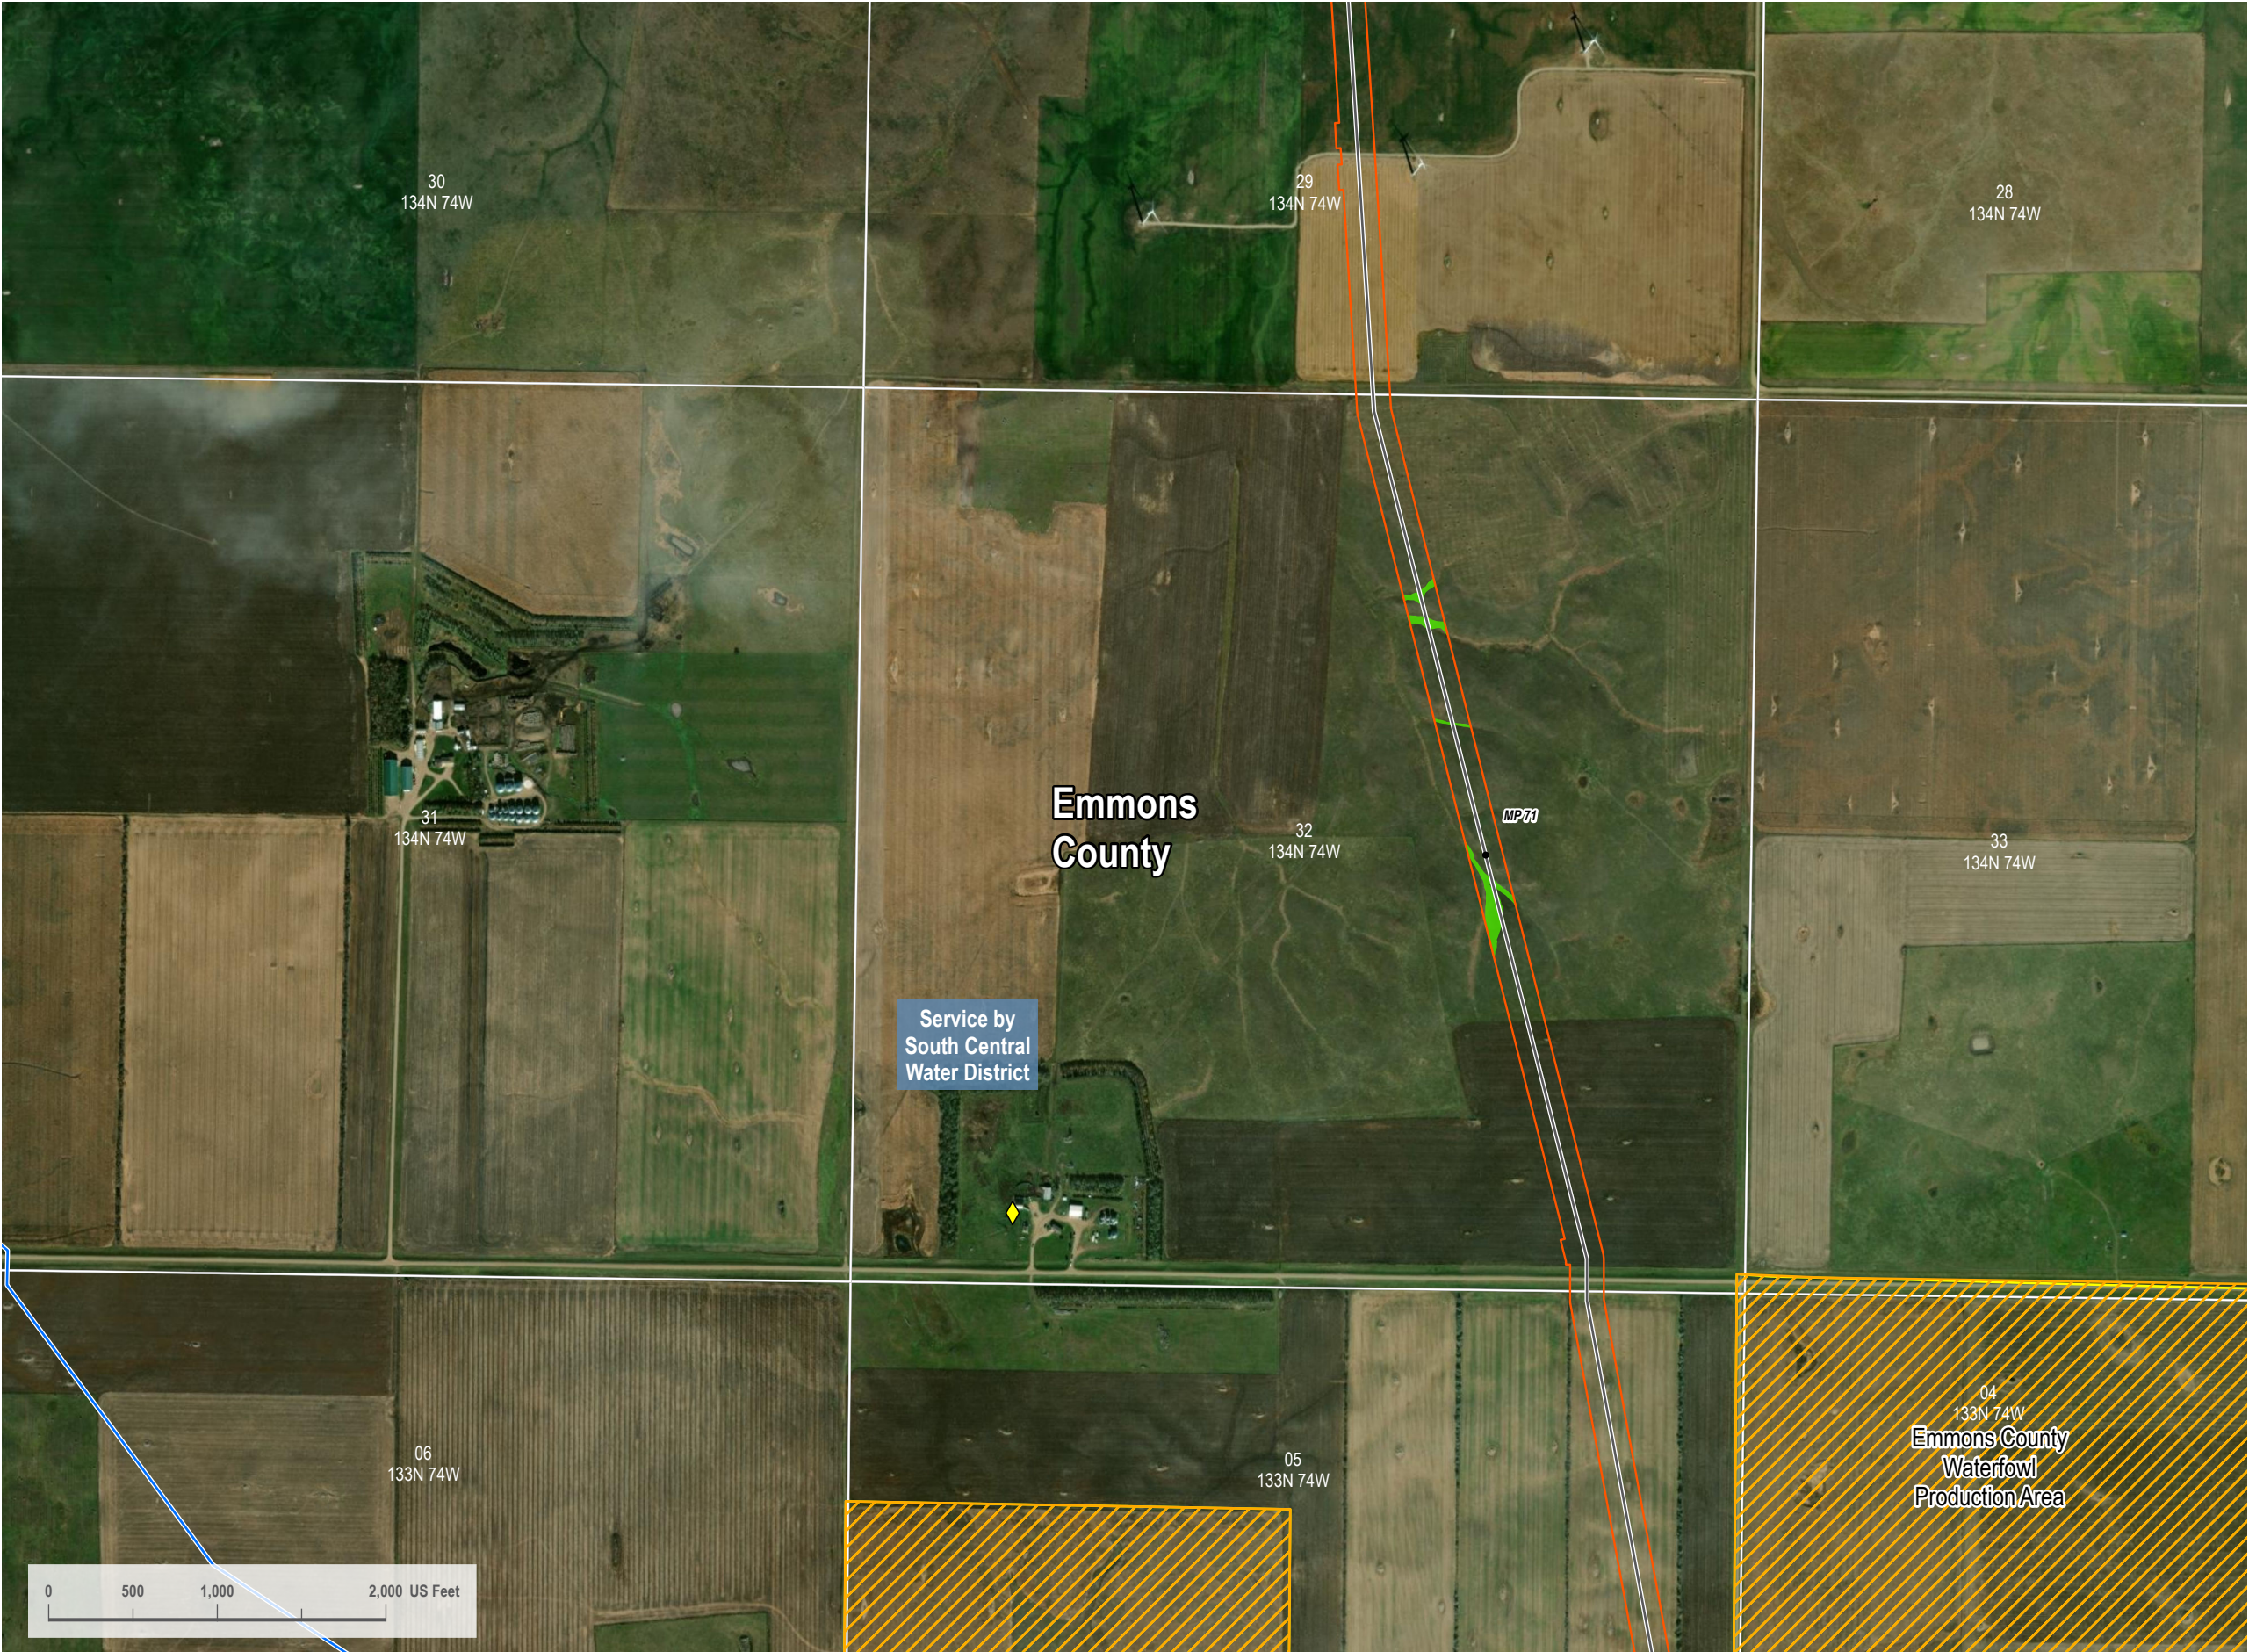

VICINITY MAP



LEGEND

- Centerline Mileposts
- Water Well (Avoidance)
- Updated Proposed Project Route 08/15/2023
- October 17, 2023 Original PSC Application Route
- Section Line
- Avoidance Area
- PEM Wetland
- 200-foot Siltation Corridor
- Resource Management Area



REVISIONS

Date: 2023-08-17 Revised by: CW Checked by: RC  
A - Issued for Review

Date: Revised by: Checked by:

Date: Revised by: Checked by:

PREPARED BY

**Summit Carbon Solutions**  
2321 North Loop Drive, Suite 221  
Ames, Iowa 50010  
United States of America  
[www.summitcarbonsolutions.com](http://www.summitcarbonsolutions.com)



**SUMMIT CARBON SOLUTIONS**

PROJECT INFORMATION

Figure Title:  
ND PSC - Aerial Map Book - NDM-106

Figure Number:  
Map Book 1

Scale: 1 : 12,000 1 inch equals 1,000 feet	Projection: Transverse Mercator NAD 1983 UTM Zone 14N
Sheet: 20 20 of 139	Drawing Number: 1001-01-003 Revision A






VICINITY MAP



LEGEND

- Centerline Mileposts
- Updated Proposed Project Route 08/15/2023
- October 17, 2023 Original PSC Application Route
- Section Line
- PEM Wetland
- 200-foot Siting Corridor
- State Resource Management Area

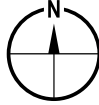

REVISIONS

Date:	2023-08-17	Revised by:	CW	Checked by:	RC
A - Issued for Review					
Date:		Revised by:		Checked by:	
Date:		Revised by:		Checked by:	

PREPARED BY

**Summit Carbon Solutions**  
2321 North Loop Drive, Suite 221  
Ames, Iowa 50010  
United States of America  
[www.summitcarbonsolutions.com](http://www.summitcarbonsolutions.com)




**SUMMIT CARBON**  
SOLUTIONS

PROJECT INFORMATION

Figure Title: <b>ND PSC - Aerial Map Book - NDM-106</b>	
Figure Number: <b>Map Book 1</b>	
Scale: <b>1 : 12,000</b> 1 inch equals 1,000 feet	Projection: <b>Transverse Mercator</b> NAD 1983 UTM Zone 14N
Sheet: <b>21</b> 21 of 139	Drawing Number: <b>1001-01-003</b> Revision A



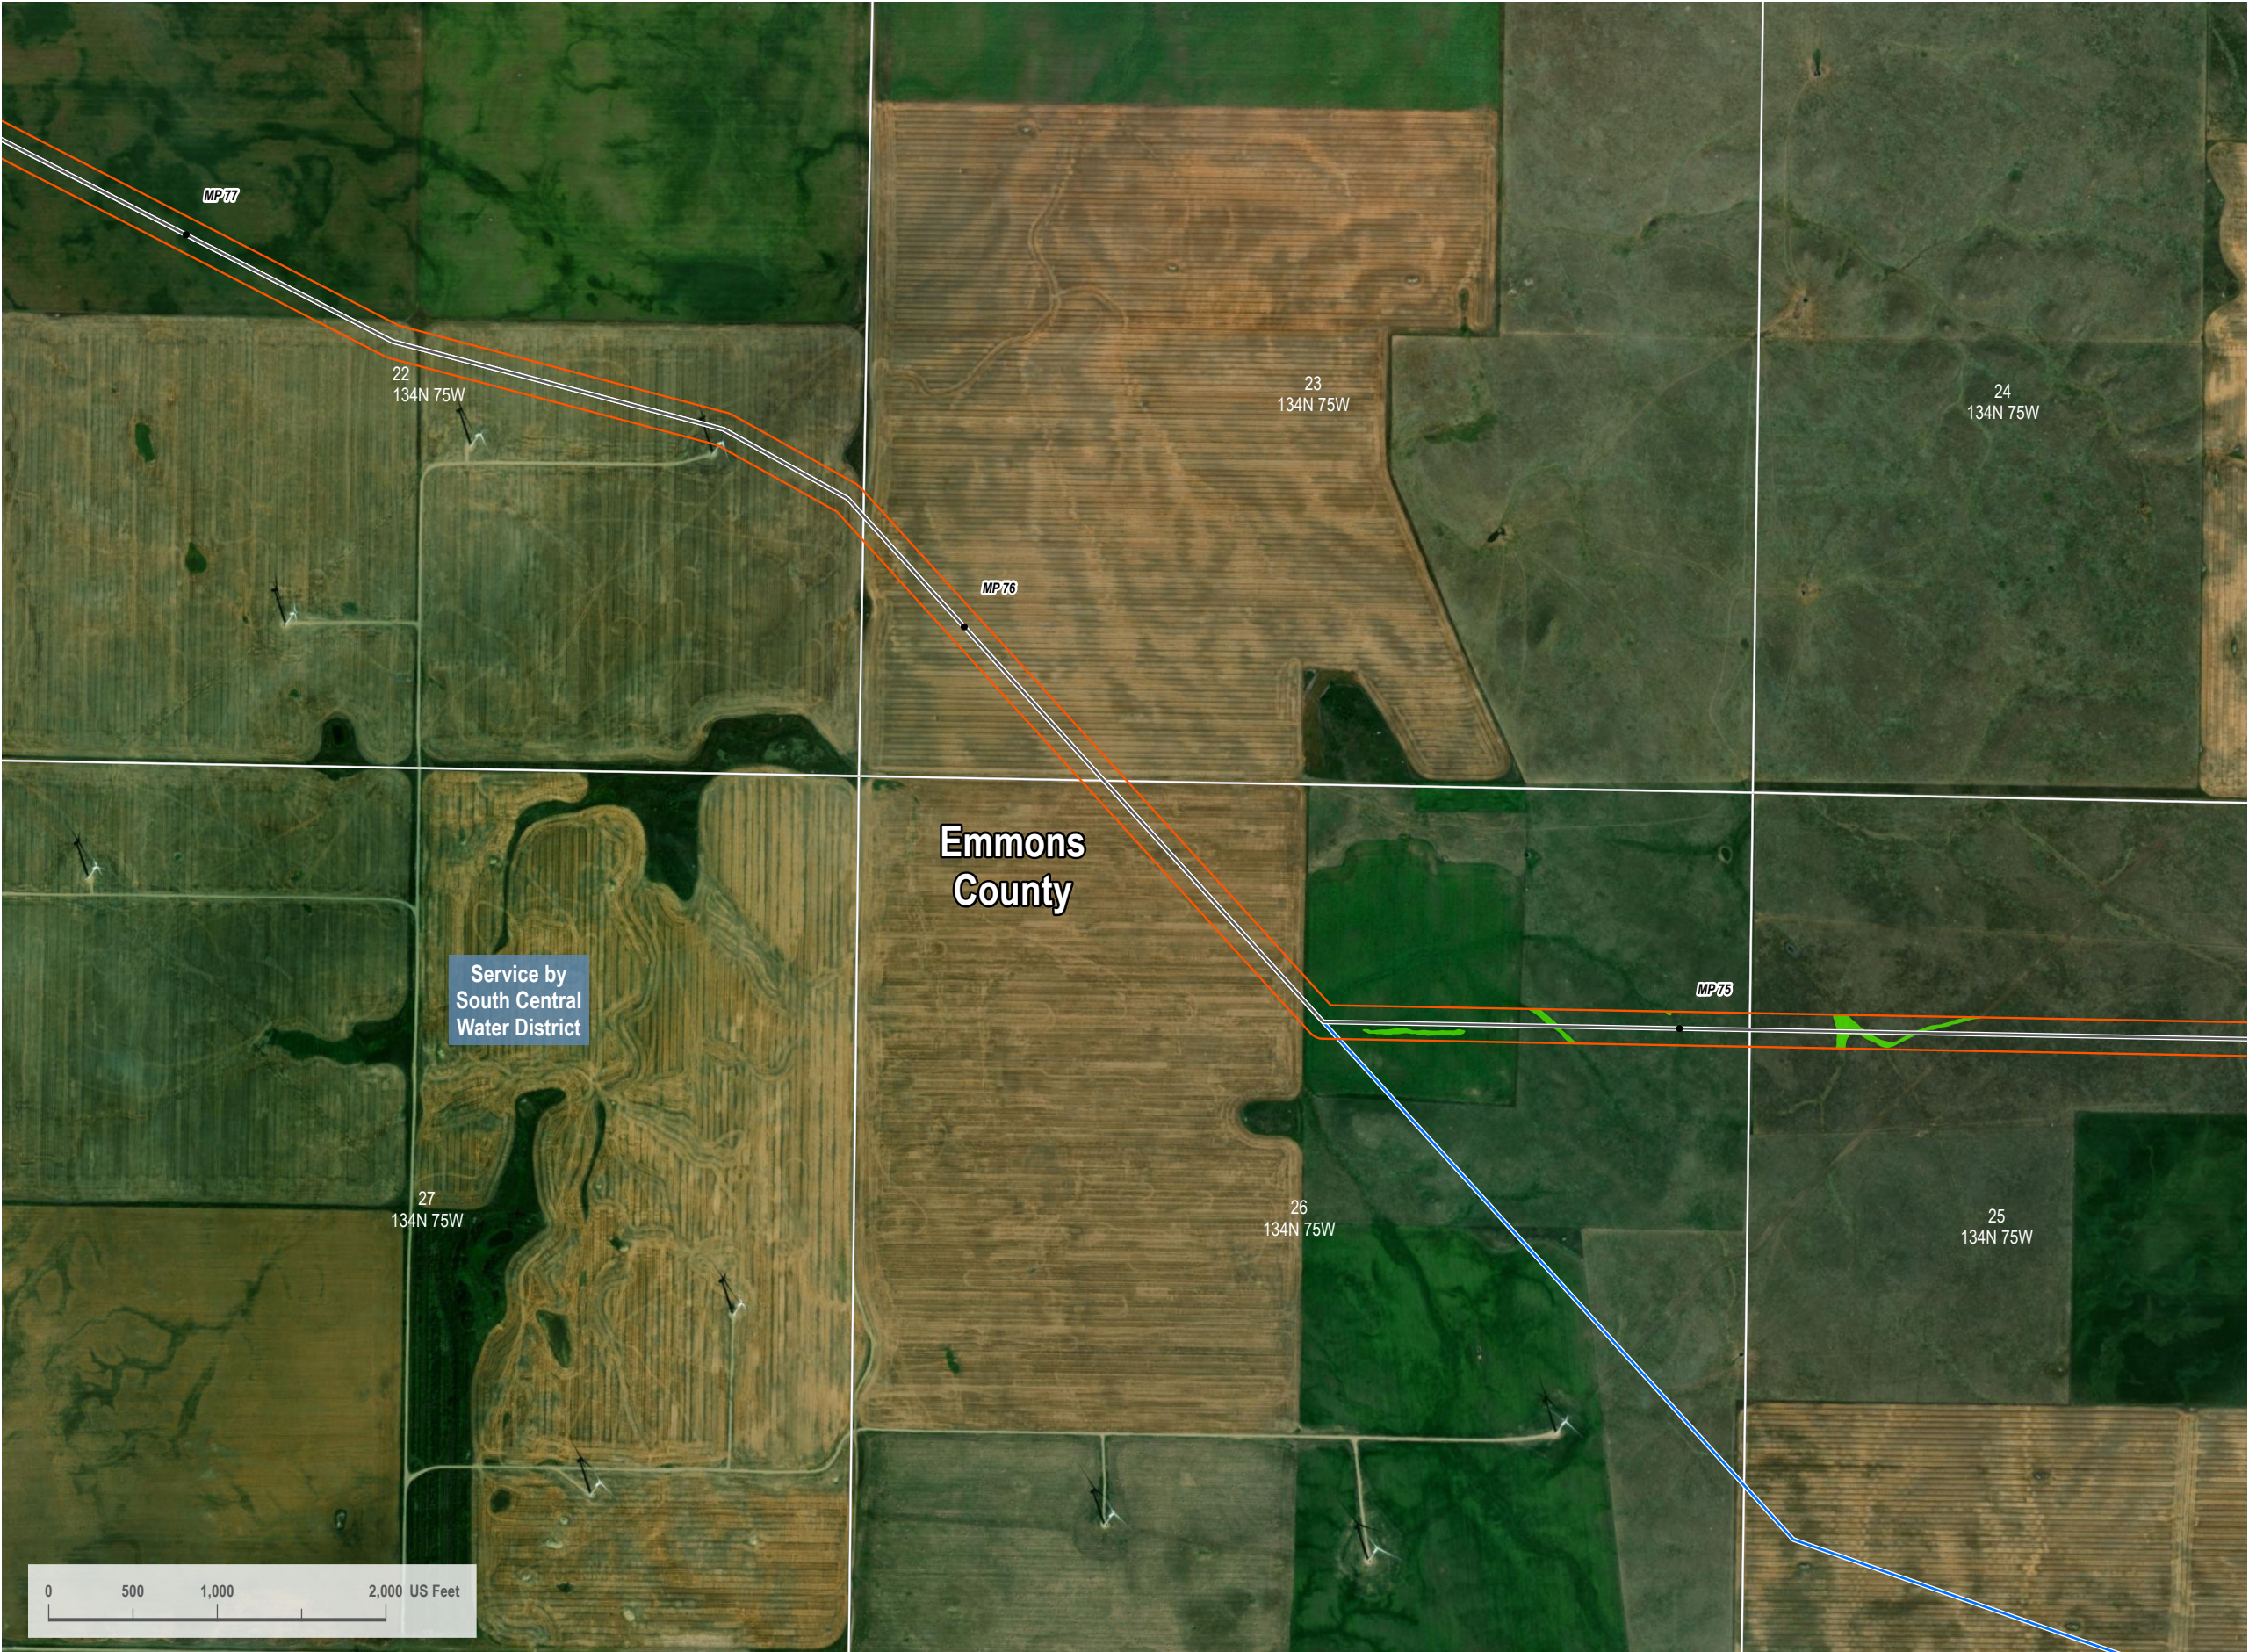

VICINITY MAP



LEGEND

- Centerline Mileposts
- Updated Proposed Project Route 08/15/2023
- October 17, 2023 Original PSC Application Route
- Section Line
- PEM Wetland
- 200-foot Stiling Corridor



REVISIONS

Date: 2023-08-17	Revised by: CW	Checked by: RC
A - Issued for Review		
Date:	Revised by:	Checked by:
Date:	Revised by:	Checked by:

PREPARED BY

**Summit Carbon Solutions**  
2321 North Loop Drive, Suite 221  
Ames, Iowa 50010  
United States of America  
[www.summitcarbonsolutions.com](http://www.summitcarbonsolutions.com)



**SUMMIT CARBON**  
SOLUTIONS

PROJECT INFORMATION

Figure Title: <b>ND PSC - Aerial Map Book - NDM-106</b>	
Figure Number: <b>Map Book 1</b>	
Scale: <b>1 : 12,000</b> 1 inch equals 1,000 feet	Projection: <b>Transverse Mercator</b> NAD 1983 UTM Zone 14N
Sheet: <b>22</b> 22 of 139	Drawing Number: <b>1001-01-003</b> Revision A





VICINITY MAP



LEGEND

- Centerline Mileposts
- Updated Proposed Project Route 08/15/2023
- October 17, 2023 Original PSC Application Route
- Section Line
- PEM Wetland
- 200-foot Siting Corridor
- State Resource Management Area



REVISIONS

Date: 2023-08-17	Revised by: CW	Checked by: RC
A - Issued for Review		
Date:	Revised by:	Checked by:
Date:	Revised by:	Checked by:

PREPARED BY

**Summit Carbon Solutions**  
2321 North Loop Drive, Suite 221  
Ames, Iowa 50010  
United States of America  
[www.summitcarbonsolutions.com](http://www.summitcarbonsolutions.com)



**SUMMIT CARBON**  
SOLUTIONS

PROJECT INFORMATION

Figure Title: <b>ND PSC - Aerial Map Book - NDM-106</b>	
Figure Number: <b>Map Book 1</b>	
Scale: <b>1 : 12,000</b> 1 inch equals 1,000 feet	Projection: <b>Transverse Mercator</b> NAD 1983 UTM Zone 14N
Sheet: <b>23</b> 23 of 139	Drawing Number: <b>1001-01-003</b> Revision A






VICINITY MAP



LEGEND

- Centerline Mileposts
- Updated Proposed Project Route 08/15/2023
- October 17, 2023 Original PSC Application Route
- Section Line
- PEM Wetland
- 200-foot Siting Corridor

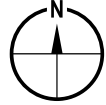

REVISIONS

Date: 2023-08-17	Revised by: CW	Checked by: RC
A - Issued for Review		
Date:	Revised by:	Checked by:
Date:	Revised by:	Checked by:

PREPARED BY

**Summit Carbon Solutions**  
2321 North Loop Drive, Suite 221  
Ames, Iowa 50010  
United States of America  
[www.summitcarbonsolutions.com](http://www.summitcarbonsolutions.com)




**SUMMIT CARBON**  
SOLUTIONS

PROJECT INFORMATION

Figure Title: <b>ND PSC - Aerial Map Book - NDM-106</b>	
Figure Number: <b>Map Book 1</b>	
Scale: <b>1 : 12,000</b> 1 inch equals 1,000 feet	Projection: <b>Transverse Mercator</b> NAD 1983 UTM Zone 14N
Sheet: <b>24</b> 24 of 139	Drawing Number: <b>1001-01-003</b> Revision A



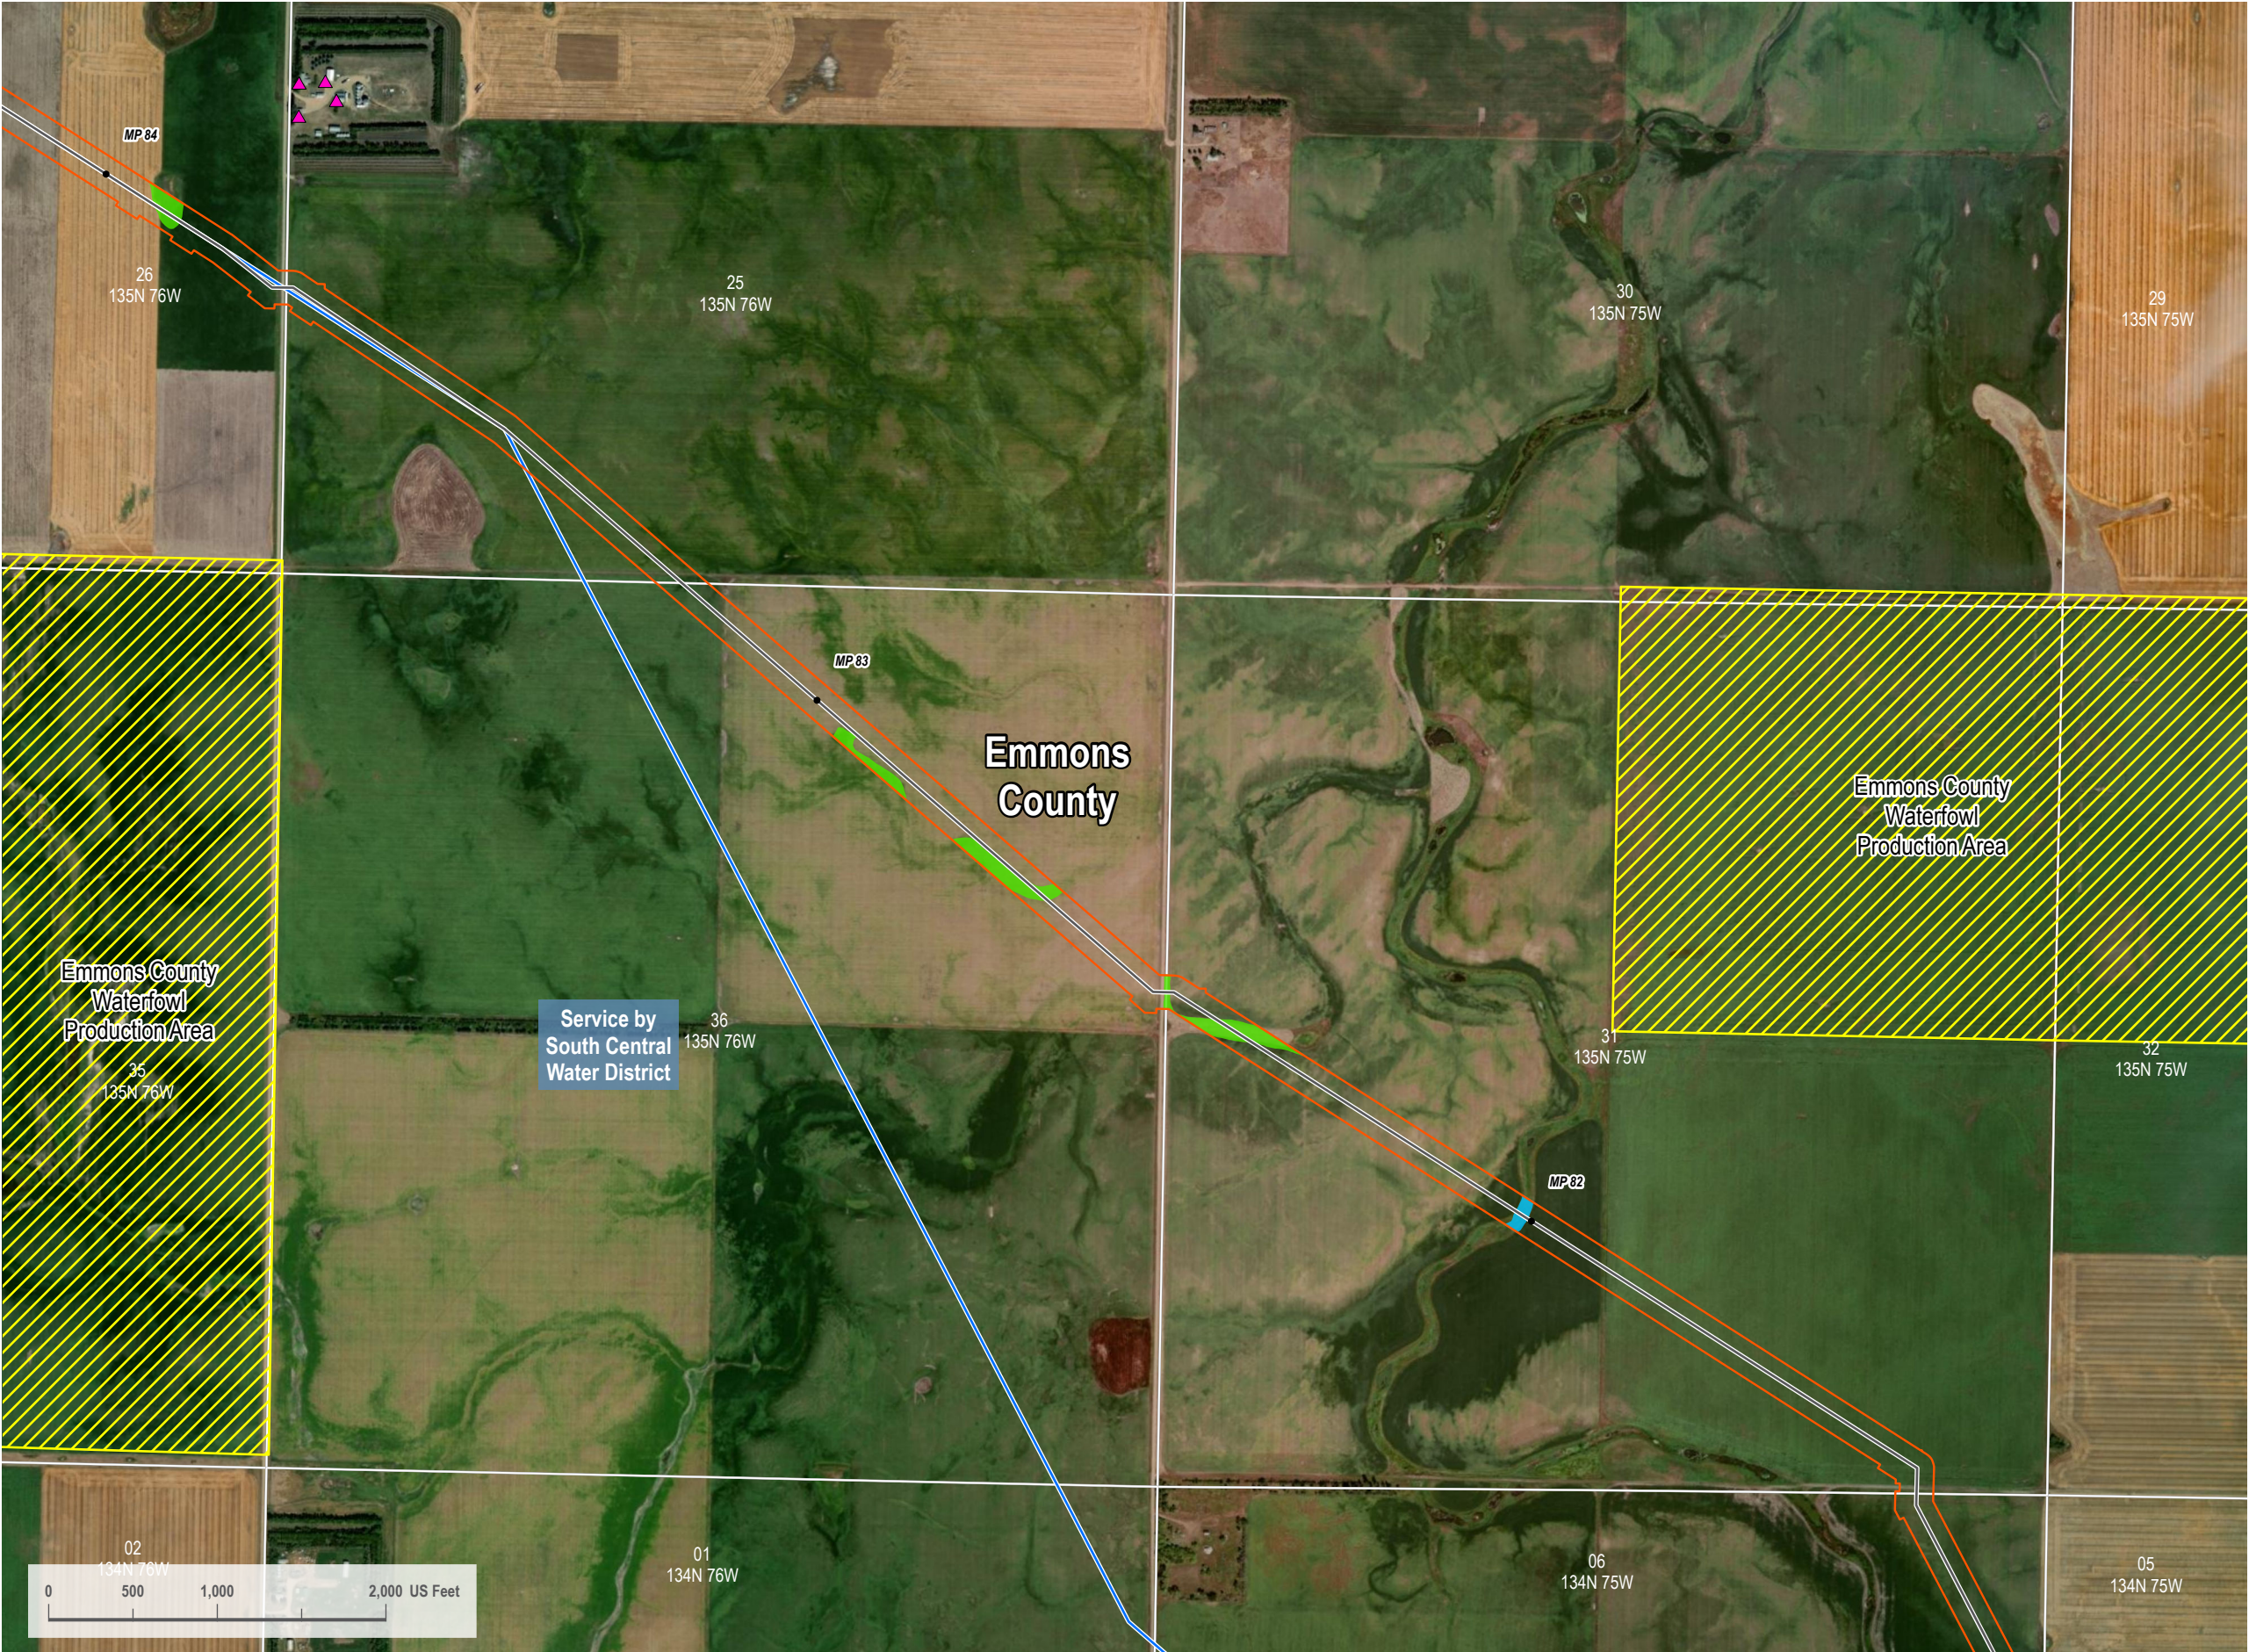


VICINITY MAP



LEGEND

- Centerline Mileposts
- Domestic Structure or Business (Avoidance)
- Updated Proposed Project Route 08/15/2023
- October 17, 2023 Original PSC Application Route
- Section Line
- PEM Wetland
- Stream
- 200-foot Siting Corridor
- Resource Management Area

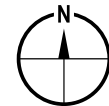

REVISIONS

Date:	2023-08-17	Revised by:	CW	Checked by:	RC
A - Issued for Review					
Date:		Revised by:		Checked by:	
Date:		Revised by:		Checked by:	

PREPARED BY

**Summit Carbon Solutions**  
2321 North Loop Drive, Suite 221  
Ames, Iowa 50010  
United States of America  
[www.summitcarbonsolutions.com](http://www.summitcarbonsolutions.com)



**SUMMIT CARBON SOLUTIONS**

PROJECT INFORMATION

Figure Title: <b>ND PSC - Aerial Map Book - NDM-106</b>	
Figure Number: <b>Map Book 1</b>	
Scale: <b>1 : 12,000</b> 1 inch equals 1,000 feet	Projection: <b>Transverse Mercator</b> NAD 1983 UTM Zone 14N
Sheet: <b>25</b> 25 of 139	Drawing Number: <b>1001-01-003</b> Revision A





VICINITY MAP

LEGEND

- Centerline Mileposts
- Domestic Structure or Business (Avoidance)
- Updated Proposed Project Route 08/15/2023
- October 17, 2023 Original PSC Application Route
- Section Line
- PEM Wetland
- 200-foot Stiling Corridor
- Resource Management Area

REVISIONS

Date: 2023-08-17	Revised by: CW	Checked by: RC
A - Issued for Review		
Date:	Revised by:	Checked by:
Date:	Revised by:	Checked by:

PREPARED BY

Summit Carbon Solutions

2321 North Loop Drive, Suite 221  
Ames, Iowa 50010  
United States of America

www.summitcarbonsolutions.com


PROJECT INFORMATION

Figure Title:  
ND PSC - Aerial Map Book - NDM-106

Figure Number:  
Map Book 1

Scale: 1 : 12,000 1 inch equals 1,000 feet	Projection: Transverse Mercator NAD 1983 UTM Zone 14N
Sheet: 26 26 of 139	Drawing Number: 1001-01-003 Revision A



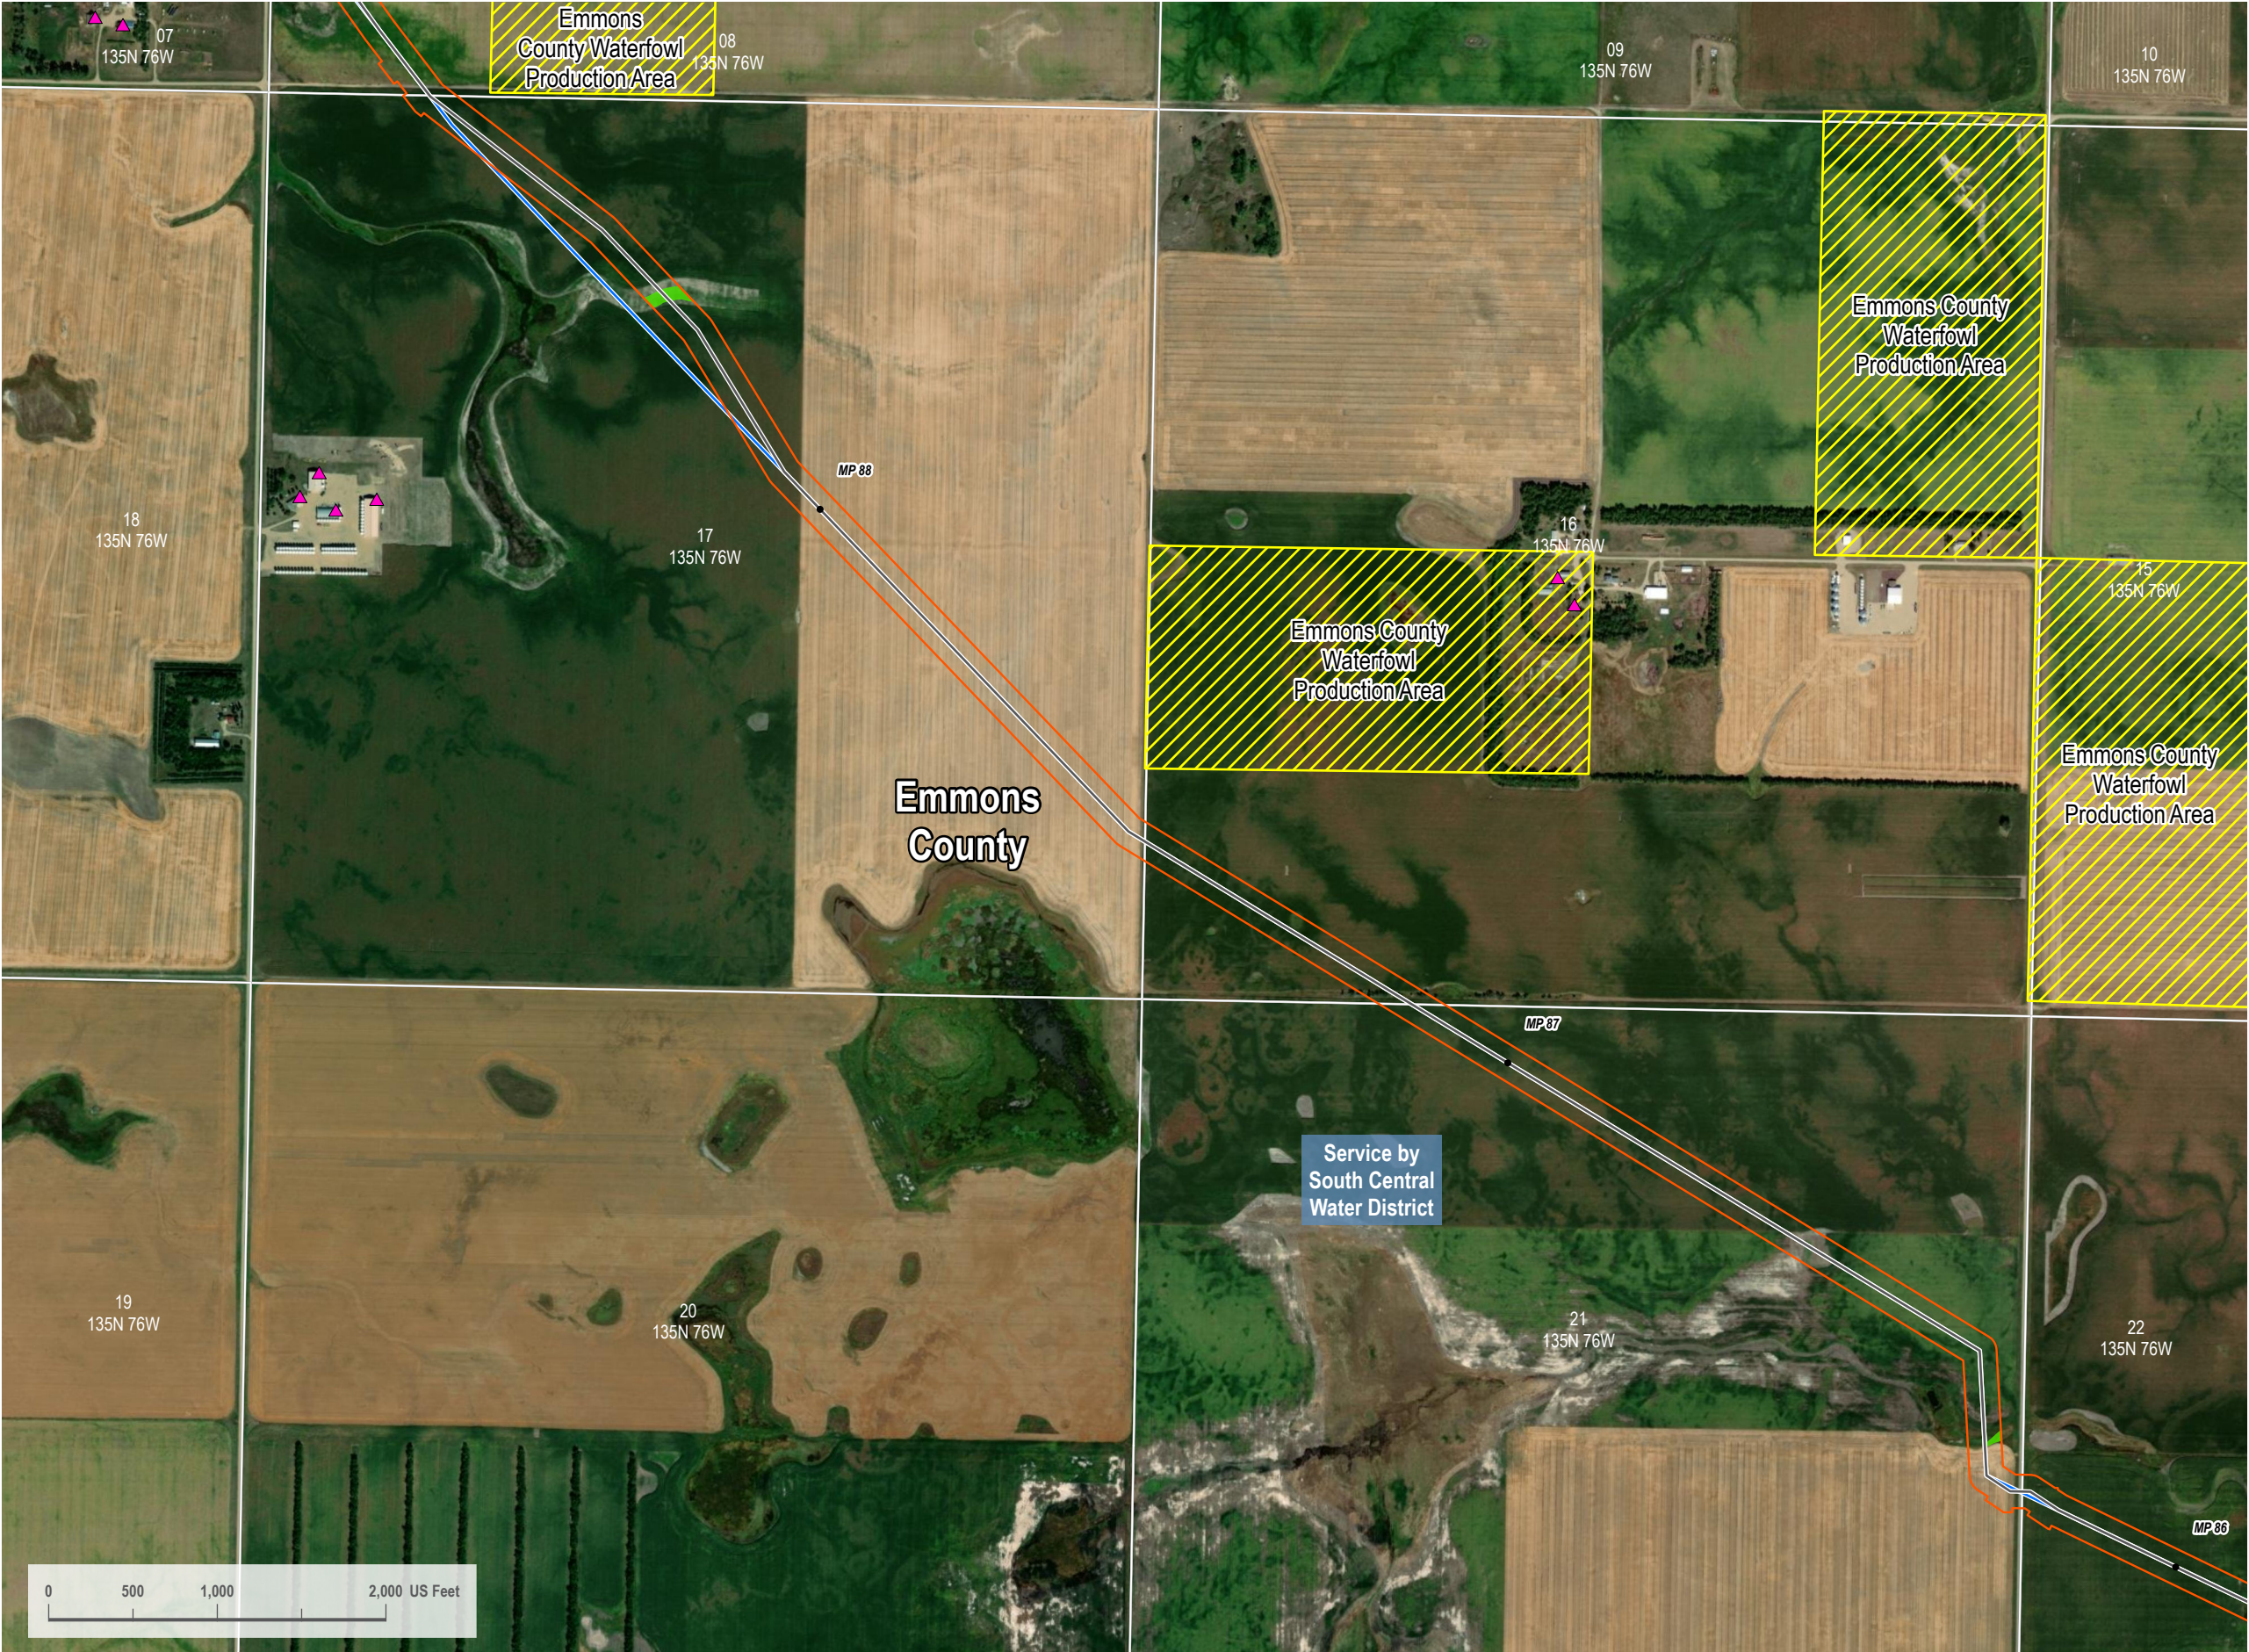

VICINITY MAP



LEGEND

- Centerline Mileposts
- Domestic Structure or Business (Avoidance)
- Updated Proposed Project Route 08/15/2023
- October 17, 2023 Original PSC Application Route
- Section Line
- PEM Wetland
- 200-foot Stiling Corridor
- Resource Management Area



REVISIONS

Date:	2023-08-17	Revised by:	CW	Checked by:	RC
A - Issued for Review					
Date:		Revised by:		Checked by:	
Date:		Revised by:		Checked by:	

PREPARED BY

**Summit Carbon Solutions**  
2321 North Loop Drive, Suite 221  
Ames, Iowa 50010  
United States of America  
[www.summitcarbonsolutions.com](http://www.summitcarbonsolutions.com)




**SUMMIT CARBON**  
SOLUTIONS

PROJECT INFORMATION

Figure Title: <b>ND PSC - Aerial Map Book - NDM-106</b>	
Figure Number: <b>Map Book 1</b>	
Scale: <b>1 : 12,000</b> 1 inch equals 1,000 feet	Projection: <b>Transverse Mercator</b> NAD 1983 UTM Zone 14N
Sheet: <b>27</b> 27 of 139	Drawing Number: <b>1001-01-003</b> Revision A



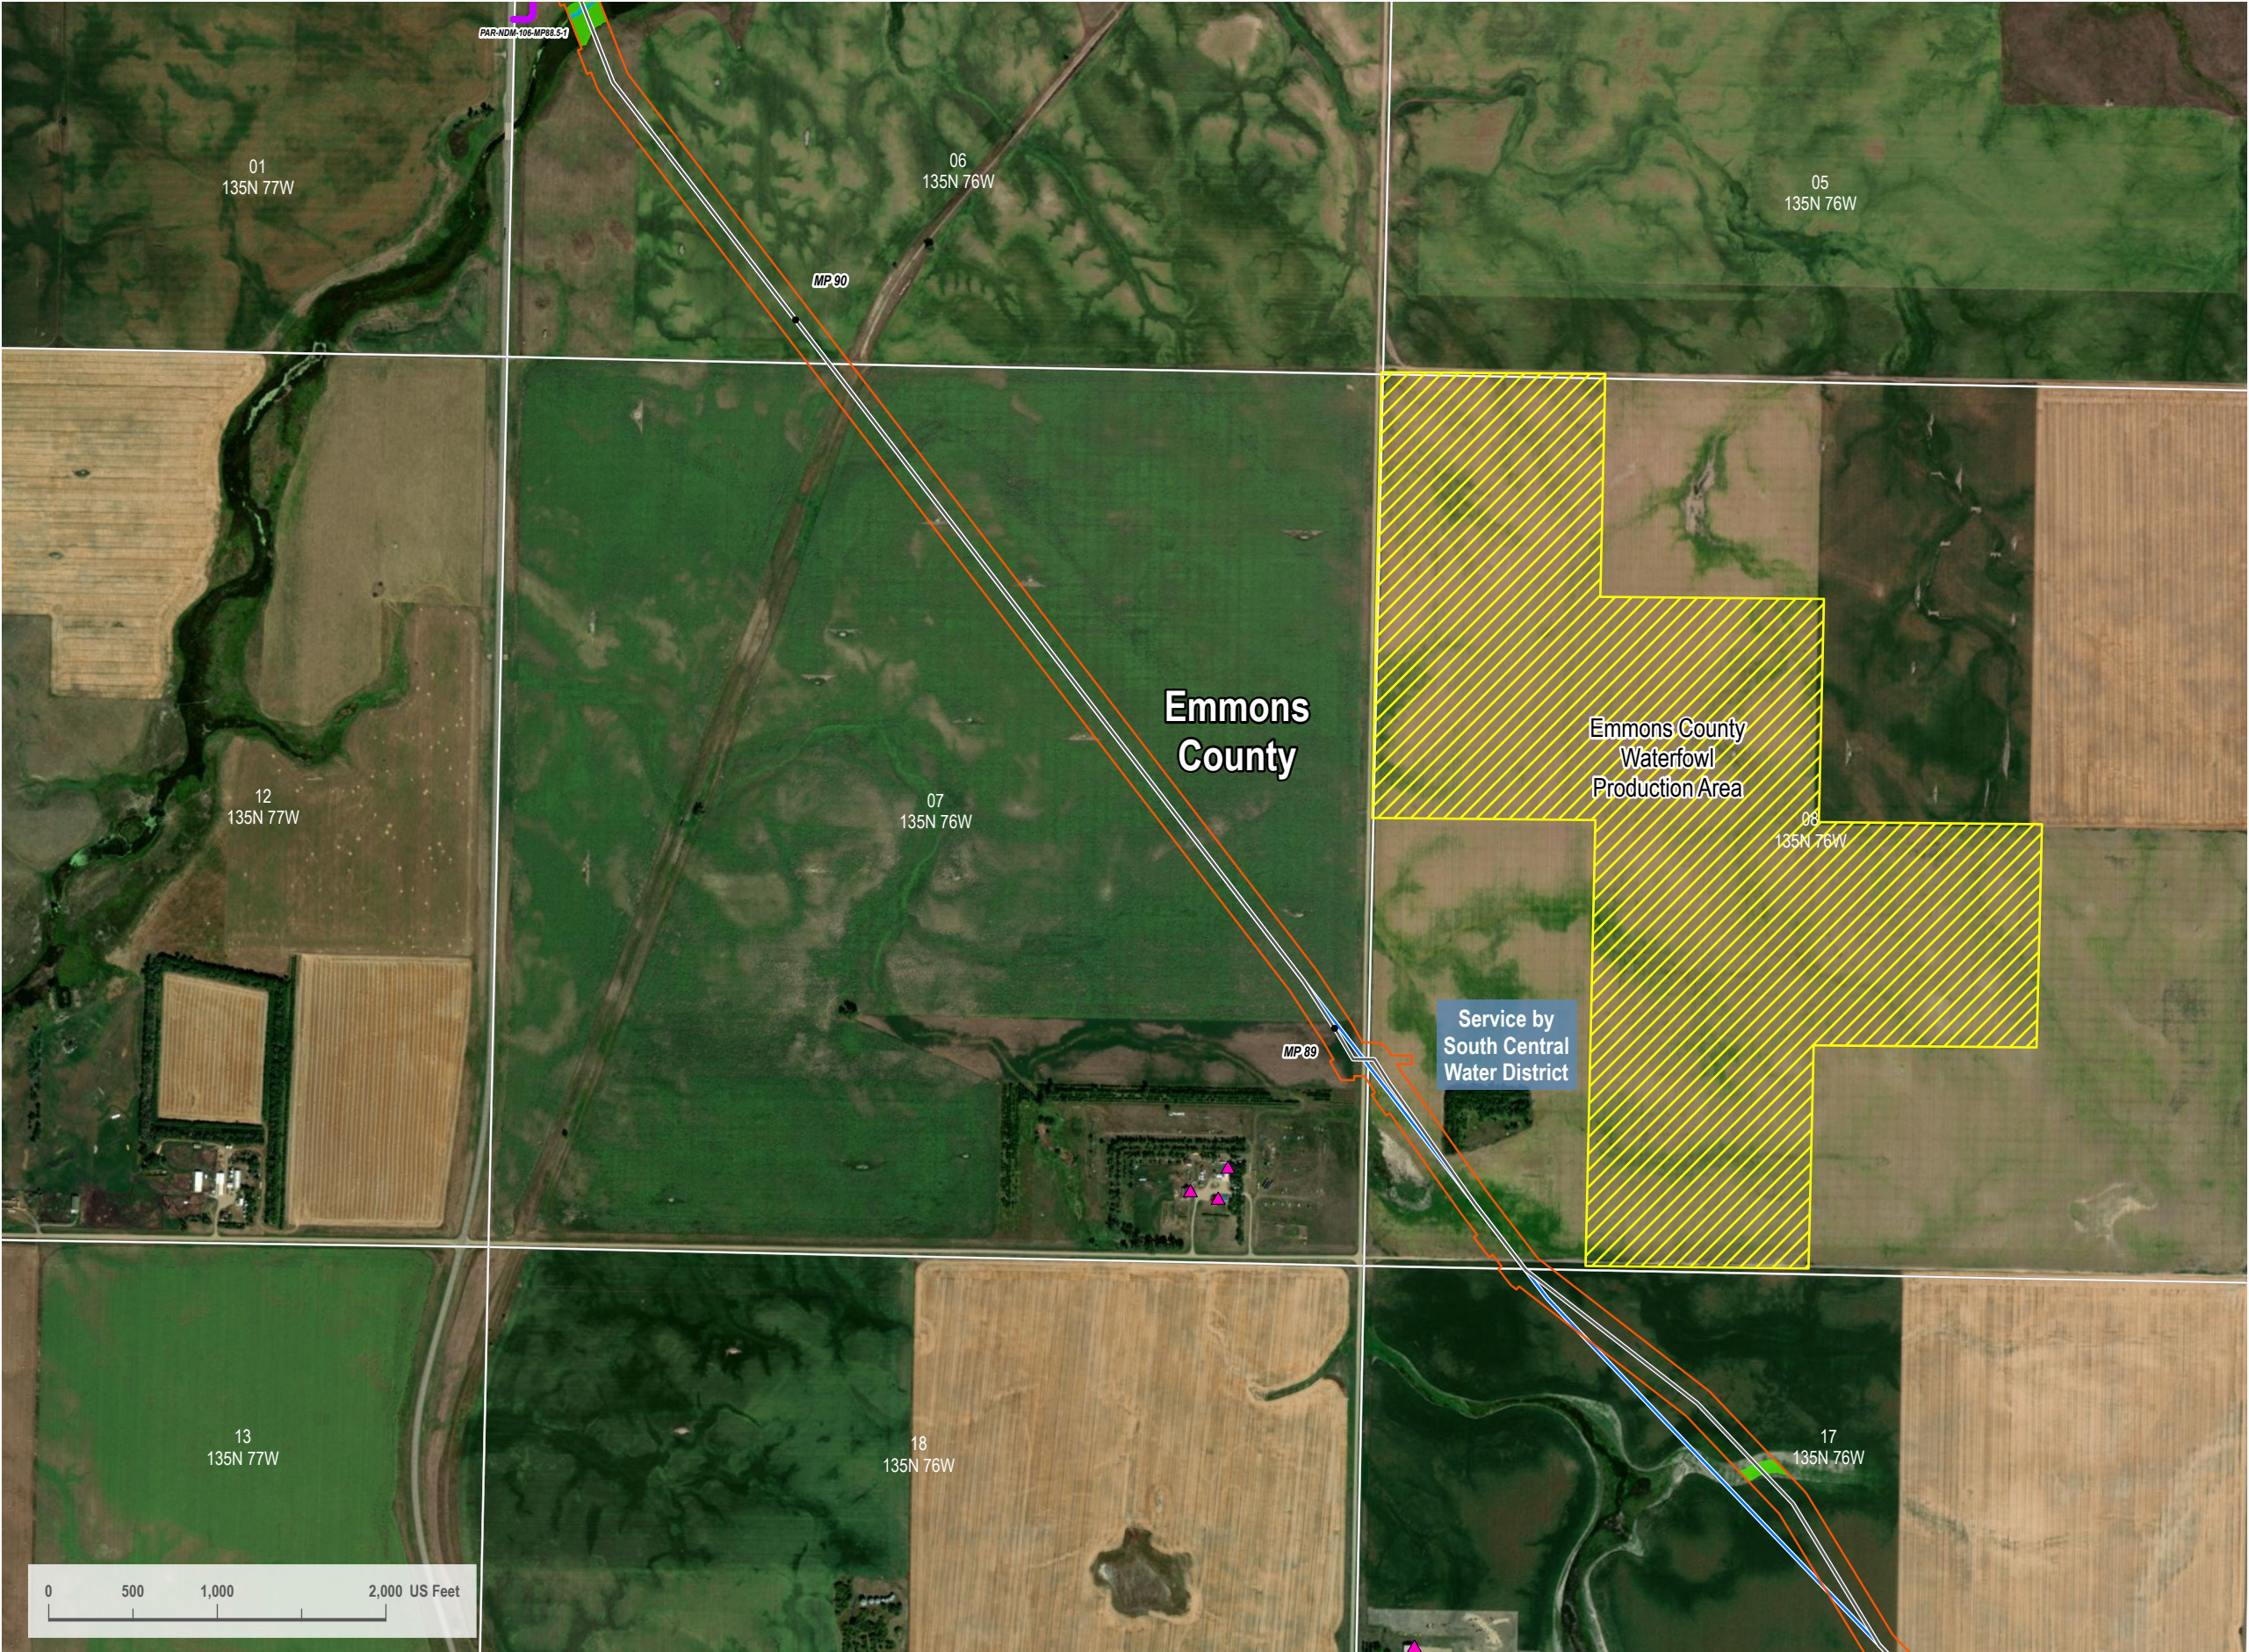

VICINITY MAP



LEGEND

- Centerline Mileposts
- Domestic Structure or Business (Avoidance)
- Updated Proposed Project Route 08/15/2023
- October 17, 2023 Original PSC Application Route
- Section Line
- Access Road
- PEM Wetland
- Stream
- 200-foot Siting Corridor
- Resource Management Area



REVISIONS

Date: 2023-08-17	Revised by: CW	Checked by: RC
A - Issued for Review		
Date:	Revised by:	Checked by:
Date:	Revised by:	Checked by:

PREPARED BY

**Summit Carbon Solutions**  
 2321 North Loop Drive, Suite 221  
 Ames, Iowa 50010  
 United States of America  
[www.summitcarbonsolutions.com](http://www.summitcarbonsolutions.com)



**SUMMIT CARBON SOLUTIONS**

PROJECT INFORMATION

Figure Title: <b>ND PSC - Aerial Map Book - NDM-106</b>	
Figure Number: <b>Map Book 1</b>	
Scale: <b>1 : 12,000</b> 1 inch equals 1,000 feet	Projection: <b>Transverse Mercator</b> NAD 1983 UTM Zone 14N
Sheet: <b>28</b> 28 of 139	Drawing Number: <b>1001-01-003</b> Revision A





VICINITY MAP

LEGEND

- Centerline Mileposts
- Mainline Valve Location
- Updated Proposed Project Route 08/15/2023
- October 17, 2023 Original PSC Application Route
- Section Line
- Access Road
- PEM Wetland
- Stream
- 200-foot Stiling Corridor

REVISIONS

Date: 2023-08-17	Revised by: CW	Checked by: RC
A - Issued for Review		
Date:	Revised by:	Checked by:
Date:	Revised by:	Checked by:

PREPARED BY

Summit Carbon Solutions

2321 North Loop Drive, Suite 221  
Ames, Iowa 50010  
United States of America

www.summitcarbonsolutions.com

PROJECT INFORMATION

Figure Title:  
ND PSC - Aerial Map Book - NDM-106

Figure Number:  
Map Book 1

Scale: 1 : 12,000 1 inch equals 1,000 feet	Projection: Transverse Mercator NAD 1983 UTM Zone 14N
Sheet: 29 29 of 139	Drawing Number: 1001-01-003 Revision A





VICINITY MAP



LEGEND

- Centerline Mileposts
- Domestic Structure or Business (Avoidance)
- Updated Proposed Project Route 08/15/2023
- October 17, 2023 Original PSC Application Route
- Section Line
- PEM Wetland
- Stream
- 200-foot Siting Corridor



REVISIONS

Date: 2023-08-17	Revised by: CW	Checked by: RC
A - Issued for Review		
Date:	Revised by:	Checked by:
Date:	Revised by:	Checked by:

PREPARED BY

**Summit Carbon Solutions**  
2321 North Loop Drive, Suite 221  
Ames, Iowa 50010  
United States of America  
[www.summitcarbonsolutions.com](http://www.summitcarbonsolutions.com)



**SUMMIT CARBON**  
SOLUTIONS

PROJECT INFORMATION

Figure Title: <b>ND PSC - Aerial Map Book - NDM-106</b>	
Figure Number: <b>Map Book 1</b>	
Scale: <b>1 : 12,000</b> 1 inch equals 1,000 feet	Projection: <b>Transverse Mercator</b> NAD 1983 UTM Zone 14N
Sheet: <b>30</b> 30 of 139	Drawing Number: <b>1001-01-003</b> Revision A





VICINITY MAP

LEGEND

Centerline Mileposts	Open Water
Water Well (Avoidance)	PEM Wetland
Domestic Structure or Business (Avoidance)	Stream
Updated Proposed Project Route 08/15/2023	200-foot Siting Corridor
October 17, 2023 Original PSC Application Route	Resource Management Area
Section Line	State Resource Management Area

REVISIONS

Date: 2023-08-17	Revised by: CW	Checked by: RC
A - Issued for Review		
Date:	Revised by:	Checked by:
Date:	Revised by:	Checked by:

PREPARED BY

Summit Carbon Solutions

2321 North Loop Drive, Suite 221  
Ames, Iowa 50010  
United States of America  
[www.summitcarbonsolutions.com](http://www.summitcarbonsolutions.com)


PROJECT INFORMATION

Figure Title:  
ND PSC - Aerial Map Book - NDM-106

Figure Number:  
Map Book 1

Scale: 1 : 12,000 1 inch equals 1,000 feet	Projection: Transverse Mercator NAD 1983 UTM Zone 14N
Sheet: 31 31 of 139	Drawing Number: 1001-01-003 Revision A



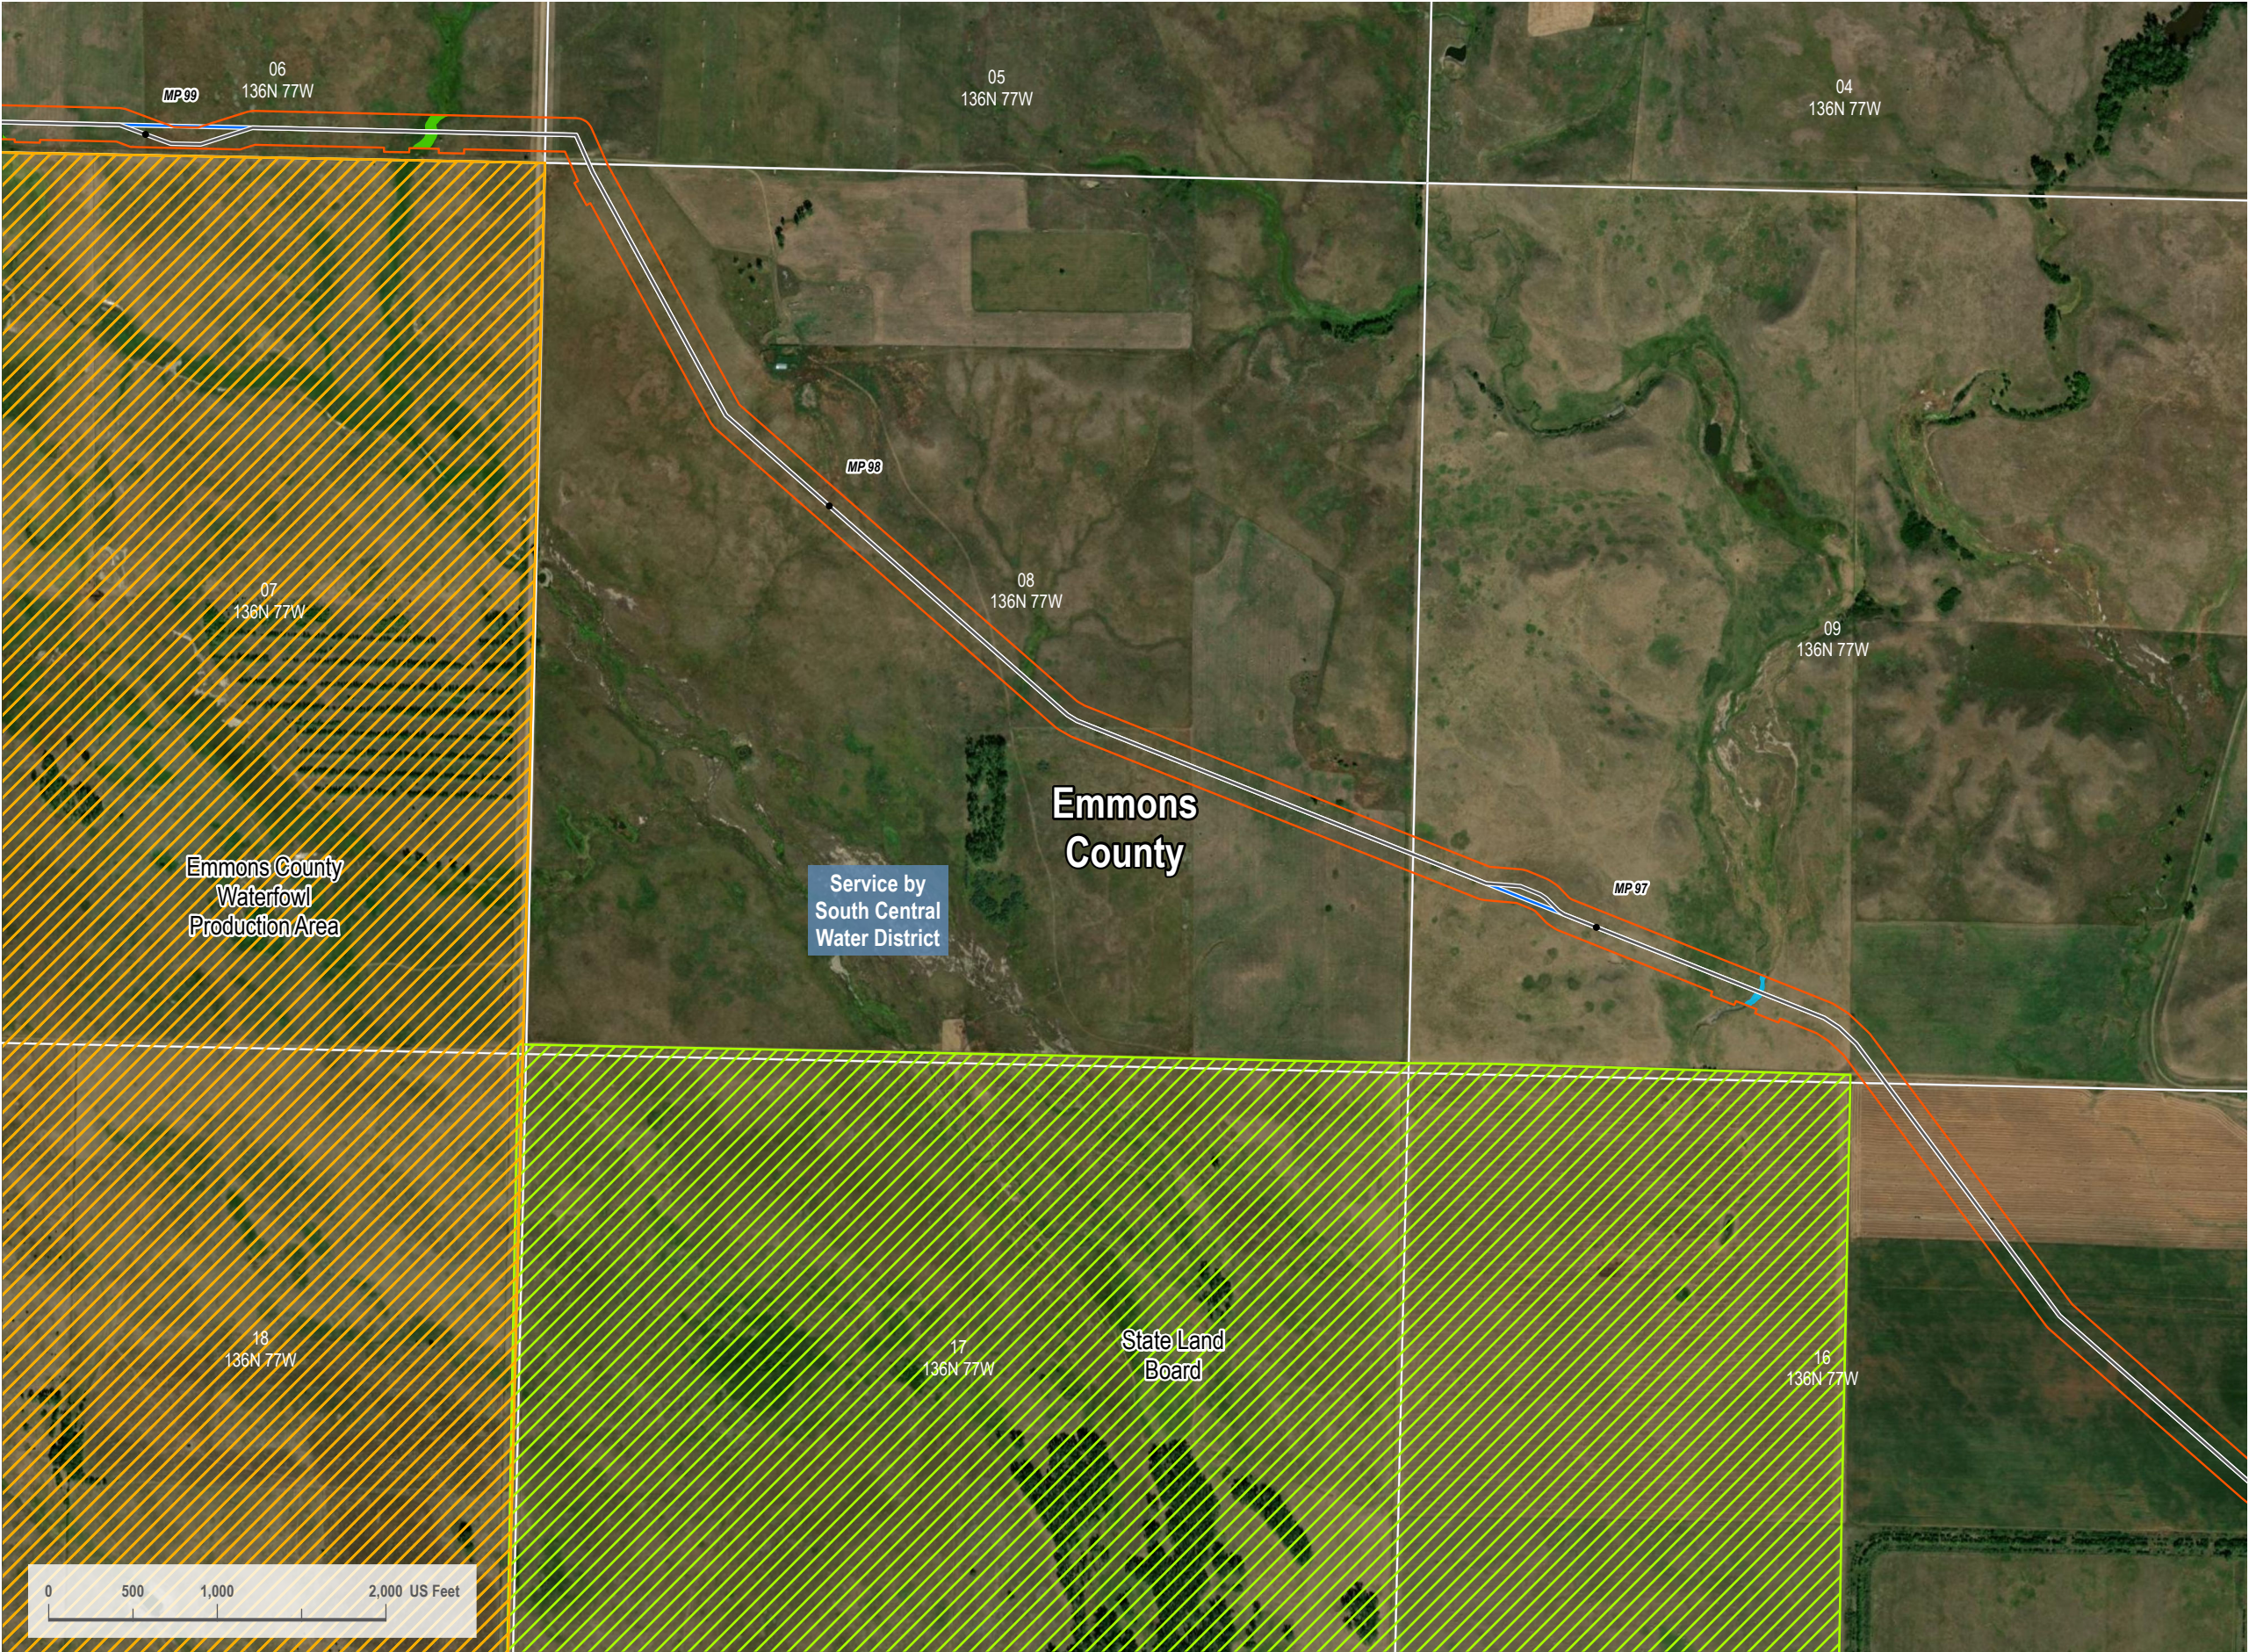

VICINITY MAP



LEGEND

- Centerline Mileposts
- Updated Proposed Project Route 08/15/2023
- October 17, 2023 Original PSC Application Route
- Section Line
- Avoidance Area
- PEM Wetland
- Stream
- 200-foot Siltation Corridor
- Resource Management Area
- State Resource Management Area



REVISIONS

Date:	2023-08-17	Revised by:	CW	Checked by:	RC
A - Issued for Review					
Date:		Revised by:		Checked by:	
Date:		Revised by:		Checked by:	

PREPARED BY

**Summit Carbon Solutions**  
2321 North Loop Drive, Suite 221  
Ames, Iowa 50010  
United States of America  
[www.summitcarbonsolutions.com](http://www.summitcarbonsolutions.com)



**SUMMIT CARBON**  
SOLUTIONS

PROJECT INFORMATION

Figure Title: <b>ND PSC - Aerial Map Book - NDM-106</b>	
Figure Number: <b>Map Book 1</b>	
Scale: <b>1 : 12,000</b> 1 inch equals 1,000 feet	Projection: <b>Transverse Mercator</b> NAD 1983 UTM Zone 14N
Sheet: <b>32</b> 32 of 139	Drawing Number: <b>1001-01-003</b> Revision A





VICINITY MAP

North Dakota

South Dakota

LEGEND

Centerline Mileposts	Avoidance Area
Domestic Structure or Business (Avoidance)	PEM Wetland
Updated Proposed Project Route 08/15/2023	PSS Wetland
October 17, 2023 Original PSC Application Route	200-foot Siting Corridor
Section Line	Resource Management Area

REVISIONS

Date: 2023-08-17	Revised by: CW	Checked by: RC
A - Issued for Review		
Date:	Revised by:	Checked by:
Date:	Revised by:	Checked by:

PREPARED BY

Summit Carbon Solutions

2321 North Loop Drive, Suite 221  
Ames, Iowa 50010  
United States of America

[www.summitcarbonsolutions.com](http://www.summitcarbonsolutions.com)

PROJECT INFORMATION

Figure Title:

ND PSC - Aerial Map Book - NDM-106

Figure Number:

Map Book 1

Scale:	Projection:
1 : 12,000	Transverse Mercator
1 inch equals 1,000 feet	NAD 1983 UTM Zone 14N
Sheet:	Drawing Number:
33	1001-01-003
33 of 139	Revision A






VICINITY MAP



LEGEND

- Centerline Mileposts
- Domestic Structure or Business (Avoidance)
- Updated Proposed Project Route 08/15/2023
- October 17, 2023 Original PSC Application Route
- Section Line
- 200-foot Siting Corridor
- State Resource Management Area

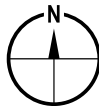

REVISIONS

Date:	2023-08-17	Revised by:	CW	Checked by:	RC
A - Issued for Review					
Date:		Revised by:		Checked by:	
Date:		Revised by:		Checked by:	

PREPARED BY

**Summit Carbon Solutions**  
2321 North Loop Drive, Suite 221  
Ames, Iowa 50010  
United States of America  
[www.summitcarbonsolutions.com](http://www.summitcarbonsolutions.com)



**SUMMIT CARBON**  
SOLUTIONS

PROJECT INFORMATION

Figure Title: <b>ND PSC - Aerial Map Book - NDM-106</b>	
Figure Number: <b>Map Book 1</b>	
Scale: <b>1 : 12,000</b> 1 inch equals 1,000 feet	Projection: <b>Transverse Mercator</b> NAD 1983 UTM Zone 14N
Sheet: <b>34</b> 34 of 139	Drawing Number: <b>1001-01-003</b> Revision A





VICINITY MAP



LEGEND

- Centerline Mileposts
- Updated Proposed Project Route 08/15/2023
- October 17, 2023 Original PSC Application Route
- Section Line
- Open Water
- PEM Wetland
- 200-foot Siting Corridor
- State Resource Management Area



REVISIONS

Date:	2023-08-17	Revised by:	CW	Checked by:	RC
A - Issued for Review					
Date:		Revised by:		Checked by:	
Date:		Revised by:		Checked by:	

PREPARED BY

**Summit Carbon Solutions**  
2321 North Loop Drive, Suite 221  
Ames, Iowa 50010  
United States of America  
[www.summitcarbonsolutions.com](http://www.summitcarbonsolutions.com)



**SUMMIT CARBON**  
SOLUTIONS

PROJECT INFORMATION

Figure Title: <b>ND PSC - Aerial Map Book - NDM-106</b>	
Figure Number: <b>Map Book 1</b>	
Scale: <b>1 : 12,000</b> 1 inch equals 1,000 feet	Projection: <b>Transverse Mercator</b> NAD 1983 UTM Zone 14N
Sheet: <b>35</b> 35 of 139	Drawing Number: <b>1001-01-003</b> Revision A





VICINITY MAP



LEGEND

- Centerline Mileposts
- Mainline Valve Location
- Domestic Structure or Business (Avoidance)
- Updated Proposed Project Route 08/15/2023
- October 17, 2023 Original PSC Application Route
- Section Line
- Access Road
- Facility Boundary
- Avoidance Area
- PEM Wetland
- PSS Wetland
- 200-foot Siting Corridor
- State Resource Management Area



REVISIONS

Date:	2023-08-17	Revised by:	CW	Checked by:	RC
A - Issued for Review					
Date:		Revised by:		Checked by:	
Date:		Revised by:		Checked by:	

PREPARED BY

**Summit Carbon Solutions**  
2321 North Loop Drive, Suite 221  
Ames, Iowa 50010  
United States of America  
[www.summitcarbonsolutions.com](http://www.summitcarbonsolutions.com)




**SUMMIT CARBON**  
SOLUTIONS

PROJECT INFORMATION

Figure Title: <b>ND PSC - Aerial Map Book - NDM-106</b>	
Figure Number: <b>Map Book 1</b>	
Scale: <b>1 : 12,000</b> 1 inch equals 1,000 feet	Projection: <b>Transverse Mercator</b> NAD 1983 UTM Zone 14N
Sheet: <b>36</b> 36 of 139	Drawing Number: <b>1001-01-003</b> Revision A



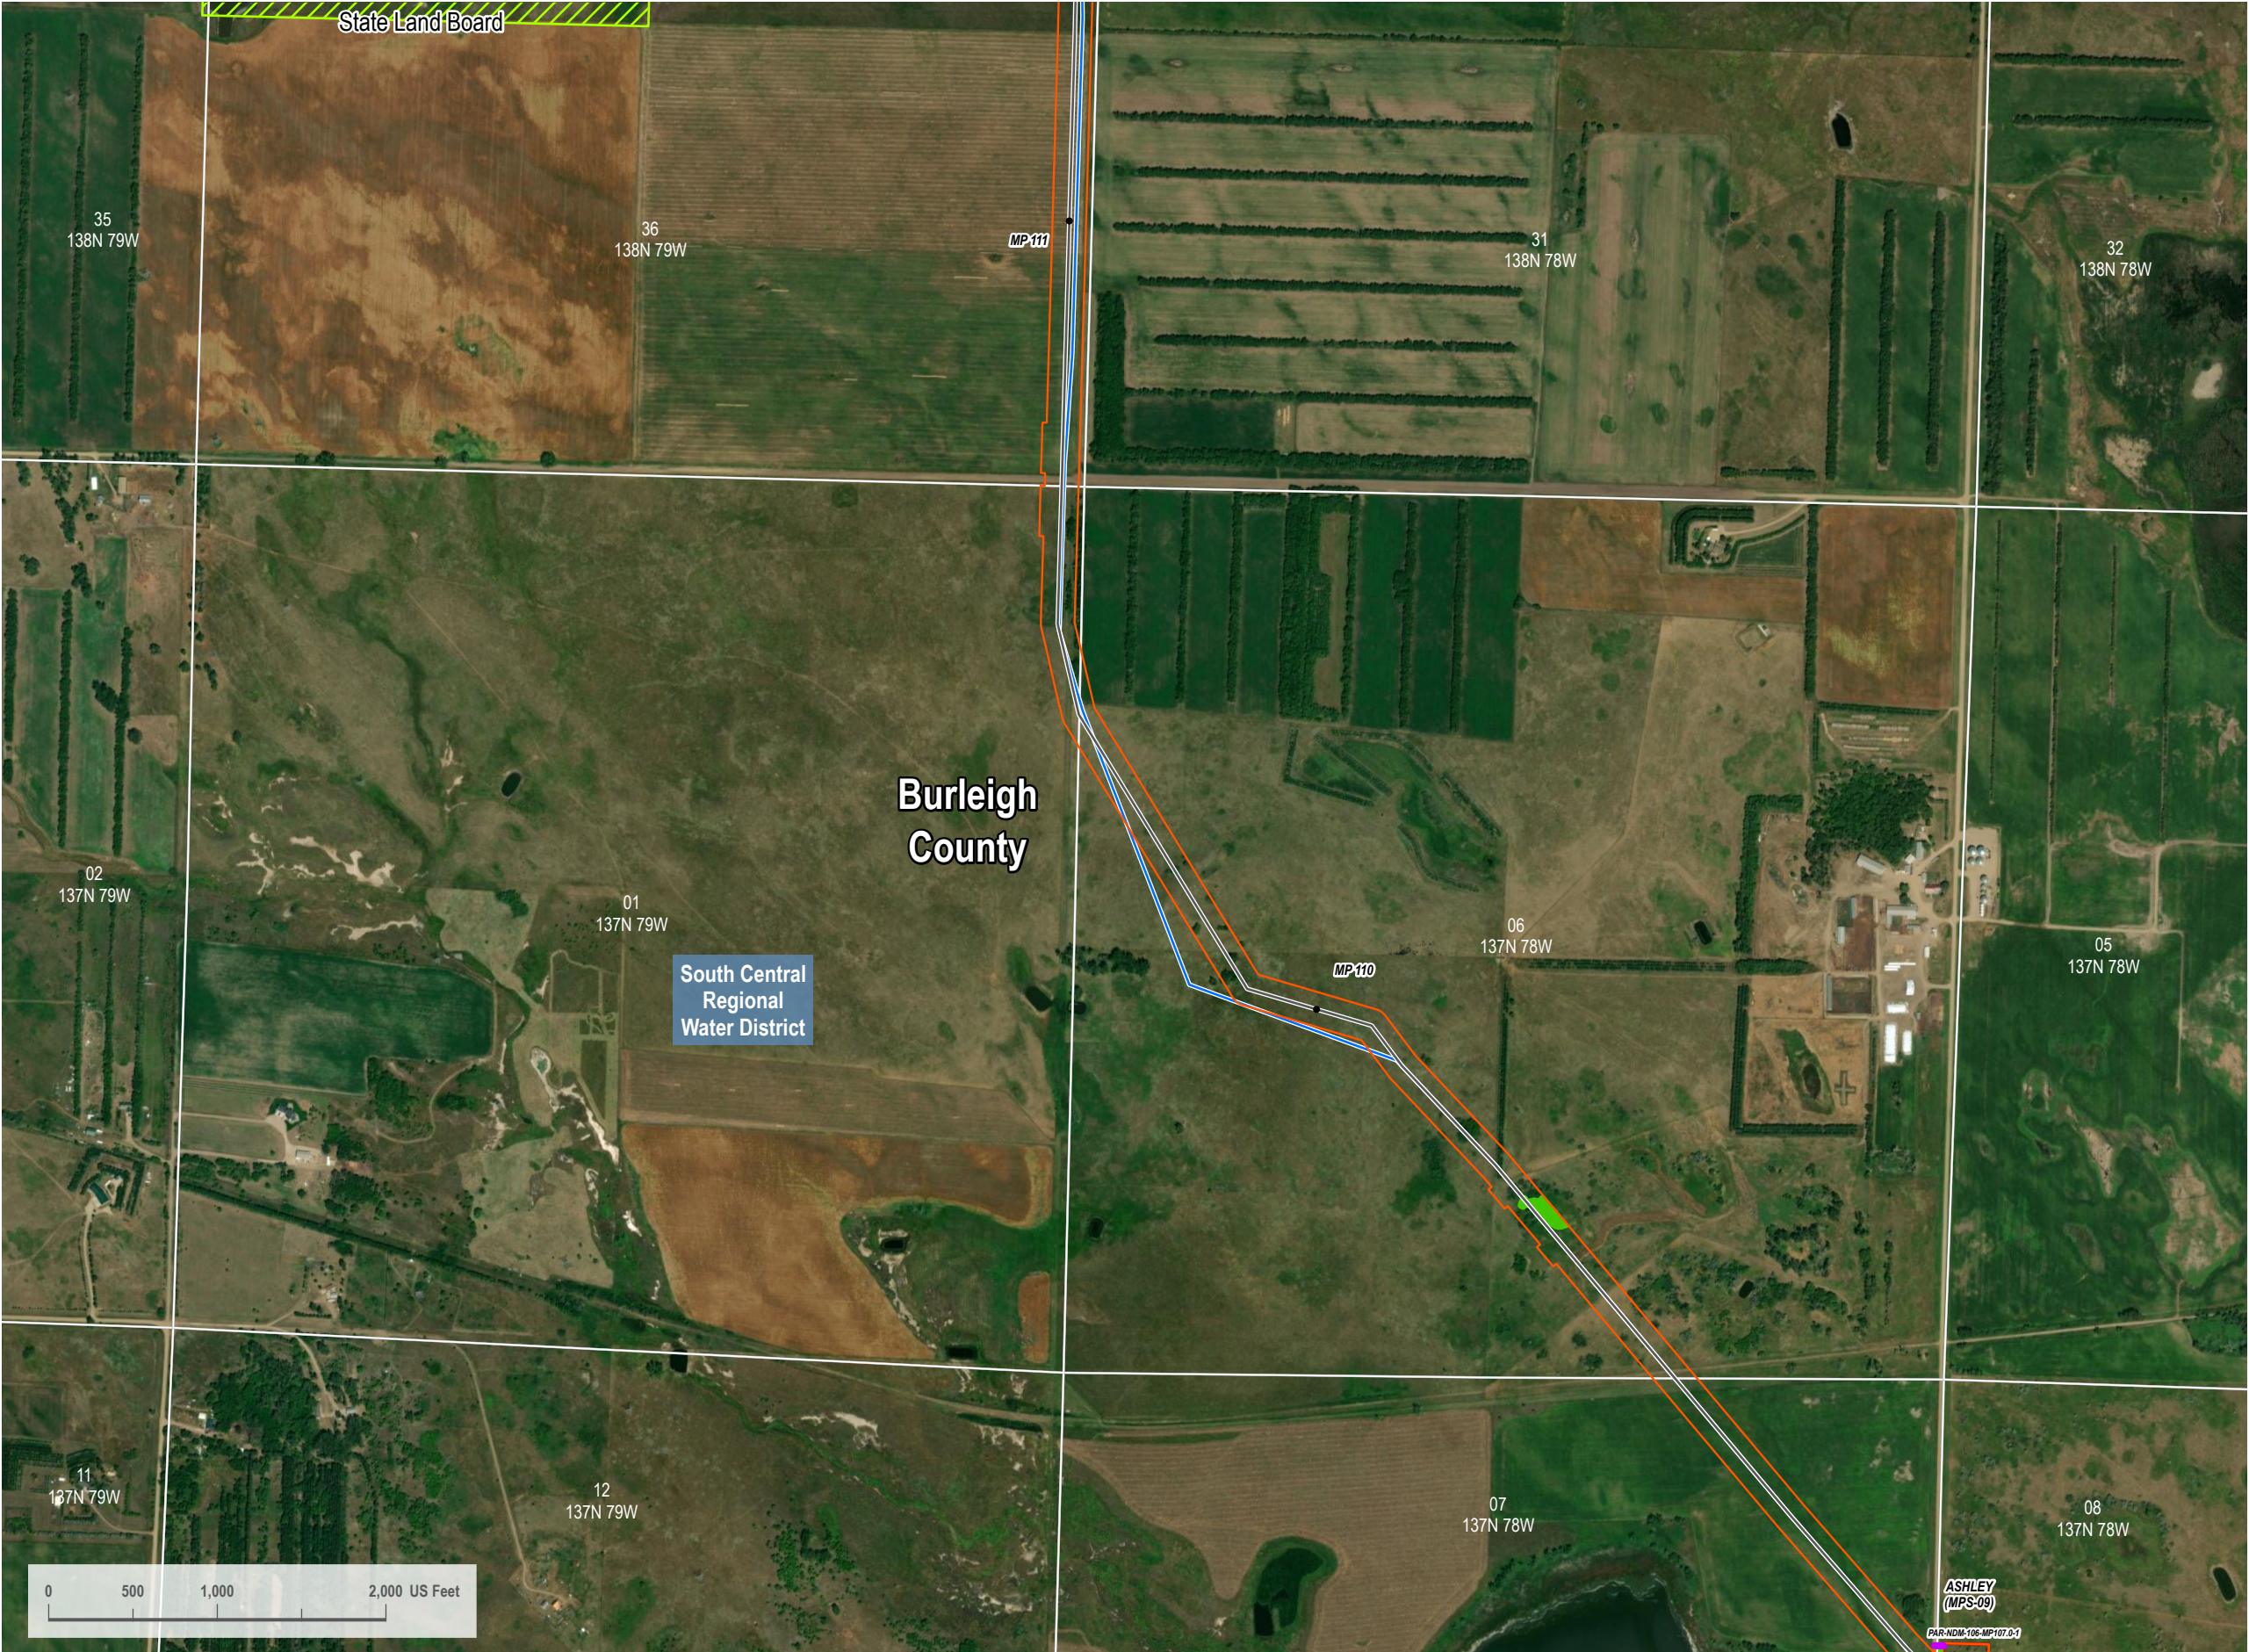


VICINITY MAP



LEGEND

- Centerline Mileposts
- Updated Proposed Project Route 08/15/2023
- October 17, 2023 Original PSC Application Route
- Section Line
- Access Road
- Facility Boundary
- PEM Wetland
- 200-foot Stiling Corridor
- State Resource Management Area

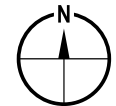

REVISIONS

Date: 2023-08-17	Revised by: CW	Checked by: RC
A - Issued for Review		
Date:	Revised by:	Checked by:
Date:	Revised by:	Checked by:

PREPARED BY

**Summit Carbon Solutions**  
2321 North Loop Drive, Suite 221  
Ames, Iowa 50010  
United States of America  
[www.summitcarbonsolutions.com](http://www.summitcarbonsolutions.com)



**SUMMIT CARBON SOLUTIONS**

PROJECT INFORMATION

Figure Title: <b>ND PSC - Aerial Map Book - NDM-106</b>	
Figure Number: <b>Map Book 1</b>	
Scale: <b>1 : 12,000</b> 1 inch equals 1,000 feet	Projection: <b>Transverse Mercator</b> NAD 1983 UTM Zone 14N
Sheet: <b>37</b> 37 of 139	Drawing Number: <b>1001-01-003</b> Revision A





VICINITY MAP



LEGEND

- Centerline Mileposts
- Domestic Structure or Business (Avoidance)
- Updated Proposed Project Route 08/15/2023
- October 17, 2023 Original PSC Application Route
- Section Line
- Avoidance Area
- Open Water
- PEM Wetland
- Stream
- 200-foot Siting Corridor
- State Resource Management Area



REVISIONS

Date:	2023-08-17	Revised by:	CW	Checked by:	RC
A - Issued for Review					
Date:		Revised by:		Checked by:	
Date:		Revised by:		Checked by:	

PREPARED BY

**Summit Carbon Solutions**  
2321 North Loop Drive, Suite 221  
Ames, Iowa 50010  
United States of America  
[www.summitcarbonsolutions.com](http://www.summitcarbonsolutions.com)

PROJECT INFORMATION

Figure Title: <b>ND PSC - Aerial Map Book - NDM-106</b>	
Figure Number: <b>Map Book 1</b>	
Scale: <b>1 : 12,000</b> 1 inch equals 1,000 feet	Projection: <b>Transverse Mercator</b> NAD 1983 UTM Zone 14N
Sheet: <b>38</b> 38 of 139	Drawing Number: <b>1001-01-003</b> Revision A






VICINITY MAP



LEGEND

- Centerline Mileposts
- Domestic Structure or Business (Avoidance)
- Updated Proposed Project Route 08/15/2023
- October 17, 2023 Original PSC Application Route
- Section Line
- Avoidance Area
- PEM Wetland
- 200-foot Siting Corridor

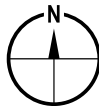

REVISIONS

Date: 2023-08-17 Revised by: CW Checked by: RC  
A - Issued for Review

Date: Revised by: Checked by:

Date: Revised by: Checked by:

PREPARED BY

**Summit Carbon Solutions**  
2321 North Loop Drive, Suite 221  
Ames, Iowa 50010  
United States of America  
[www.summitcarbonsolutions.com](http://www.summitcarbonsolutions.com)



**SUMMIT CARBON SOLUTIONS**

PROJECT INFORMATION

Figure Title:  
ND PSC - Aerial Map Book - NDM-106

Figure Number:  
Map Book 1

Scale:  
1 : 12,000  
1 inch equals 1,000 feet

Projection:  
Transverse Mercator  
NAD 1983 UTM Zone 14N

Sheet:  
39  
39 of 139

Drawing Number:  
1001-01-003  
Revision A






VICINITY MAP



LEGEND

- Centerline Mileposts
- Water Well (Avoidance)
- Domestic Structure or Business (Avoidance)
- Updated Proposed Project Route 08/15/2023
- October 17, 2023 Original PSC Application Route
- Section Line
- Avoidance Area
- 200-foot Siting Corridor

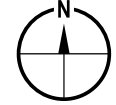

REVISIONS

Date: 2023-08-17	Revised by: CW	Checked by: RC
A - Issued for Review		
Date:	Revised by:	Checked by:
Date:	Revised by:	Checked by:

PREPARED BY

**Summit Carbon Solutions**  
2321 North Loop Drive, Suite 221  
Ames, Iowa 50010  
United States of America  
[www.summitcarbonsolutions.com](http://www.summitcarbonsolutions.com)




**SUMMIT CARBON**  
SOLUTIONS

PROJECT INFORMATION

Figure Title: <b>ND PSC - Aerial Map Book - NDM-106</b>	
Figure Number: <b>Map Book 1</b>	
Scale: <b>1 : 12,000</b> 1 inch equals 1,000 feet	Projection: <b>Transverse Mercator</b> NAD 1983 UTM Zone 14N
Sheet: <b>40</b> 40 of 139	Drawing Number: <b>1001-01-003</b> Revision A



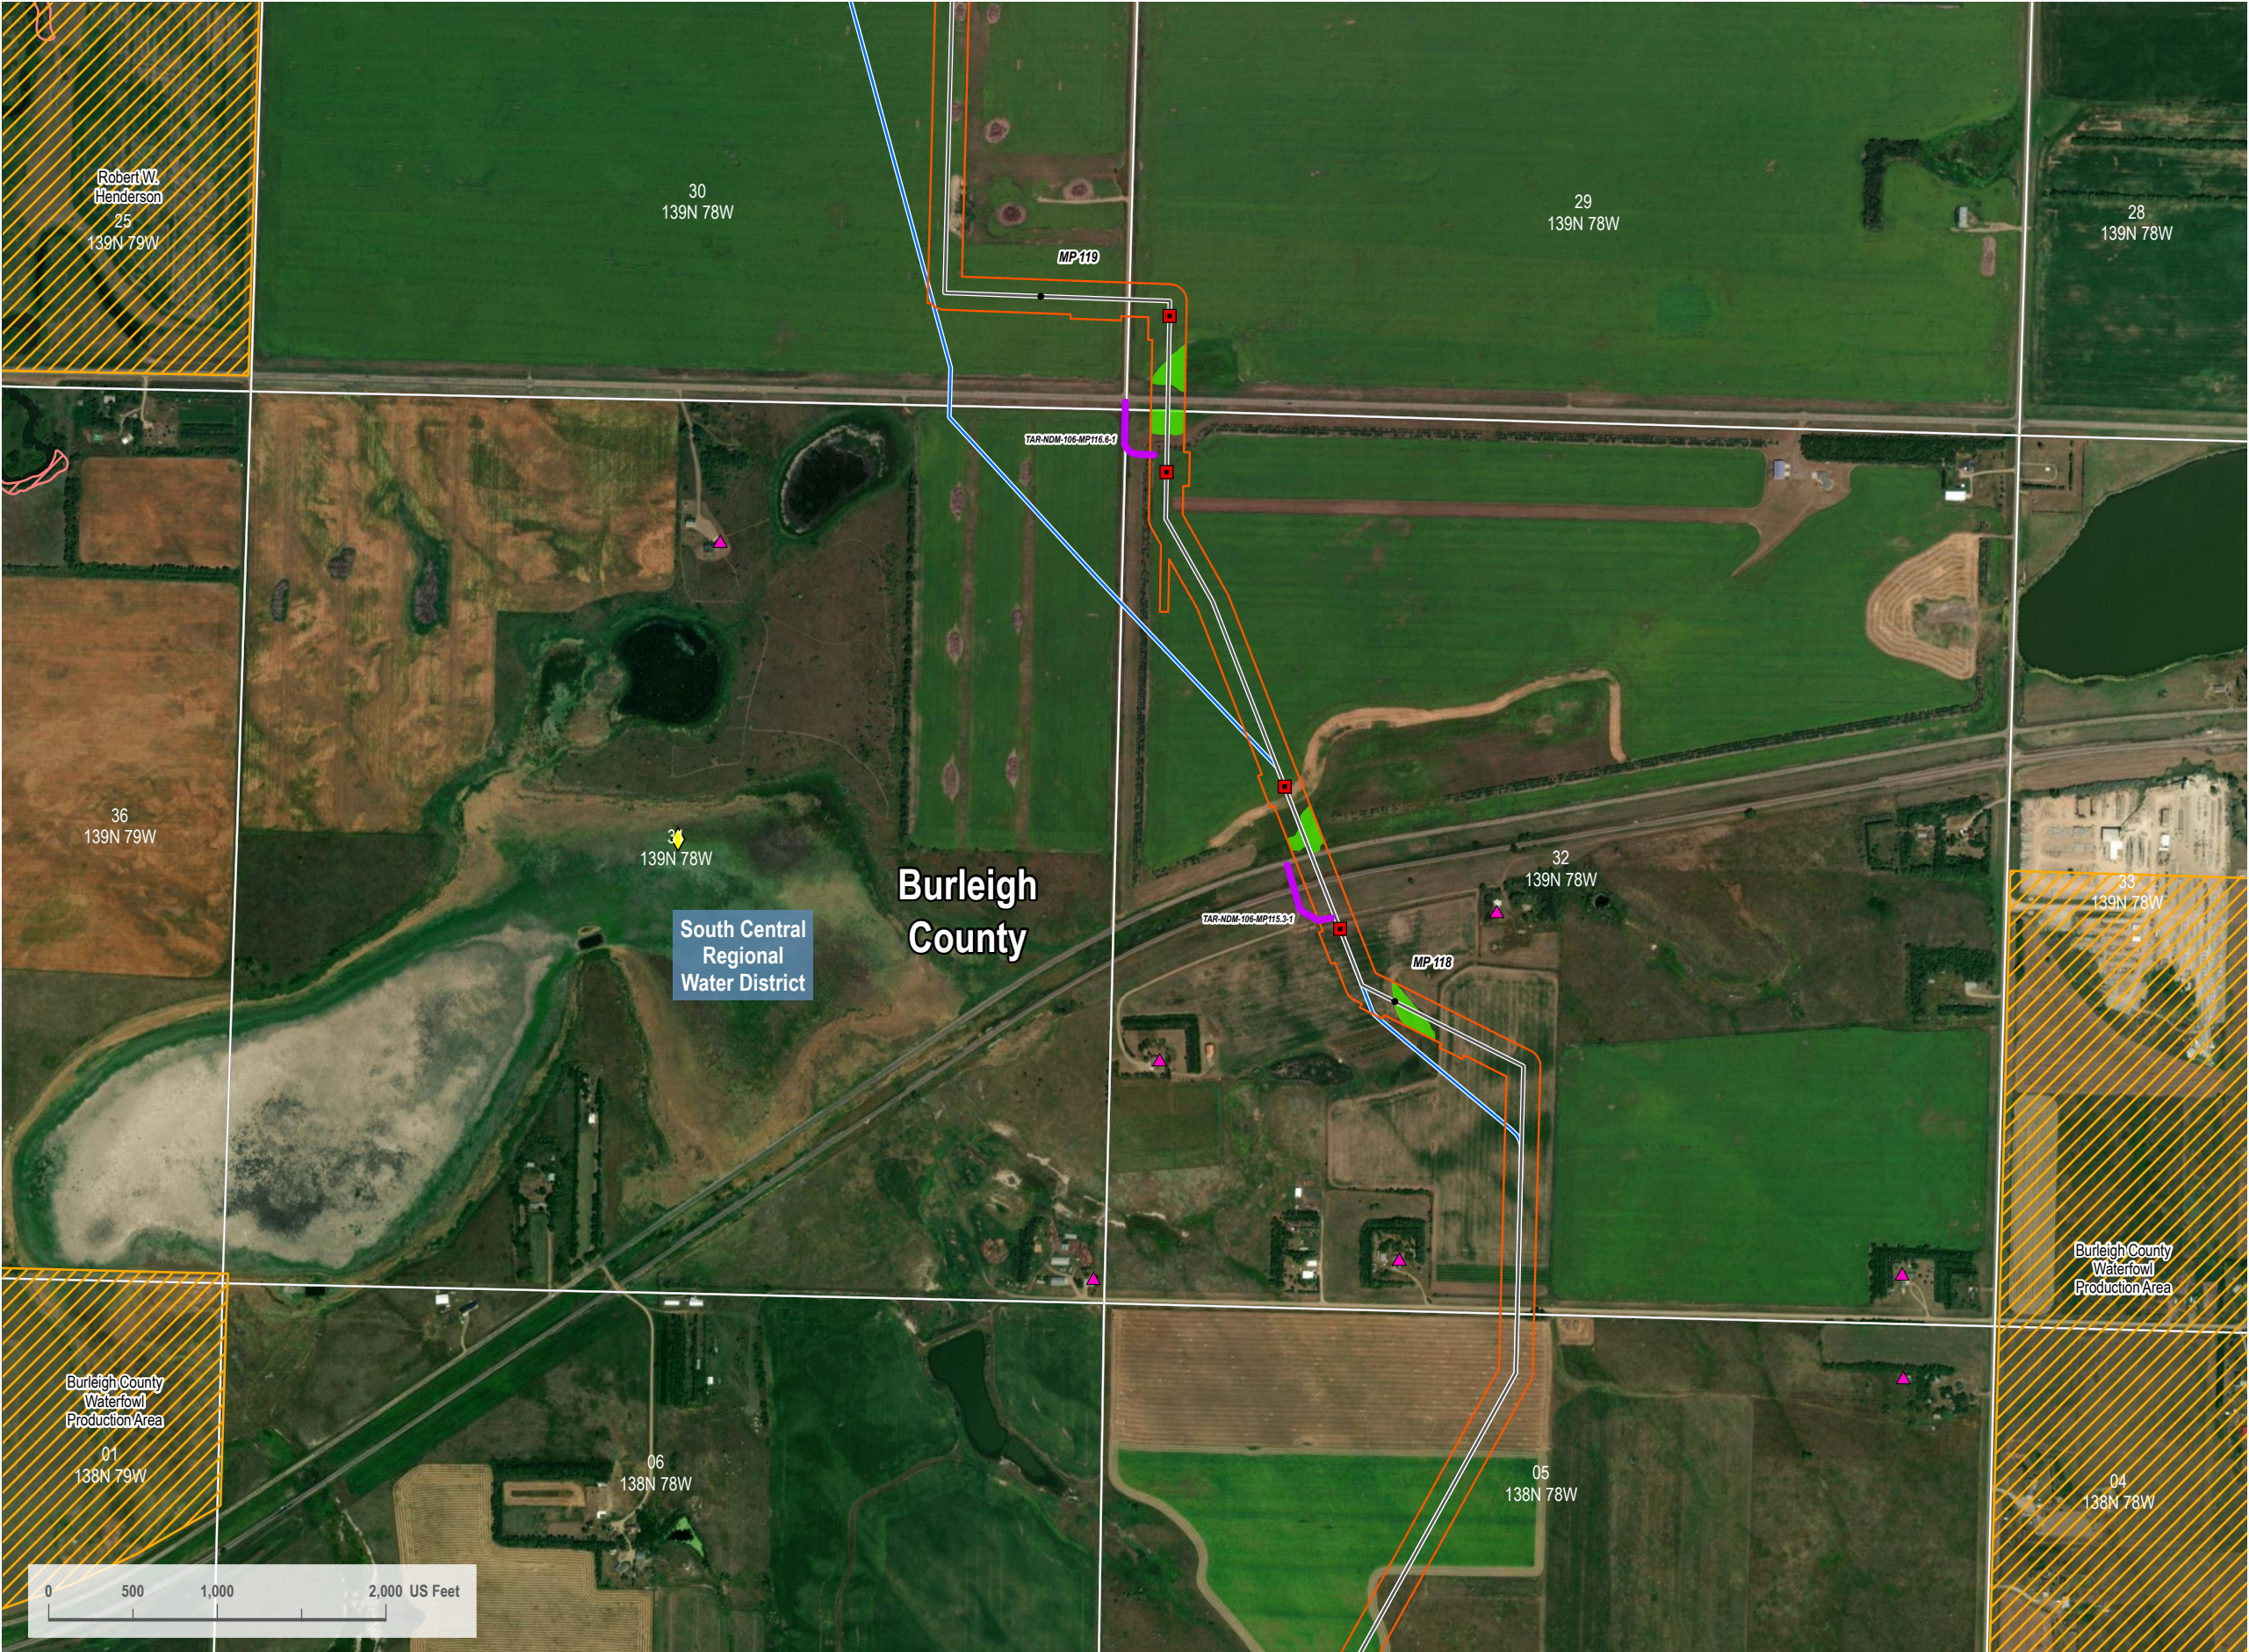

VICINITY MAP



LEGEND

- HDD Entry/Exit
- Centerline Mileposts
- Water Well (Avoidance)
- Domestic Structure or Business (Avoidance)
- Updated Proposed Project Route 08/15/2023
- October 17, 2023 Original PSC Application Route
- Section Line
- Access Road
- Landslide Deposit (Avoidance)
- Avoidance Area
- PEM Wetland
- 200-foot Siting Corridor



REVISIONS

Date: 2023-08-17 Revised by: CW Checked by: RC  
A - Issued for Review

Date: Revised by: Checked by:

Date: Revised by: Checked by:

PREPARED BY

Summit Carbon Solutions  
2321 North Loop Drive, Suite 221  
Ames, Iowa 50010  
United States of America  
www.summitcarbonsolutions.com

  
SUMMIT CARBON  
SOLUTIONS

PROJECT INFORMATION

Figure Title:  
ND PSC - Aerial Map Book - NDM-106

Figure Number:  
Map Book 1


Scale:  
1 : 12,000  
1 inch equals 1,000 feet

Projection:  
Transverse Mercator  
NAD 1983 UTM Zone 14N

Sheet:  
41  
41 of 139

Drawing Number:  
1001-01-003  
Revision A



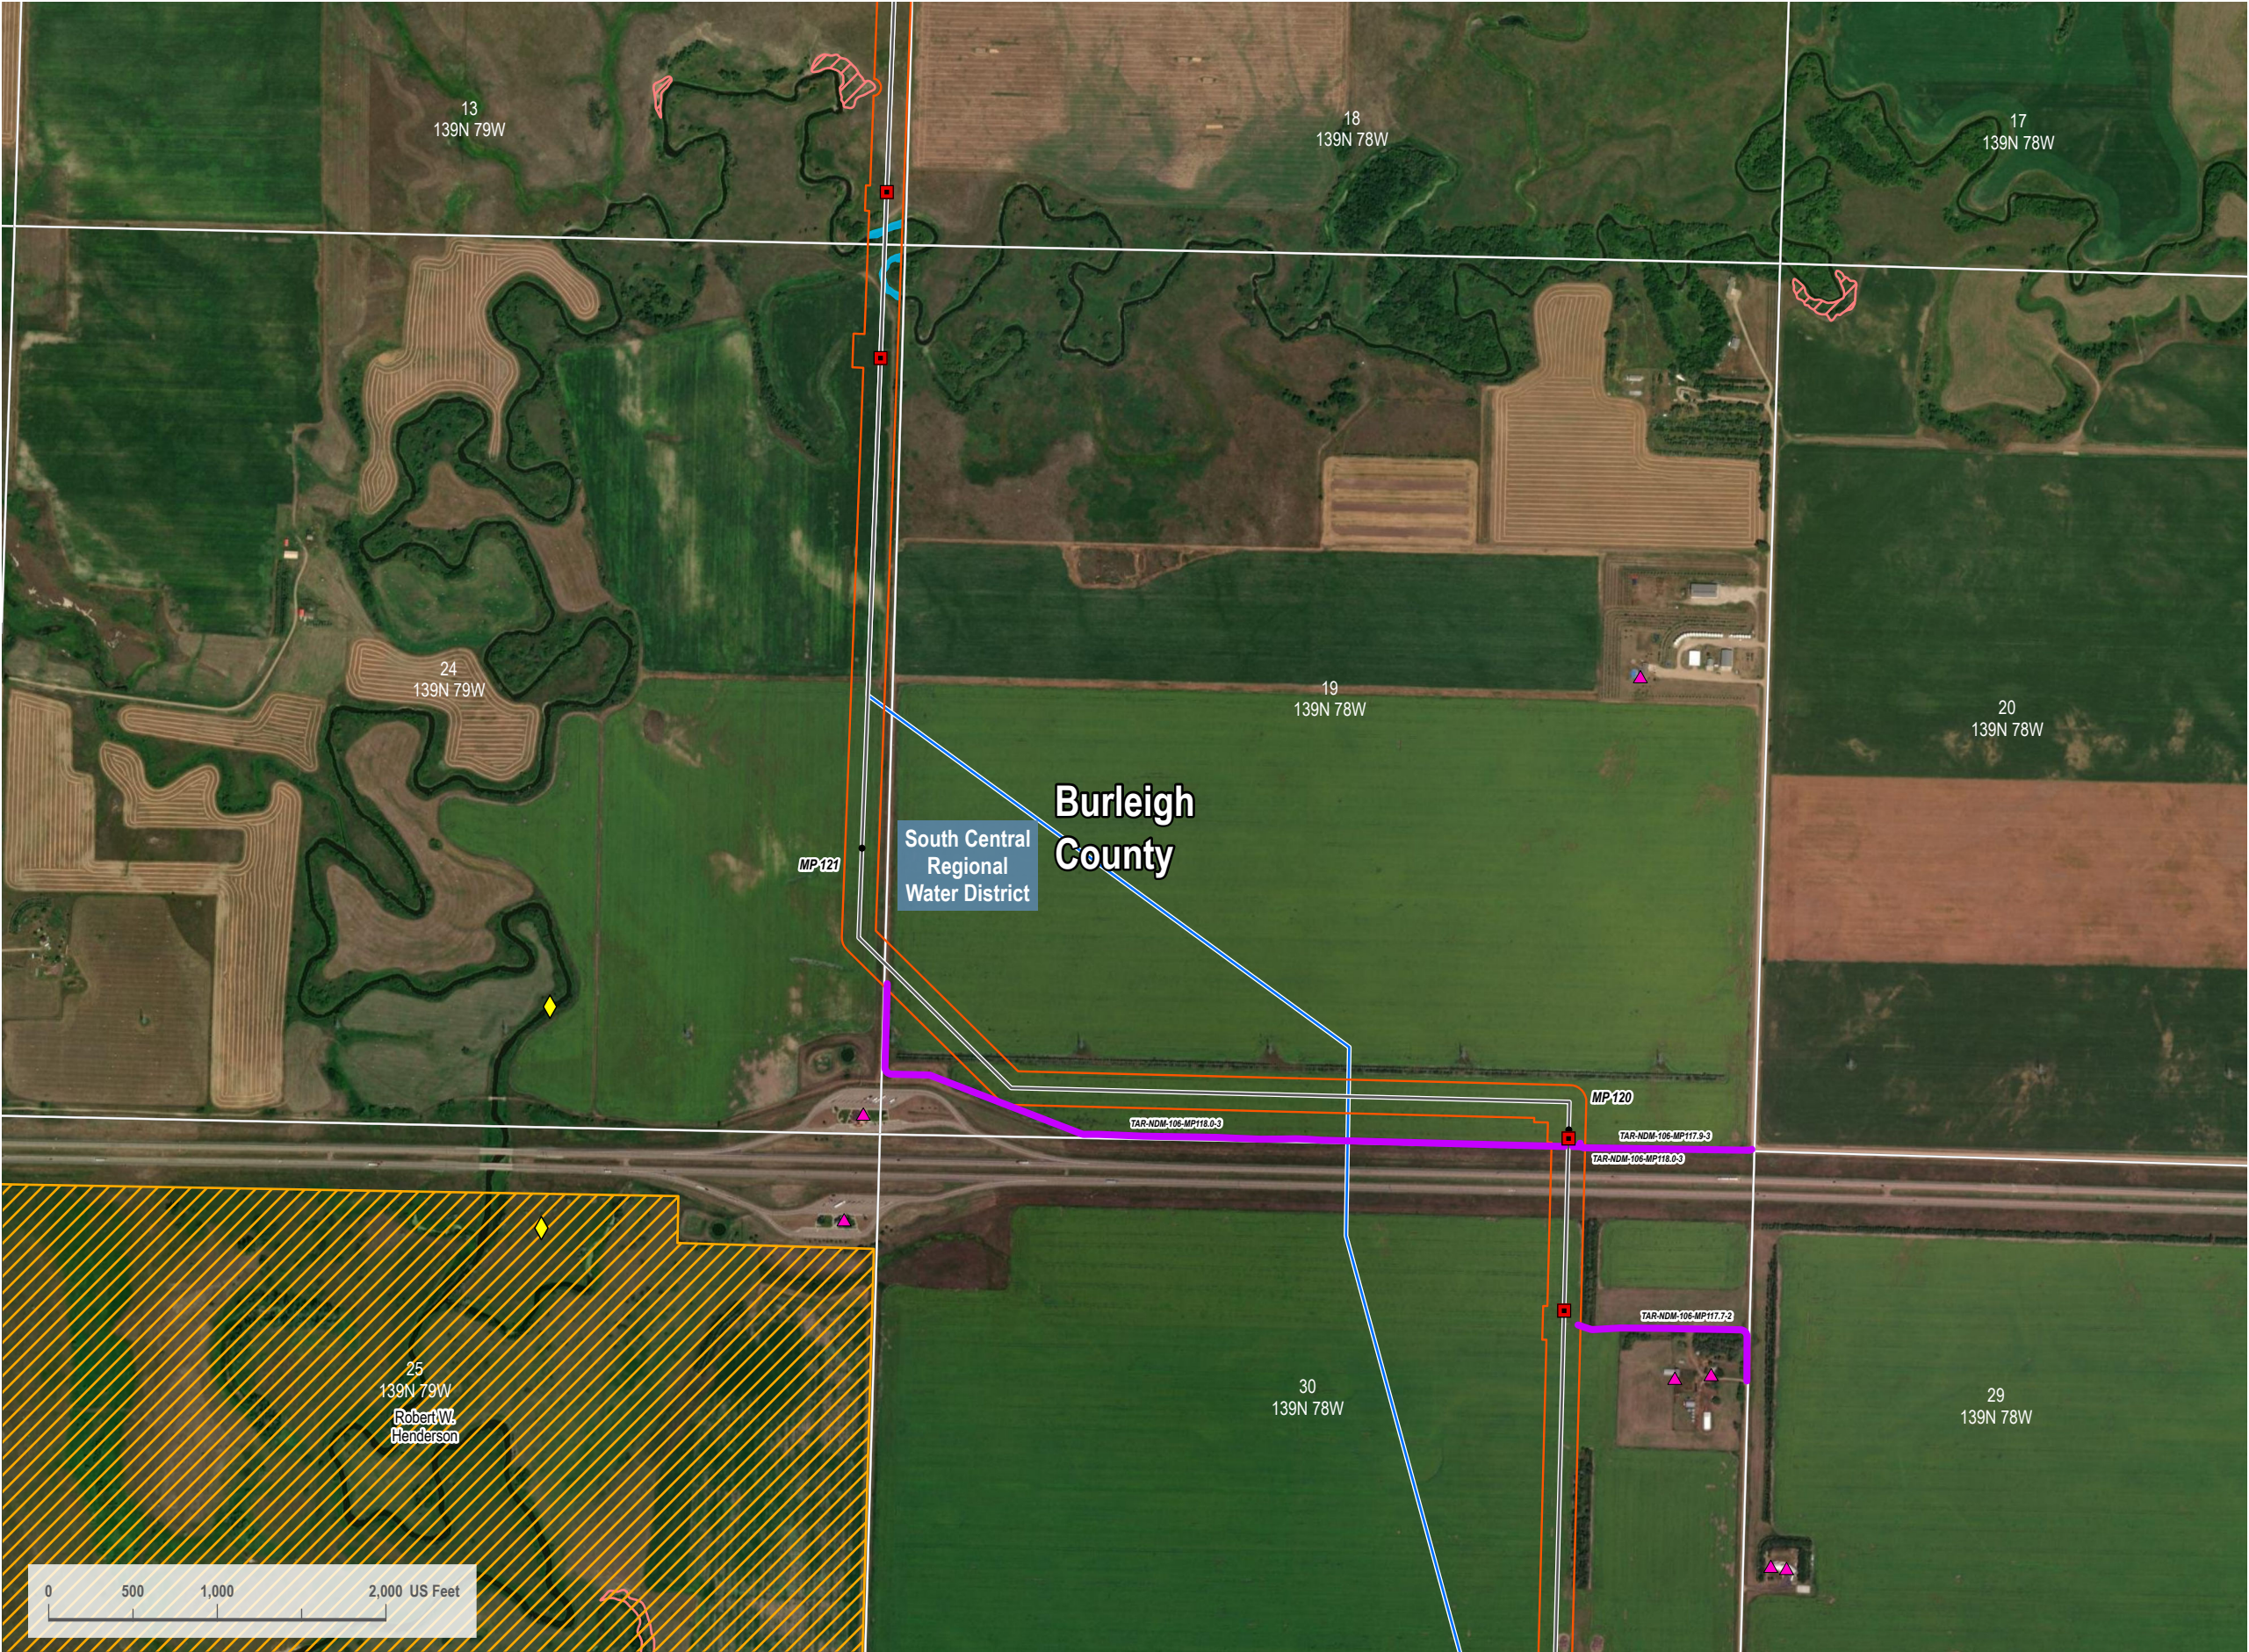

VICINITY MAP



LEGEND

- HDD Entry/Exit
- Centerline Mileposts
- Water Well (Avoidance)
- Domestic Structure or Business (Avoidance)
- Updated Proposed Project Route 08/15/2023
- October 17, 2023 Original PSC Application Route
- Section Line
- Access Road
- Landslide Deposit (Avoidance)
- Avoidance Area
- Stream
- 200-foot Siting Corridor



REVISIONS

Date: 2023-08-17 Revised by: CW Checked by: RC  
A - Issued for Review

Date: Revised by: Checked by:

Date: Revised by: Checked by:

PREPARED BY

**Summit Carbon Solutions**  
2321 North Loop Drive, Suite 221  
Ames, Iowa 50010  
United States of America  
www.summitcarbonsolutions.com



PROJECT INFORMATION

Figure Title:  
ND PSC - Aerial Map Book - NDM-106

Figure Number:  
Map Book 1


Scale:  
1 : 12,000  
1 inch equals 1,000 feet

Projection:  
Transverse Mercator  
NAD 1983 UTM Zone 14N

Sheet:  
42  
42 of 139

Drawing Number:  
1001-01-003  
Revision A



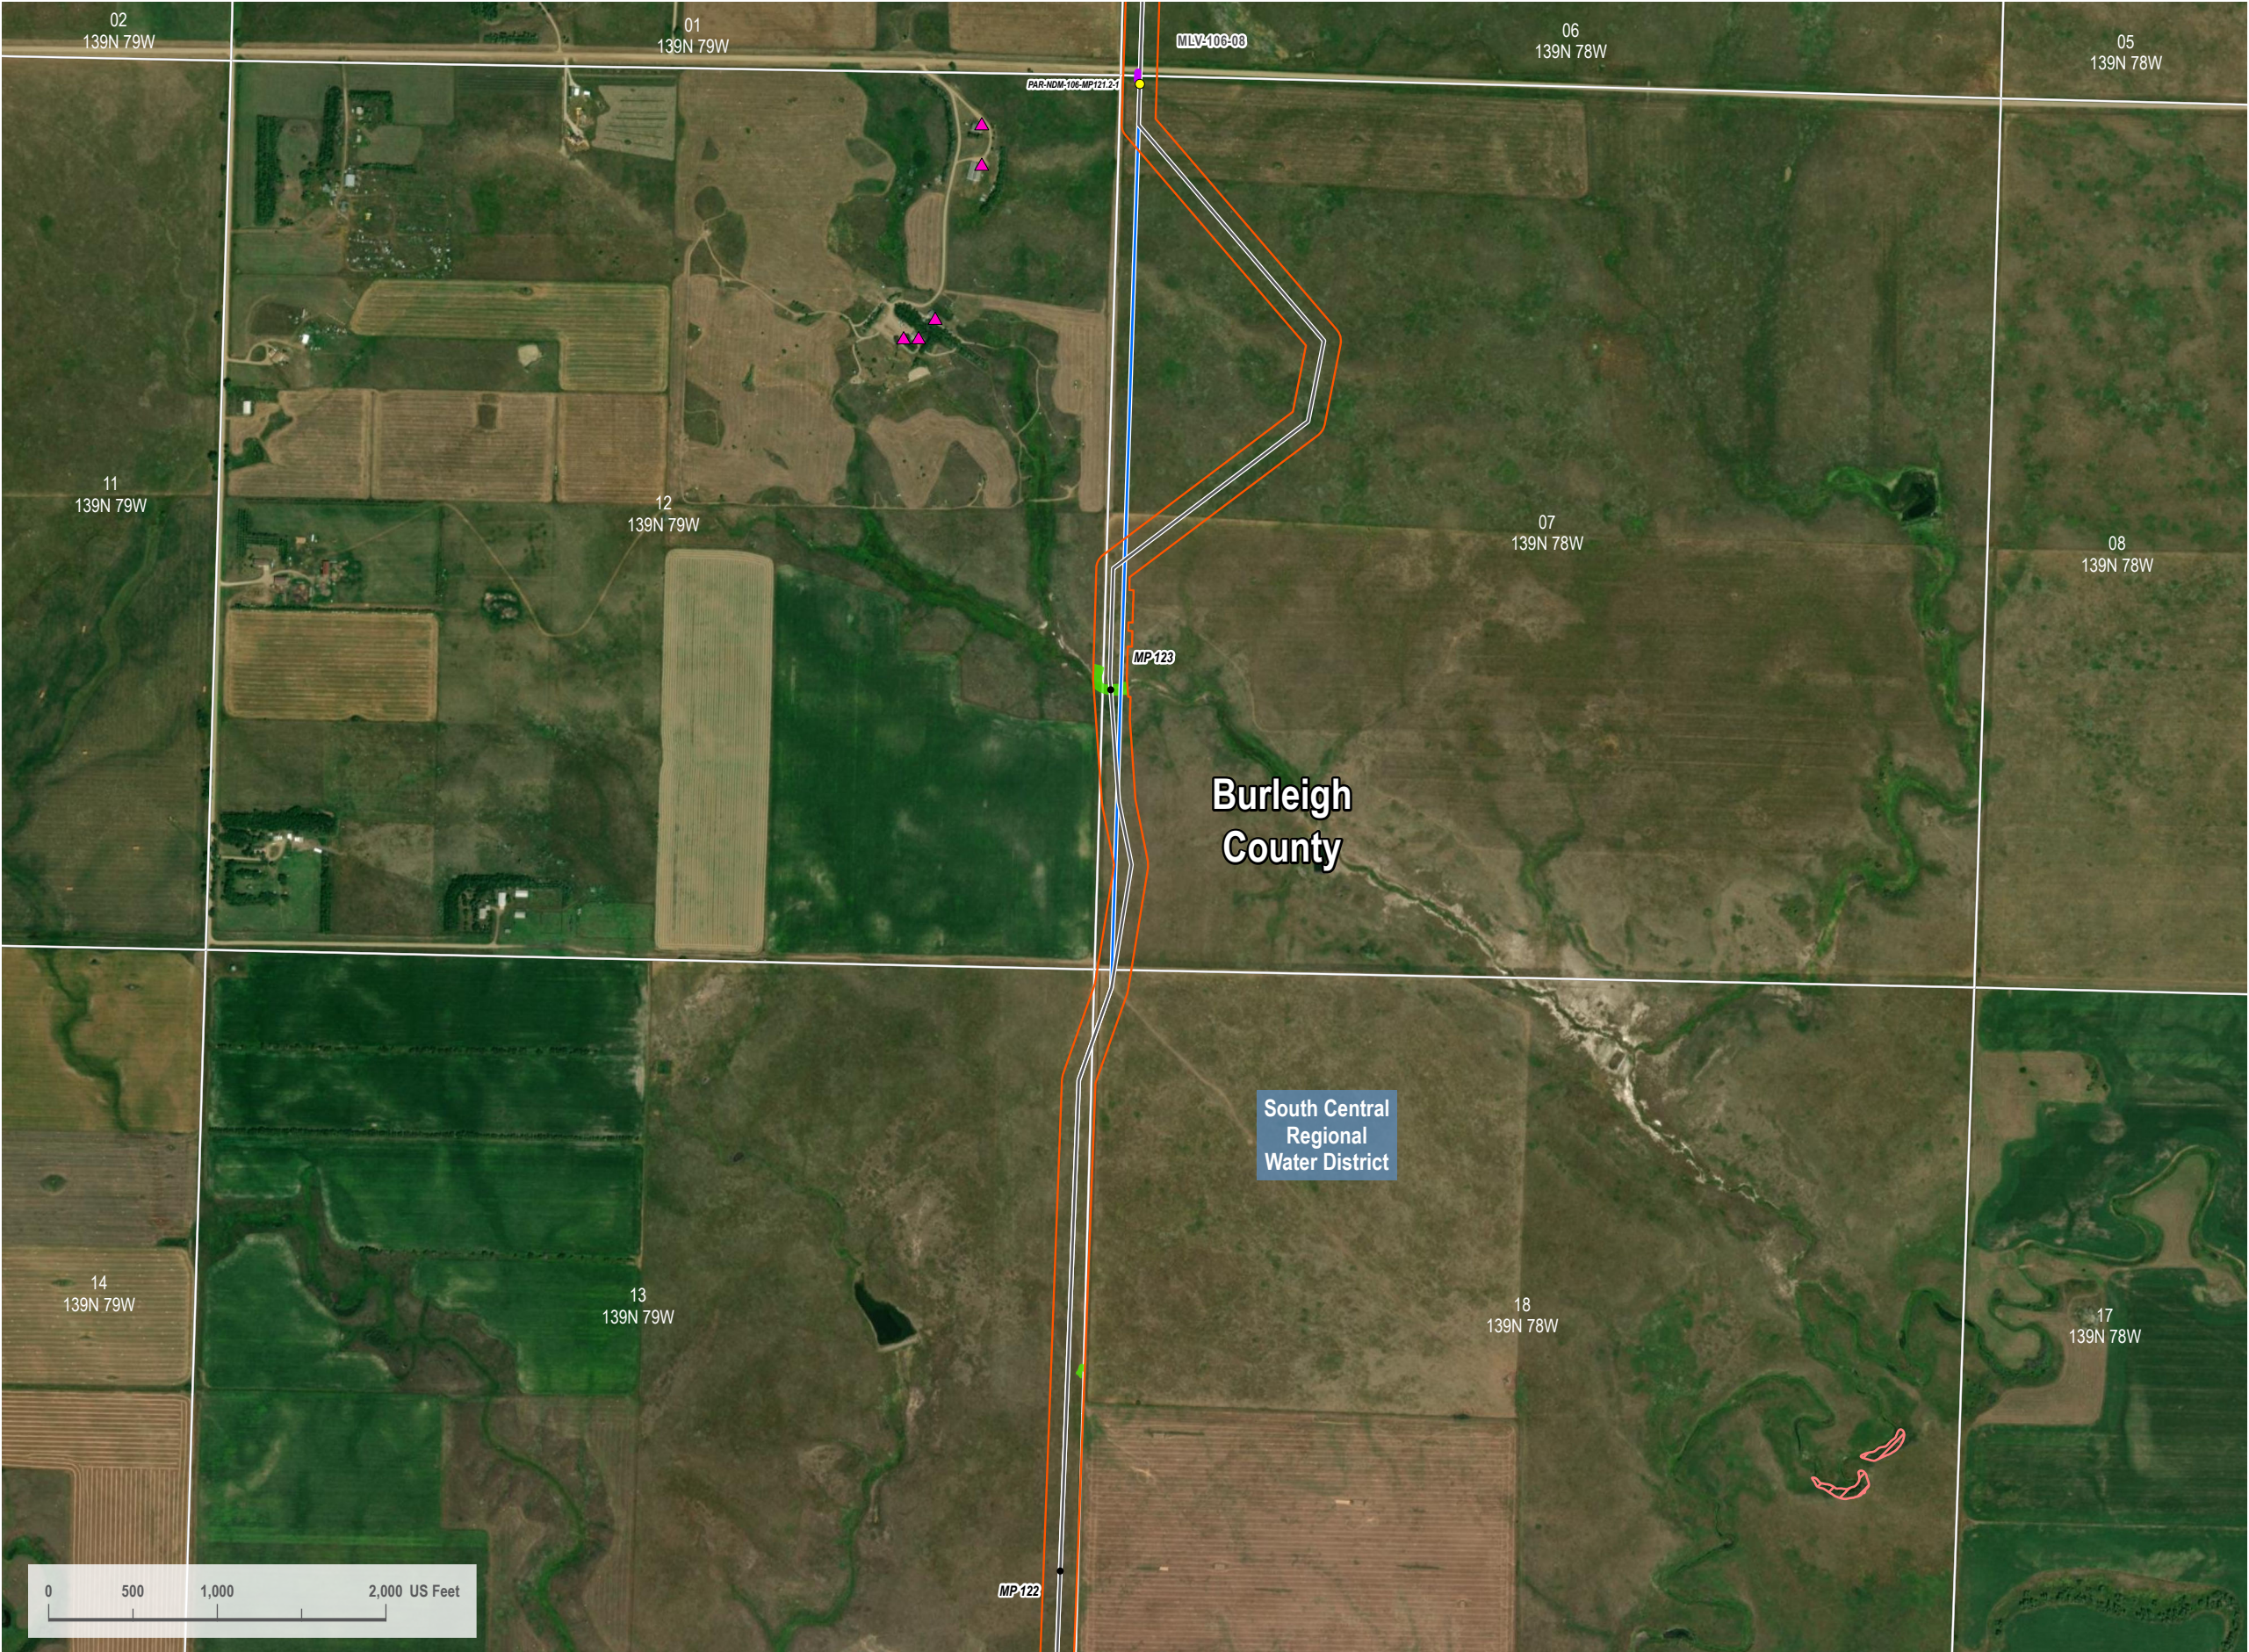


VICINITY MAP



LEGEND

- Centerline Mileposts
- Mainline Valve Location
- Domestic Structure or Business (Avoidance)
- Updated Proposed Project Route 08/15/2023
- October 17, 2023 Original PSC Application Route
- Section Line
- Access Road
- Landslide Deposit (Avoidance)
- PEM Wetland
- 200-foot Siting Corridor

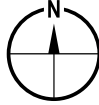

REVISIONS

Date: 2023-08-17	Revised by: CW	Checked by: RC
A - Issued for Review		
Date:	Revised by:	Checked by:
Date:	Revised by:	Checked by:

PREPARED BY

**Summit Carbon Solutions**  
2321 North Loop Drive, Suite 221  
Ames, Iowa 50010  
United States of America  
[www.summitcarbonsolutions.com](http://www.summitcarbonsolutions.com)




**SUMMIT CARBON**  
SOLUTIONS

PROJECT INFORMATION

Figure Title: <b>ND PSC - Aerial Map Book - NDM-106</b>	
Figure Number: <b>Map Book 1</b>	
Scale: <b>1 : 12,000</b> 1 inch equals 1,000 feet	Projection: <b>Transverse Mercator</b> NAD 1983 UTM Zone 14N
Sheet: <b>43</b> 43 of 139	Drawing Number: <b>1001-01-003</b> Revision A



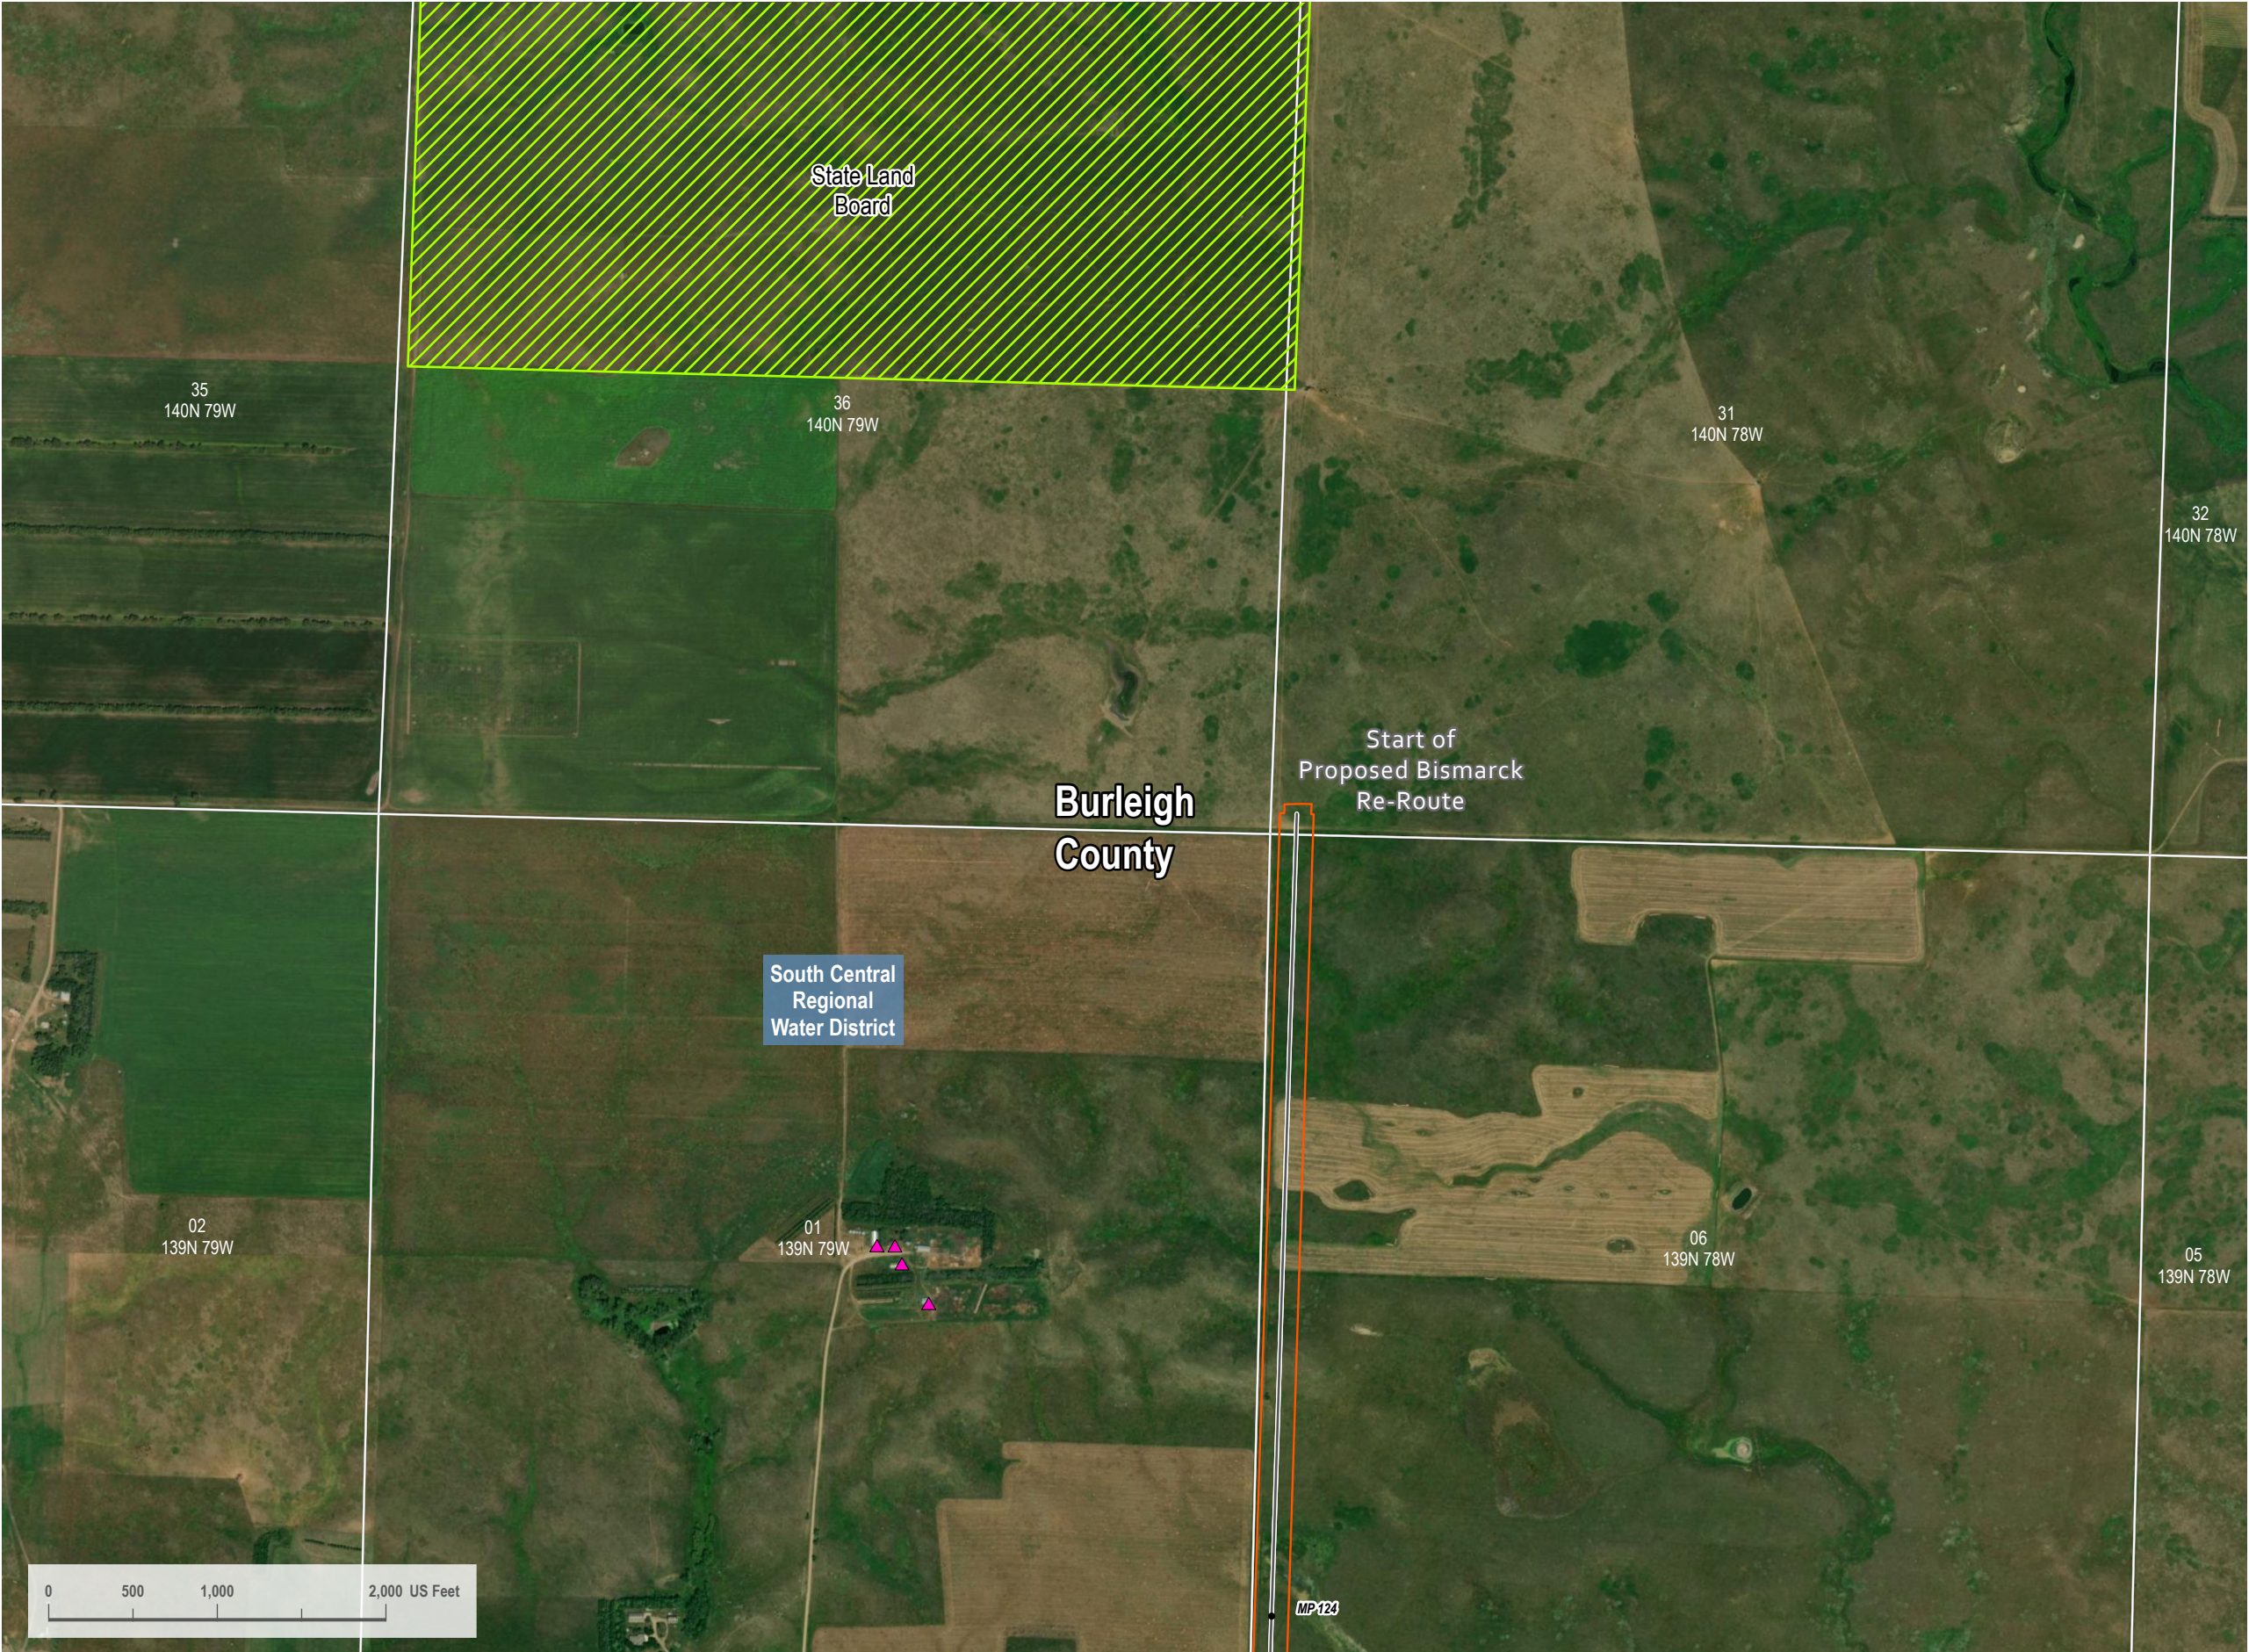

VICINITY MAP



LEGEND

- Centerline Mileposts
- Domestic Structure or Business (Avoidance)
- Updated Proposed Project Route 08/15/2023
- October 17, 2023 Original PSC Application Route
- Section Line
- 200-foot Siting Corridor
- State Resource Management Area



REVISIONS

Date:	2023-08-17	Revised by:	CW	Checked by:	RC
A - Issued for Review					
Date:		Revised by:		Checked by:	
Date:		Revised by:		Checked by:	

PREPARED BY

**Summit Carbon Solutions**  
2321 North Loop Drive, Suite 221  
Ames, Iowa 50010  
United States of America  
[www.summitcarbonsolutions.com](http://www.summitcarbonsolutions.com)




**SUMMIT CARBON**  
SOLUTIONS

PROJECT INFORMATION

Figure Title: <b>ND PSC - Aerial Map Book - NDM-106</b>	
Figure Number: <b>Map Book 1</b>	
Scale: <b>1 : 12,000</b> 1 inch equals 1,000 feet	Projection: <b>Transverse Mercator</b> NAD 1983 UTM Zone 14N
Sheet: <b>44</b> 44 of 139	Drawing Number: <b>1001-01-003</b> Revision A



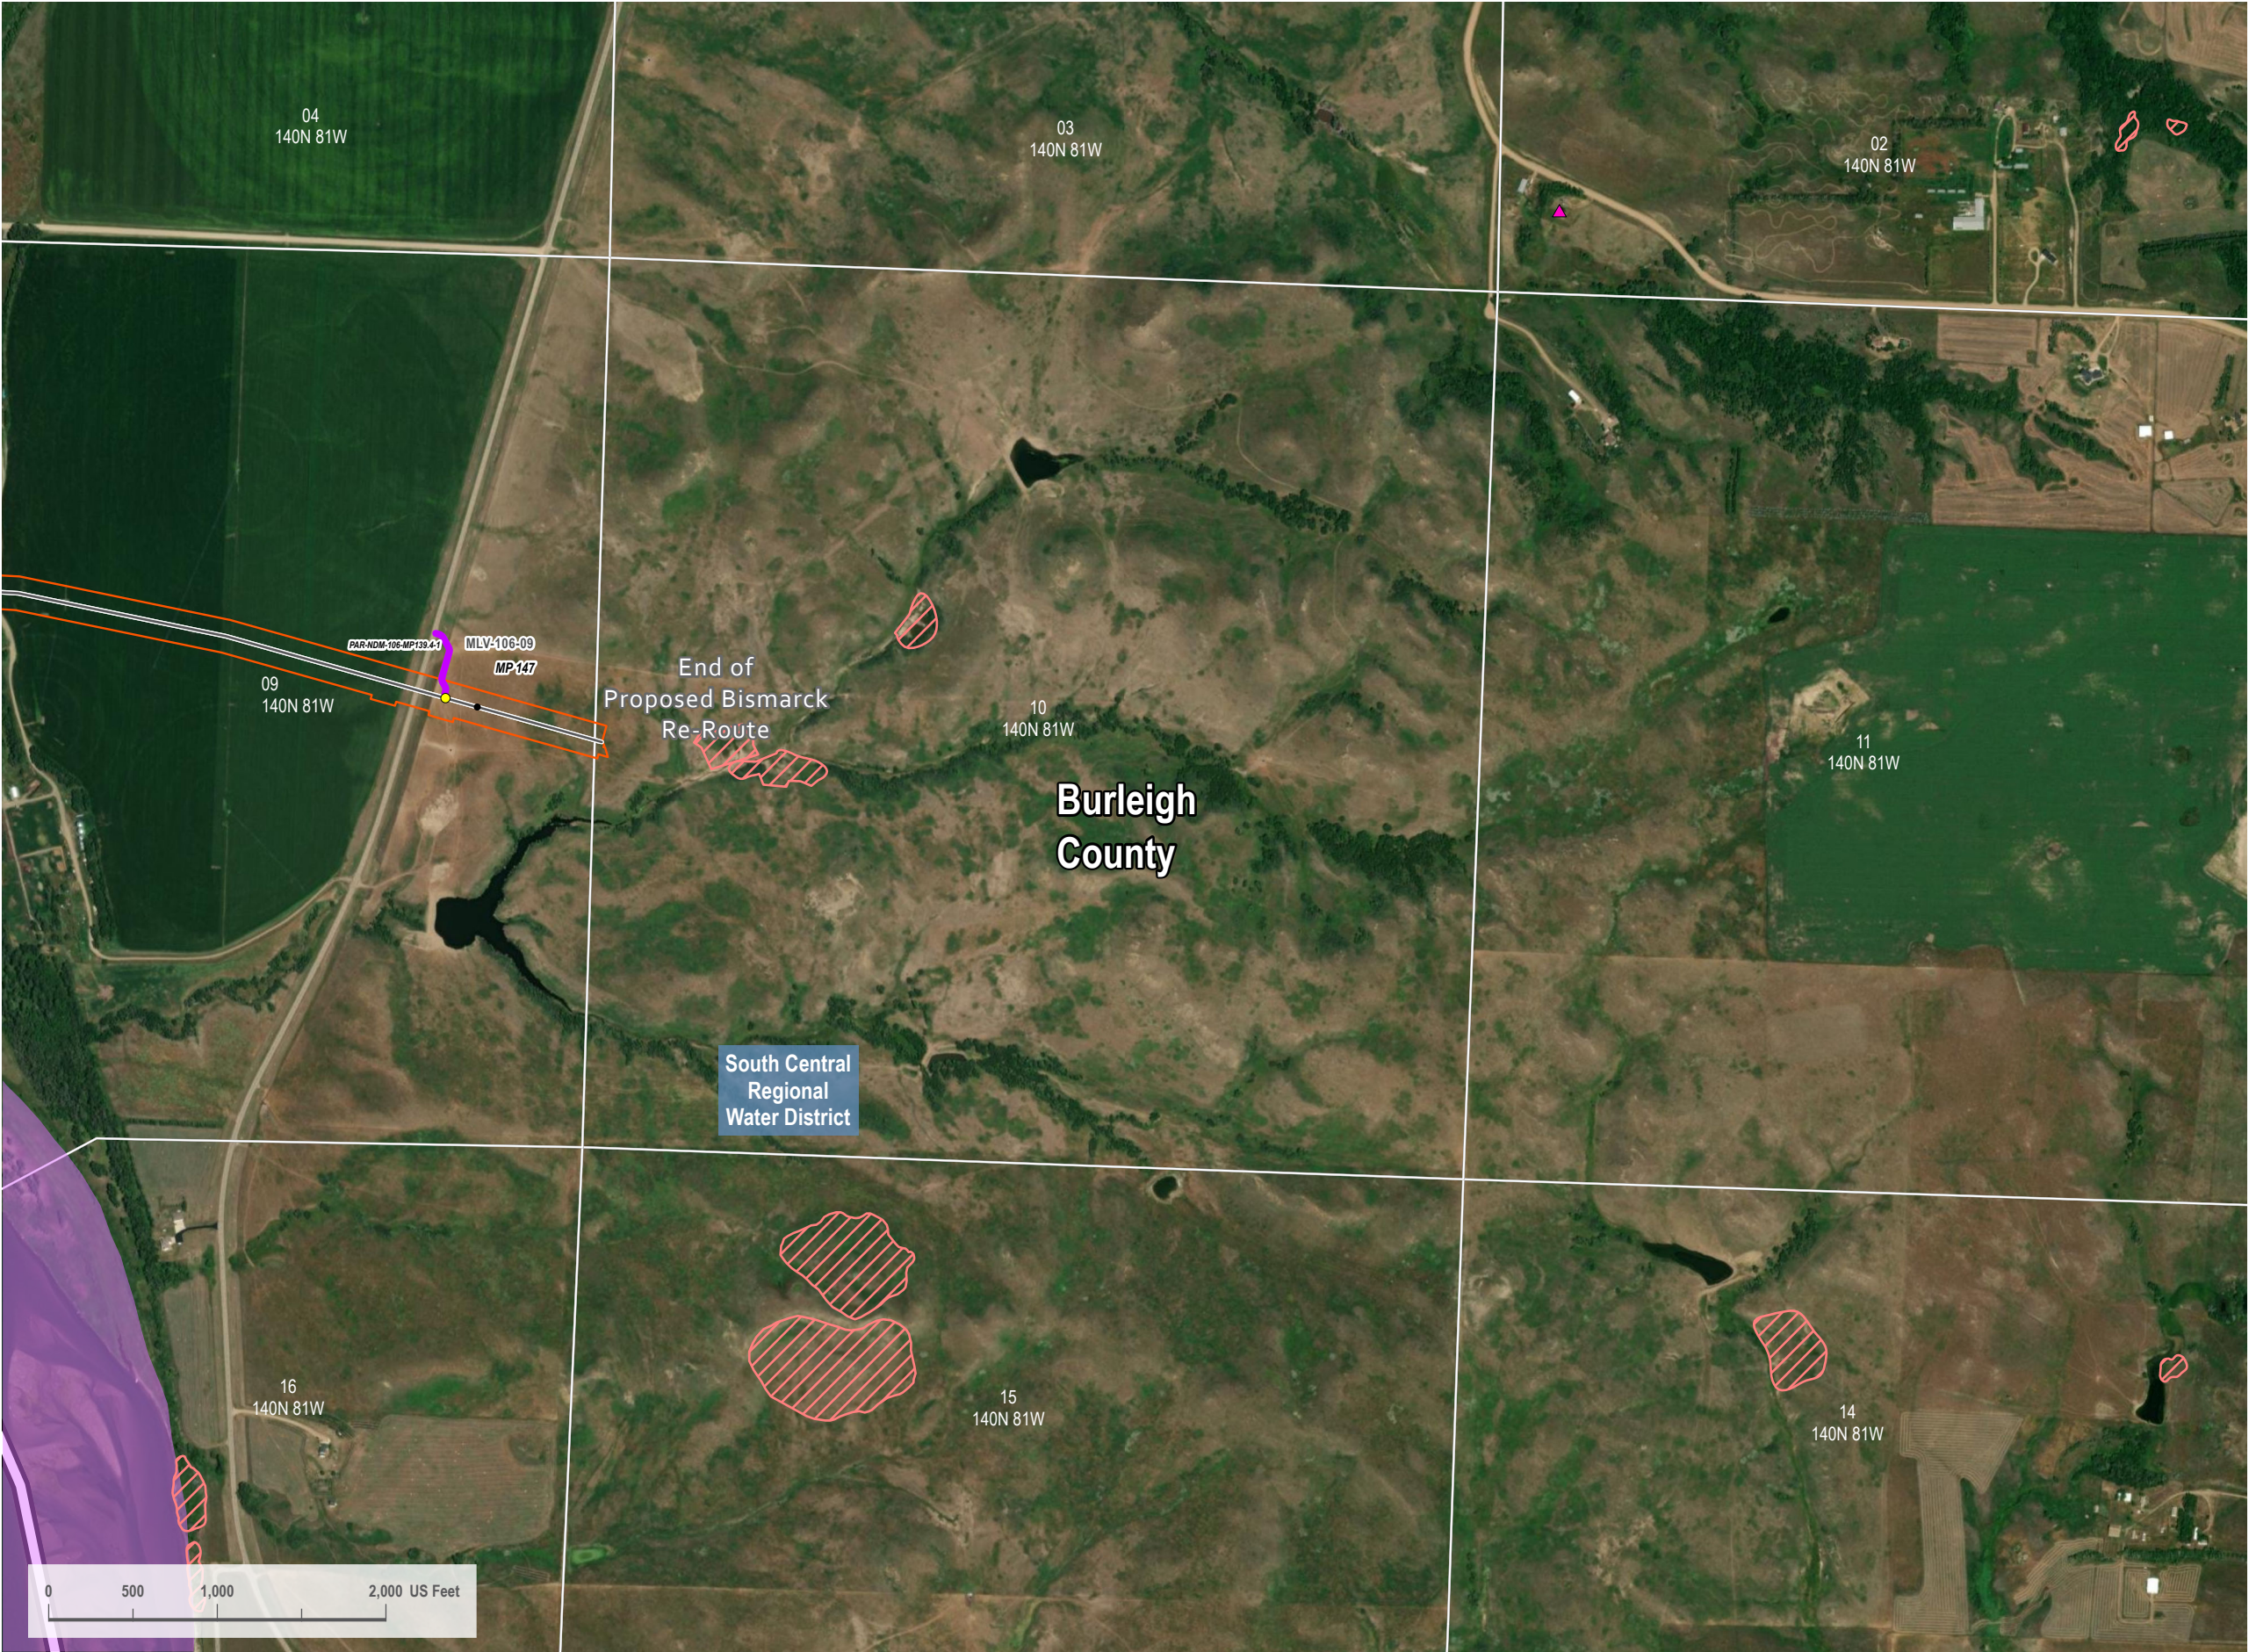

VICINITY MAP

LEGEND

Centerline Mileposts	USFWS Critical Habitat (Exclusion)
Mainline Valve Location	200-foot Siting Corridor
Domestic Structure or Business (Avoidance)	
Updated Proposed Project Route 08/15/2023	
October 17, 2023 Original PSC Application Route	
Section Line	
Access Road	
Landslide Deposit (Avoidance)	

REVISIONS

Date: 2023-08-17	Revised by: CW	Checked by: RC
A - Issued for Review		
Date:	Revised by:	Checked by:
Date:	Revised by:	Checked by:

PREPARED BY

Summit Carbon Solutions

2321 North Loop Drive, Suite 221  
Ames, Iowa 50010  
United States of America

[www.summitcarbonsolutions.com](http://www.summitcarbonsolutions.com)


PROJECT INFORMATION

Figure Title:  
ND PSC - Aerial Map Book - NDM-106

Figure Number:  
Map Book 1

Scale: 1 : 12,000 1 inch equals 1,000 feet	Projection: Transverse Mercator NAD 1983 UTM Zone 14N
Sheet: 45 45 of 139	Drawing Number: 1001-01-003 Revision A



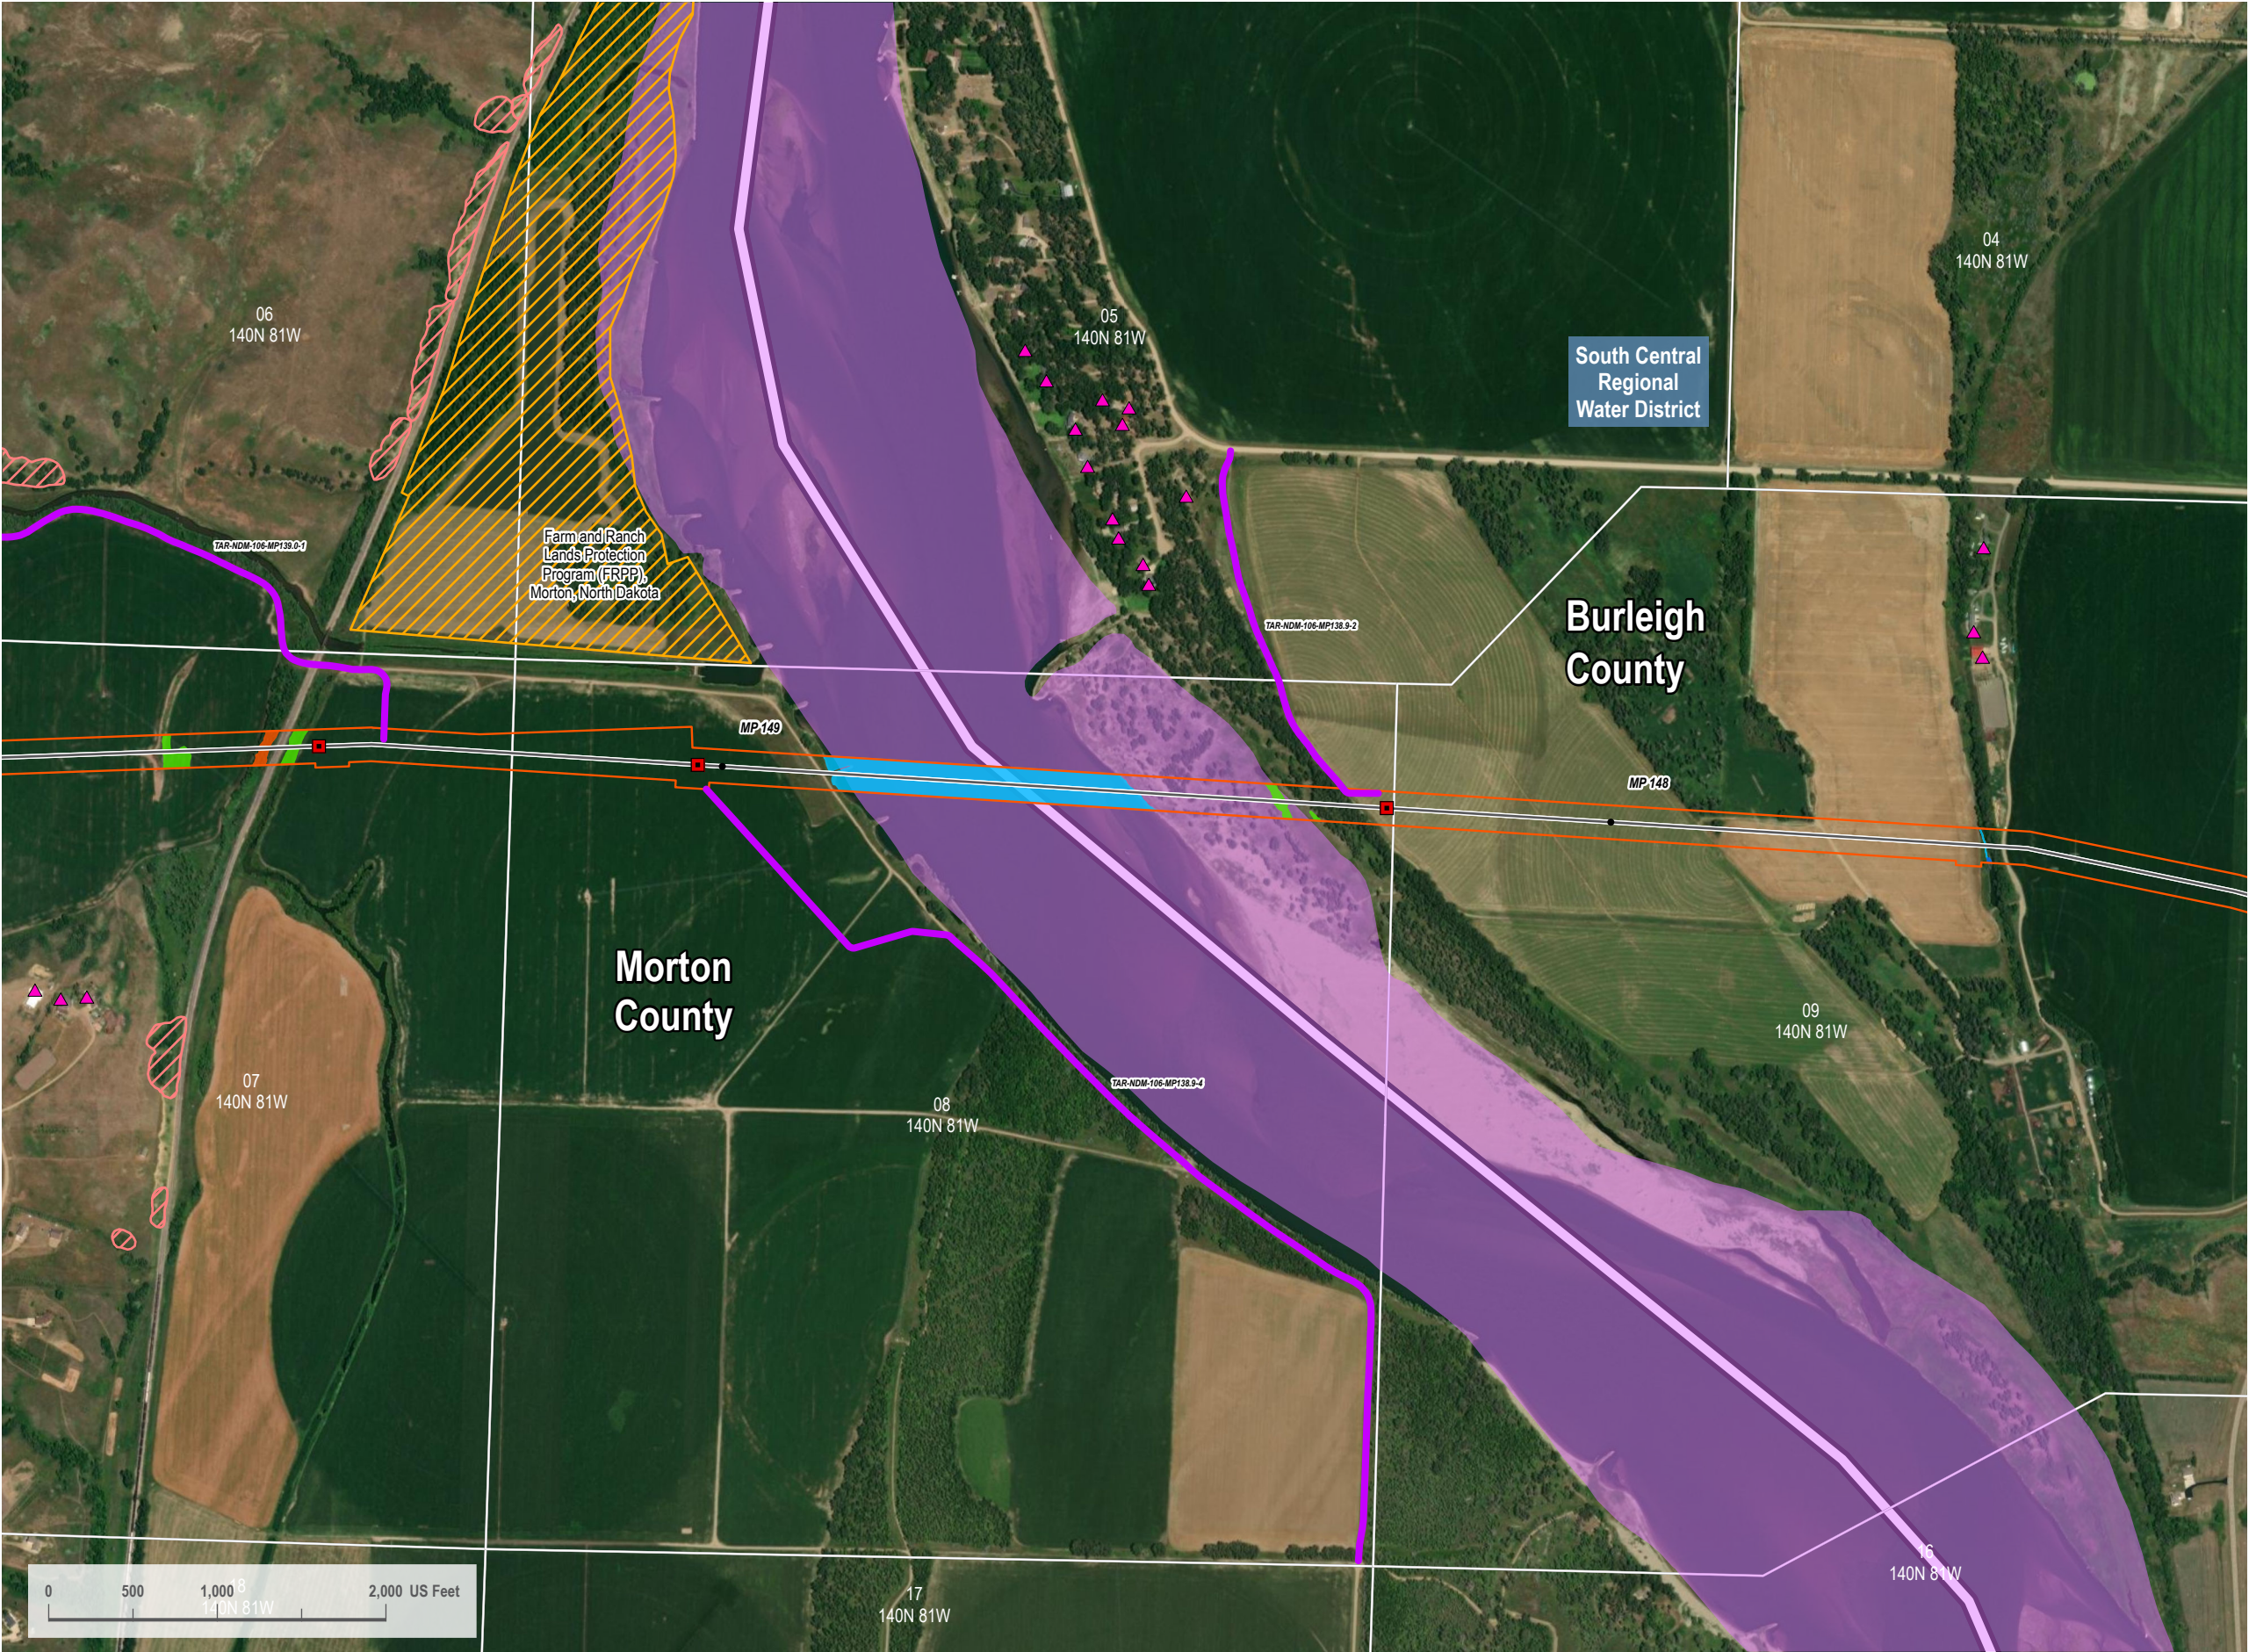

VICINITY MAP



LEGEND

- |   |                                    |
|---|------------------------------------|
| HDD Entry/Exit                                  | Avoidance Area                     |
| Centerline Mileposts                            | USFWS Critical Habitat (Exclusion) |
| Domestic Structure or Business (Avoidance)      | Open Water                         |
| Updated Proposed Project Route 08/15/2023       | PEM Wetland                        |
| October 17, 2023 Original PSC Application Route | PFO Wetland                        |
| Section Line                                    | Stream                             |
| Access Road                                     | 200-foot Siting Corridor           |
| Landslide Deposit (Avoidance)                   |                                    |



REVISIONS

Date:	2023-08-17	Revised by:	CW	Checked by:	RC
A - Issued for Review					
Date:		Revised by:		Checked by:	
Date:		Revised by:		Checked by:	


PREPARED BY

**Summit Carbon Solutions**  
2321 North Loop Drive, Suite 221  
Ames, Iowa 50010  
United States of America  
[www.summitcarbonsolutions.com](http://www.summitcarbonsolutions.com)

PROJECT INFORMATION

Figure Title:	ND PSC - Aerial Map Book - NDM-106		
Figure Number:	Map Book 1		
Scale:	1 : 12,000 1 inch equals 1,000 feet	Projection:	Transverse Mercator NAD 1983 UTM Zone 14N
Sheet:	46 46 of 139	Drawing Number:	1001-01-003 Revision A



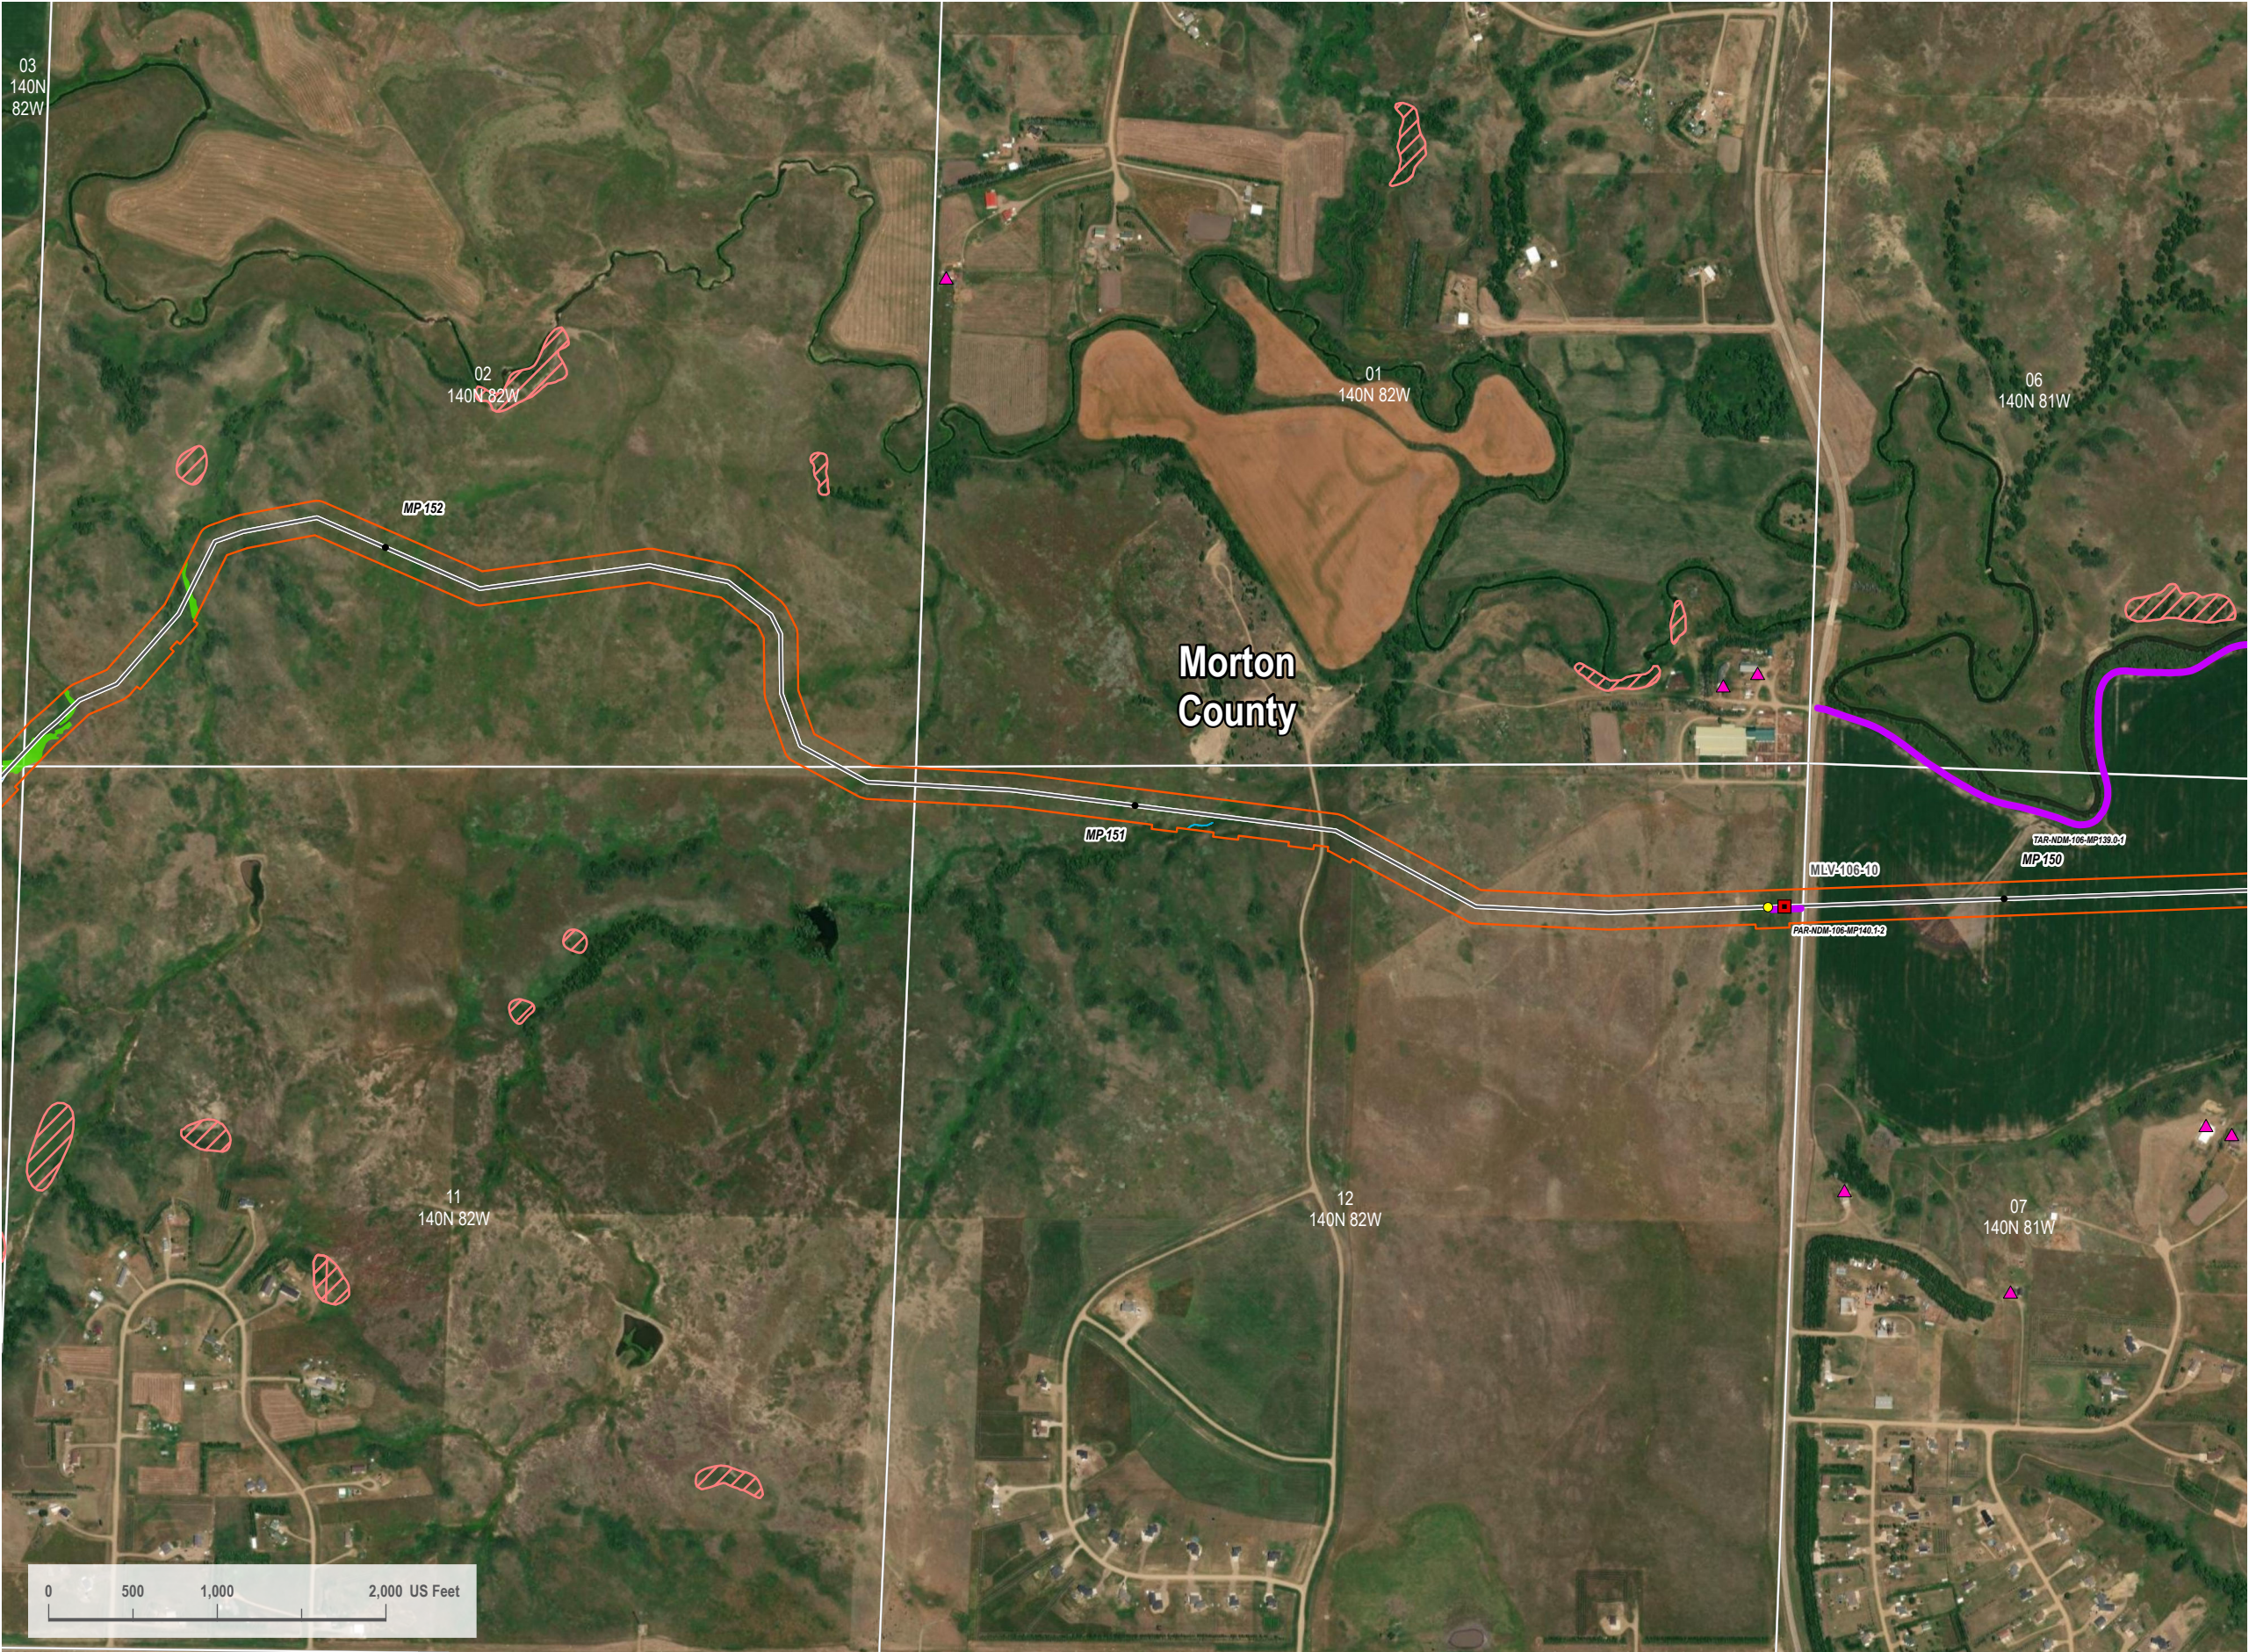


VICINITY MAP



LEGEND

- HDD Entry/Exit
- Centerline Mileposts
- Mainline Valve Location
- Domestic Structure or Business (Avoidance)
- Updated Proposed Project Route 08/15/2023
- October 17, 2023 Original PSC Application Route
- Section Line
- Access Road
- Landslide Deposit (Avoidance)
- PEM Wetland
- Stream
- 200-foot Siting Corridor

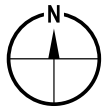

REVISIONS

Date: 2023-08-17	Revised by: CW	Checked by: RC
A - Issued for Review		
Date:	Revised by:	Checked by:
Date:	Revised by:	Checked by:

PREPARED BY

**Summit Carbon Solutions**  
2321 North Loop Drive, Suite 221  
Ames, Iowa 50010  
United States of America  
[www.summitcarbonsolutions.com](http://www.summitcarbonsolutions.com)




**SUMMIT CARBON SOLUTIONS**

PROJECT INFORMATION

Figure Title: <b>ND PSC - Aerial Map Book - NDM-106</b>	
Figure Number: <b>Map Book 1</b>	
Scale: <b>1 : 12,000</b> 1 inch equals 1,000 feet	Projection: <b>Transverse Mercator</b> NAD 1983 UTM Zone 14N
Sheet: <b>47</b> 47 of 139	Drawing Number: <b>1001-01-003</b> Revision A



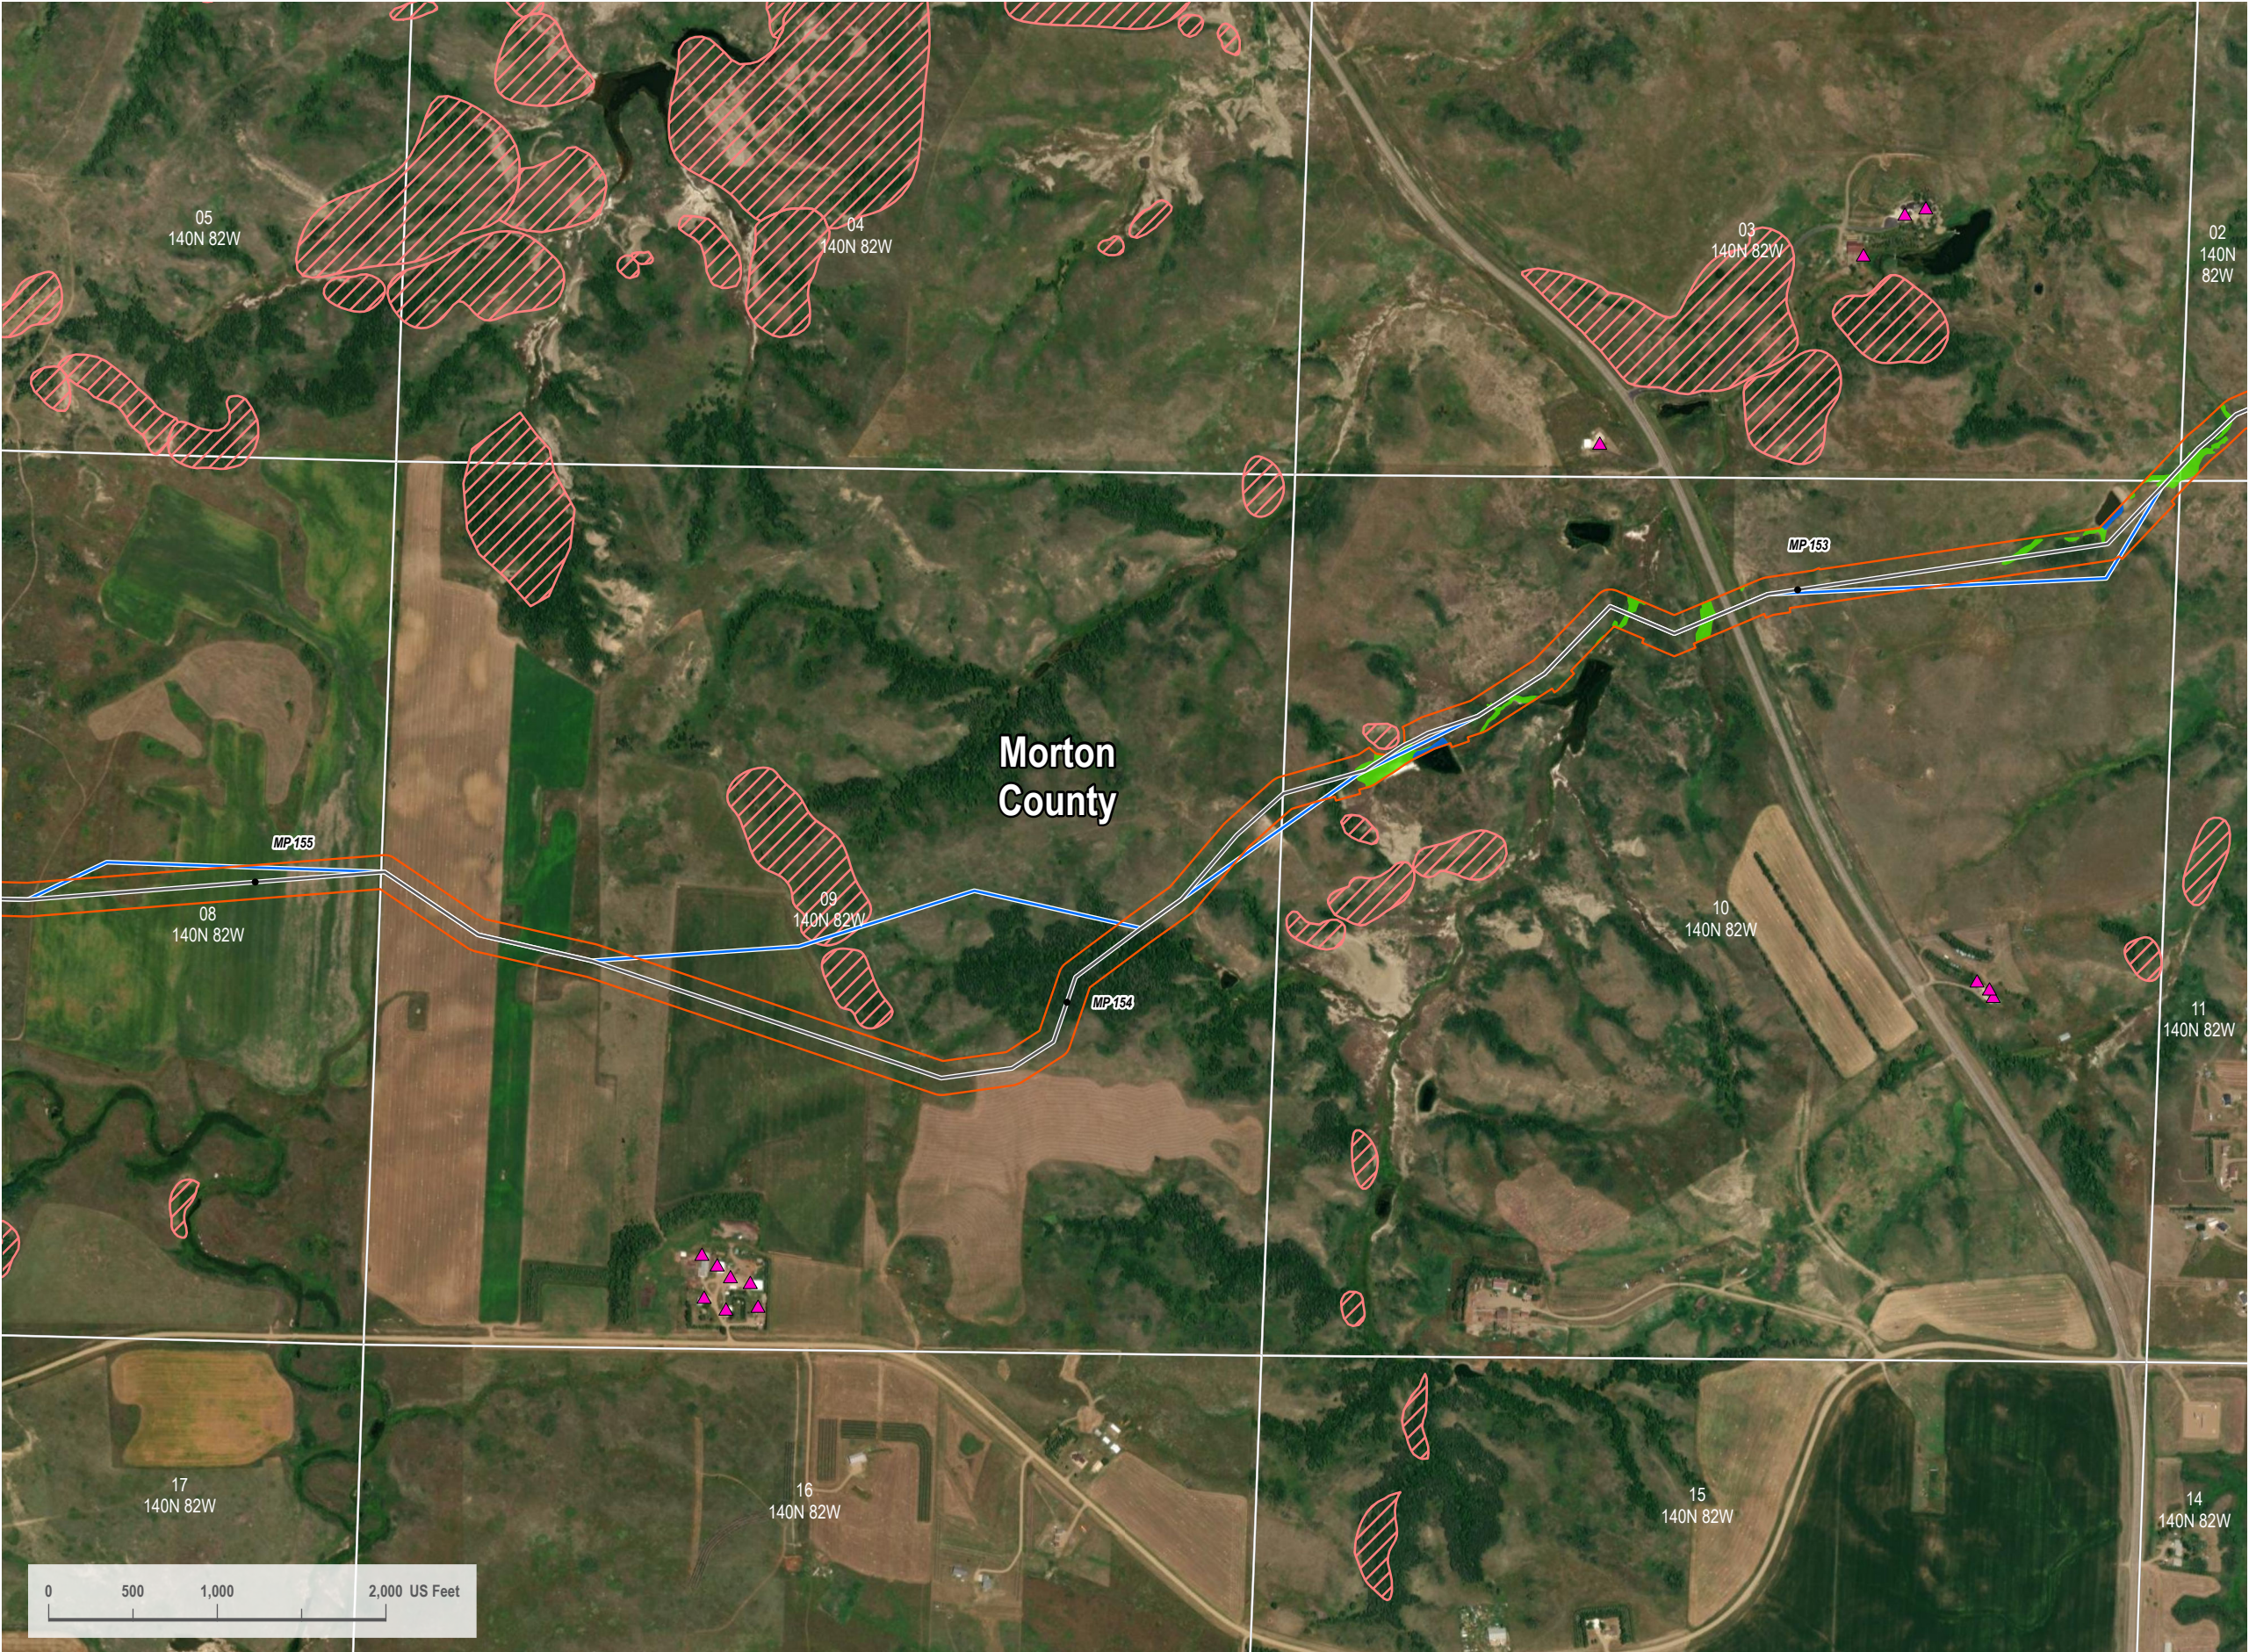

VICINITY MAP



LEGEND

- Centerline Mileposts
- Domestic Structure or Business (Avoidance)
- Updated Proposed Project Route 08/15/2023
- October 17, 2023 Original PSC Application Route
- Section Line
- Landslide Deposit (Avoidance)
- Open Water
- PEM Wetland
- 200-foot Siting Corridor



REVISIONS

Date: 2023-08-17	Revised by: CW	Checked by: RC
A - Issued for Review		
Date:	Revised by:	Checked by:
Date:	Revised by:	Checked by:

PREPARED BY

**Summit Carbon Solutions**  
2321 North Loop Drive, Suite 221  
Ames, Iowa 50010  
United States of America  
[www.summitcarbonsolutions.com](http://www.summitcarbonsolutions.com)



**SUMMIT CARBON**  
SOLUTIONS

PROJECT INFORMATION

Figure Title: <b>ND PSC - Aerial Map Book - NDM-106</b>	
Figure Number: <b>Map Book 1</b>	
Scale: <b>1 : 12,000</b> 1 inch equals 1,000 feet	Projection: <b>Transverse Mercator</b> NAD 1983 UTM Zone 14N
Sheet: <b>48</b> 48 of 139	Drawing Number: <b>1001-01-003</b> Revision A






VICINITY MAP



LEGEND

- Centerline Mileposts
- Domestic Structure or Business (Avoidance)
- Updated Proposed Project Route 08/15/2023
- October 17, 2023 Original PSC Application Route
- Section Line
- Landslide Deposit (Avoidance)
- PEM Wetland
- 200-foot Siting Corridor

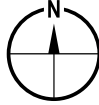

REVISIONS

Date:	2023-08-17	Revised by:	CW	Checked by:	RC
A - Issued for Review					
Date:		Revised by:		Checked by:	
Date:		Revised by:		Checked by:	

PREPARED BY

**Summit Carbon Solutions**  
2321 North Loop Drive, Suite 221  
Ames, Iowa 50010  
United States of America  
[www.summitcarbonsolutions.com](http://www.summitcarbonsolutions.com)




**SUMMIT CARBON**  
SOLUTIONS

PROJECT INFORMATION

Figure Title: <b>ND PSC - Aerial Map Book - NDM-106</b>	
Figure Number: <b>Map Book 1</b>	
Scale: <b>1 : 12,000</b> 1 inch equals 1,000 feet	Projection: <b>Transverse Mercator</b> NAD 1983 UTM Zone 14N
Sheet: <b>49</b> 49 of 139	Drawing Number: <b>1001-01-003</b> Revision A



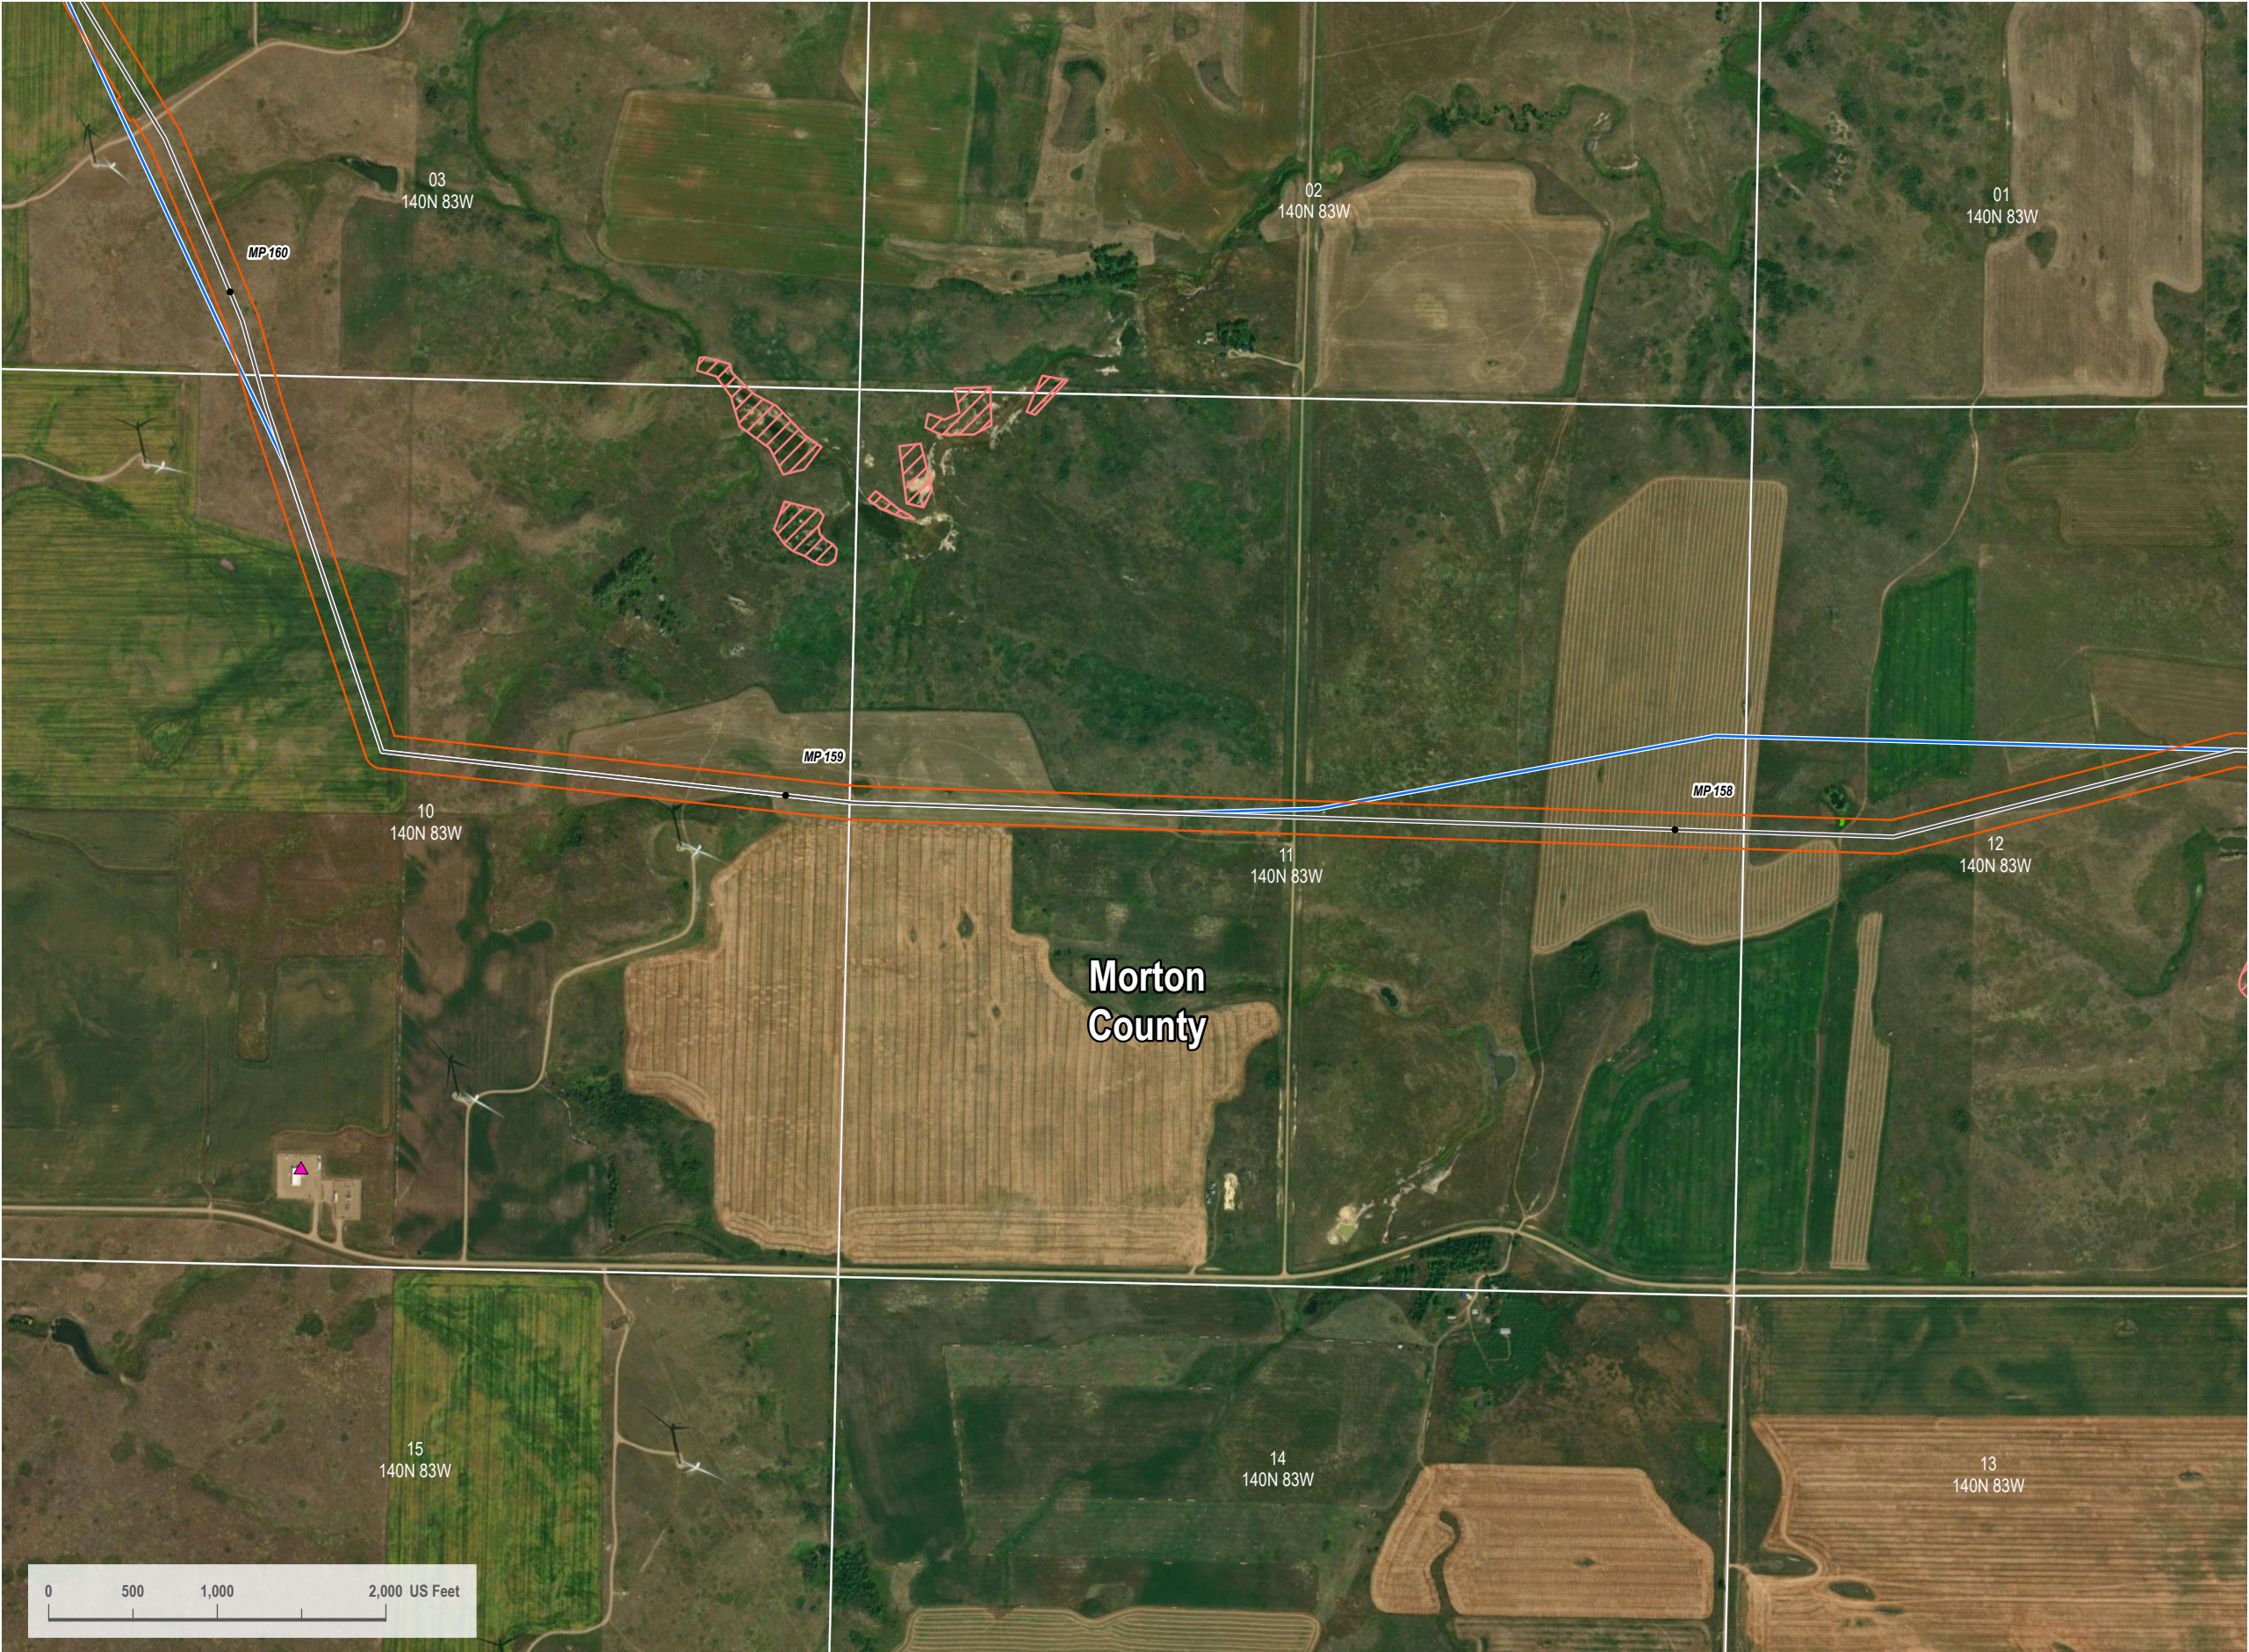

VICINITY MAP



LEGEND

- Centerline Mileposts
- Domestic Structure or Business (Avoidance)
- Updated Proposed Project Route 08/15/2023
- October 17, 2023 Original PSC Application Route
- Section Line
- Landslide Deposit (Avoidance)
- Open Water
- PEM Wetland
- 200-foot Siting Corridor



REVISIONS

Date:	2023-08-17	Revised by:	CW	Checked by:	RC
A - Issued for Review					
Date:		Revised by:		Checked by:	
Date:		Revised by:		Checked by:	

PREPARED BY

**Summit Carbon Solutions**  
2321 North Loop Drive, Suite 221  
Ames, Iowa 50010  
United States of America  
[www.summitcarbonsolutions.com](http://www.summitcarbonsolutions.com)



**SUMMIT CARBON**  
SOLUTIONS

PROJECT INFORMATION

Figure Title: <b>ND PSC - Aerial Map Book - NDM-106</b>	
Figure Number: <b>Map Book 1</b>	
Scale: <b>1 : 12,000</b> 1 inch equals 1,000 feet	Projection: <b>Transverse Mercator</b> NAD 1983 UTM Zone 14N
Sheet: <b>50</b> 50 of 139	Drawing Number: <b>1001-01-003</b> Revision A





VICINITY MAP

LEGEND

- Centerline Mileposts
- Mainline Valve Location
- Domestic Structure or Business (Avoidance)
- Updated Proposed Project Route 08/15/2023
- October 17, 2023 Original PSC Application Route
- Section Line
- Access Road
- Landslide Deposit (Avoidance)
- Facility Boundary
- PEM Wetland
- 200-foot Siting Corridor

REVISIONS

Date: 2023-08-17	Revised by: CW	Checked by: RC
A - Issued for Review		
Date:	Revised by:	Checked by:
Date:	Revised by:	Checked by:

PREPARED BY

**Summit Carbon Solutions**  
2321 North Loop Drive, Suite 221  
Ames, Iowa 50010  
United States of America  
[www.summitcarbonsolutions.com](http://www.summitcarbonsolutions.com)

PROJECT INFORMATION

Figure Title:  
ND PSC - Aerial Map Book - NDM-106, NDL-328

Figure Number:  
Map Book 1

Scale: 1 : 12,000 1 inch equals 1,000 feet	Projection: Transverse Mercator NAD 1983 UTM Zone 14N
Sheet: 51 51 of 139	Drawing Number: 1001-01-003 Revision A






VICINITY MAP



LEGEND

- Centerline Mileposts
- Water Well (Avoidance)
- Mainline Valve Location
- Domestic Structure or Business (Avoidance)
- Updated Proposed Project Route 08/15/2023
- October 17, 2023 Original PSC Application Route
- Section Line
- Access Road
- Landslide Deposit (Avoidance)
- PEM Wetland
- 200-foot Siting Corridor

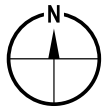

REVISIONS

Date: 2023-08-17	Revised by: CW	Checked by: RC
A - Issued for Review		
Date:	Revised by:	Checked by:
Date:	Revised by:	Checked by:

PREPARED BY

**Summit Carbon Solutions**  
2321 North Loop Drive, Suite 221  
Ames, Iowa 50010  
United States of America  
[www.summitcarbonsolutions.com](http://www.summitcarbonsolutions.com)




**SUMMIT CARBON**  
SOLUTIONS

PROJECT INFORMATION

Figure Title: <b>ND PSC - Aerial Map Book - NDM-106</b>	
Figure Number: <b>Map Book 1</b>	
Scale: <b>1 : 12,000</b> 1 inch equals 1,000 feet	Projection: <b>Transverse Mercator</b> NAD 1983 UTM Zone 14N
Sheet: <b>52</b> 52 of 139	Drawing Number: <b>1001-01-003</b> Revision A



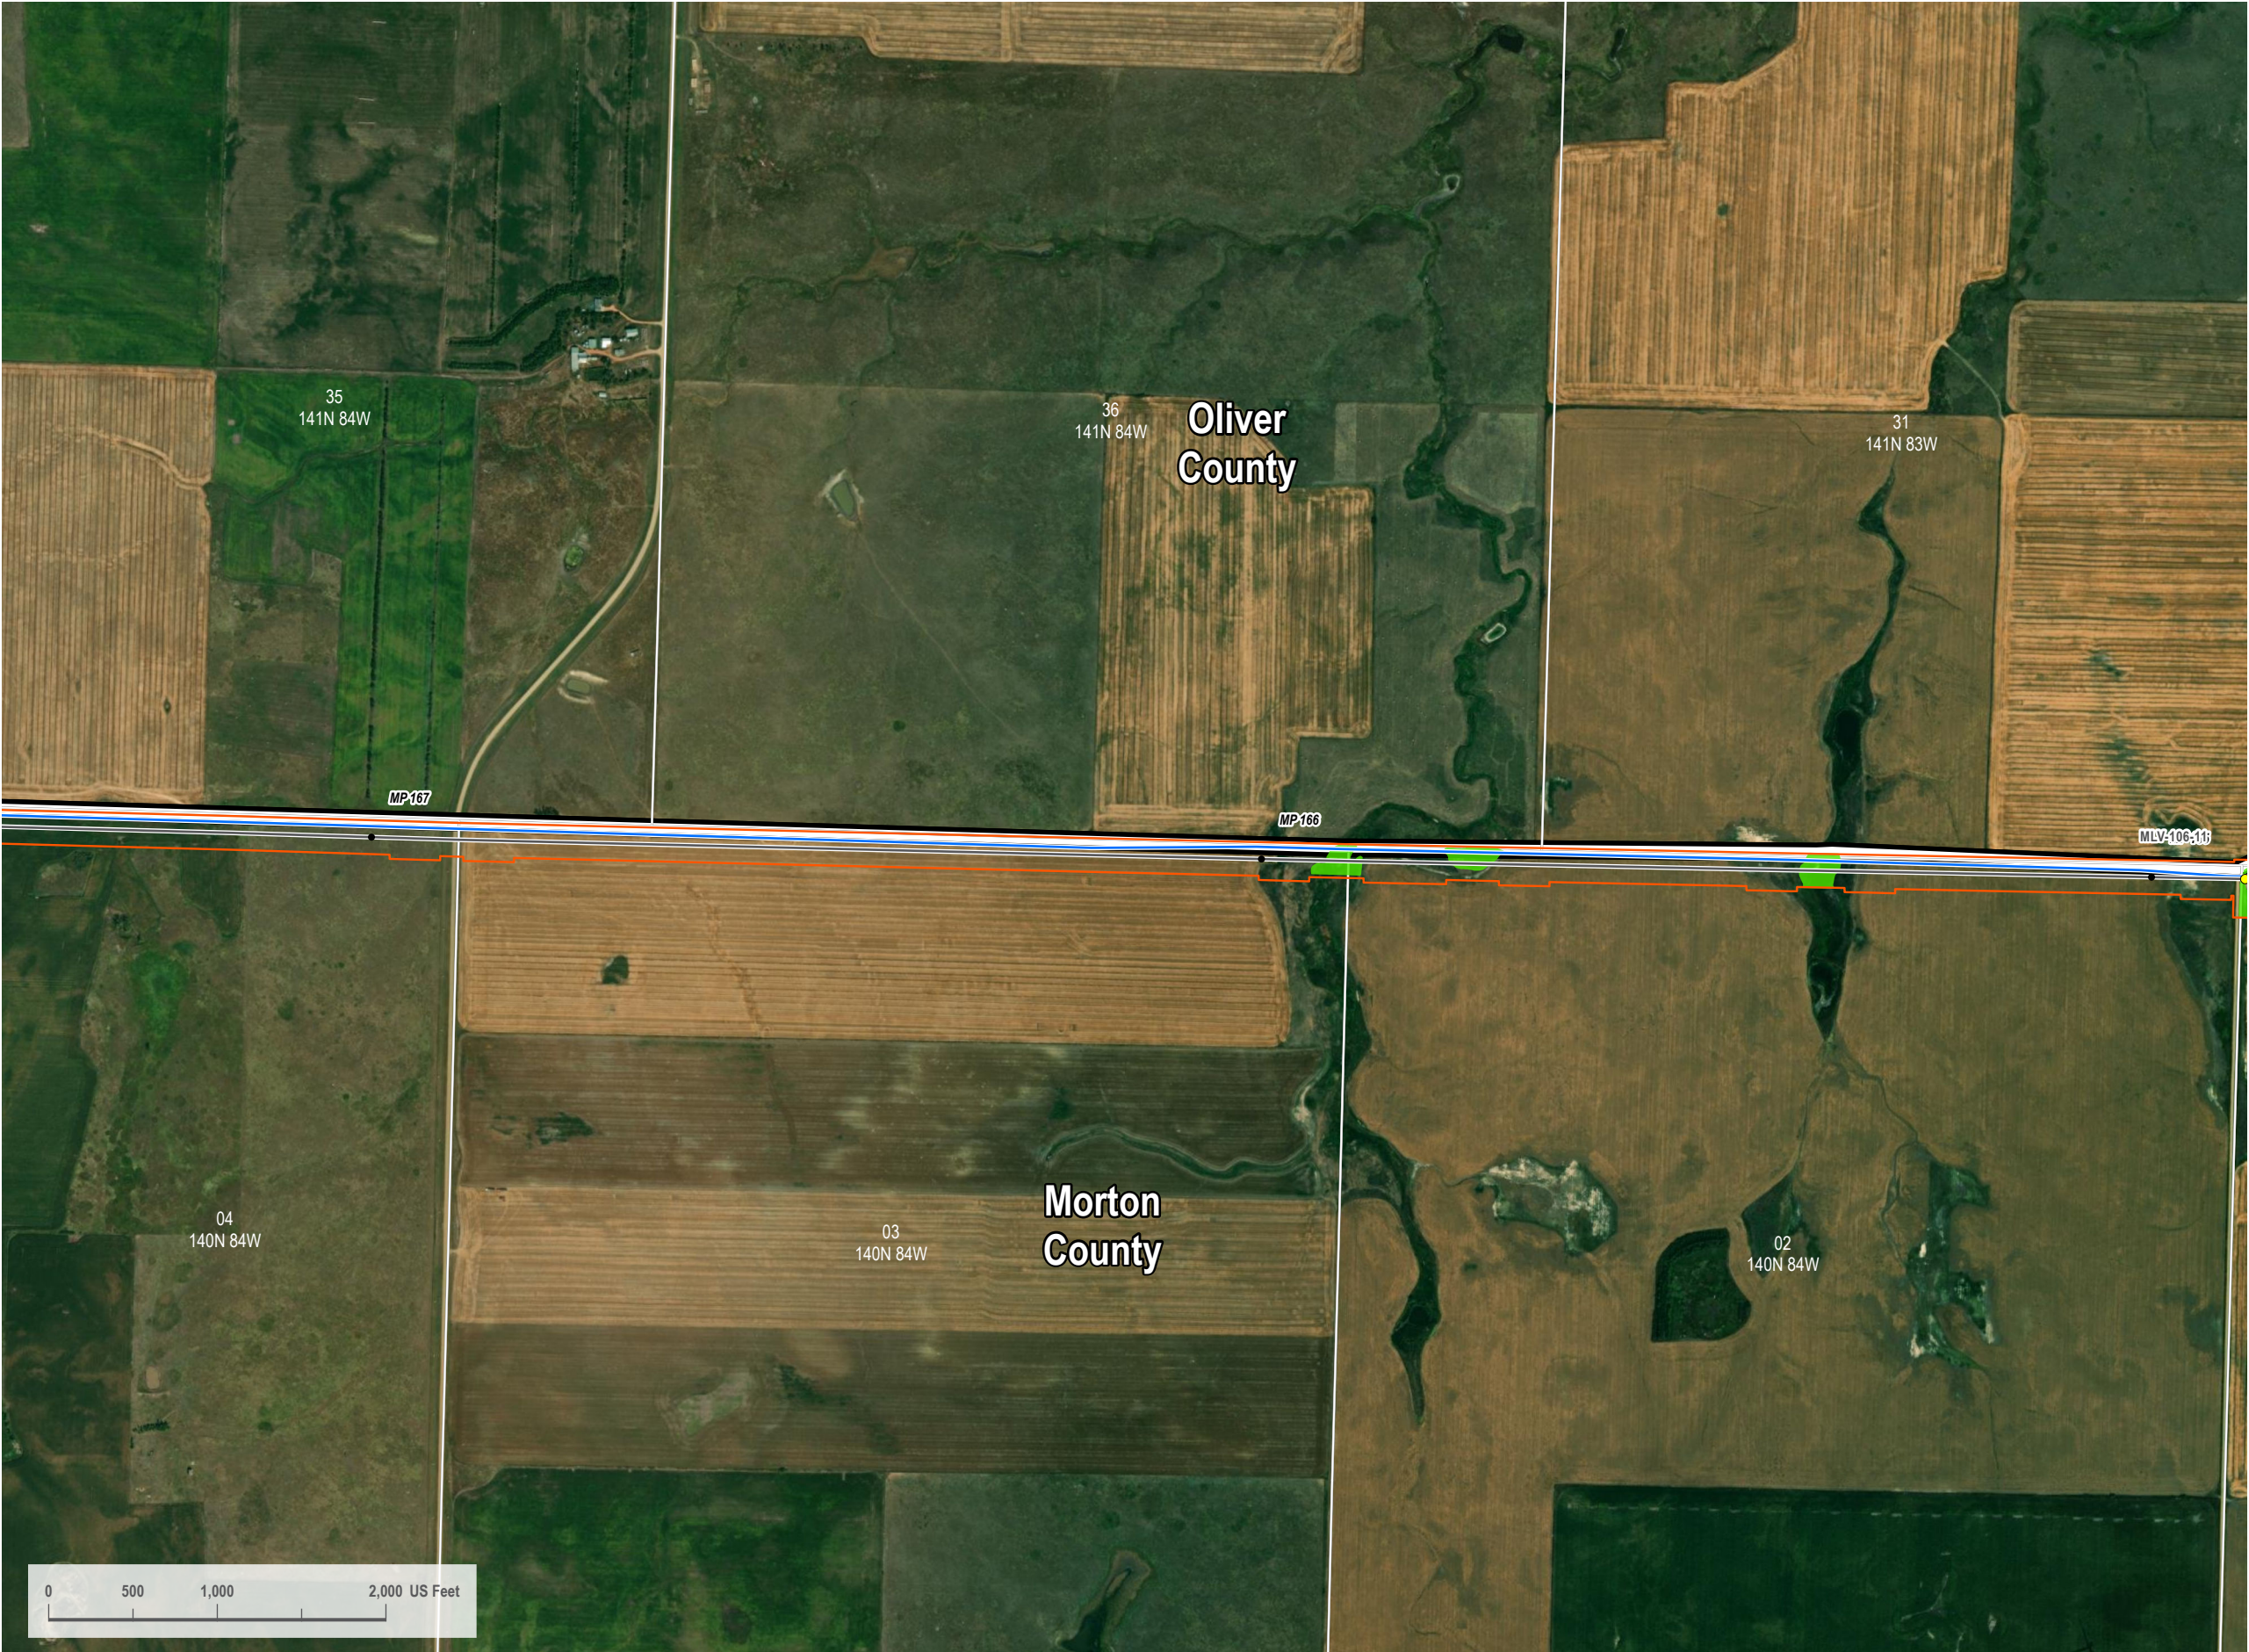


VICINITY MAP



LEGEND

- Centerline Mileposts
- Mainline Valve Location
- Updated Proposed Project Route 08/15/2023
- October 17, 2023 Original PSC Application Route
- Section Line
- PEM Wetland
- 200-foot Stiling Corridor

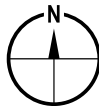

REVISIONS

Date:	2023-08-17	Revised by:	CW	Checked by:	RC
A - Issued for Review					
Date:		Revised by:		Checked by:	
Date:		Revised by:		Checked by:	

PREPARED BY

**Summit Carbon Solutions**  
2321 North Loop Drive, Suite 221  
Ames, Iowa 50010  
United States of America  
[www.summitcarbonsolutions.com](http://www.summitcarbonsolutions.com)



**SUMMIT CARBON**  
SOLUTIONS

PROJECT INFORMATION

Figure Title: <b>ND PSC - Aerial Map Book - NDM-106</b>	
Figure Number: <b>Map Book 1</b>	
Scale: <b>1 : 12,000</b> 1 inch equals 1,000 feet	Projection: <b>Transverse Mercator</b> NAD 1983 UTM Zone 14N
Sheet: <b>53</b> 53 of 139	Drawing Number: <b>1001-01-003</b> Revision A





VICINITY MAP



LEGEND

- Centerline Mileposts
- Domestic Structure or Business (Avoidance)
- Updated Proposed Project Route 08/15/2023
- October 17, 2023 Original PSC Application Route
- Section Line
- 200-foot Siting Corridor



REVISIONS

Date:	2023-08-17	Revised by:	CW	Checked by:	RC
A - Issued for Review					
Date:		Revised by:		Checked by:	
Date:		Revised by:		Checked by:	

PREPARED BY

**Summit Carbon Solutions**  
2321 North Loop Drive, Suite 221  
Ames, Iowa 50010  
United States of America  
[www.summitcarbonsolutions.com](http://www.summitcarbonsolutions.com)



**SUMMIT CARBON**  
SOLUTIONS

PROJECT INFORMATION

Figure Title: <b>ND PSC - Aerial Map Book - NDM-106</b>	
Figure Number: <b>Map Book 1</b>	
Scale: <b>1 : 12,000</b> 1 inch equals 1,000 feet	Projection: <b>Transverse Mercator</b> NAD 1983 UTM Zone 14N
Sheet: <b>54</b> 54 of 139	Drawing Number: <b>1001-01-003</b> Revision A





VICINITY MAP



LEGEND

- Centerline Mileposts
- Domestic Structure or Business (Avoidance)
- Updated Proposed Project Route 08/15/2023
- October 17, 2023 Original PSC Application Route
- Section Line
- 200-foot Siting Corridor



REVISIONS

Date:	2023-08-17	Revised by:	CW	Checked by:	RC
A - Issued for Review					
Date:		Revised by:		Checked by:	
Date:		Revised by:		Checked by:	

PREPARED BY

**Summit Carbon Solutions**  
2321 North Loop Drive, Suite 221  
Ames, Iowa 50010  
United States of America  
[www.summitcarbonsolutions.com](http://www.summitcarbonsolutions.com)



**SUMMIT CARBON**  
SOLUTIONS

PROJECT INFORMATION

Figure Title: <b>ND PSC - Aerial Map Book - NDM-106</b>	
Figure Number: <b>Map Book 1</b>	
Scale: <b>1 : 12,000</b> 1 inch equals 1,000 feet	Projection: <b>Transverse Mercator</b> NAD 1983 UTM Zone 14N
Sheet: <b>55</b> 55 of 139	Drawing Number: <b>1001-01-003</b> Revision A





VICINITY MAP

LEGEND

Centerline Mileposts	Open Water
Domestic Structure or Business (Avoidance)	PEM Wetland
Updated Proposed Project Route 08/15/2023	200-foot Stiling Corridor
October 17, 2023 Original PSC Application Route	
Section Line	

REVISIONS

Date: 2023-08-17	Revised by: CW	Checked by: RC
A - Issued for Review		
Date:	Revised by:	Checked by:
Date:	Revised by:	Checked by:

PREPARED BY

Summit Carbon Solutions

2321 North Loop Drive, Suite 221  
Ames, Iowa 50010  
United States of America

[www.summitcarbonsolutions.com](http://www.summitcarbonsolutions.com)

PROJECT INFORMATION

Figure Title:  
ND PSC - Aerial Map Book - NDM-106

Figure Number:  
Map Book 1

Scale: 1 : 12,000 1 inch equals 1,000 feet	Projection: Transverse Mercator NAD 1983 UTM Zone 14N
Sheet: 56 56 of 139	Drawing Number: 1001-01-003 Revision A





VICINITY MAP



LEGEND

- Centerline Mileposts
- Domestic Structure or Business (Avoidance)
- Updated Proposed Project Route 08/15/2023
- October 17, 2023 Original PSC Application Route
- Section Line
- Open Water
- PEM Wetland
- 200-foot Stiling Corridor



REVISIONS

Date:	2023-08-17	Revised by:	CW	Checked by:	RC
A - Issued for Review					
Date:		Revised by:		Checked by:	
Date:		Revised by:		Checked by:	

PREPARED BY

**Summit Carbon Solutions**  
2321 North Loop Drive, Suite 221  
Ames, Iowa 50010  
United States of America  
[www.summitcarbonsolutions.com](http://www.summitcarbonsolutions.com)



**SUMMIT CARBON**  
SOLUTIONS

PROJECT INFORMATION

Figure Title: <b>ND PSC - Aerial Map Book - NDM-106</b>	
Figure Number: <b>Map Book 1</b>	
Scale: <b>1 : 12,000</b> 1 inch equals 1,000 feet	Projection: <b>Transverse Mercator</b> NAD 1983 UTM Zone 14N
Sheet: <b>57</b> 57 of 139	Drawing Number: <b>1001-01-003</b> Revision A





VICINITY MAP



LEGEND

- Centerline Mileposts
- Domestic Structure or Business (Avoidance)
- Updated Proposed Project Route 08/15/2023
- October 17, 2023 Original PSC Application Route
- Section Line
- PEM Wetland
- 200-foot Siting Corridor



REVISIONS

Date:	2023-08-17	Revised by:	CW	Checked by:	RC
A - Issued for Review					
Date:		Revised by:		Checked by:	
Date:		Revised by:		Checked by:	

PREPARED BY

**Summit Carbon Solutions**  
2321 North Loop Drive, Suite 221  
Ames, Iowa 50010  
United States of America  
[www.summitcarbonsolutions.com](http://www.summitcarbonsolutions.com)




**SUMMIT CARBON**  
SOLUTIONS

PROJECT INFORMATION

Figure Title: <b>ND PSC - Aerial Map Book - NDM-106</b>	
Figure Number: <b>Map Book 1</b>	
Scale: <b>1 : 12,000</b> 1 inch equals 1,000 feet	Projection: <b>Transverse Mercator</b> NAD 1983 UTM Zone 14N
Sheet: <b>58</b> 58 of 139	Drawing Number: <b>1001-01-003</b> Revision A



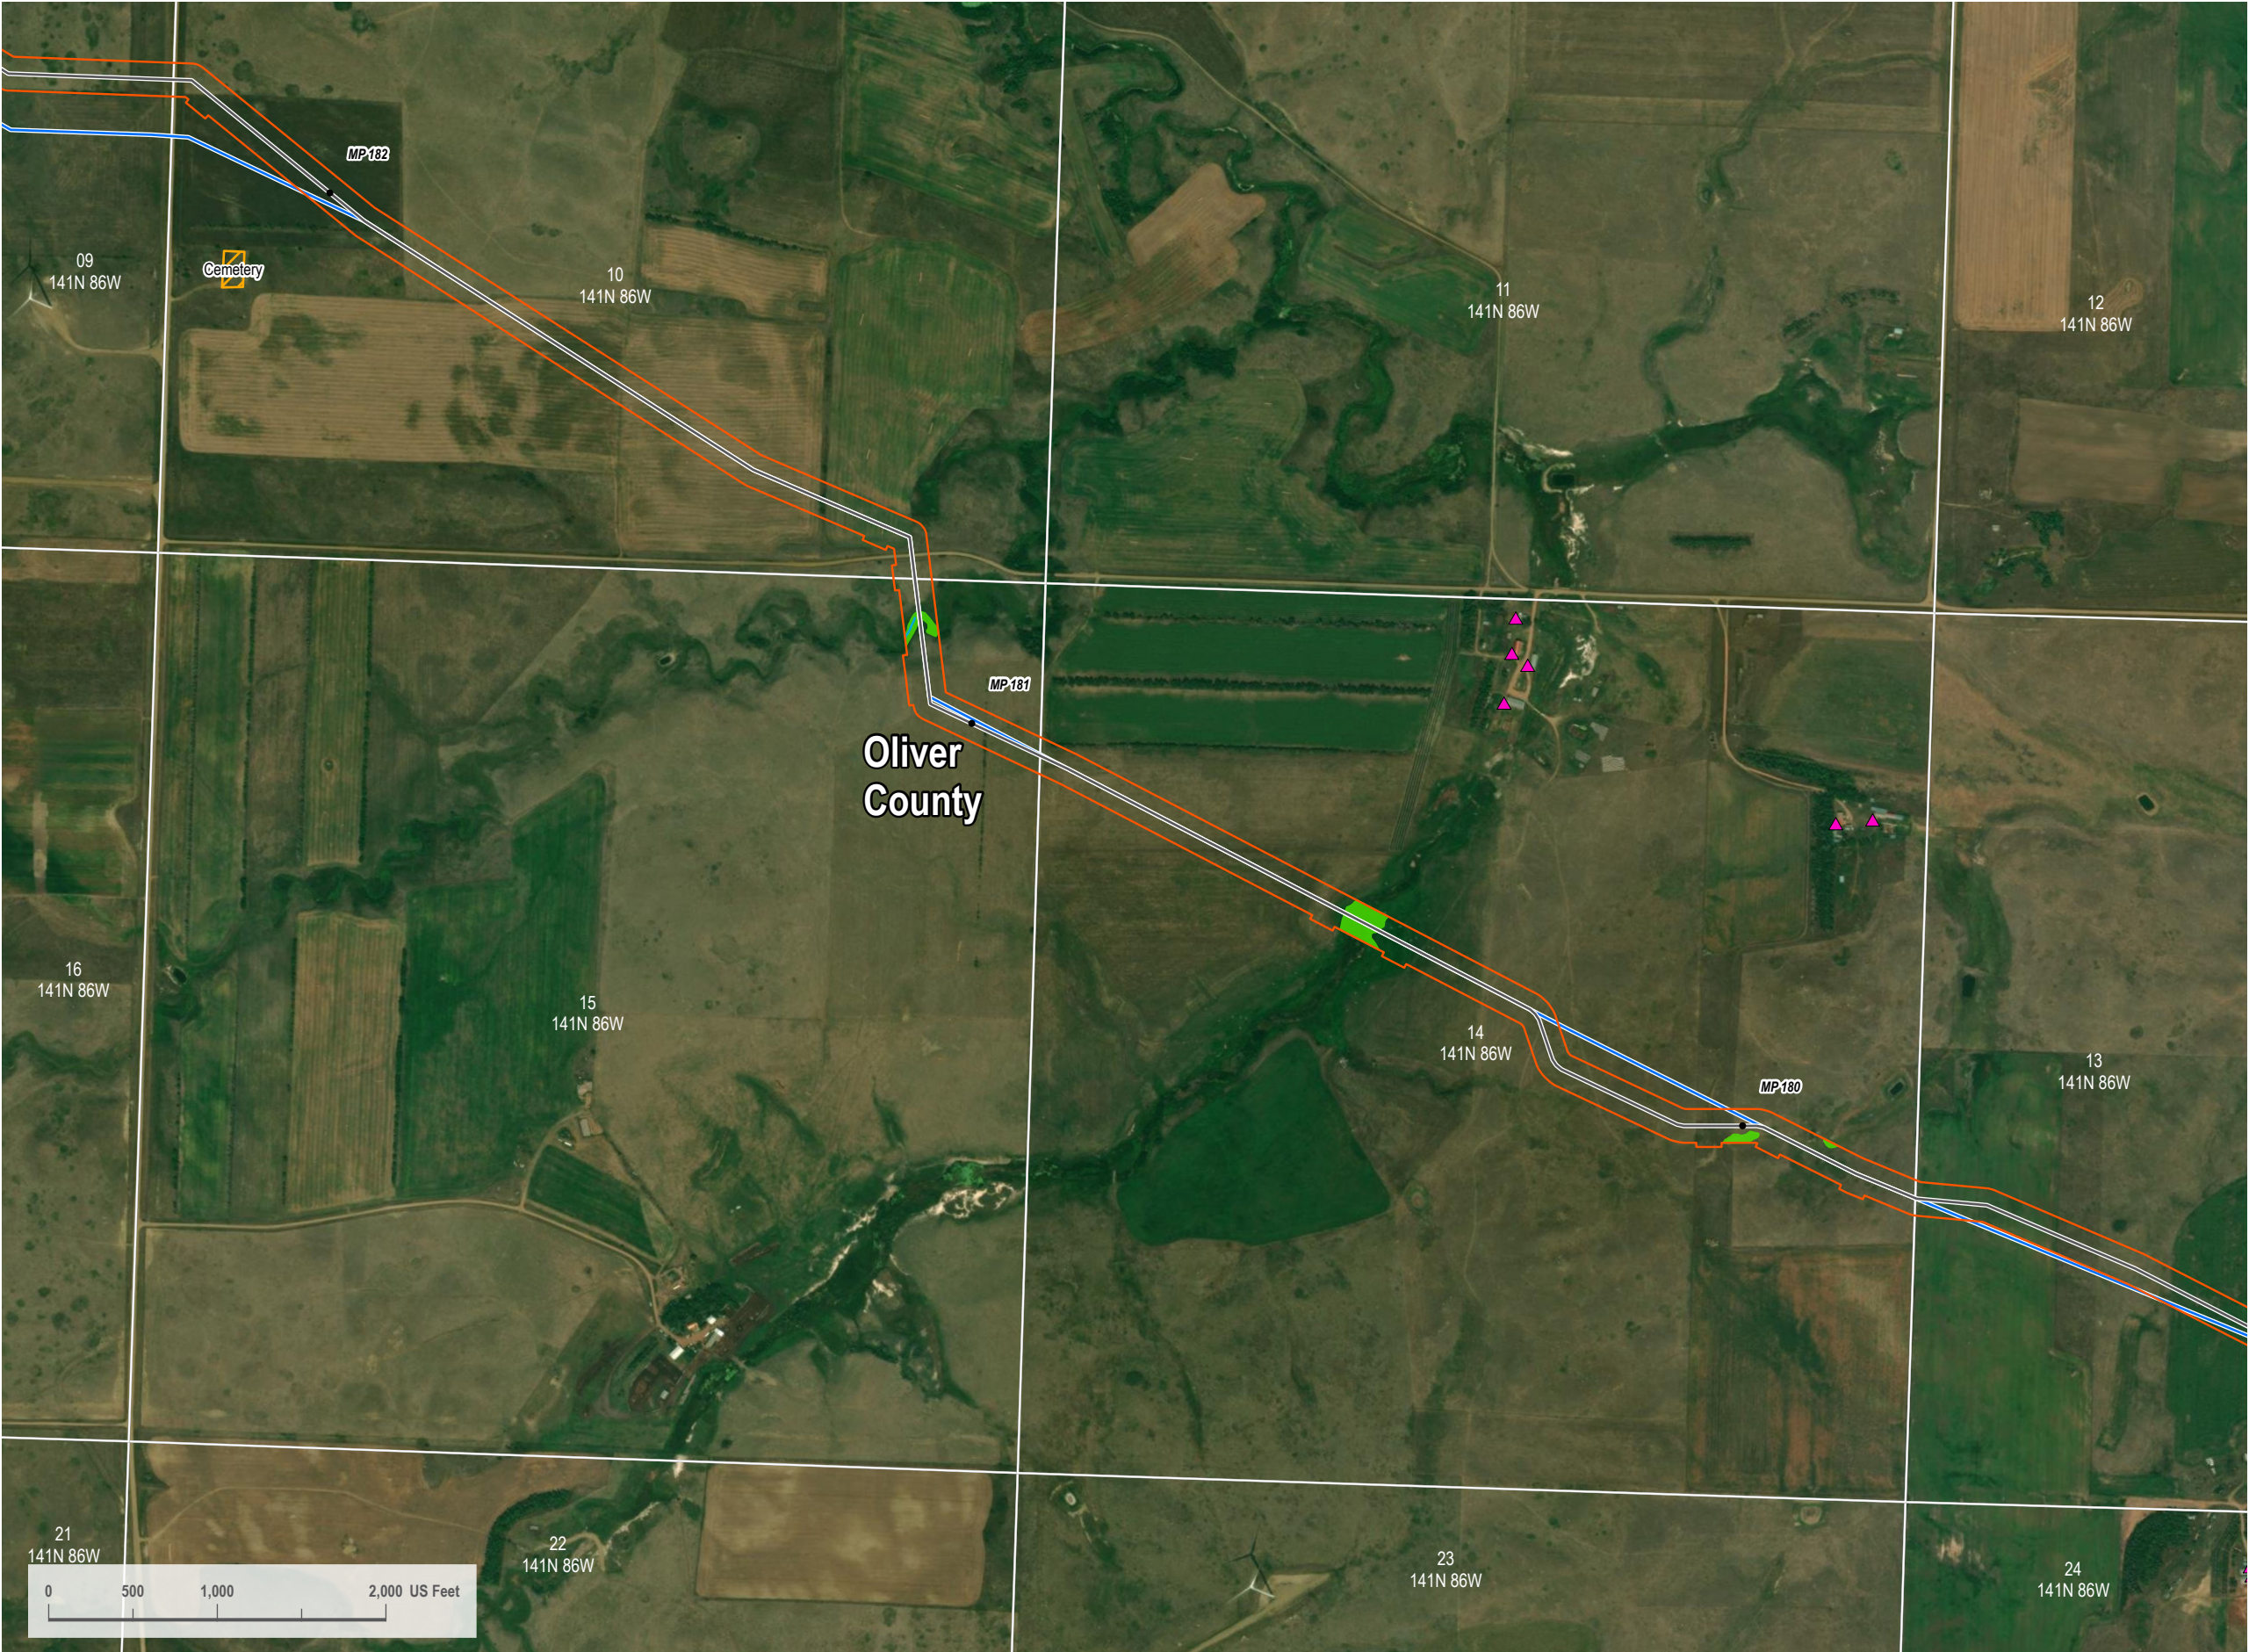


VICINITY MAP



LEGEND

- Centerline Mileposts
- Domestic Structure or Business (Avoidance)
- Updated Proposed Project Route 08/15/2023
- October 17, 2023 Original PSC Application Route
- Section Line
- Avoidance Area
- PEM Wetland
- Stream
- 200-foot Siting Corridor

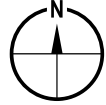

REVISIONS

Date:	2023-08-17	Revised by:	CW	Checked by:	RC
A - Issued for Review					
Date:		Revised by:		Checked by:	
Date:		Revised by:		Checked by:	

PREPARED BY


**Summit Carbon Solutions**  
2321 North Loop Drive, Suite 221  
Ames, Iowa 50010  
United States of America  
[www.summitcarbonsolutions.com](http://www.summitcarbonsolutions.com)

**SUMMIT CARBON SOLUTIONS**

PROJECT INFORMATION

Figure Title: <b>ND PSC - Aerial Map Book - NDM-106</b>	
Figure Number: <b>Map Book 1</b>	
Scale: <b>1 : 12,000</b> 1 inch equals 1,000 feet	Projection: <b>Transverse Mercator</b> NAD 1983 UTM Zone 14N
Sheet: <b>59</b> 59 of 139	Drawing Number: <b>1001-01-003</b> Revision A



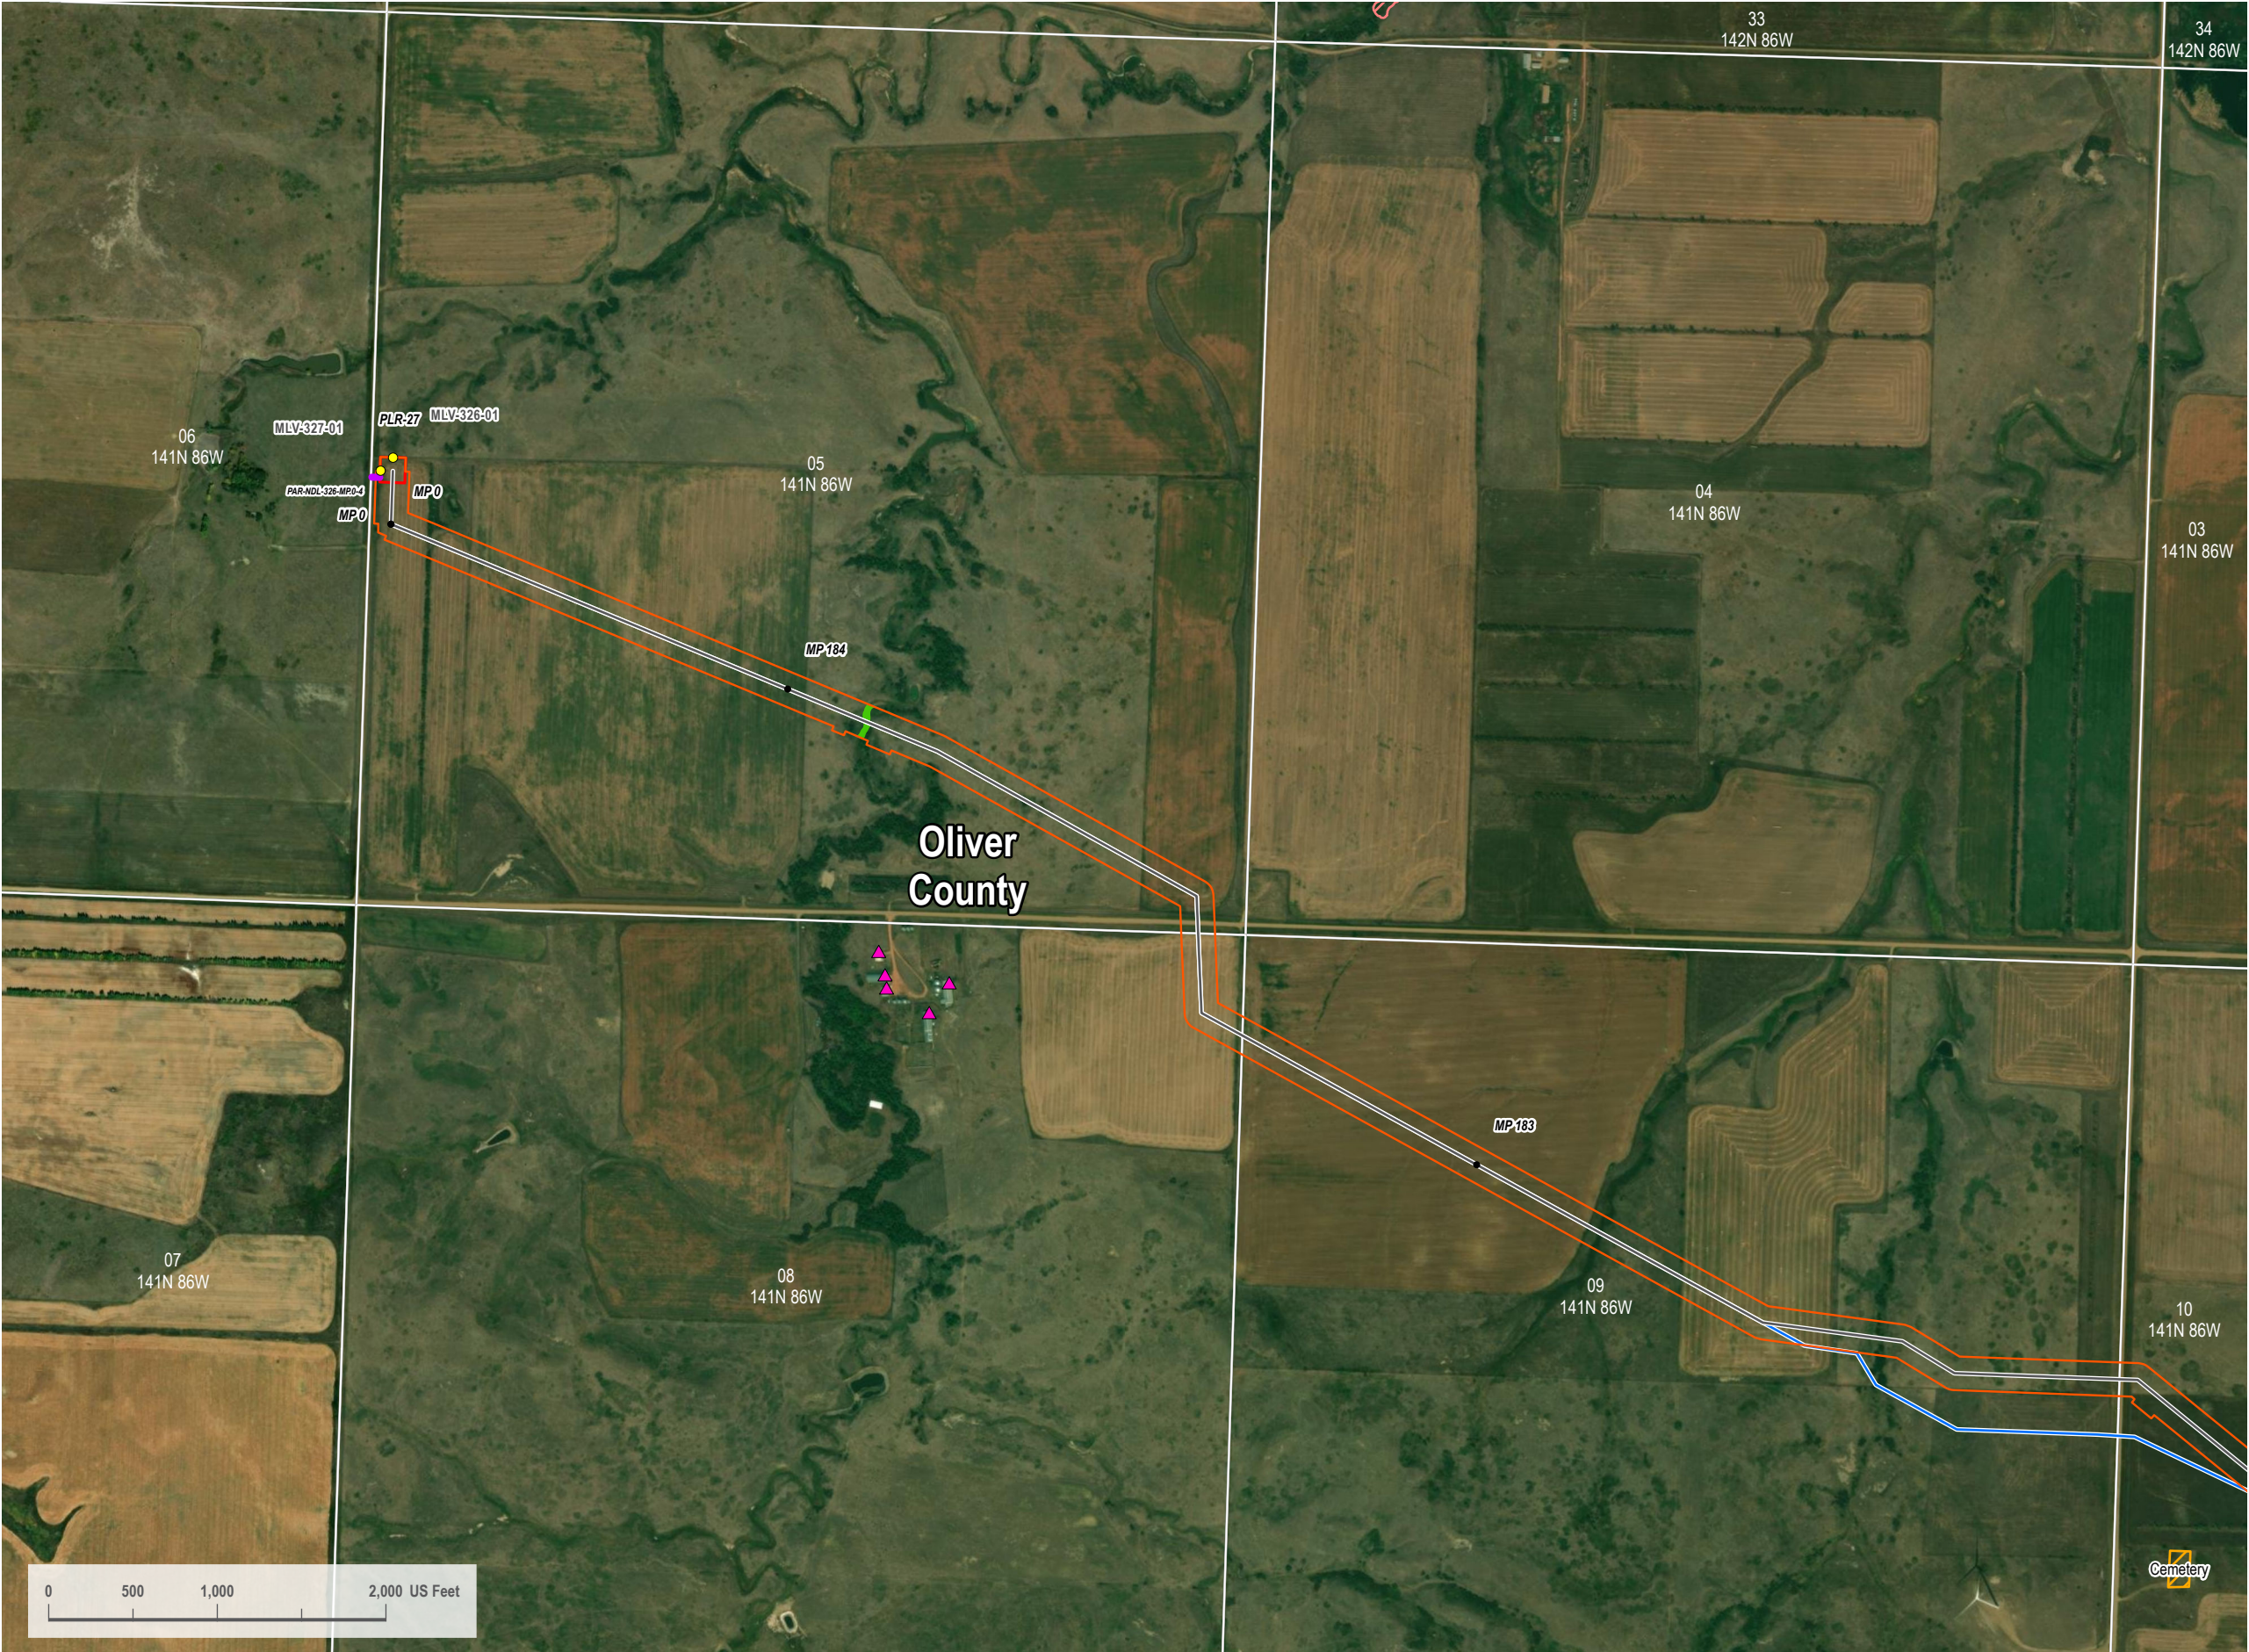

VICINITY MAP

LEGEND

- Centerline Mileposts
- Mainline Valve Location
- Domestic Structure or Business (Avoidance)
- Updated Proposed Project Route 08/15/2023
- October 17, 2023 Original PSC Application Route
- Section Line
- Access Road
- Landslide Deposit (Avoidance)
- Facility Boundary
- Avoidance Area
- PEM Wetland
- 200-foot Siting Corridor

REVISIONS

Date: 2023-08-17	Revised by: CW	Checked by: RC
A - Issued for Review		
Date:	Revised by:	Checked by:
Date:	Revised by:	Checked by:

PREPARED BY

Summit Carbon Solutions

2321 North Loop Drive, Suite 221  
Ames, Iowa 50010  
United States of America

[www.summitcarbonsolutions.com](http://www.summitcarbonsolutions.com)


PROJECT INFORMATION

Figure Title: ND PSC - Aerial Map Book - NDM-106

Figure Number: Map Book 1

Scale: 1 : 12,000 1 inch equals 1,000 feet	Projection: Transverse Mercator NAD 1983 UTM Zone 14N
Sheet: 60 60 of 139	Drawing Number: 1001-01-003 Revision A



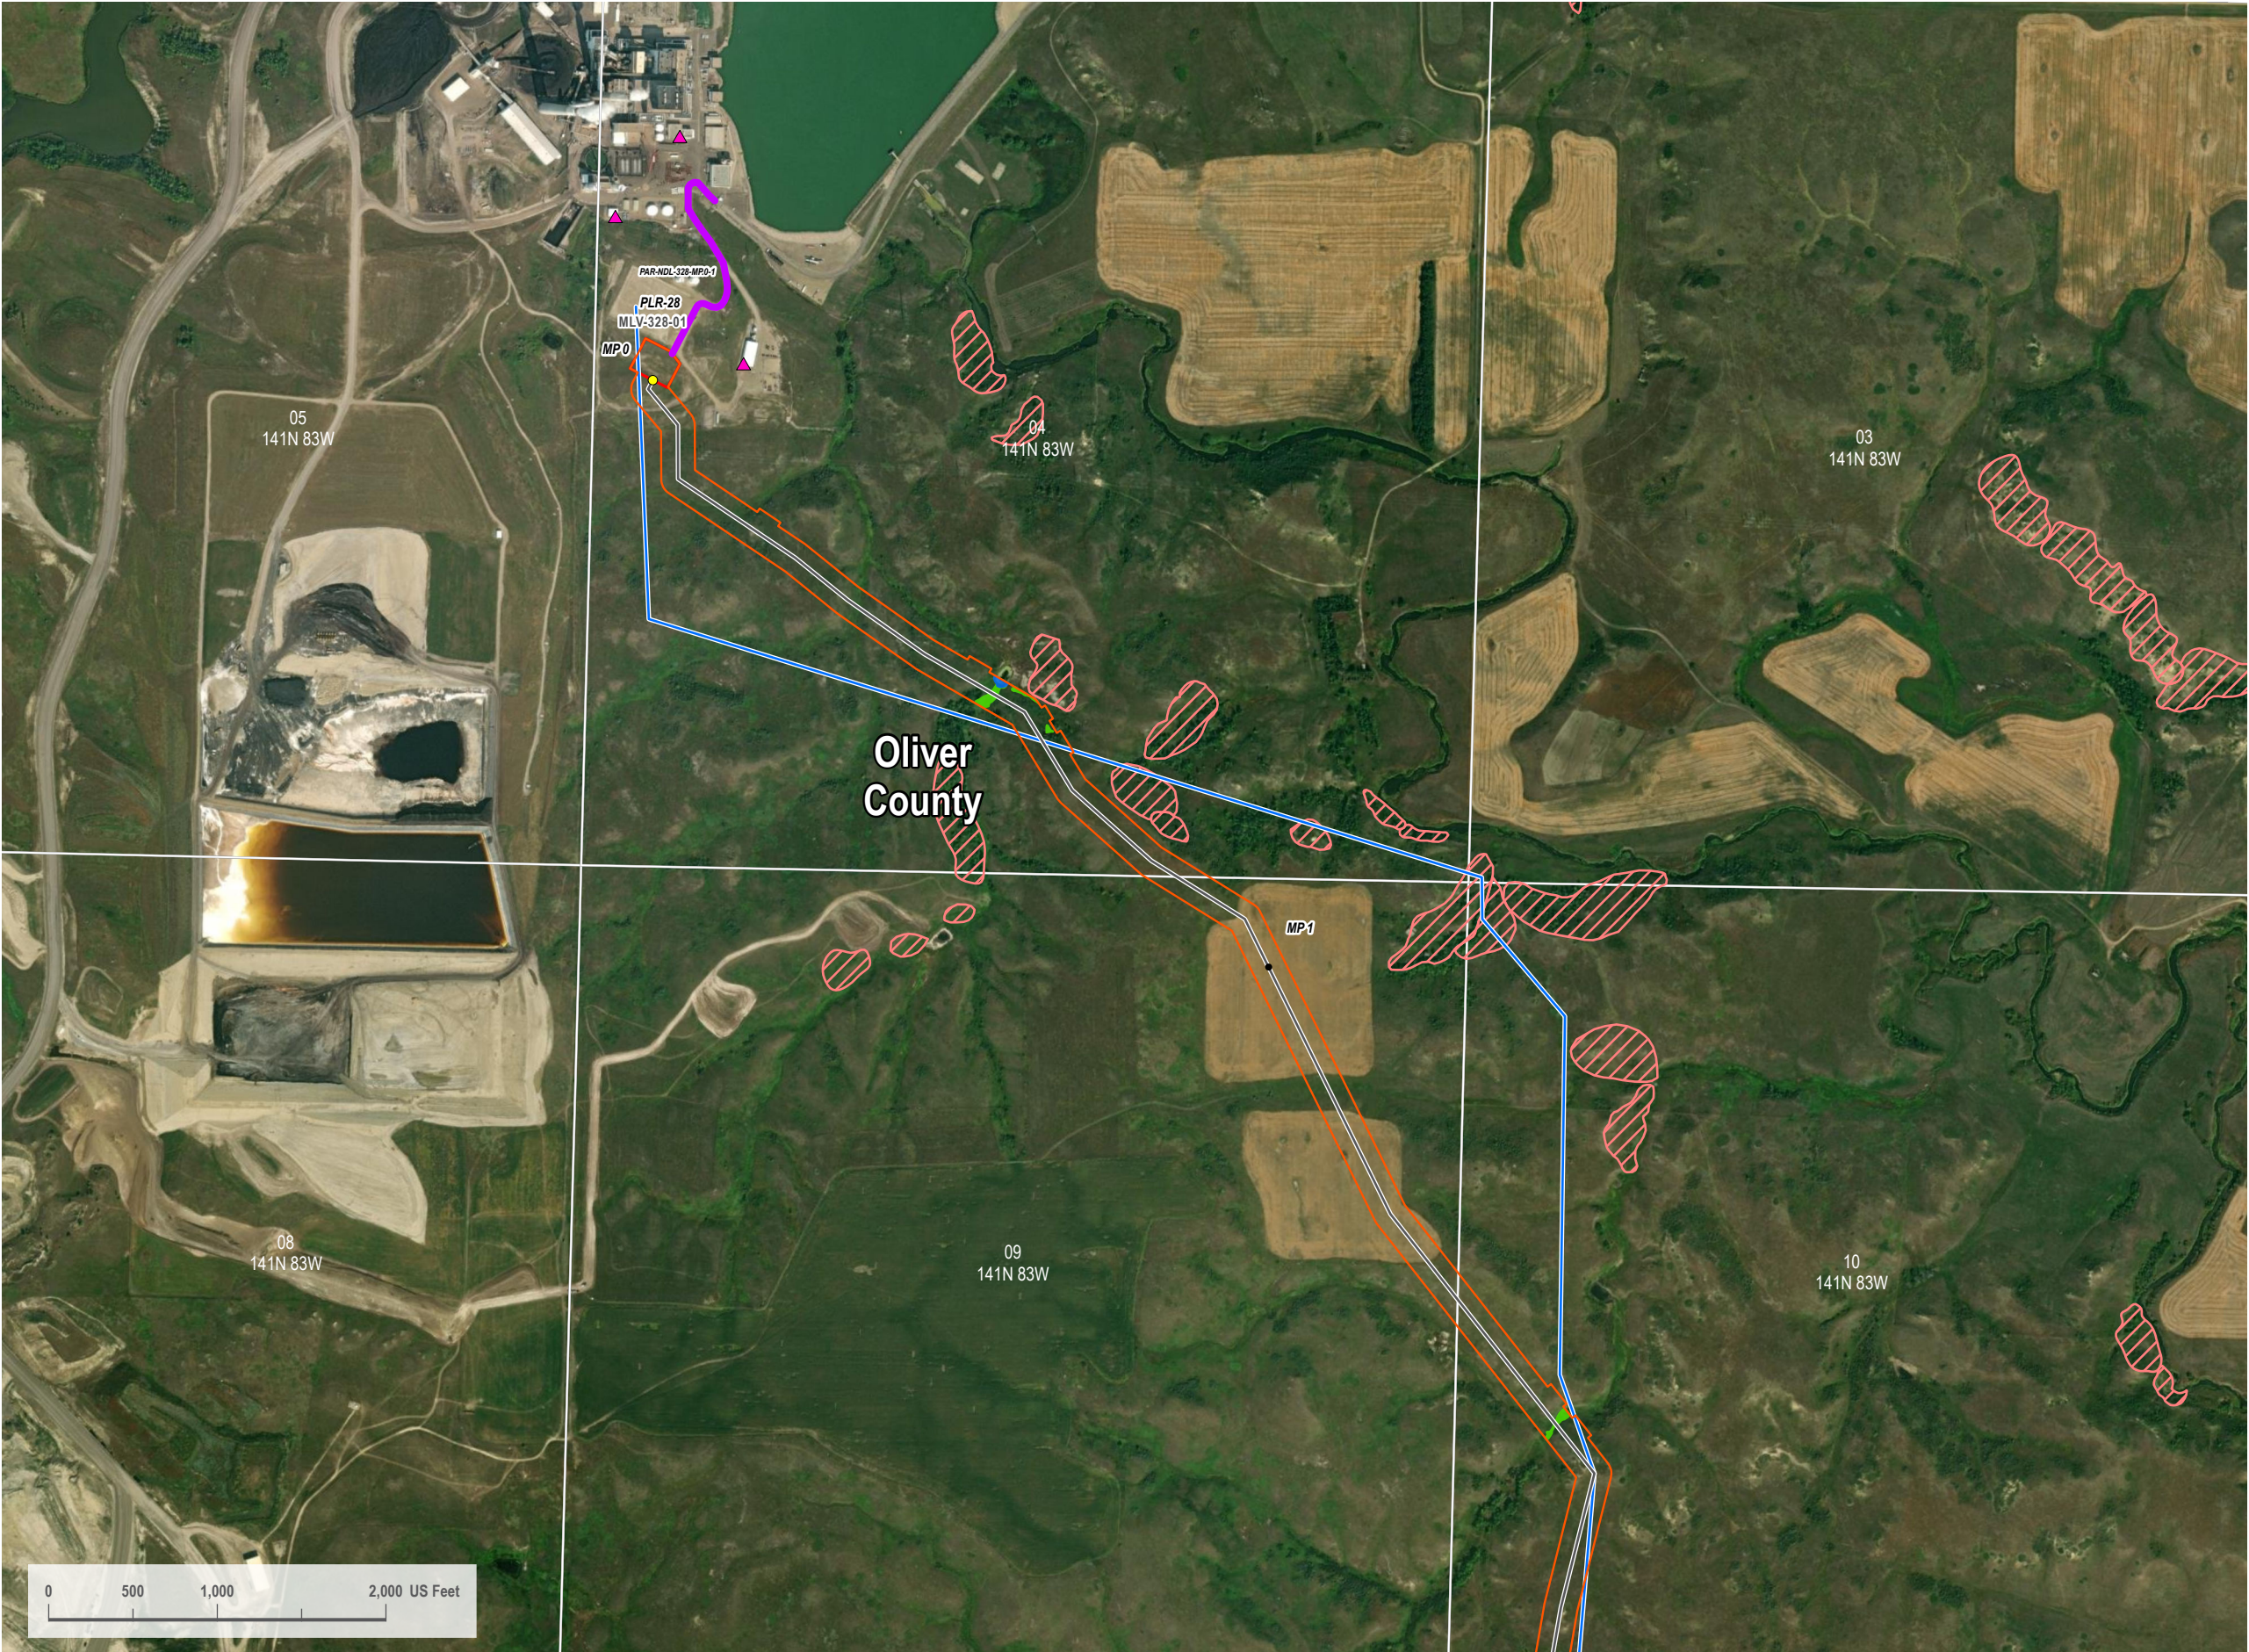

VICINITY MAP



LEGEND

- Centerline Mileposts
- Mainline Valve Location
- Domestic Structure or Business (Avoidance)
- Updated Proposed Project Route 08/15/2023
- October 17, 2023 Original PSC Application Route
- Section Line
- Access Road
- Landslide Deposit (Avoidance)
- Facility Boundary
- Open Water
- PEM Wetland
- 200-foot Siting Corridor



REVISIONS

Date: 2023-08-17	Revised by: CW	Checked by: RC
A - Issued for Review		
Date:	Revised by:	Checked by:
Date:	Revised by:	Checked by:

PREPARED BY

**Summit Carbon Solutions**  
2321 North Loop Drive, Suite 221  
Ames, Iowa 50010  
United States of America  
[www.summitcarbonsolutions.com](http://www.summitcarbonsolutions.com)




**SUMMIT CARBON**  
SOLUTIONS

PROJECT INFORMATION

Figure Title: <b>ND PSC - Aerial Map Book - NDL-328</b>	
Figure Number: <b>Map Book 1</b>	
Scale: <b>1 : 12,000</b> 1 inch equals 1,000 feet	Projection: <b>Transverse Mercator</b> NAD 1983 UTM Zone 14N
Sheet: <b>61</b> 61 of 139	Drawing Number: <b>1001-01-003</b> Revision A



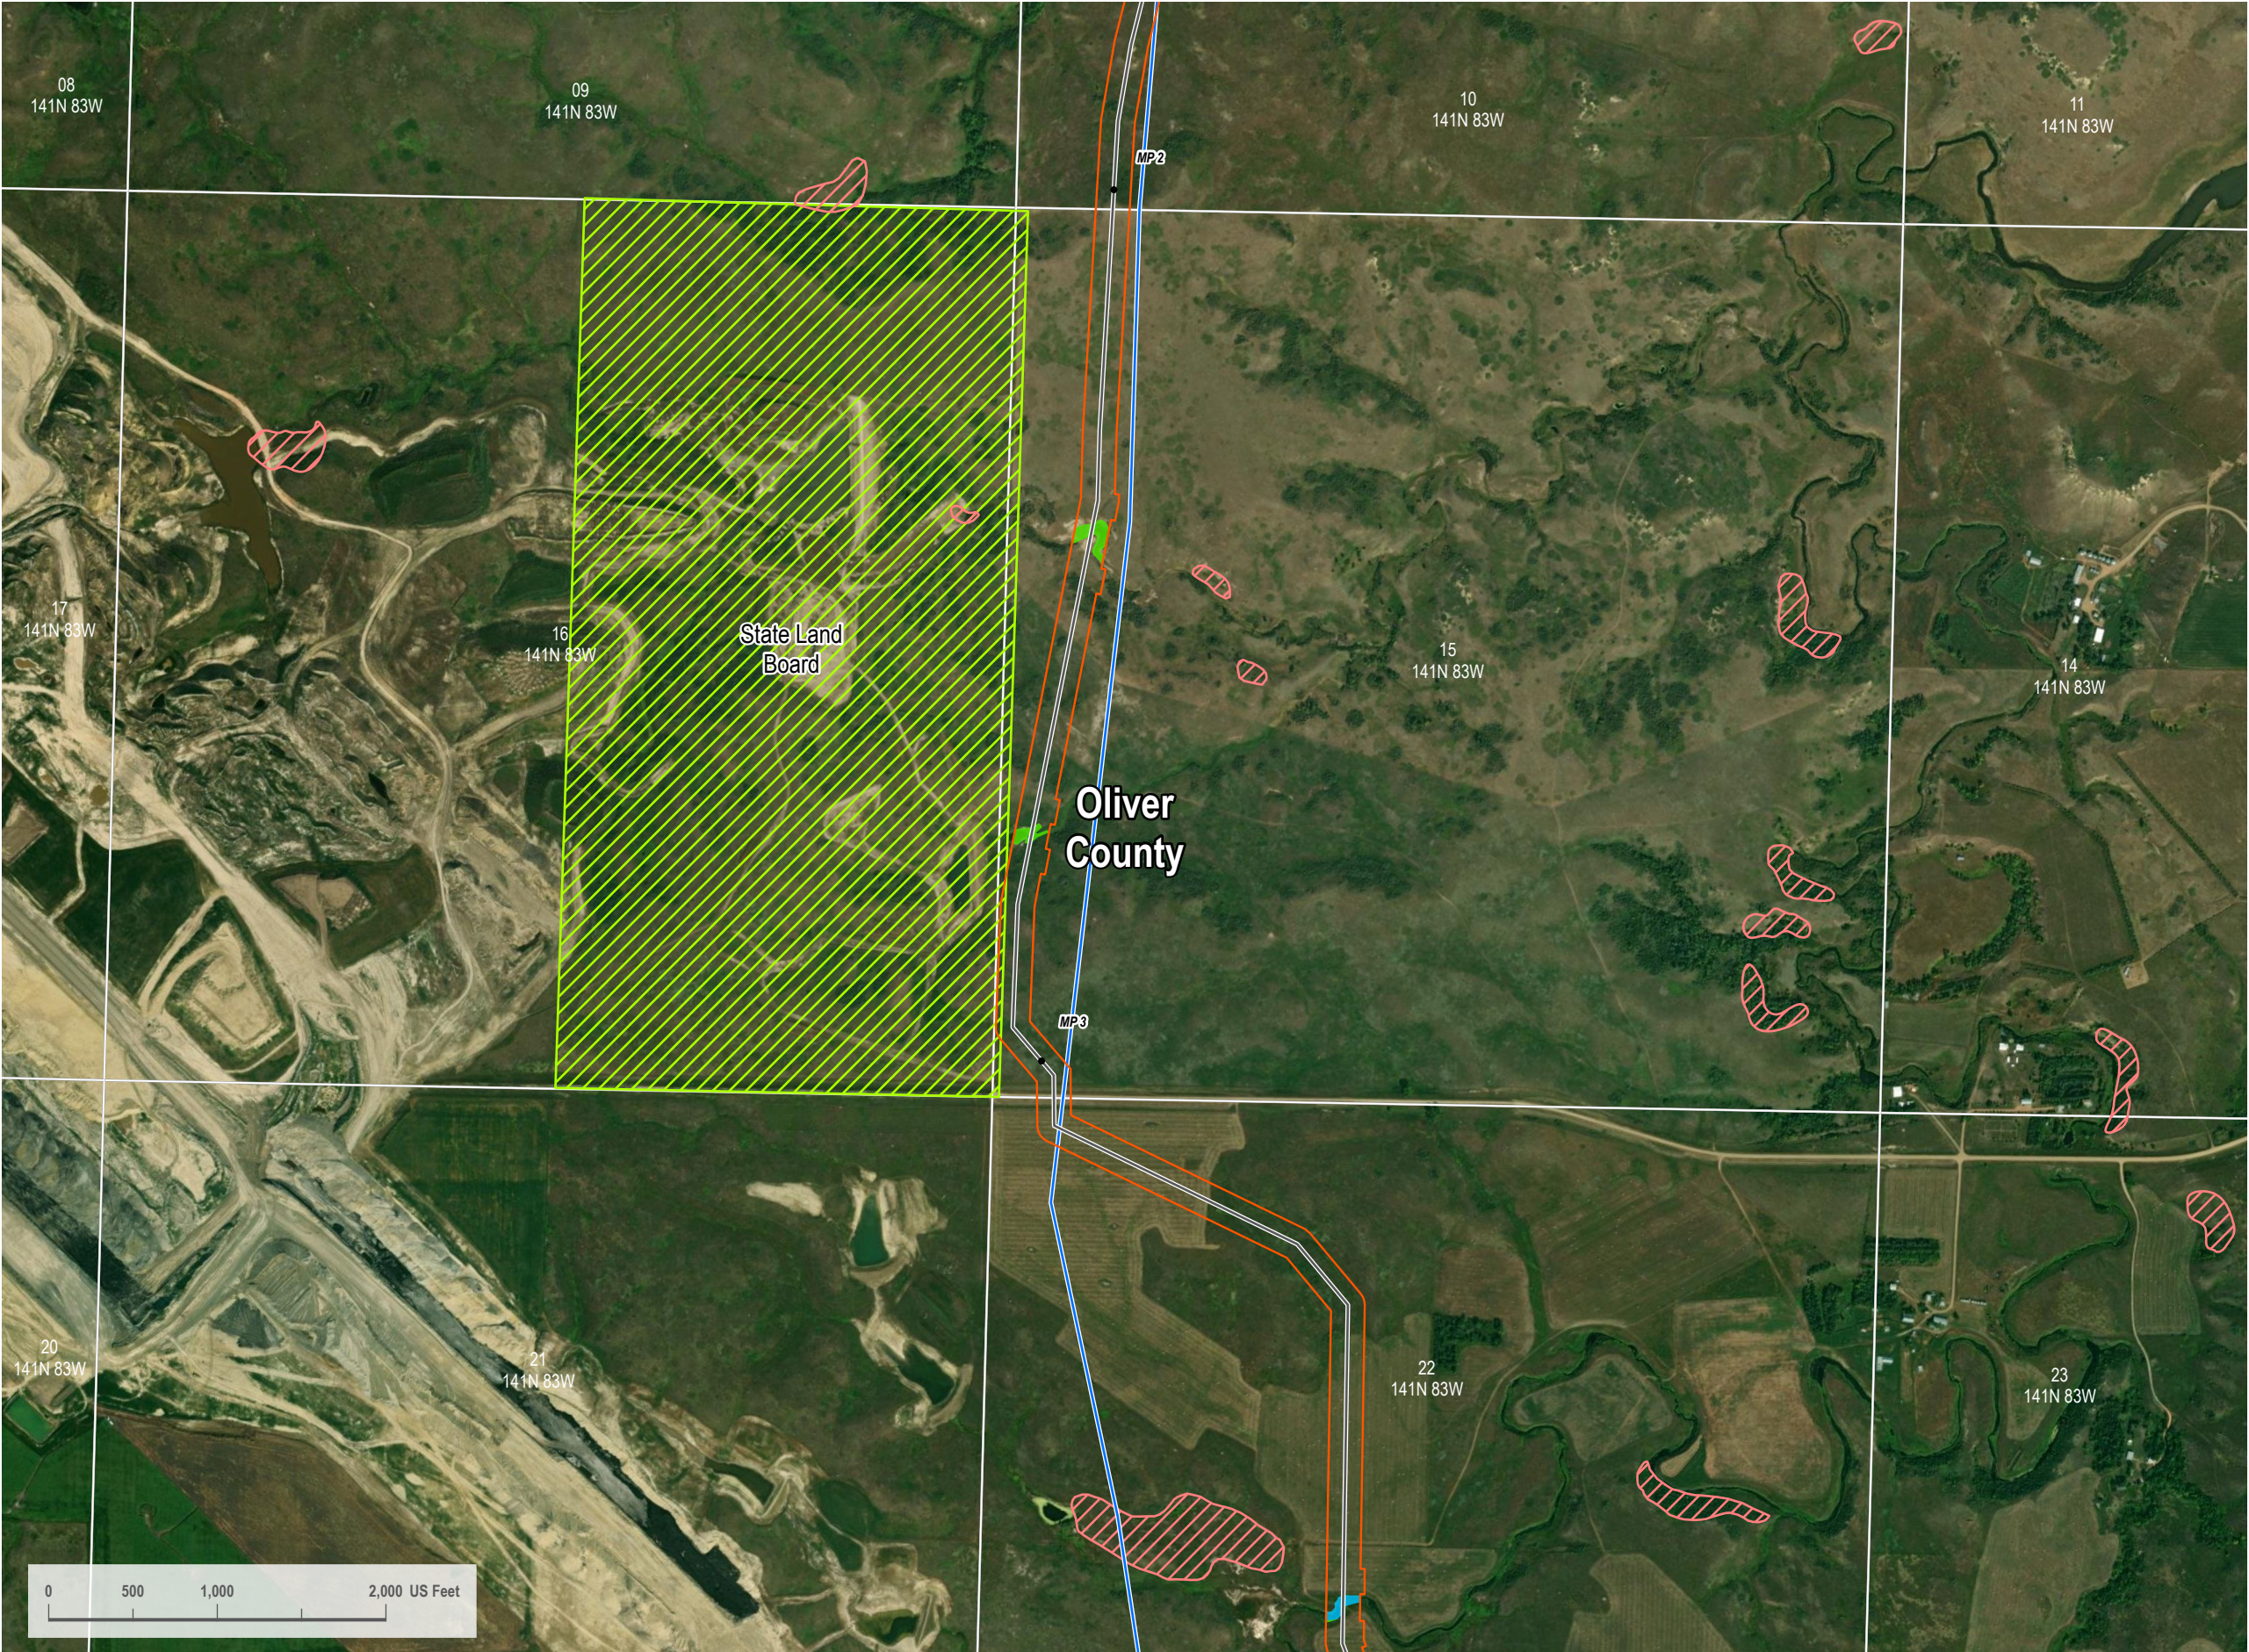

VICINITY MAP



LEGEND

- Centerline Mileposts
- Updated Proposed Project Route 08/15/2023
- October 17, 2023 Original PSC Application Route
- Section Line
- Landslide Deposit (Avoidance)
- PEM Wetland
- Stream
- 200-foot Siting Corridor
- State Resource Management Area



REVISIONS

Date:	2023-08-17	Revised by:	CW	Checked by:	RC
A - Issued for Review					
Date:		Revised by:		Checked by:	
Date:		Revised by:		Checked by:	

PREPARED BY

**Summit Carbon Solutions**  
2321 North Loop Drive, Suite 221  
Ames, Iowa 50010  
United States of America  
[www.summitcarbonsolutions.com](http://www.summitcarbonsolutions.com)




**SUMMIT CARBON**  
SOLUTIONS

PROJECT INFORMATION

Figure Title: <b>ND PSC - Aerial Map Book - NDL-328</b>	
Figure Number: <b>Map Book 1</b>	
Scale: <b>1 : 12,000</b> 1 inch equals 1,000 feet	Projection: <b>Transverse Mercator</b> NAD 1983 UTM Zone 14N
Sheet: <b>62</b> 62 of 139	Drawing Number: <b>1001-01-003</b> Revision A



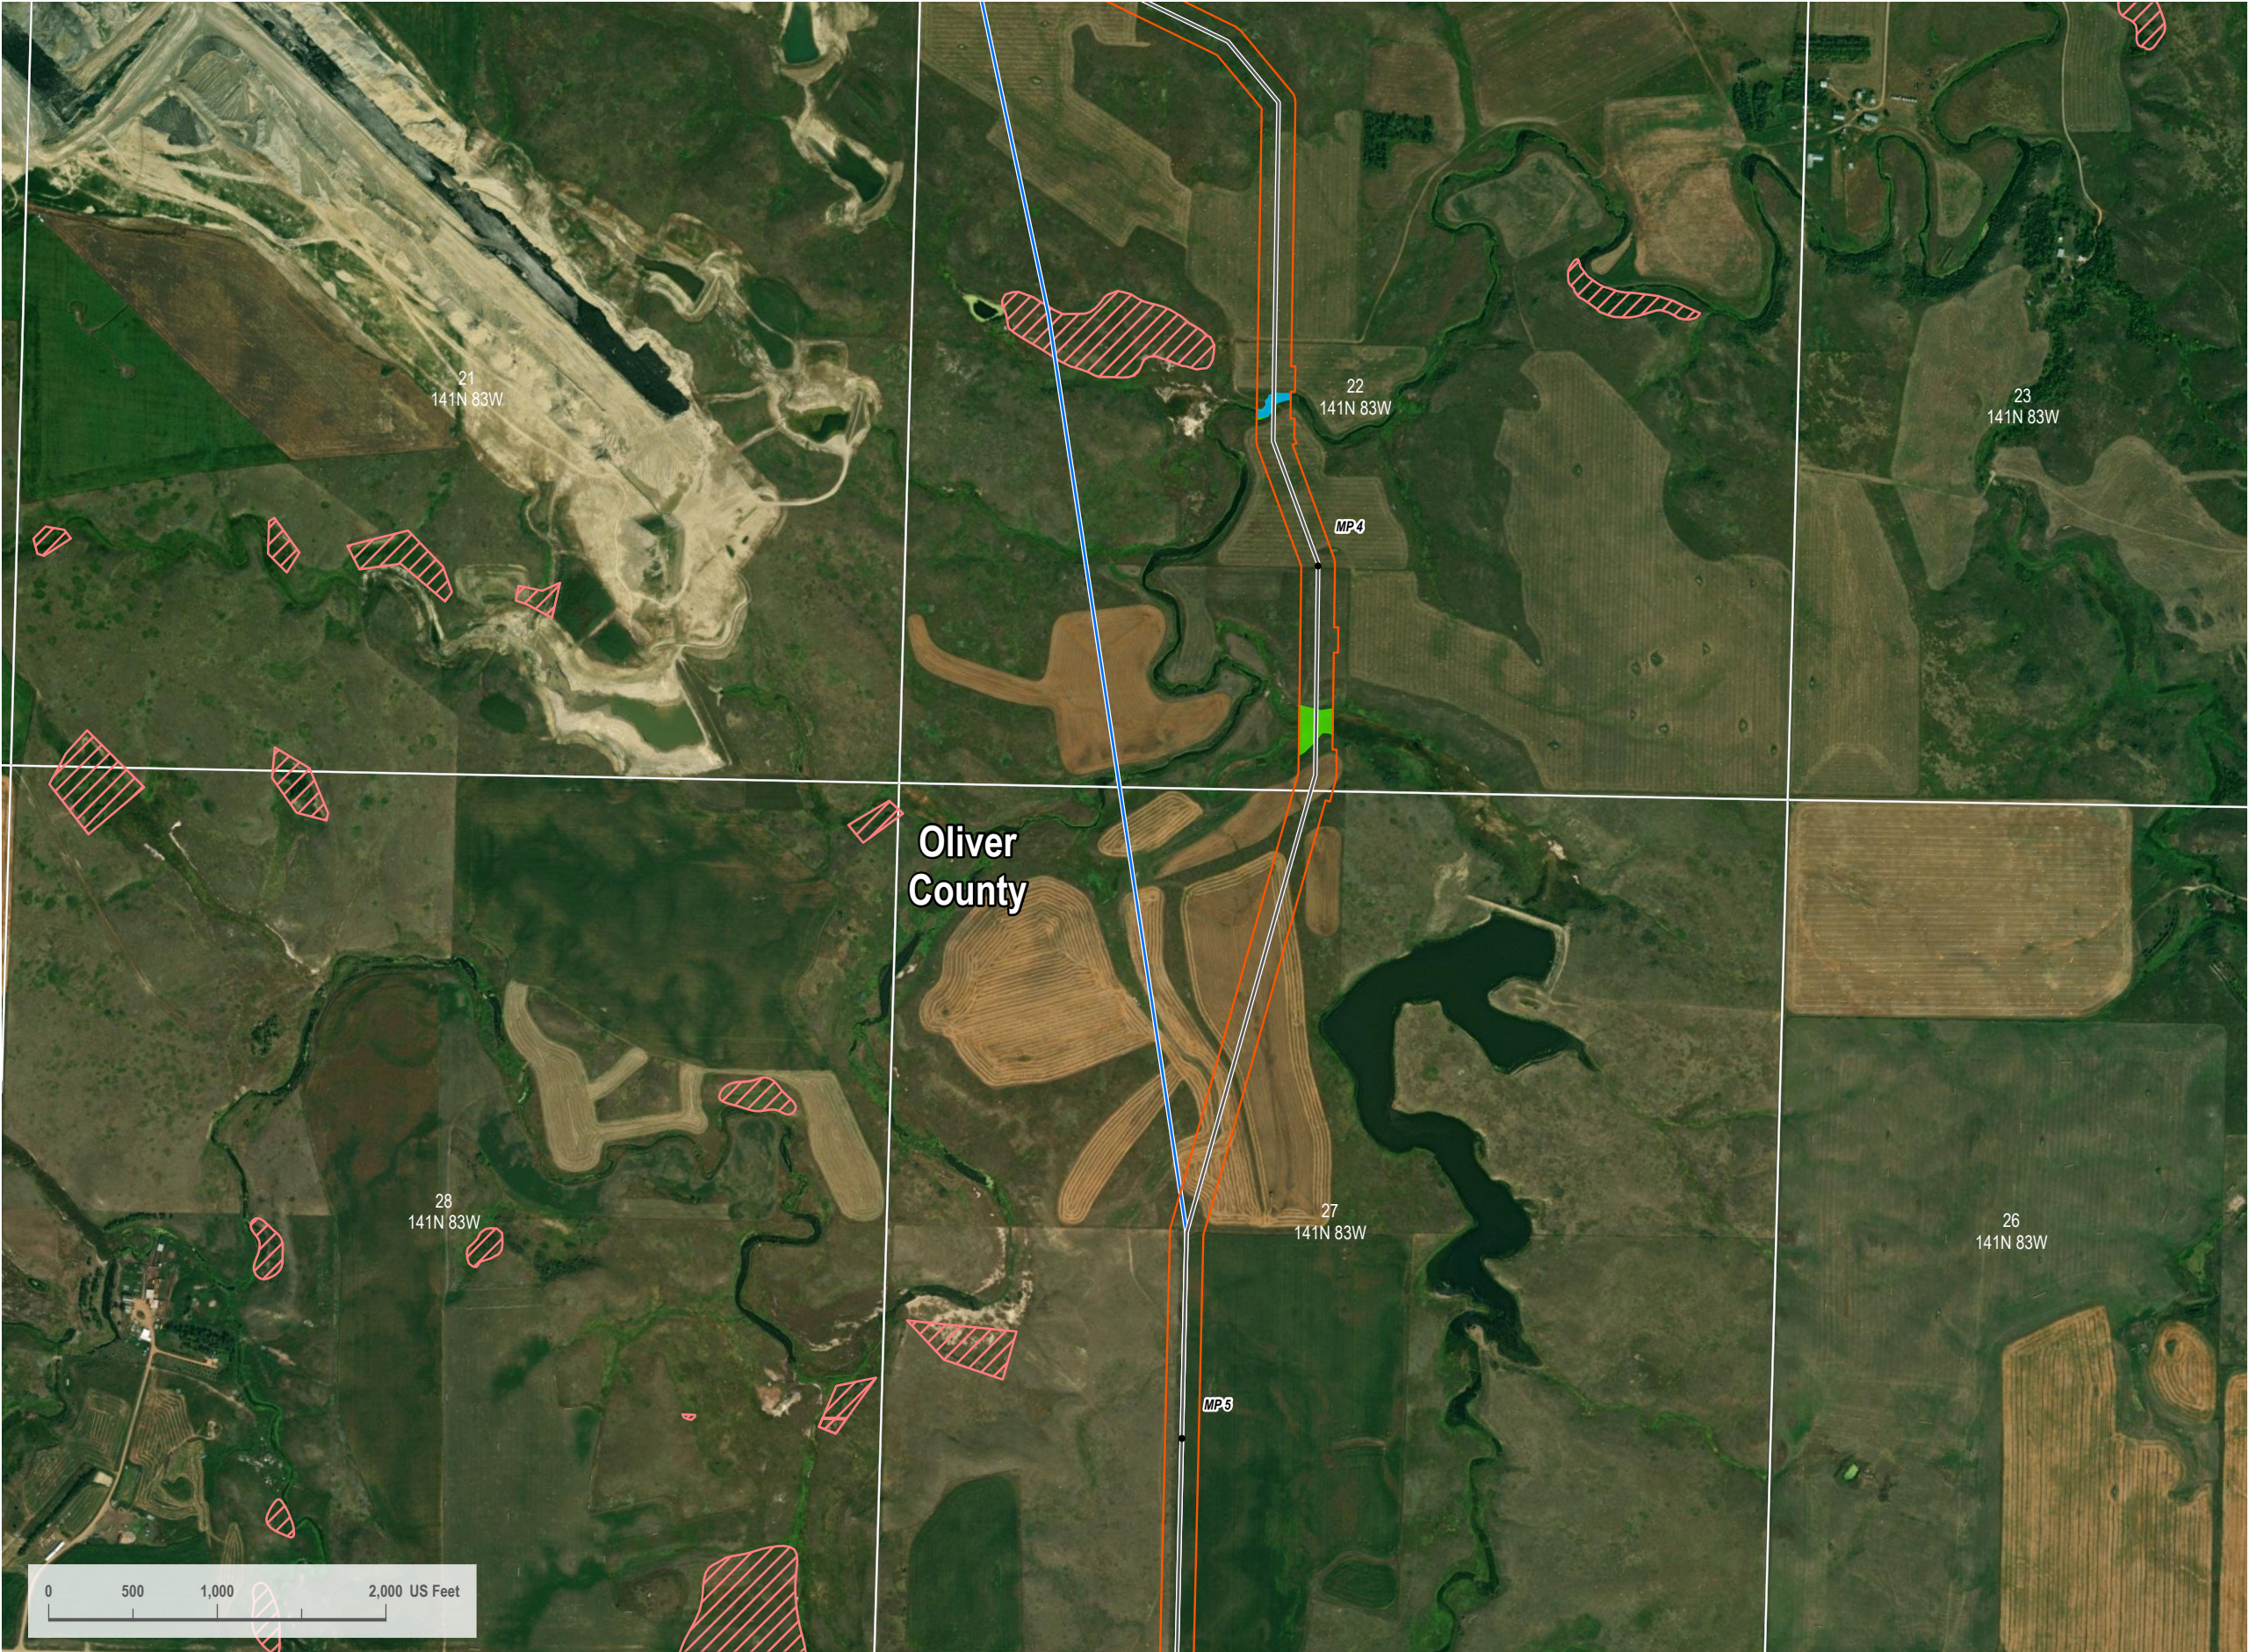

VICINITY MAP



LEGEND

- Centerline Mileposts
- Updated Proposed Project Route 08/15/2023
- October 17, 2023 Original PSC Application Route
- Section Line
- Landslide Deposit (Avoidance)
- PEM Wetland
- Stream
- 200-foot Siting Corridor



REVISIONS

Date:	2023-08-17	Revised by:	CW	Checked by:	RC
A - Issued for Review					
Date:		Revised by:		Checked by:	
Date:		Revised by:		Checked by:	

PREPARED BY

**Summit Carbon Solutions**  
2321 North Loop Drive, Suite 221  
Ames, Iowa 50010  
United States of America  
[www.summitcarbonsolutions.com](http://www.summitcarbonsolutions.com)




**SUMMIT CARBON**  
SOLUTIONS

PROJECT INFORMATION

Figure Title: <b>ND PSC - Aerial Map Book - NDL-328</b>	
Figure Number: <b>Map Book 1</b>	
Scale: <b>1 : 12,000</b> 1 inch equals 1,000 feet	Projection: <b>Transverse Mercator</b> NAD 1983 UTM Zone 14N
Sheet: <b>63</b> 63 of 139	Drawing Number: <b>1001-01-003</b> Revision A



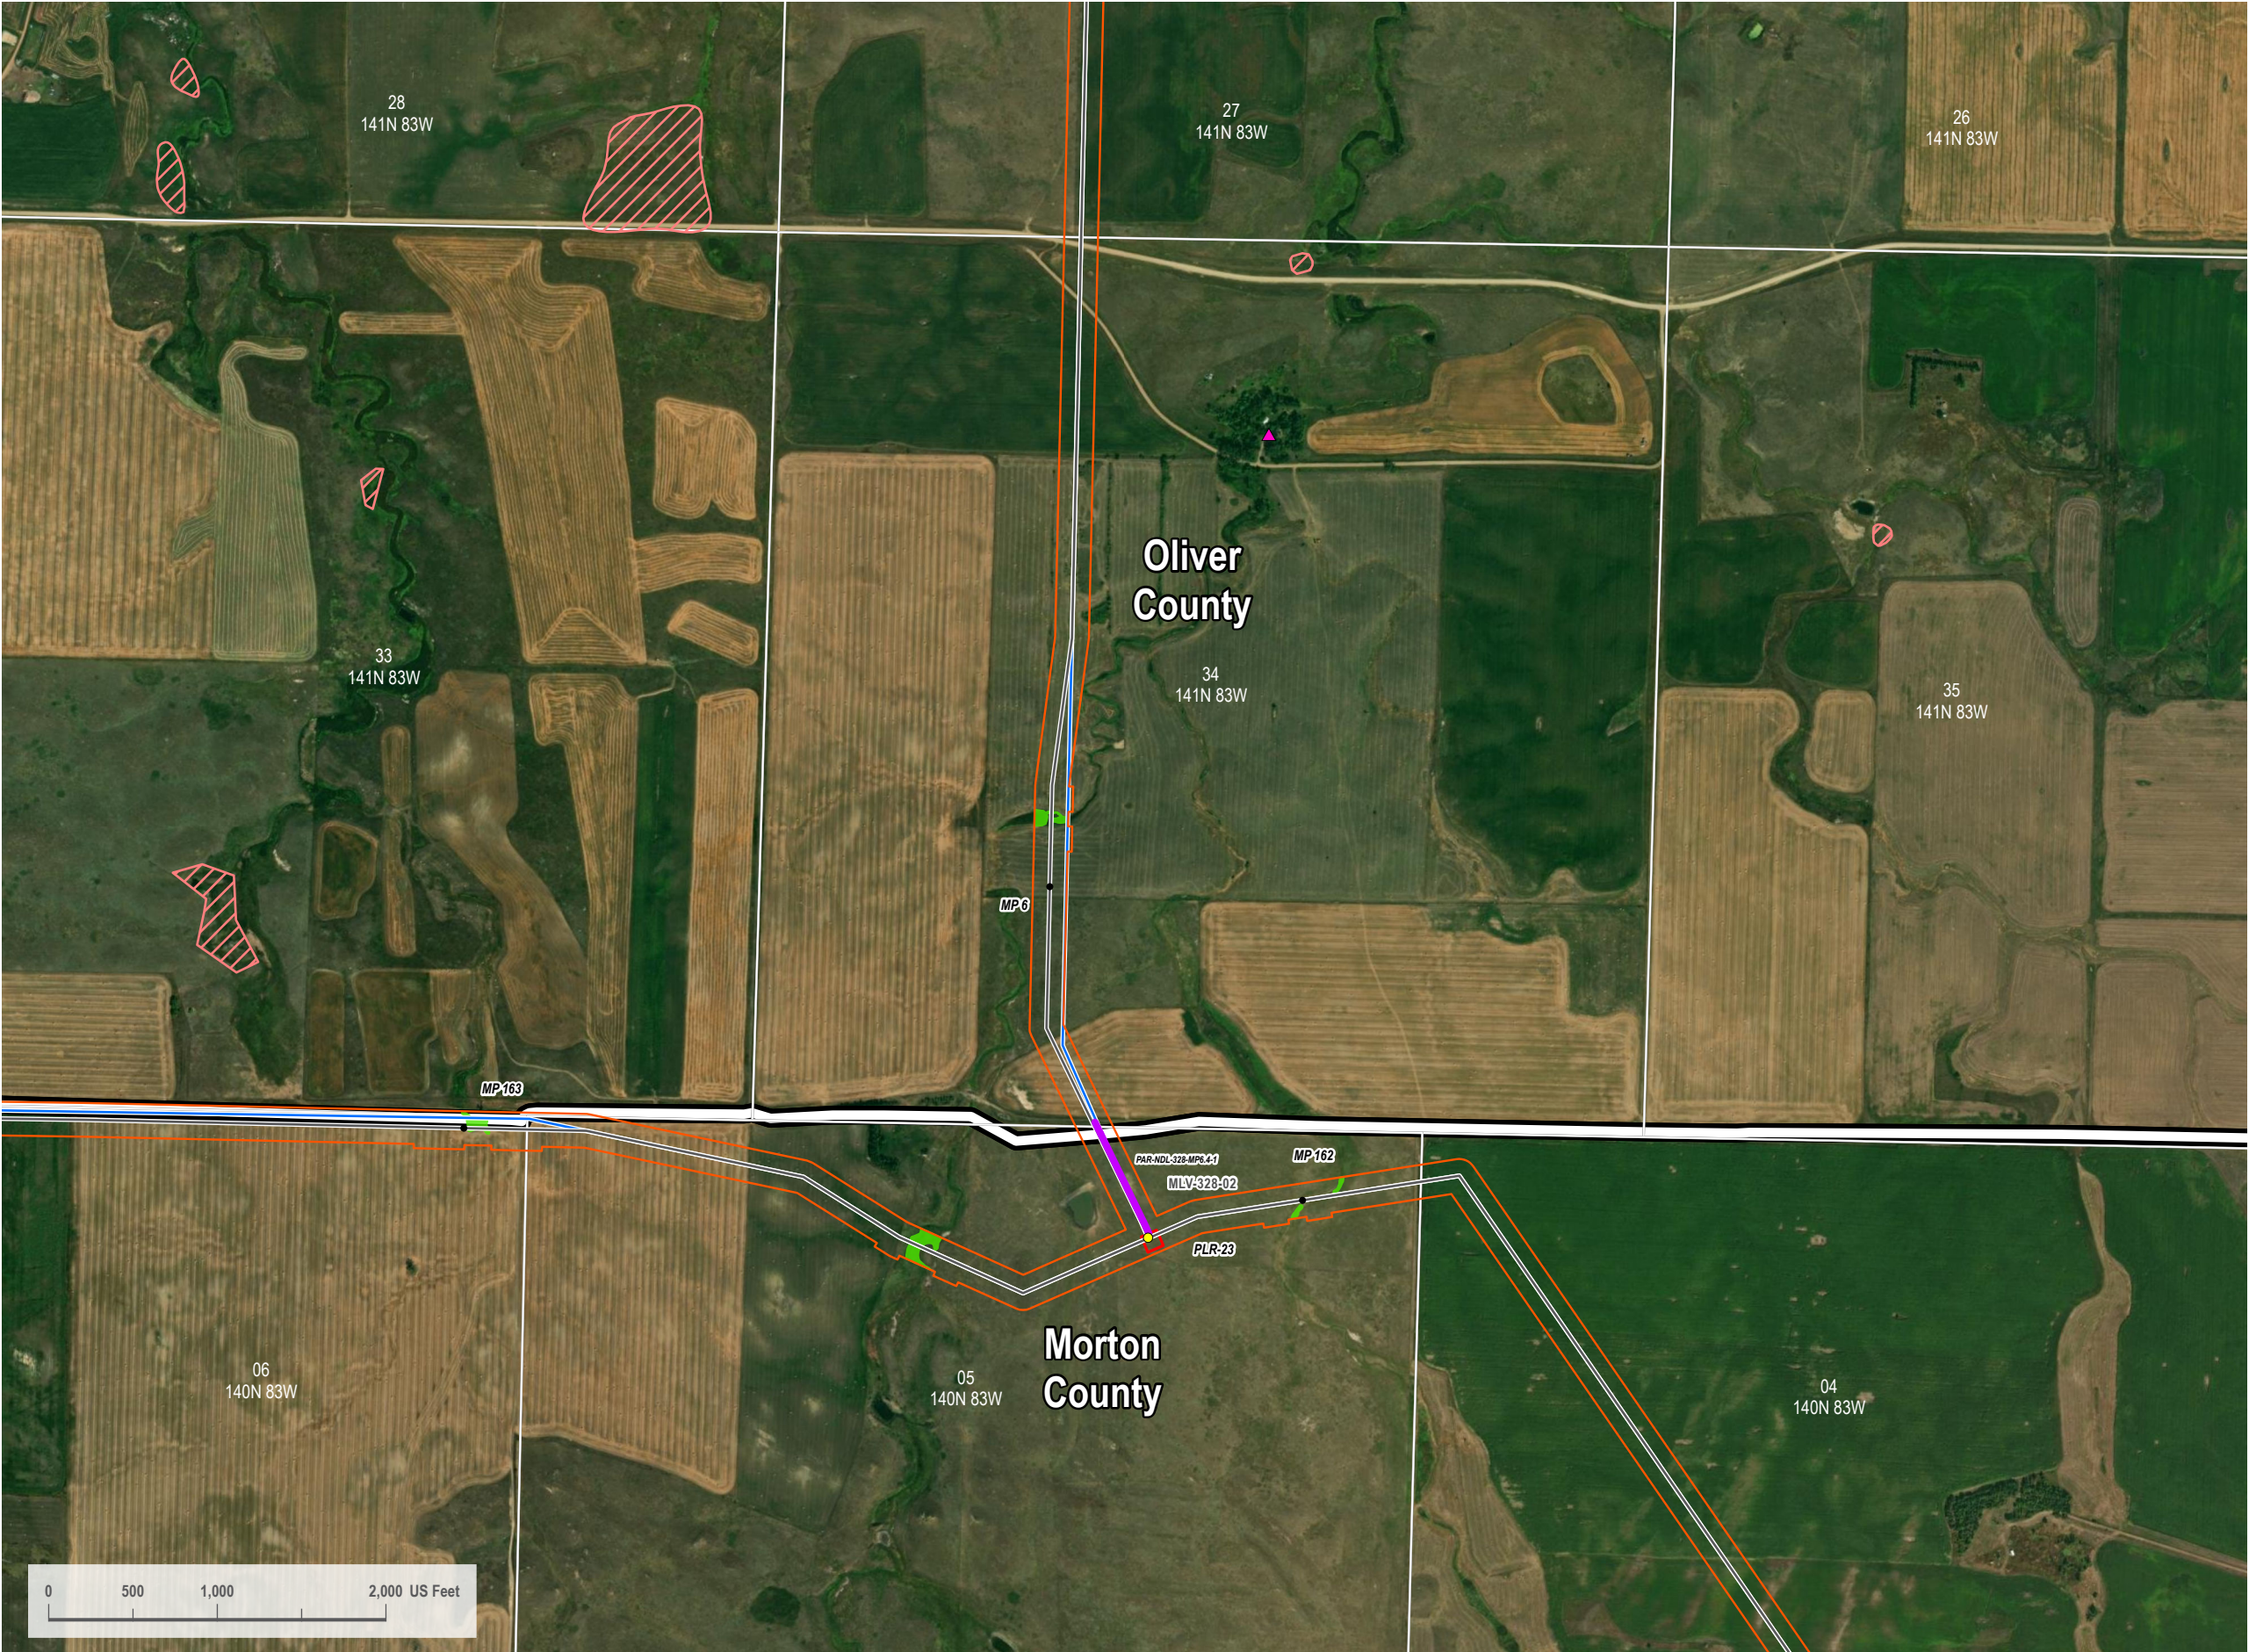

VICINITY MAP



LEGEND

- Centerline Mileposts
- Mainline Valve Location
- Domestic Structure or Business (Avoidance)
- Updated Proposed Project Route 08/15/2023
- October 17, 2023 Original PSC Application Route
- Section Line
- Access Road
- Landslide Deposit (Avoidance)
- Facility Boundary
- PEM Wetland
- 200-foot Siting Corridor



REVISIONS

Date:	2023-08-17	Revised by:	CW	Checked by:	RC
A - Issued for Review					
Date:		Revised by:		Checked by:	
Date:		Revised by:		Checked by:	

PREPARED BY

**Summit Carbon Solutions**  
2321 North Loop Drive, Suite 221  
Ames, Iowa 50010  
United States of America  
[www.summitcarbonsolutions.com](http://www.summitcarbonsolutions.com)

PROJECT INFORMATION

Figure Title: <b>ND PSC - Aerial Map Book - NDM-106, NDL-328</b>	
Figure Number: <b>Map Book 1</b>	
Scale: <b>1 : 12,000</b> 1 inch equals 1,000 feet	Projection: <b>Transverse Mercator</b> NAD 1983 UTM Zone 14N
Sheet: <b>64</b> 64 of 139	Drawing Number: <b>1001-01-003</b> Revision A





VICINITY MAP



LEGEND

- HDD Entry/Exit
- Centerline Mileposts
- Water Well (Avoidance)
- Mainline Valve Location
- Domestic Structure or Business (Avoidance)
- Updated Proposed Project Route 08/15/2023
- October 17, 2023 Original PSC Application Route
- Section Line
- Access Road
- Avoidance Area
- PEM Wetland
- Stream
- 200-foot Siting Corridor



REVISIONS

Date:	2023-08-17	Revised by:	CW	Checked by:	RC
A - Issued for Review					
Date:		Revised by:		Checked by:	
Date:		Revised by:		Checked by:	

PREPARED BY

**Summit Carbon Solutions**  
2321 North Loop Drive, Suite 221  
Ames, Iowa 50010  
United States of America  
[www.summitcarbonsolutions.com](http://www.summitcarbonsolutions.com)



**SUMMIT CARBON SOLUTIONS**

PROJECT INFORMATION

Figure Title: <b>ND PSC - Aerial Map Book - MNL-321</b>	
Figure Number: <b>Map Book 1</b>	
Scale: <b>1 : 12,000</b> 1 inch equals 1,000 feet	Projection: <b>Transverse Mercator</b> NAD 1983 UTM Zone 14N
Sheet: <b>65</b> 65 of 139	Drawing Number: <b>1001-01-003</b> Revision A






VICINITY MAP



LEGEND

- Centerline Mileposts
- Water Well (Avoidance)
- Domestic Structure or Business (Avoidance)
- Updated Proposed Project Route 08/15/2023
- October 17, 2023 Original PSC Application Route
- Section Line
- PEM Wetland
- 200-foot Siting Corridor

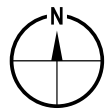

REVISIONS

Date:	2023-08-17	Revised by:	CW	Checked by:	RC
A - Issued for Review					
Date:		Revised by:		Checked by:	
Date:		Revised by:		Checked by:	

PREPARED BY

**Summit Carbon Solutions**  
2321 North Loop Drive, Suite 221  
Ames, Iowa 50010  
United States of America  
[www.summitcarbonsolutions.com](http://www.summitcarbonsolutions.com)



**SUMMIT CARBON**  
SOLUTIONS

PROJECT INFORMATION

Figure Title: <b>ND PSC - Aerial Map Book - MNL-321</b>	
Figure Number: <b>Map Book 1</b>	
Scale: <b>1 : 12,000</b> 1 inch equals 1,000 feet	Projection: <b>Transverse Mercator</b> NAD 1983 UTM Zone 14N
Sheet: <b>66</b> 66 of 139	Drawing Number: <b>1001-01-003</b> Revision A






VICINITY MAP



LEGEND

- Centerline Mileposts
- Water Well (Avoidance)
- Domestic Structure or Business (Avoidance)
- Updated Proposed Project Route 08/15/2023
- October 17, 2023 Original PSC Application Route
- Section Line
- PEM Wetland
- 200-foot Siting Corridor

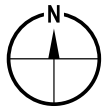

REVISIONS

Date: 2023-08-17	Revised by: CW	Checked by: RC
A - Issued for Review		
Date:	Revised by:	Checked by:
Date:	Revised by:	Checked by:

PREPARED BY

**Summit Carbon Solutions**  
 2321 North Loop Drive, Suite 221  
 Ames, Iowa 50010  
 United States of America  
[www.summitcarbonsolutions.com](http://www.summitcarbonsolutions.com)



**SUMMIT CARBON SOLUTIONS**

PROJECT INFORMATION

Figure Title: <b>ND PSC - Aerial Map Book - MNL-321 &amp; NDL-323</b>	
Figure Number: <b>Map Book 1</b>	
Scale: <b>1 : 12,000</b> 1 inch equals 1,000 feet	Projection: <b>Transverse Mercator</b> NAD 1983 UTM Zone 14N
Sheet: <b>67</b> 67 of 139	Drawing Number: <b>1001-01-003</b> Revision A






## VICINITY MAP



### LEGEND

- Centerline Mileposts
- Water Well (Avoidance)
- Domestic Structure or Business (Avoidance)
- Updated Proposed Project Route 08/15/2023
- October 17, 2023 Original PSC Application Route
- Section Line
- PEM Wetland
- 200-foot Siting Corridor

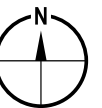

## REVISIONS

Date: 2023-08-17 Revised by: CW Checked by: RC  
A - Issued for Review

Date: Revised by: Checked by:

Date: Revised by: Checked by:

PREPARED BY

**Summit Carbon Solutions**  
2321 North Loop Drive, Suite 221  
Ames, Iowa 50010  
United States of America  
[www.summitcarbonsolutions.com](http://www.summitcarbonsolutions.com)



**SUMMIT CARBON**  
SOLUTIONS

## PROJECT INFORMATION

Figure Title:

ND PSC - Aerial Map Book - NDL-323

Figure Number: **Map Book 1**

**Scale:**  
**1 : 12,000**  
1 inch equals 1,000 feet

**Projection:**  
**Transverse Mercator**  
NAD 1983 UTM Zone 14N

Sheet: **68**  
68 of 139

Drawing Number: **1001-01-003**  
Revision A





VICINITY MAP



LEGEND

- HDD Entry/Exit
- Centerline Mileposts
- Water Well (Avoidance)
- Domestic Structure or Business (Avoidance)
- Updated Proposed Project Route 08/15/2023
- October 17, 2023 Original PSC Application Route
- Section Line
- Access Road
- Landslide Deposit (Avoidance)
- PEM Wetland
- Stream
- 200-foot Siting Corridor



REVISIONS

Date:	2023-08-17	Revised by:	CW	Checked by:	RC
A - Issued for Review					
Date:		Revised by:		Checked by:	
Date:		Revised by:		Checked by:	

PREPARED BY

**Summit Carbon Solutions**  
2321 North Loop Drive, Suite 221  
Ames, Iowa 50010  
United States of America  
[www.summitcarbonsolutions.com](http://www.summitcarbonsolutions.com)




**SUMMIT CARBON SOLUTIONS**

PROJECT INFORMATION

Figure Title: <b>ND PSC - Aerial Map Book - NDL-323</b>	
Figure Number: <b>Map Book 1</b>	
Scale: <b>1 : 12,000</b> 1 inch equals 1,000 feet	Projection: <b>Transverse Mercator</b> NAD 1983 UTM Zone 14N
Sheet: <b>69</b> 69 of 139	Drawing Number: <b>1001-01-003</b> Revision A



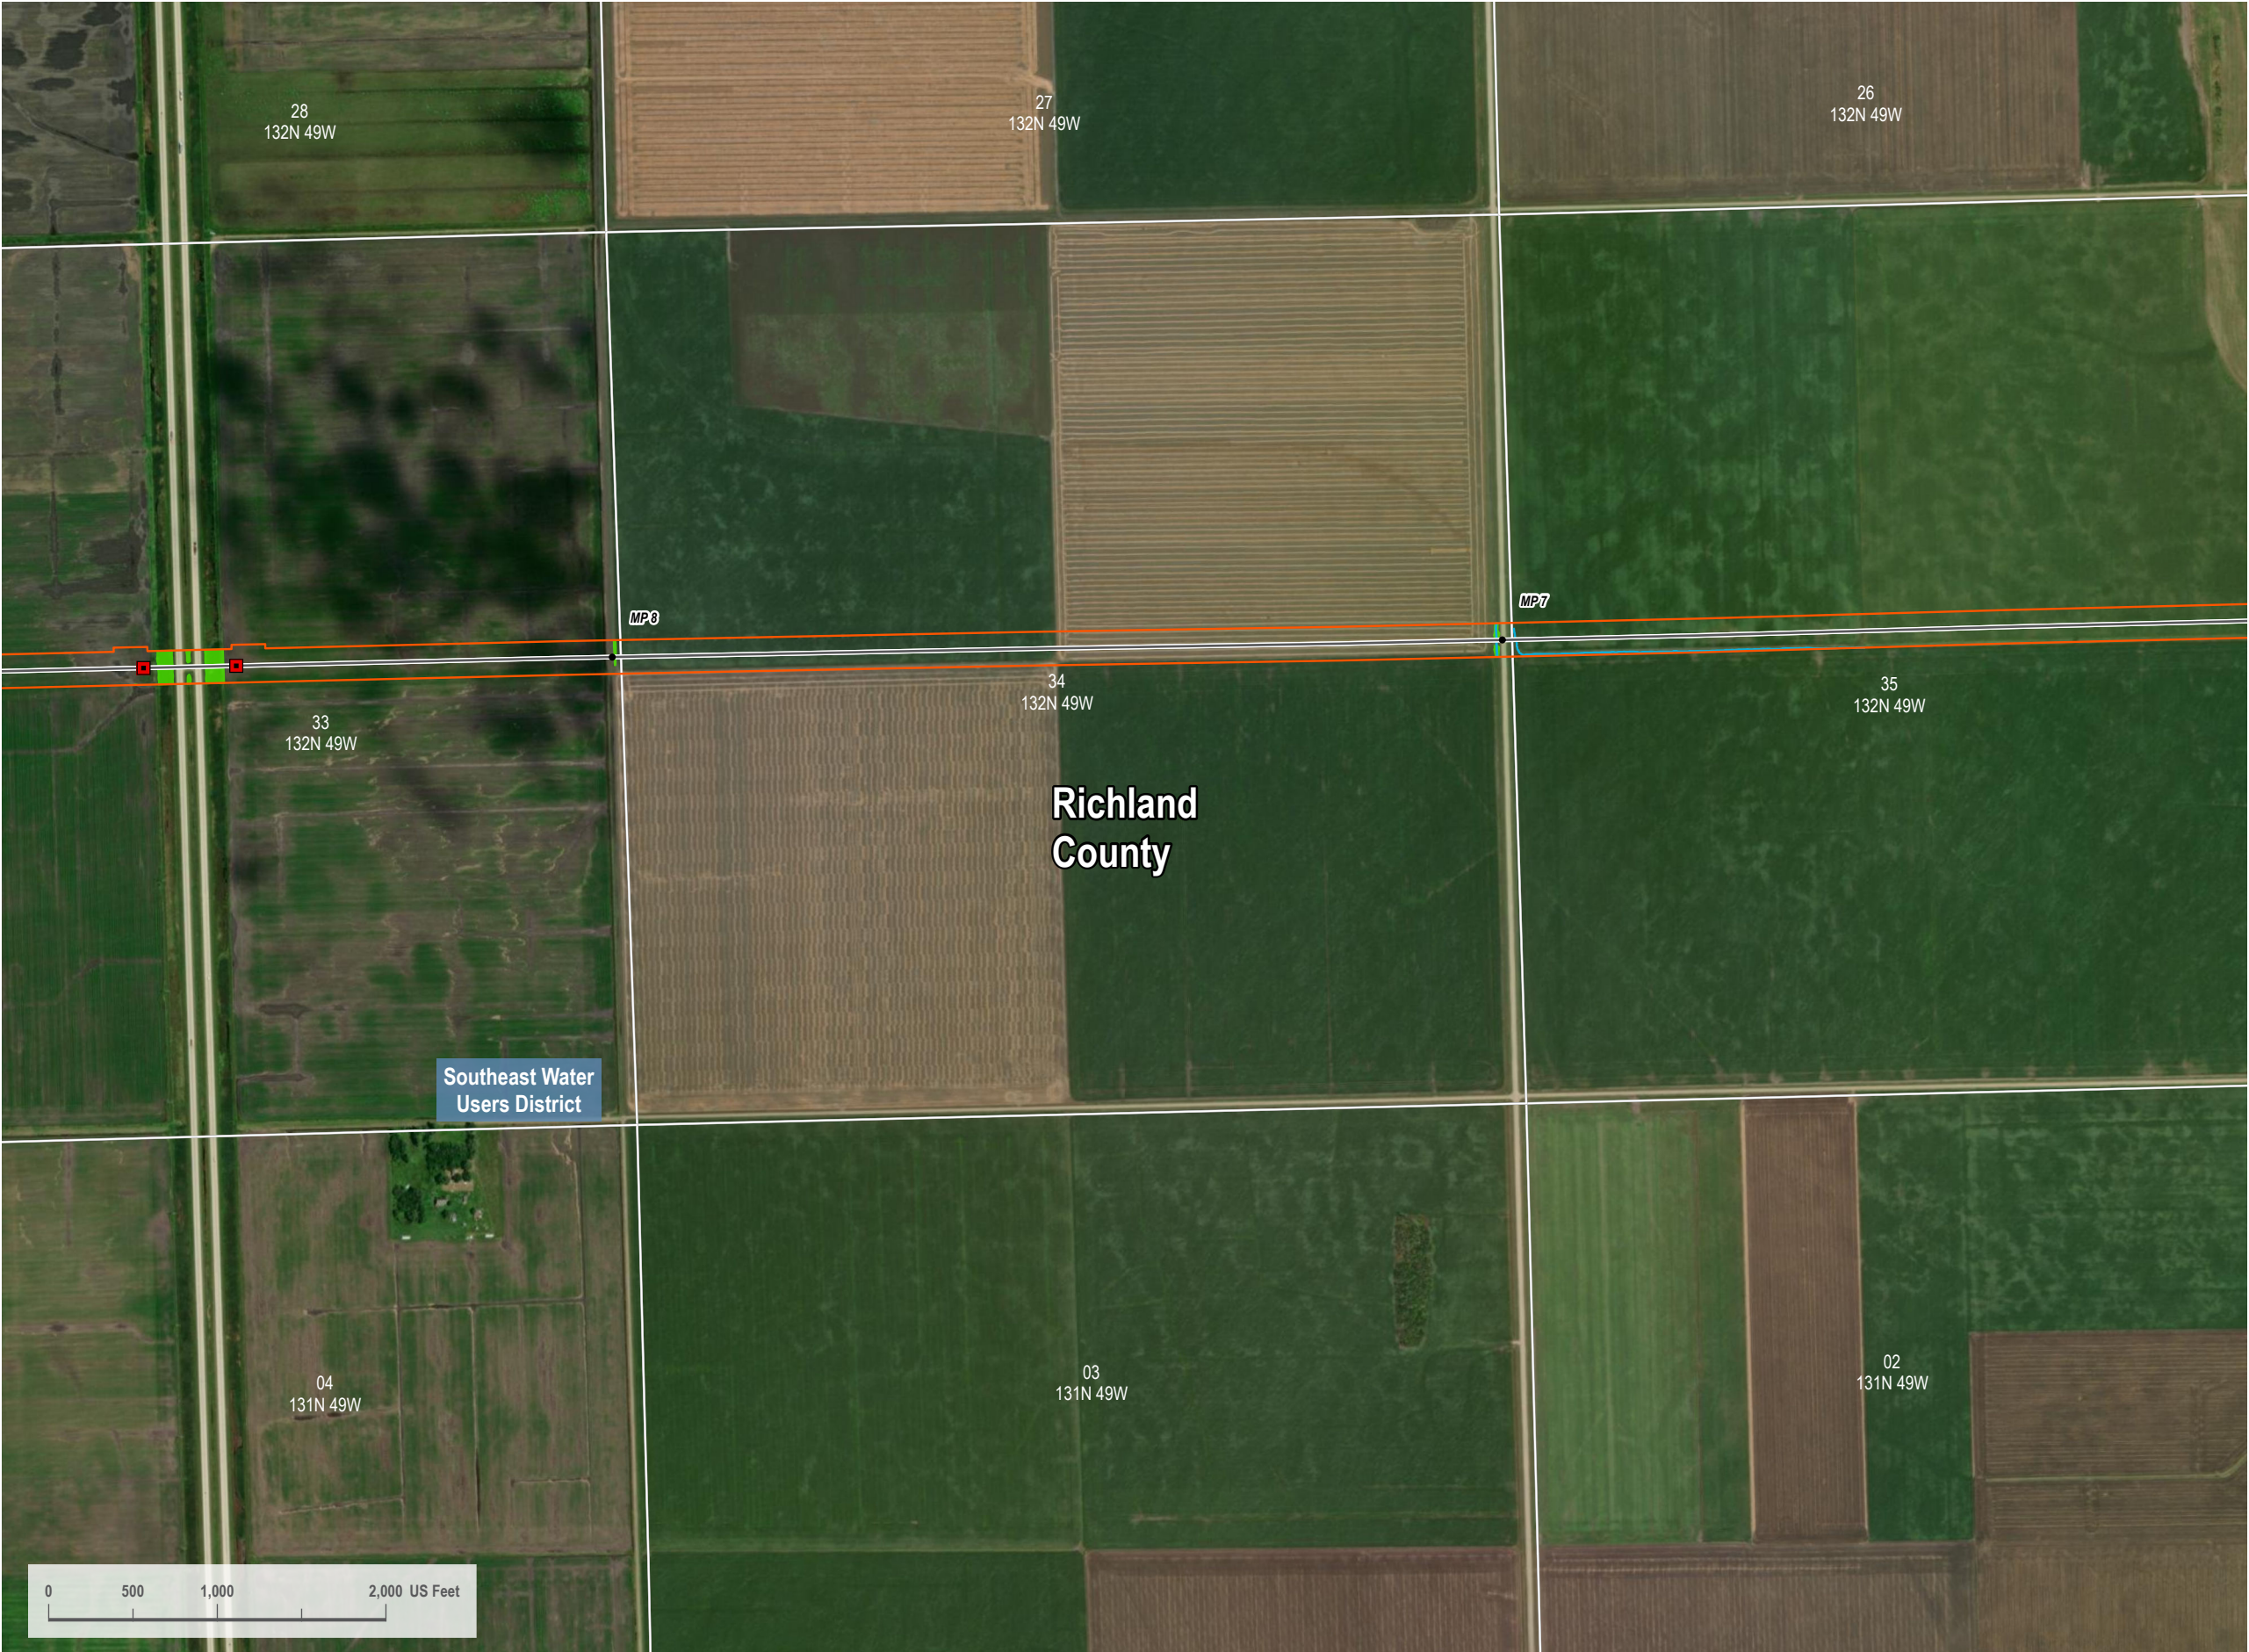

VICINITY MAP

LEGEND

HDD Entry/Exit	PEM Wetland
Centerline Mileposts	Stream
Updated Proposed Project Route 08/15/2023	200-foot Siting Corridor
October 17, 2023 Original PSC Application Route	
Section Line	

REVISIONS

Date:	2023-08-17	Revised by:	CW	Checked by:	RC
A - Issued for Review					
Date:		Revised by:		Checked by:	
Date:		Revised by:		Checked by:	

PREPARED BY

Summit Carbon Solutions

2321 North Loop Drive, Suite 221  
Ames, Iowa 50010  
United States of America

[www.summitcarbonsolutions.com](http://www.summitcarbonsolutions.com)

PROJECT INFORMATION

Figure Title:


ND PSC - Aerial Map Book - NDL-323

Figure Number:

Map Book 1

Scale:	Projection:
1 : 12,000	Transverse Mercator
1 inch equals 1,000 feet	NAD 1983 UTM Zone 14N
Sheet:	Drawing Number:
70	1001-01-003
70 of 139	Revision A



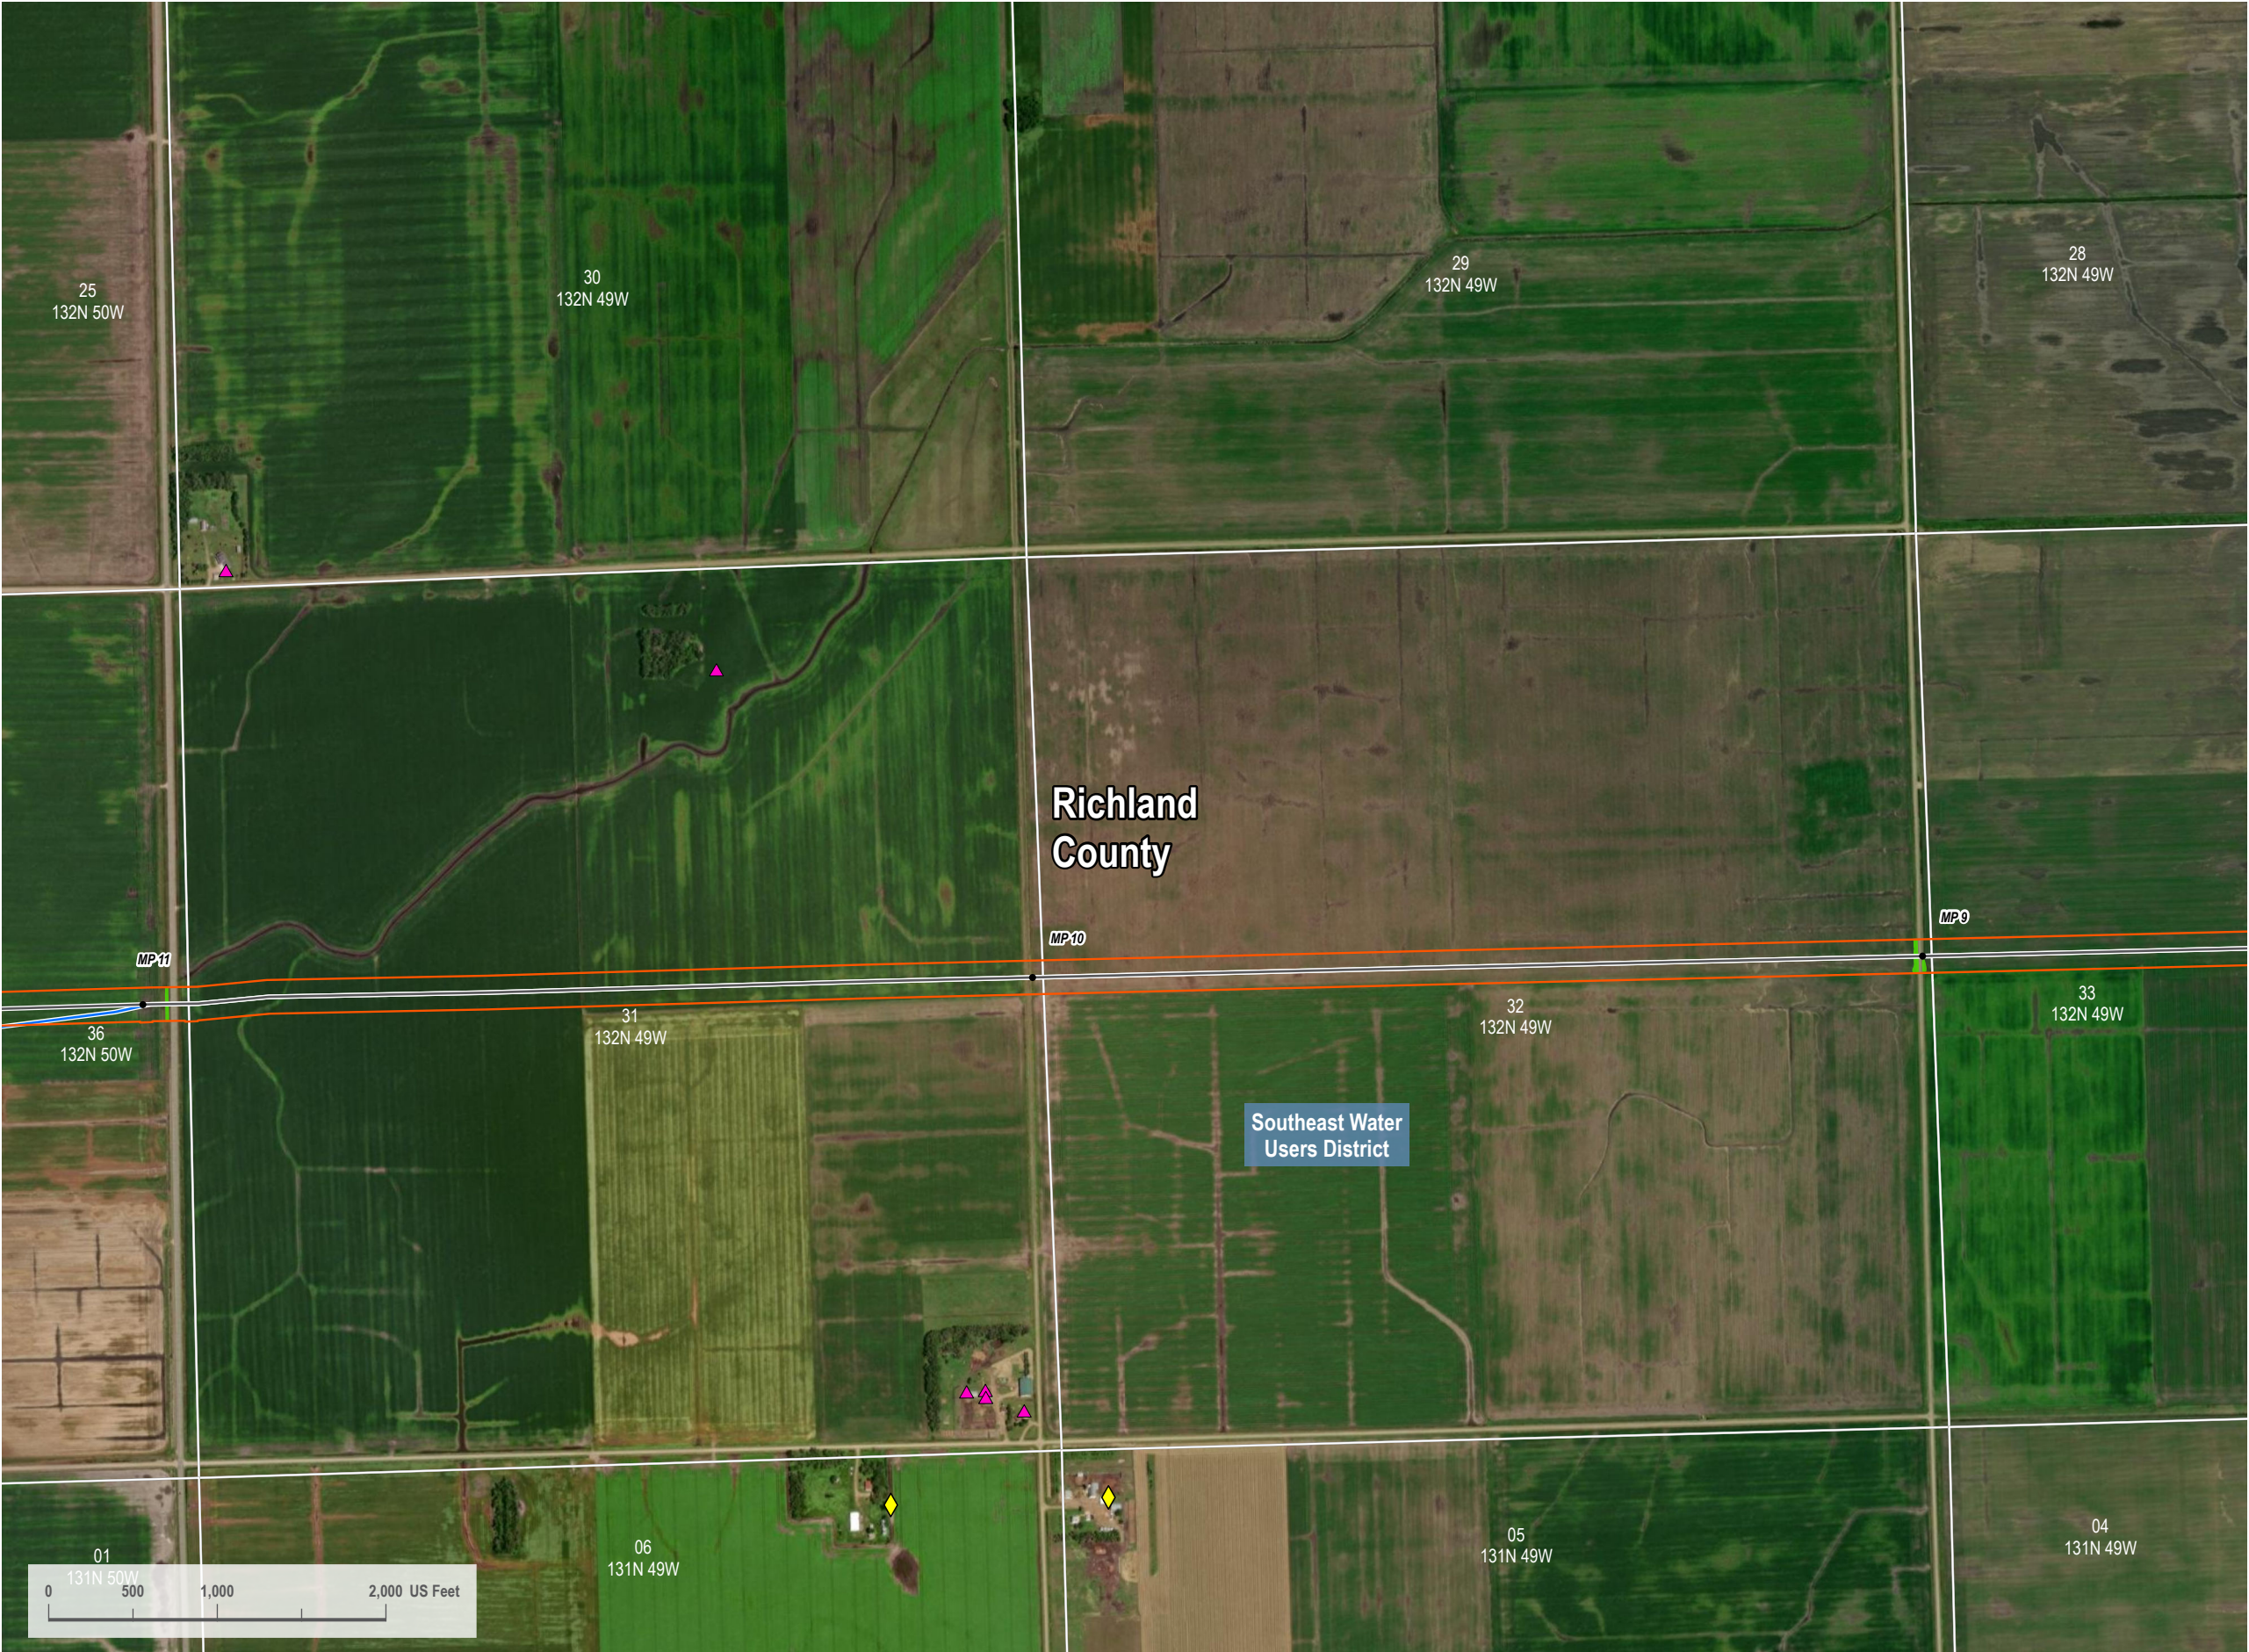

VICINITY MAP



LEGEND

- Centerline Mileposts
- Water Well (Avoidance)
- Domestic Structure or Business (Avoidance)
- Updated Proposed Project Route 08/15/2023
- October 17, 2023 Original PSC Application Route
- Section Line
- PEM Wetland
- 200-foot Siting Corridor



REVISIONS

Date: 2023-08-17 Revised by: CW Checked by: RC  
**A - Issued for Review**

Date: Revised by: Checked by:

Date: Revised by: Checked by:

PREPARED BY

**Summit Carbon Solutions**  
2321 North Loop Drive, Suite 221  
Ames, Iowa 50010  
United States of America  
[www.summitcarbonsolutions.com](http://www.summitcarbonsolutions.com)



PROJECT INFORMATION

Figure Title:

**ND PSC - Aerial Map Book - NDL-323**

Figure Number:

**Map Book 1**


Scale:  
**1 : 12,000**  
1 inch equals 1,000 feet

Projection:  
**Transverse Mercator**  
NAD 1983 UTM Zone 14N

Sheet:  
**71**  
71 of 139

Drawing Number:  
**1001-01-003**  
Revision A



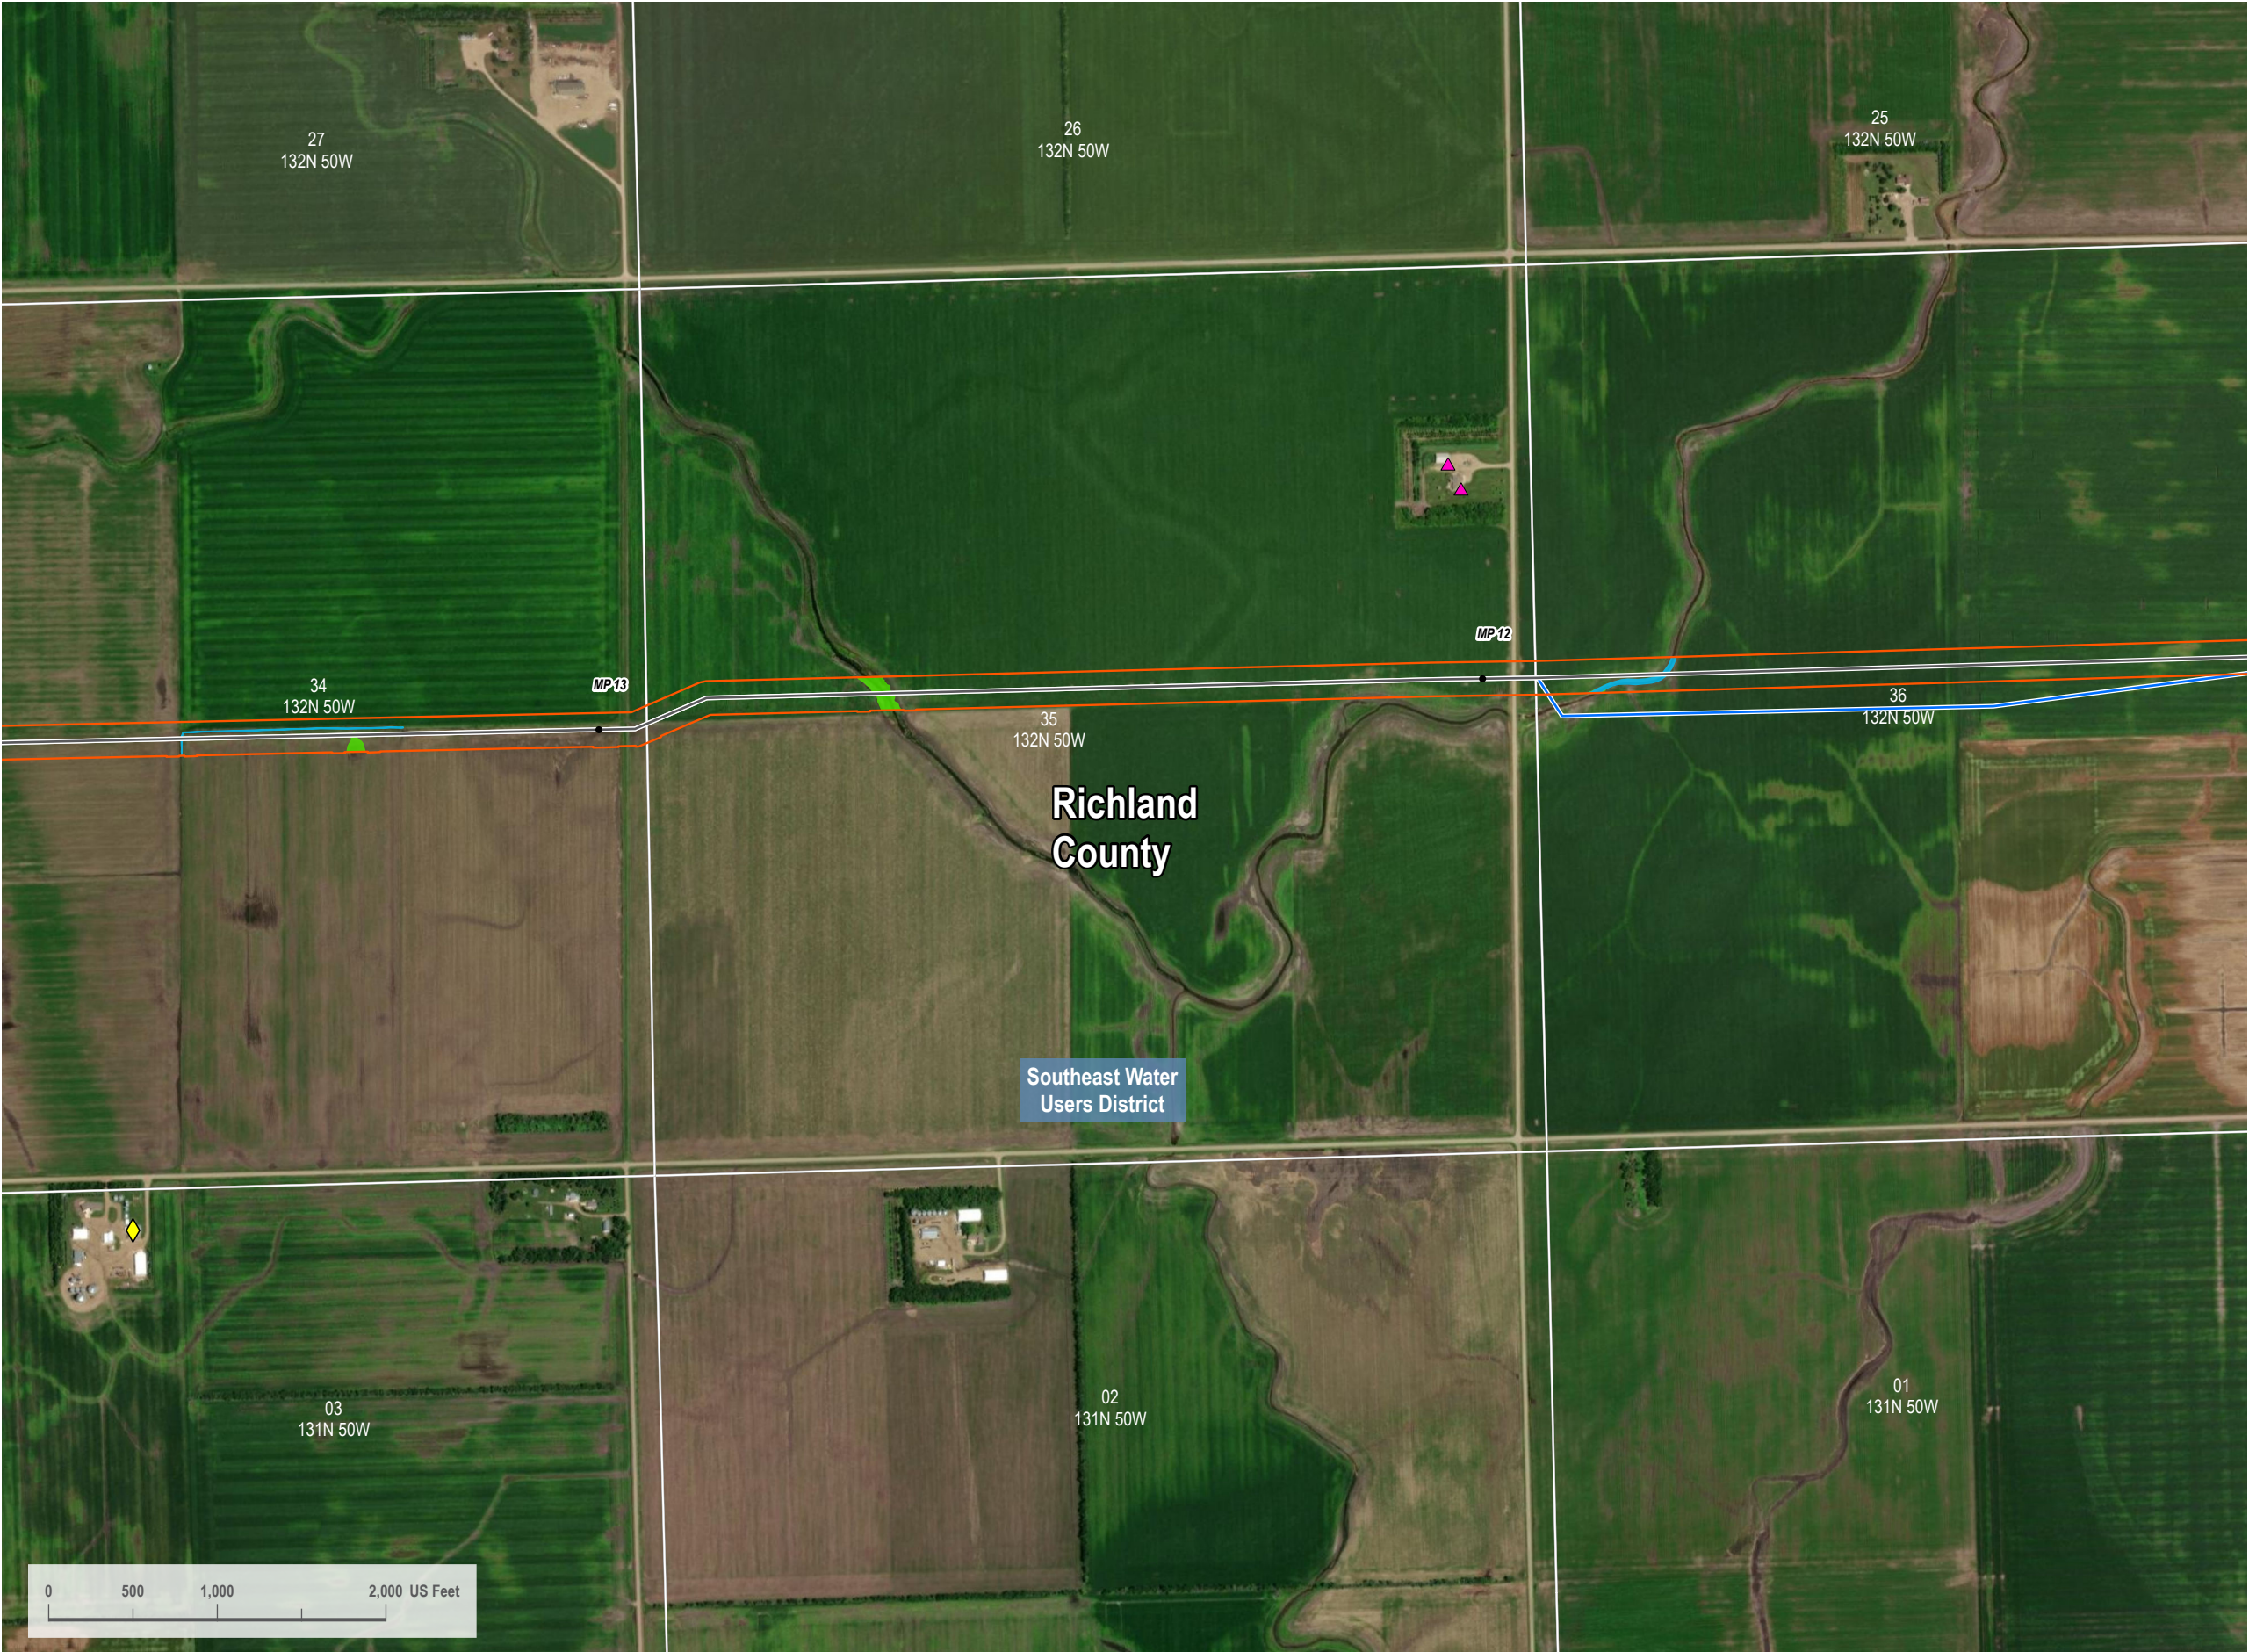


VICINITY MAP



LEGEND

- Centerline Mileposts
- Water Well (Avoidance)
- Domestic Structure or Business (Avoidance)
- Updated Proposed Project Route 08/15/2023
- October 17, 2023 Original PSC Application Route
- Section Line
- PEM Wetland
- Stream
- 200-foot Siting Corridor

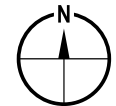

REVISIONS

Date:	2023-08-17	Revised by:	CW	Checked by:	RC
A - Issued for Review					
Date:		Revised by:		Checked by:	
Date:		Revised by:		Checked by:	

PREPARED BY

**Summit Carbon Solutions**  
2321 North Loop Drive, Suite 221  
Ames, Iowa 50010  
United States of America  
[www.summitcarbonsolutions.com](http://www.summitcarbonsolutions.com)




**SUMMIT CARBON**  
SOLUTIONS

PROJECT INFORMATION

Figure Title: <b>ND PSC - Aerial Map Book - NDL-323</b>	
Figure Number: <b>Map Book 1</b>	
Scale: <b>1 : 12,000</b> 1 inch equals 1,000 feet	Projection: <b>Transverse Mercator</b> NAD 1983 UTM Zone 14N
Sheet: <b>72</b> 72 of 139	Drawing Number: <b>1001-01-003</b> Revision A



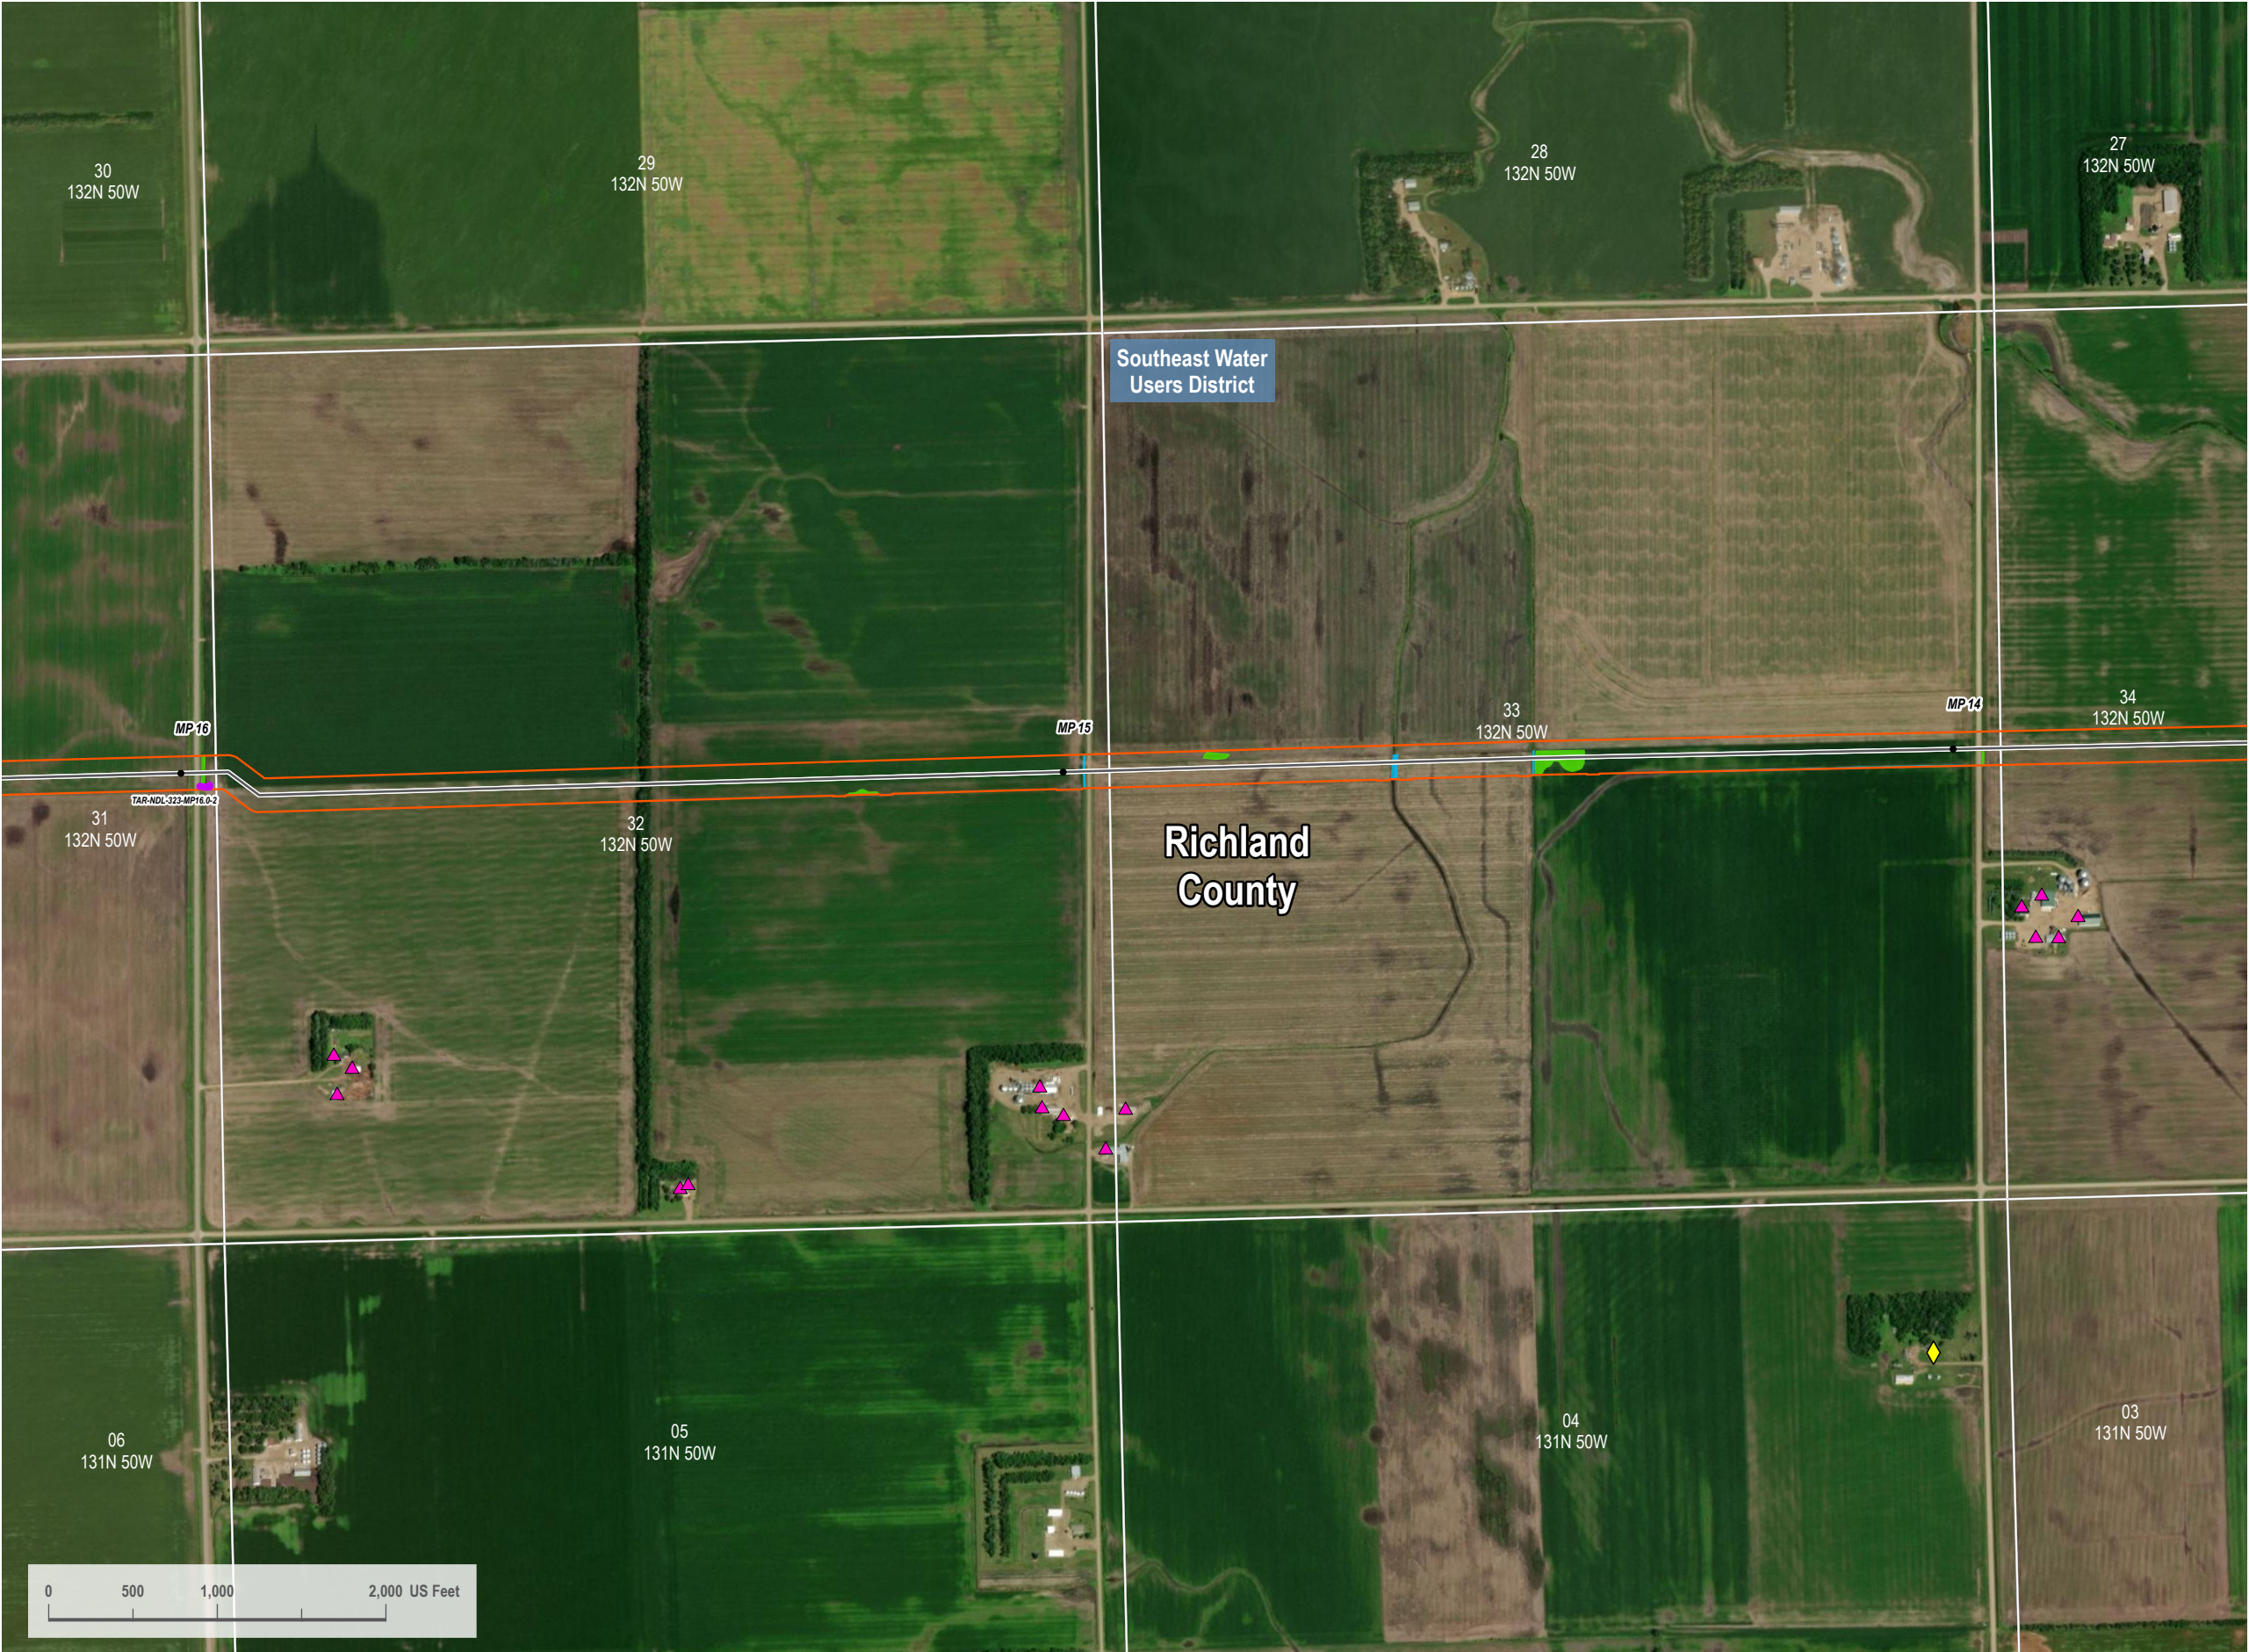

VICINITY MAP



LEGEND

- Centerline Mileposts
- Water Well (Avoidance)
- Domestic Structure or Business (Avoidance)
- Updated Proposed Project Route 08/15/2023
- October 17, 2023 Original PSC Application Route
- Section Line
- Access Road
- PEM Wetland
- Stream
- 200-foot Siting Corridor



REVISIONS

Date: 2023-08-17 Revised by: CW Checked by: RC  
A - Issued for Review

Date: Revised by: Checked by:

Date: Revised by: Checked by:

PREPARED BY

**Summit Carbon Solutions**  
2321 North Loop Drive, Suite 221  
Ames, Iowa 50010  
United States of America  
[www.summitcarbonsolutions.com](http://www.summitcarbonsolutions.com)



PROJECT INFORMATION

Figure Title:  
ND PSC - Aerial Map Book - NDL-323

Figure Number:  
Map Book 1

Scale:  
1 : 12,000  
1 inch equals 1,000 feet

Projection:  
Transverse Mercator  
NAD 1983 UTM Zone 14N

Sheet:  
73  
73 of 139

Drawing Number:  
1001-01-003  
Revision A






VICINITY MAP



LEGEND

- HDD Entry/Exit
- Centerline Mileposts
- Mainline Valve Location
- ▲ Domestic Structure or Business (Avoidance)
- Updated Proposed Project Route 08/15/2023
- October 17, 2023 Original PSC Application Route
- Section Line
- Access Road
- PEM Wetland
- 200-foot Siting Corridor

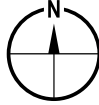

REVISIONS

Date:	2023-08-17	Revised by:	CW	Checked by:	RC
A - Issued for Review					
Date:		Revised by:		Checked by:	
Date:		Revised by:		Checked by:	

PREPARED BY

**Summit Carbon Solutions**  
2321 North Loop Drive, Suite 221  
Ames, Iowa 50010  
United States of America  
[www.summitcarbonsolutions.com](http://www.summitcarbonsolutions.com)



**SUMMIT CARBON**  
SOLUTIONS

PROJECT INFORMATION

Figure Title: <b>ND PSC - Aerial Map Book - NDL-323, NDT-211, NDL-324</b>	
Figure Number: <b>Map Book 1</b>	
Scale: <b>1 : 12,000</b> 1 inch equals 1,000 feet	Projection: <b>Transverse Mercator</b> NAD 1983 UTM Zone 14N
Sheet: <b>74</b> 74 of 139	Drawing Number: <b>1001-01-003</b> Revision A






VICINITY MAP



LEGEND

- HDD Entry/Exit
- Centerline Mileposts
- Mainline Valve Location
- Domestic Structure or Business (Avoidance)
- Updated Proposed Project Route 08/15/2023
- October 17, 2023 Original PSC Application Route
- Section Line
- Access Road
- PEM Wetland
- 200-foot Siting Corridor

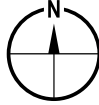

REVISIONS

Date:	2023-08-17	Revised by:	CW	Checked by:	RC
A - Issued for Review					
Date:		Revised by:		Checked by:	
Date:		Revised by:		Checked by:	

PREPARED BY

**Summit Carbon Solutions**  
2321 North Loop Drive, Suite 221  
Ames, Iowa 50010  
United States of America  
[www.summitcarbonsolutions.com](http://www.summitcarbonsolutions.com)



**SUMMIT CARBON**  
SOLUTIONS

PROJECT INFORMATION

Figure Title: <b>ND PSC - Aerial Map Book - NDL-323, NDT-211, NDL-324</b>	
Figure Number: <b>Map Book 1</b>	
Scale: <b>1 : 12,000</b> 1 inch equals 1,000 feet	Projection: <b>Transverse Mercator</b> NAD 1983 UTM Zone 14N
Sheet: <b>75</b> 75 of 139	Drawing Number: <b>1001-01-003</b> Revision A





VICINITY MAP



LEGEND

- HDD Entry/Exit
- Centerline Mileposts
- Water Well (Avoidance)
- Domestic Structure or Business (Avoidance)
- Updated Proposed Project Route 08/15/2023
- October 17, 2023 Original PSC Application Route
- Section Line
- Access Road
- Landside Deposit (Avoidance)
- Avoidance Area
- PEM Wetland
- Stream
- 200-foot Siting Corridor



REVISIONS

Date:	2023-08-17	Revised by:	CW	Checked by:	RC
A - Issued for Review					
Date:		Revised by:		Checked by:	
Date:		Revised by:		Checked by:	

PREPARED BY

**Summit Carbon Solutions**  
2321 North Loop Drive, Suite 221  
Ames, Iowa 50010  
United States of America  
[www.summitcarbonsolutions.com](http://www.summitcarbonsolutions.com)



**SUMMIT CARBON**  
SOLUTIONS

PROJECT INFORMATION

Figure Title: <b>ND PSC - Aerial Map Book - NDT-211</b>	
Figure Number: <b>Map Book 1</b>	
Scale: <b>1 : 12,000</b> 1 inch equals 1,000 feet	Projection: <b>Transverse Mercator</b> NAD 1983 UTM Zone 14N
Sheet: <b>76</b> 76 of 139	Drawing Number: <b>1001-01-003</b> Revision A





VICINITY MAP



LEGEND

- Centerline Mileposts
- Water Well (Avoidance)
- Domestic Structure or Business (Avoidance)
- Updated Proposed Project Route 08/15/2023
- October 17, 2023 Original PSC Application Route
- Section Line
- Landslide Deposit (Avoidance)
- PEM Wetland
- 200-foot Stiling Corridor



REVISIONS

Date: 2023-08-17 Revised by: CW Checked by: RC  
A - Issued for Review

Date: Revised by: Checked by:

Date: Revised by: Checked by:

PREPARED BY

**Summit Carbon Solutions**  
2321 North Loop Drive, Suite 221  
Ames, Iowa 50010  
United States of America  
[www.summitcarbonsolutions.com](http://www.summitcarbonsolutions.com)



**SUMMIT CARBON SOLUTIONS**

PROJECT INFORMATION

Figure Title:

ND PSC - Aerial Map Book - NDT-211

Figure Number:

Map Book 1


Scale:  
1 : 12,000  
1 inch equals 1,000 feet

Projection:  
Transverse Mercator  
NAD 1983 UTM Zone 14N

Sheet:  
77  
77 of 139

Drawing Number:  
1001-01-003  
Revision A



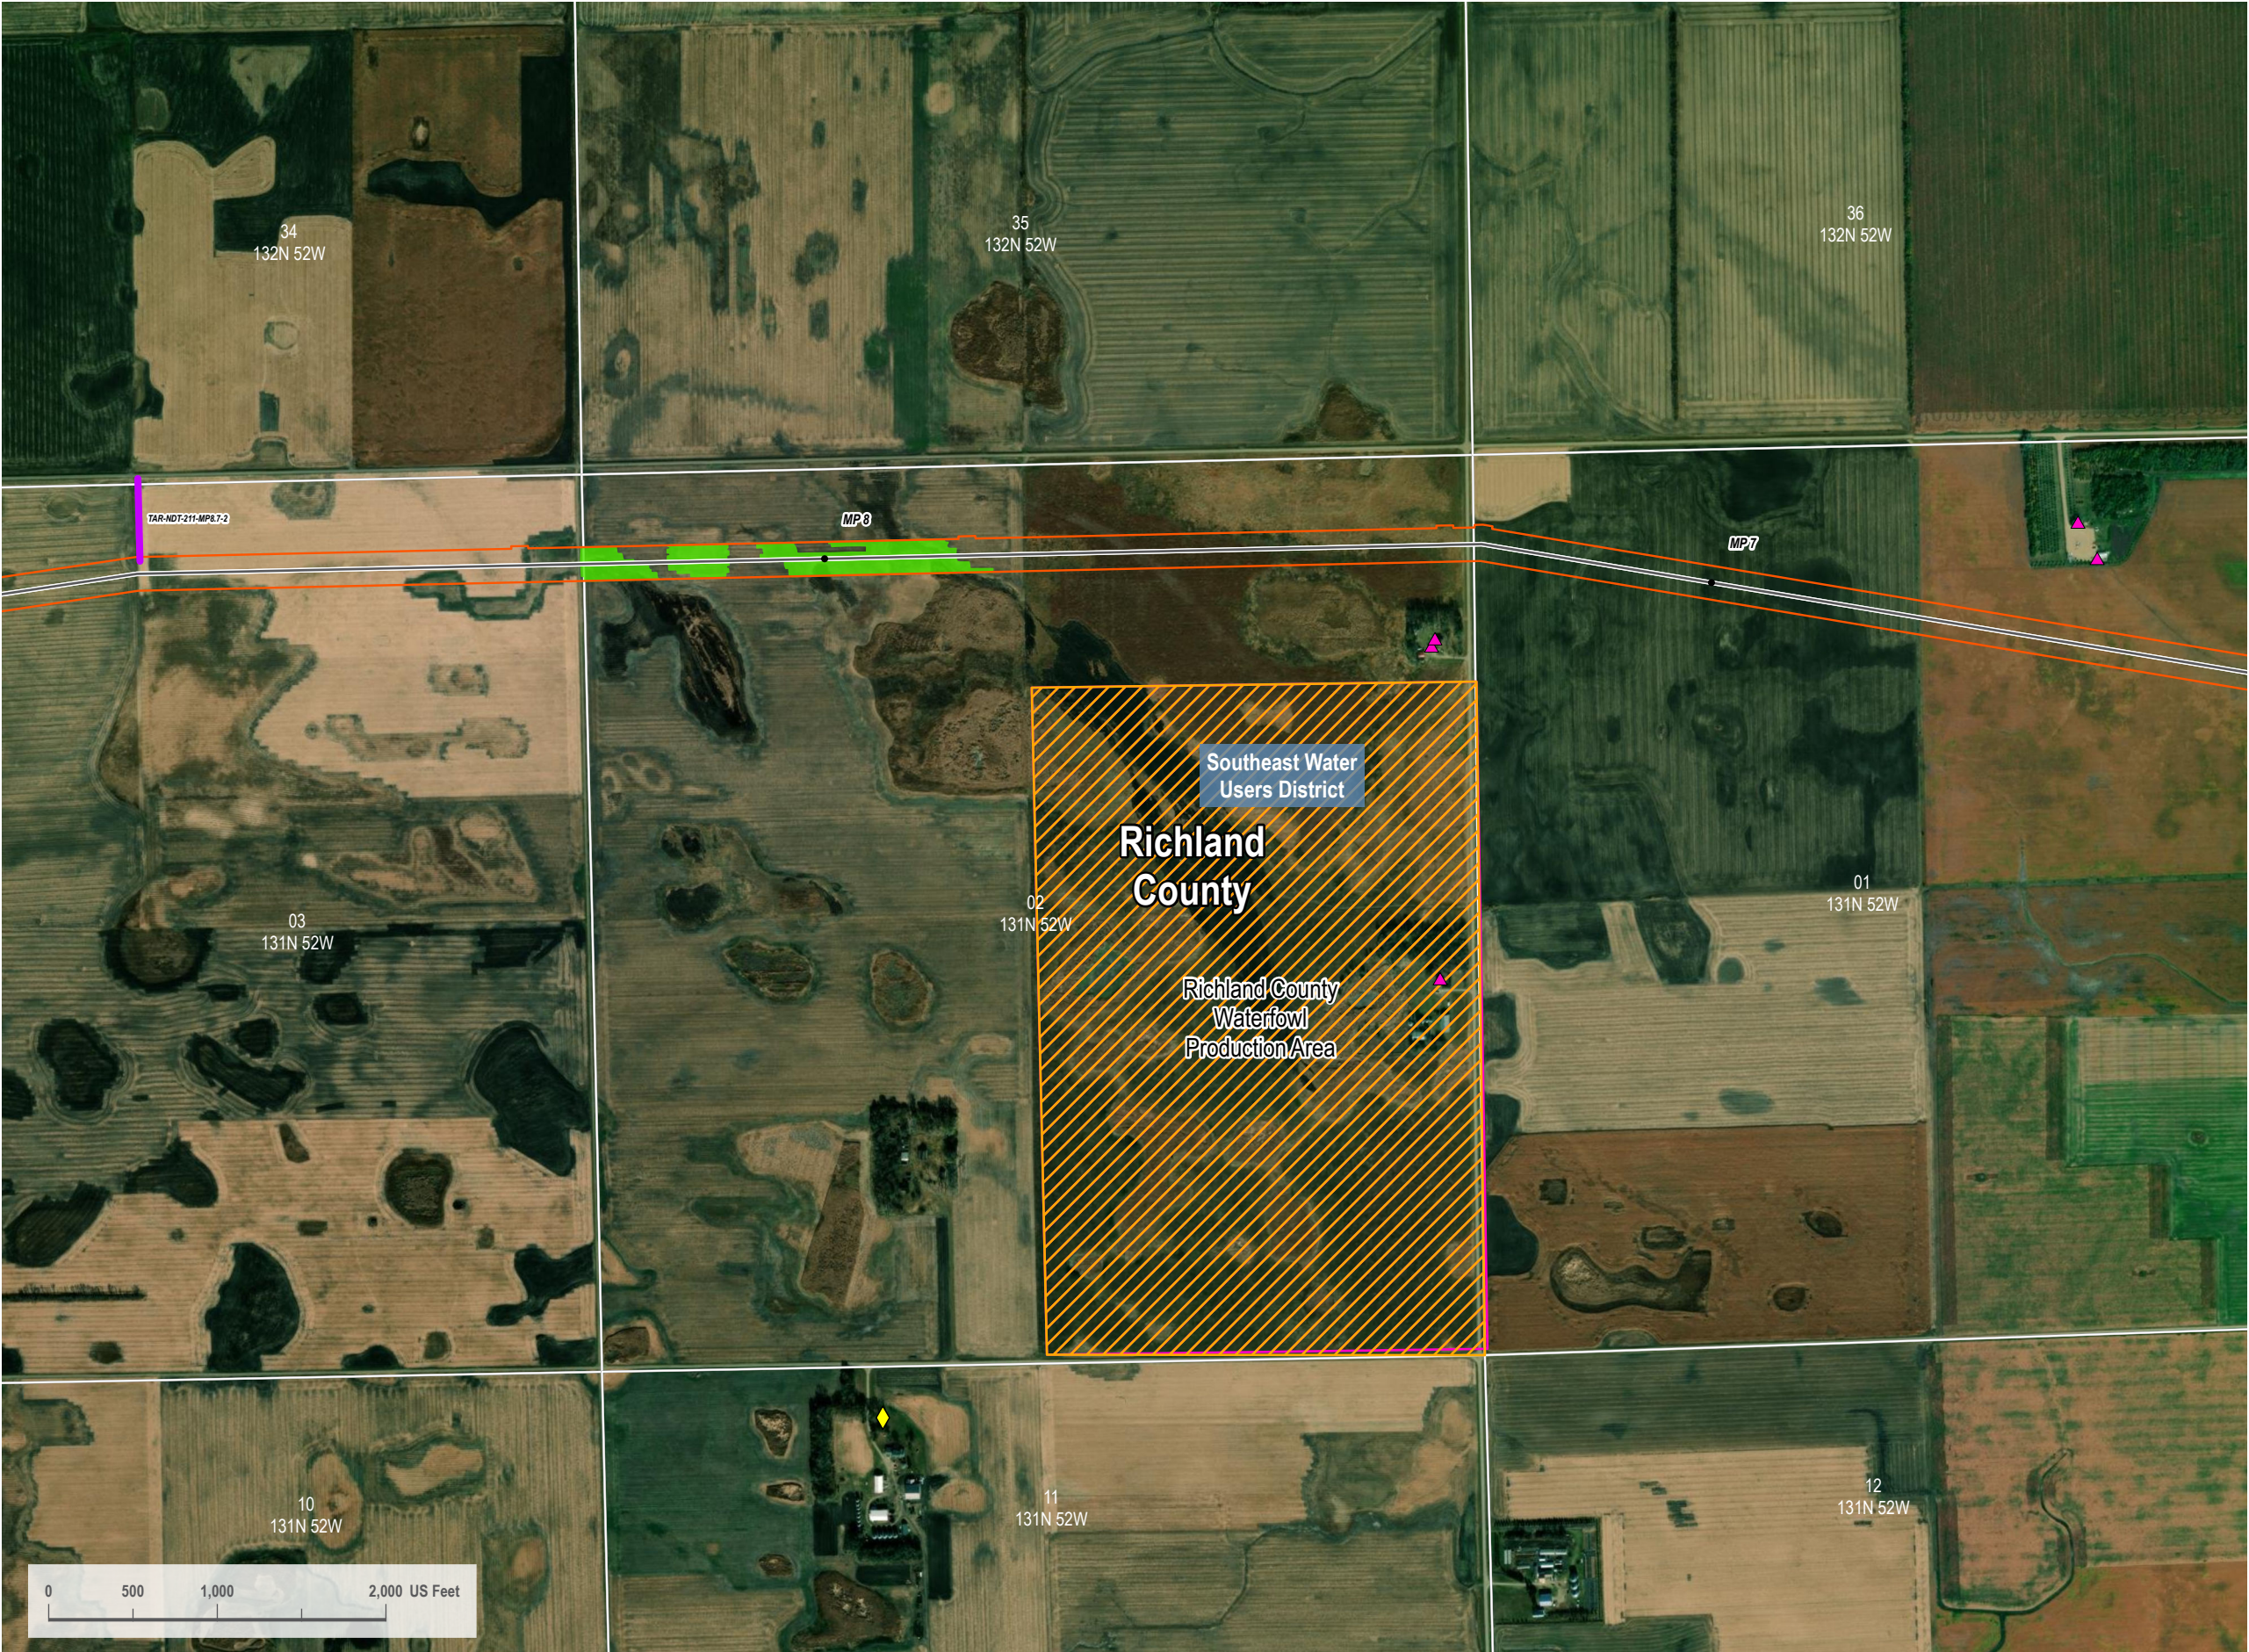

VICINITY MAP



LEGEND

- Centerline Mileposts
- Water Well (Avoidance)
- Domestic Structure or Business (Avoidance)
- Updated Proposed Project Route 08/15/2023
- October 17, 2023 Original PSC Application Route
- Section Line
- Access Road
- Avoidance Area
- PEM Wetland
- 200-foot Siting Corridor
- Conservation Easement



REVISIONS

Date:	2023-08-17	Revised by:	CW	Checked by:	RC
A - Issued for Review					
Date:		Revised by:		Checked by:	
Date:		Revised by:		Checked by:	

PREPARED BY

**Summit Carbon Solutions**  
2321 North Loop Drive, Suite 221  
Ames, Iowa 50010  
United States of America  
[www.summitcarbonsolutions.com](http://www.summitcarbonsolutions.com)




**SUMMIT CARBON**  
SOLUTIONS

PROJECT INFORMATION

Figure Title: <b>ND PSC - Aerial Map Book - NDT-211</b>	
Figure Number: <b>Map Book 1</b>	
Scale: <b>1 : 12,000</b> 1 inch equals 1,000 feet	Projection: <b>Transverse Mercator</b> NAD 1983 UTM Zone 14N
Sheet: <b>78</b> 78 of 139	Drawing Number: <b>1001-01-003</b> Revision A



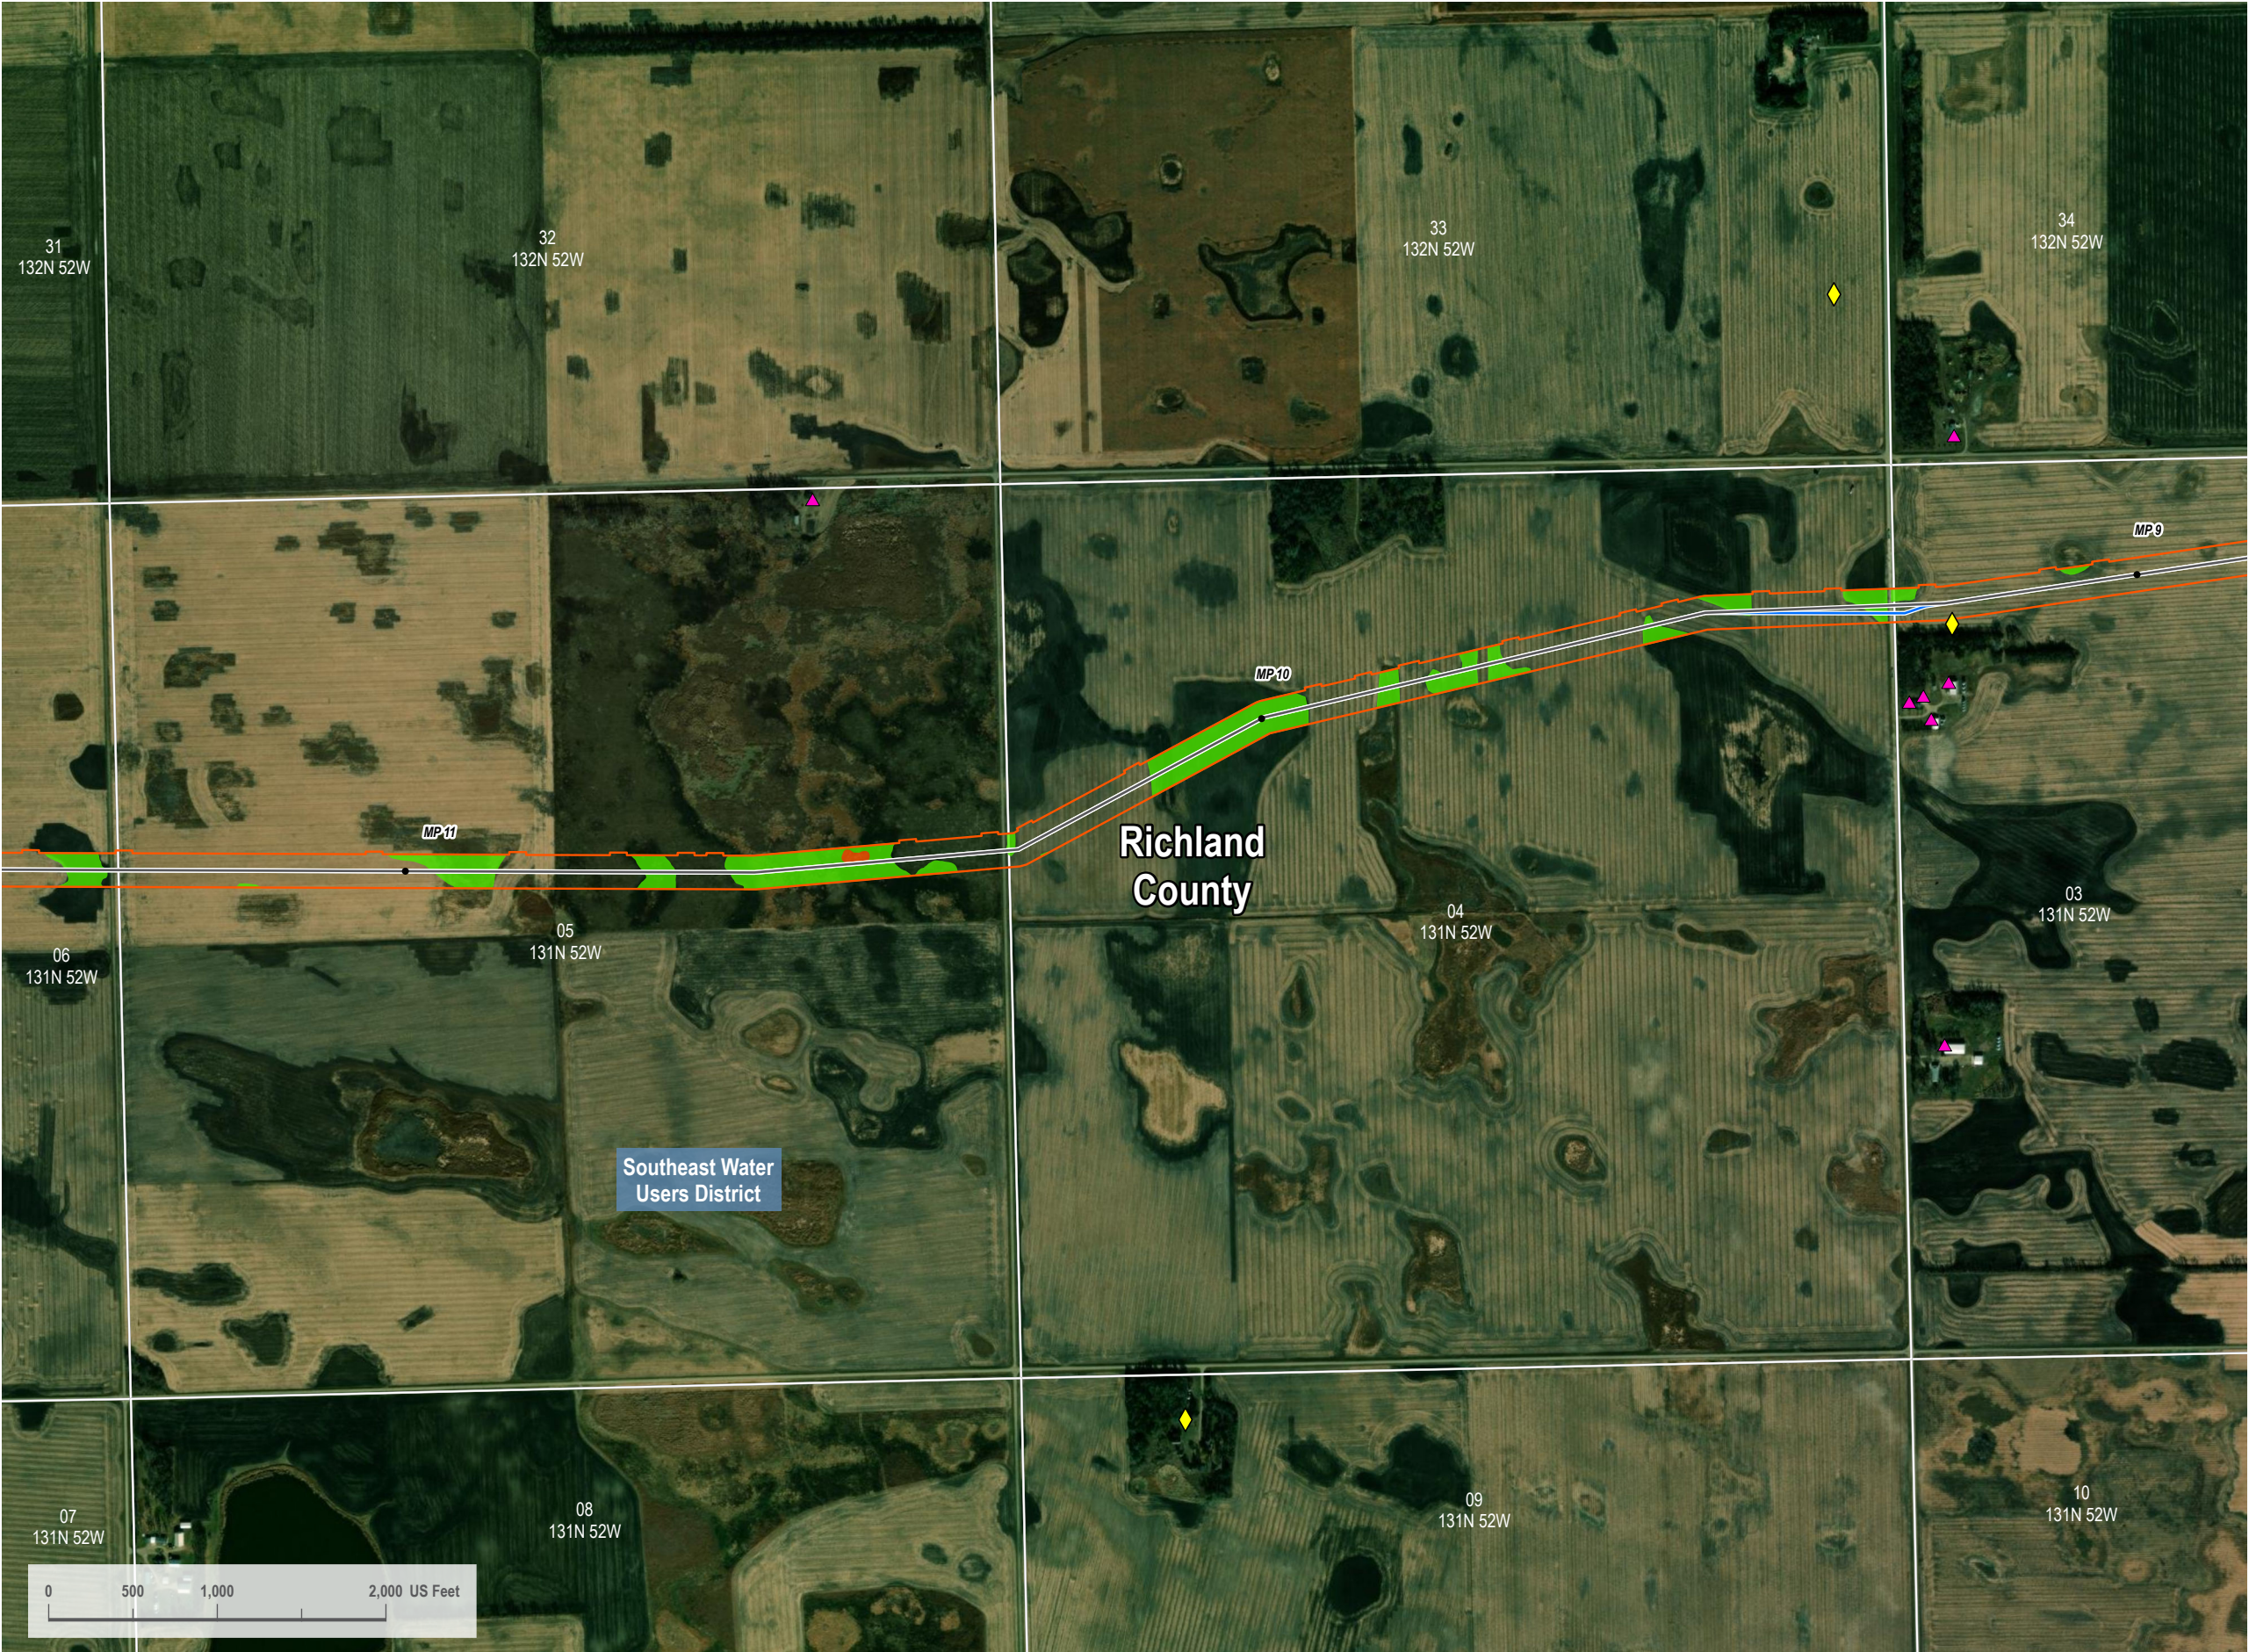

VICINITY MAP



LEGEND

- Centerline Mileposts
- Water Well (Avoidance)
- Domestic Structure or Business (Avoidance)
- Updated Proposed Project Route 08/15/2023
- October 17, 2023 Original PSC Application Route
- Section Line
- PEM Wetland
- PFO Wetland
- 200-foot Stiling Corridor



REVISIONS

Date:	2023-08-17	Revised by:	CW	Checked by:	RC
A - Issued for Review					
Date:		Revised by:		Checked by:	
Date:		Revised by:		Checked by:	

PREPARED BY

**Summit Carbon Solutions**  
2321 North Loop Drive, Suite 221  
Ames, Iowa 50010  
United States of America  
[www.summitcarbonsolutions.com](http://www.summitcarbonsolutions.com)



**SUMMIT CARBON**  
SOLUTIONS

PROJECT INFORMATION

Figure Title: <b>ND PSC - Aerial Map Book - NDT-211</b>	
Figure Number: <b>Map Book 1</b>	
Scale: <b>1 : 12,000</b> 1 inch equals 1,000 feet	Projection: <b>Transverse Mercator</b> NAD 1983 UTM Zone 14N
Sheet: <b>79</b> 79 of 139	Drawing Number: <b>1001-01-003</b> Revision A





VICINITY MAP



LEGEND

- HDD Entry/Exit
- Centerline Mileposts
- Domestic Structure or Business (Avoidance)
- Updated Proposed Project Route 08/15/2023
- October 17, 2023 Original PSC Application Route
- Section Line
- Landslide Deposit (Avoidance)
- PEM Wetland
- Stream
- 200-foot Siting Corridor
- Conservation Easement



REVISIONS

Date:	2023-08-17	Revised by:	CW	Checked by:	RC
A - Issued for Review					
Date:		Revised by:		Checked by:	
Date:		Revised by:		Checked by:	

PREPARED BY

**Summit Carbon Solutions**  
2321 North Loop Drive, Suite 221  
Ames, Iowa 50010  
United States of America  
[www.summitcarbonsolutions.com](http://www.summitcarbonsolutions.com)

PROJECT INFORMATION

Figure Title: <b>ND PSC - Aerial Map Book - NDT-211</b>	
Figure Number: <b>Map Book 1</b>	
Scale: <b>1 : 12,000</b> 1 inch equals 1,000 feet	Projection: <b>Transverse Mercator</b> NAD 1983 UTM Zone 14N
Sheet: <b>80</b> 80 of 139	Drawing Number: <b>1001-01-003</b> Revision A





Path: G:\Projects\JAL\_21015451-00 - Summit Carbon - MCE Project\0800 GE010\_Mapping\01 Map Books\01 General\1001-01-003 ND PSC Mapbook\Rev 04\MapBook1001-01-003 ND PSC Mapbook.aprx

VICINITY MAP



LEGEND

- |   |                           |
|---|---------------------------|
| HDD Entry/Exit                                  | Avoidance Area            |
| Centerline Mileposts                            | PEM Wetland               |
| Water Well (Avoidance)                          | PFO Wetland               |
| Domestic Structure or Business (Avoidance)      | Stream                    |
| Updated Proposed Project Route 08/15/2023       | 200-foot Stiling Corridor |
| October 17, 2023 Original PSC Application Route |                           |
| Section Line                                    |                           |
| Landslide Deposit (Avoidance)                   |                           |



REVISIONS

Date:	2023-08-17	Revised by:	CW	Checked by:	RC
A - Issued for Review					
Date:		Revised by:		Checked by:	
Date:		Revised by:		Checked by:	

PREPARED BY

**Summit Carbon Solutions**  
2321 North Loop Drive, Suite 221  
Ames, Iowa 50010  
United States of America  
[www.summitcarbonsolutions.com](http://www.summitcarbonsolutions.com)

PROJECT INFORMATION

Figure Title: <b>ND PSC - Aerial Map Book - NDT-211</b>	
Figure Number: <b>Map Book 1</b>	
Scale: <b>1 : 12,000</b> 1 inch equals 1,000 feet	Projection: <b>Transverse Mercator</b> NAD 1983 UTM Zone 14N
Sheet: <b>81</b> 81 of 139	Drawing Number: <b>1001-01-003</b> Revision A





VICINITY MAP



LEGEND

- Centerline Mileposts
- Water Well (Avoidance)
- Mainline Valve Location
- Domestic Structure or Business (Avoidance)
- Updated Proposed Project Route 08/15/2023
- October 17, 2023 Original PSC Application Route
- Section Line
- Access Road
- PEM Wetland
- Stream
- 200-foot Siting Corridor



REVISIONS

Date: 2023-08-17	Revised by: CW	Checked by: RC
A - Issued for Review		
Date:	Revised by:	Checked by:
Date:	Revised by:	Checked by:

PREPARED BY

**Summit Carbon Solutions**  
2321 North Loop Drive, Suite 221  
Ames, Iowa 50010  
United States of America  
[www.summitcarbonsolutions.com](http://www.summitcarbonsolutions.com)




**SUMMIT CARBON**  
SOLUTIONS

PROJECT INFORMATION

Figure Title: <b>ND PSC - Aerial Map Book - NDT-211</b>	
Figure Number: <b>Map Book 1</b>	
Scale: <b>1 : 12,000</b> 1 inch equals 1,000 feet	Projection: <b>Transverse Mercator</b> NAD 1983 UTM Zone 14N
Sheet: <b>82</b> 82 of 139	Drawing Number: <b>1001-01-003</b> Revision A



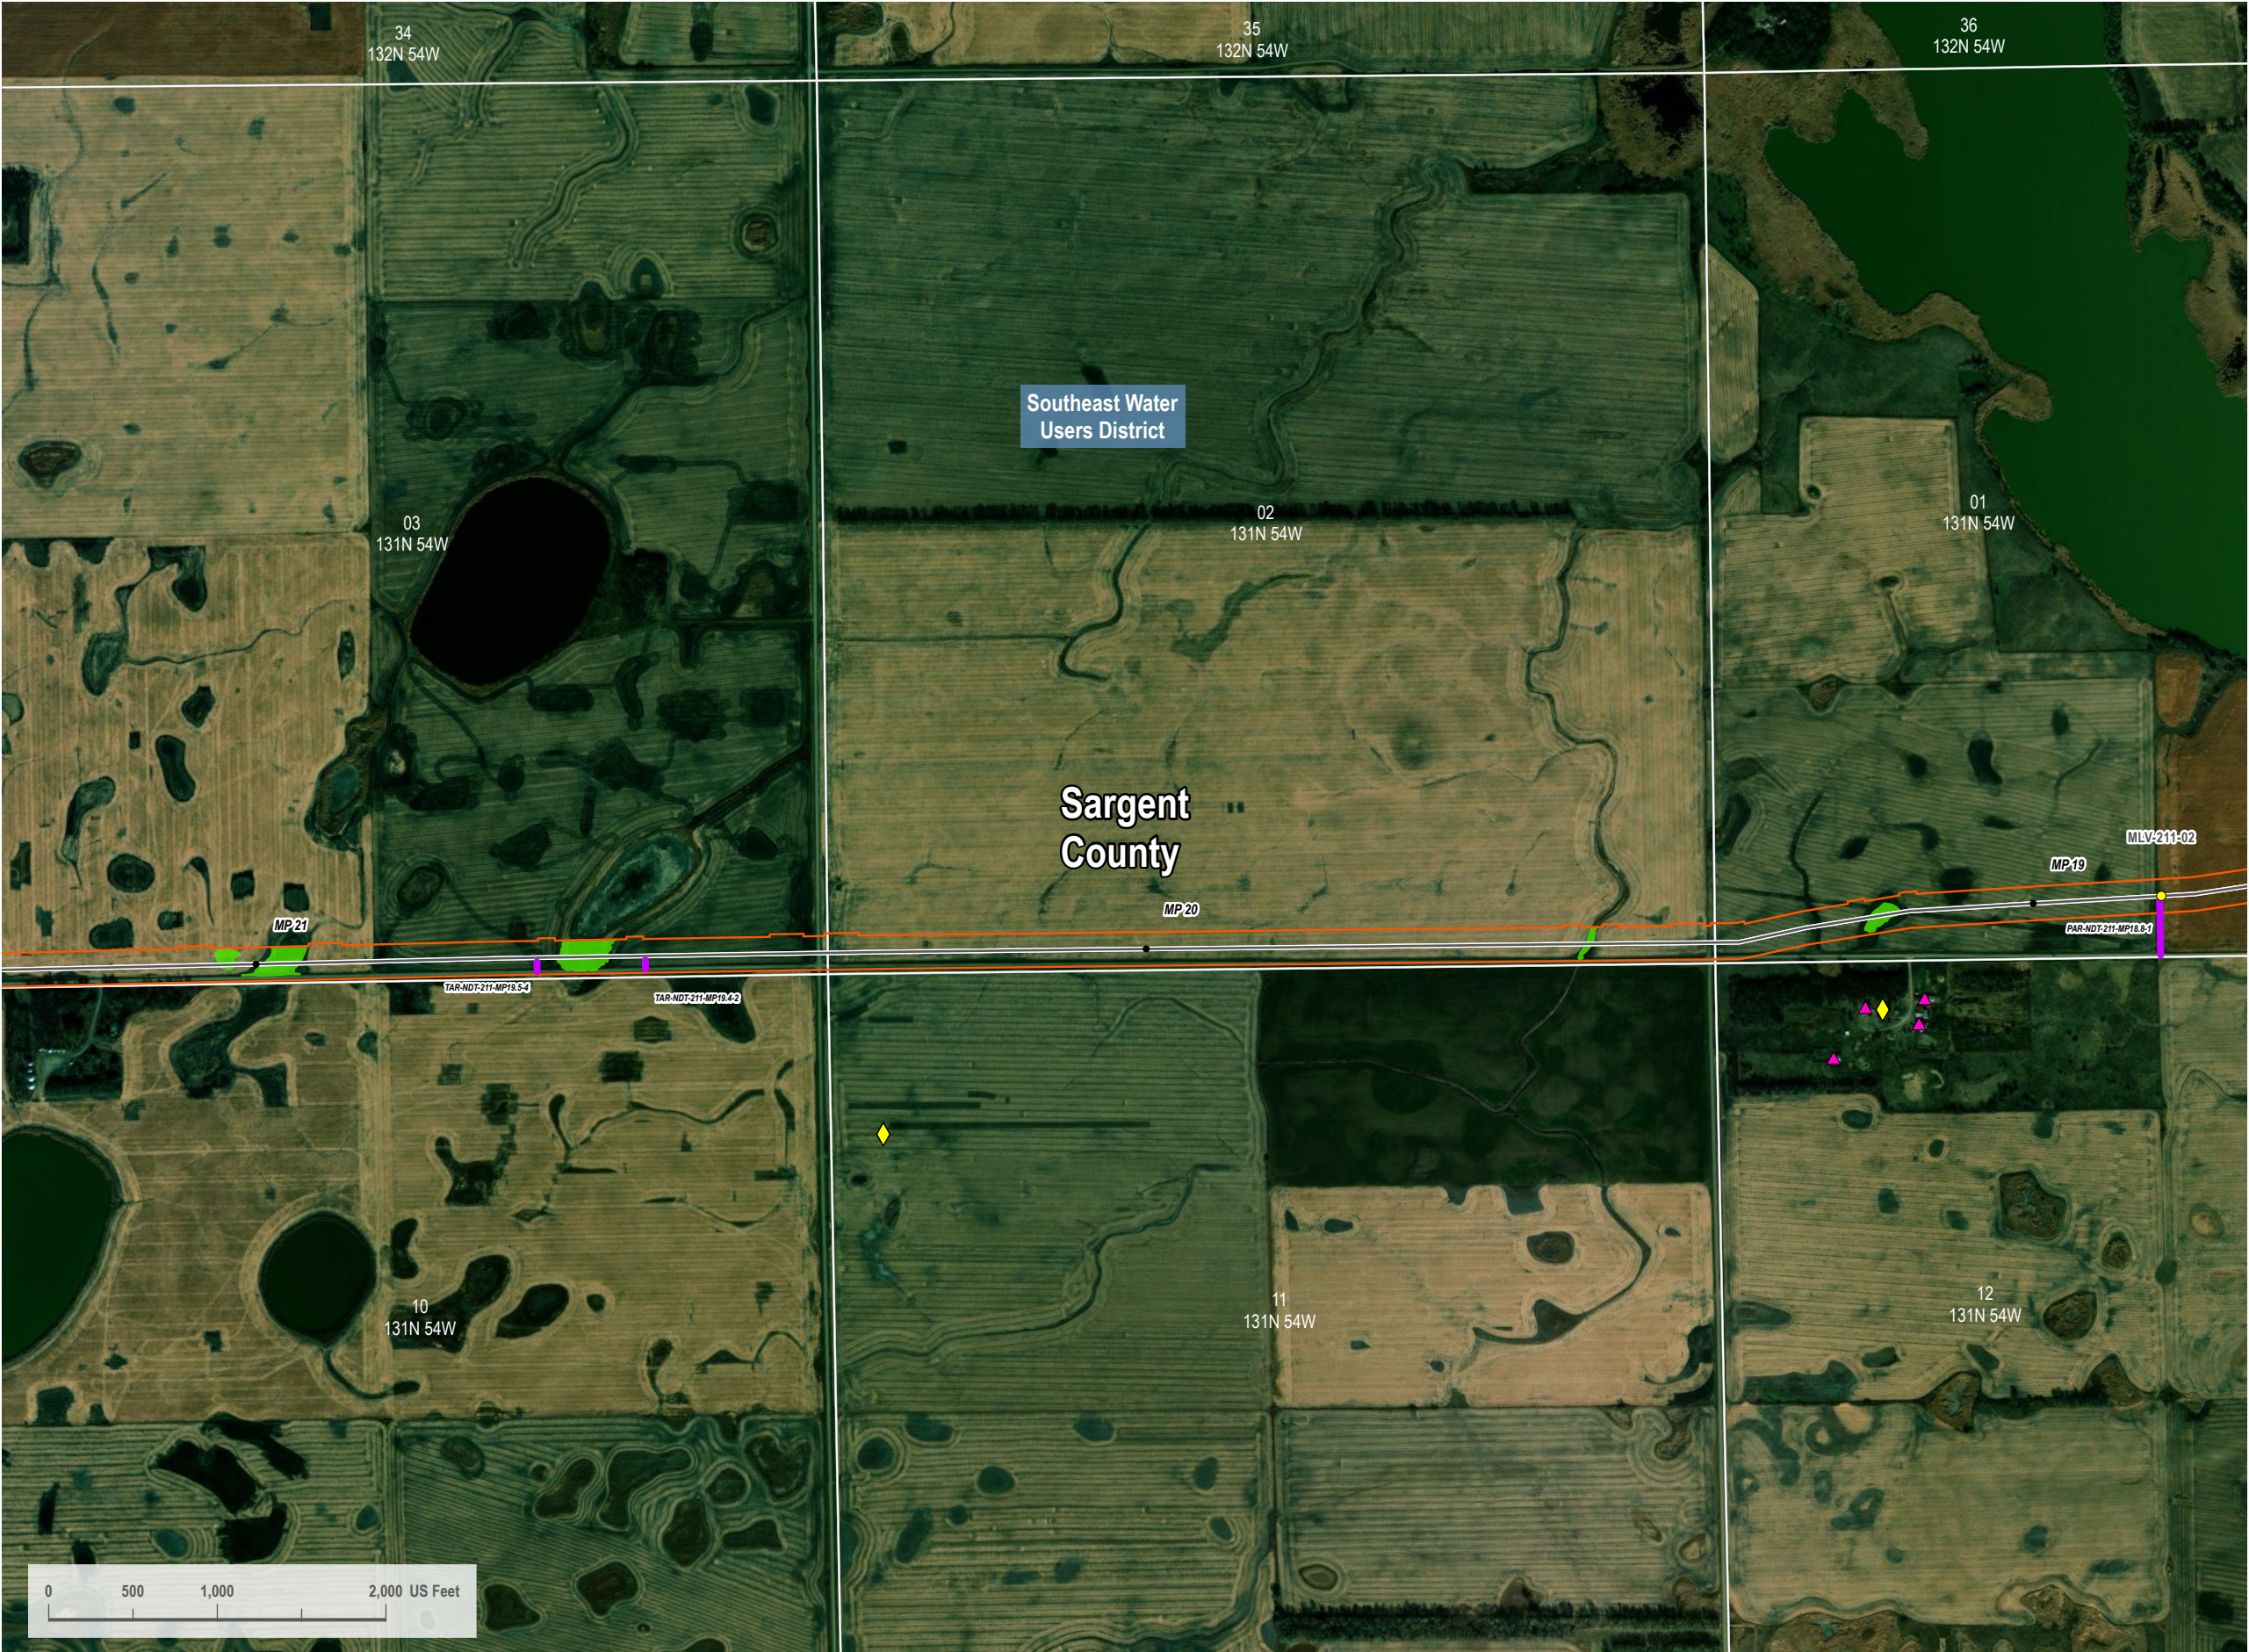

VICINITY MAP



LEGEND

- Centerline Mileposts
- Water Well (Avoidance)
- Mainline Valve Location
- Domestic Structure or Business (Avoidance)
- Updated Proposed Project Route 08/15/2023
- October 17, 2023 Original PSC Application Route
- Section Line
- Access Road
- PEM Wetland
- 200-foot Siting Corridor



REVISIONS

Date: 2023-08-17 Revised by: CW Checked by: RC  
A - Issued for Review

Date: Revised by: Checked by:

Date: Revised by: Checked by:

PREPARED BY

**Summit Carbon Solutions**  
2321 North Loop Drive, Suite 221  
Ames, Iowa 50010  
United States of America  
[www.summitcarbonsolutions.com](http://www.summitcarbonsolutions.com)



PROJECT INFORMATION

Figure Title:  
ND PSC - Aerial Map Book - NDT-211

Figure Number:  
Map Book 1


Scale:  
1 : 12,000  
1 inch equals 1,000 feet

Projection:  
Transverse Mercator  
NAD 1983 UTM Zone 14N

Sheet:  
83  
83 of 139

Drawing Number:  
1001-01-003  
Revision A



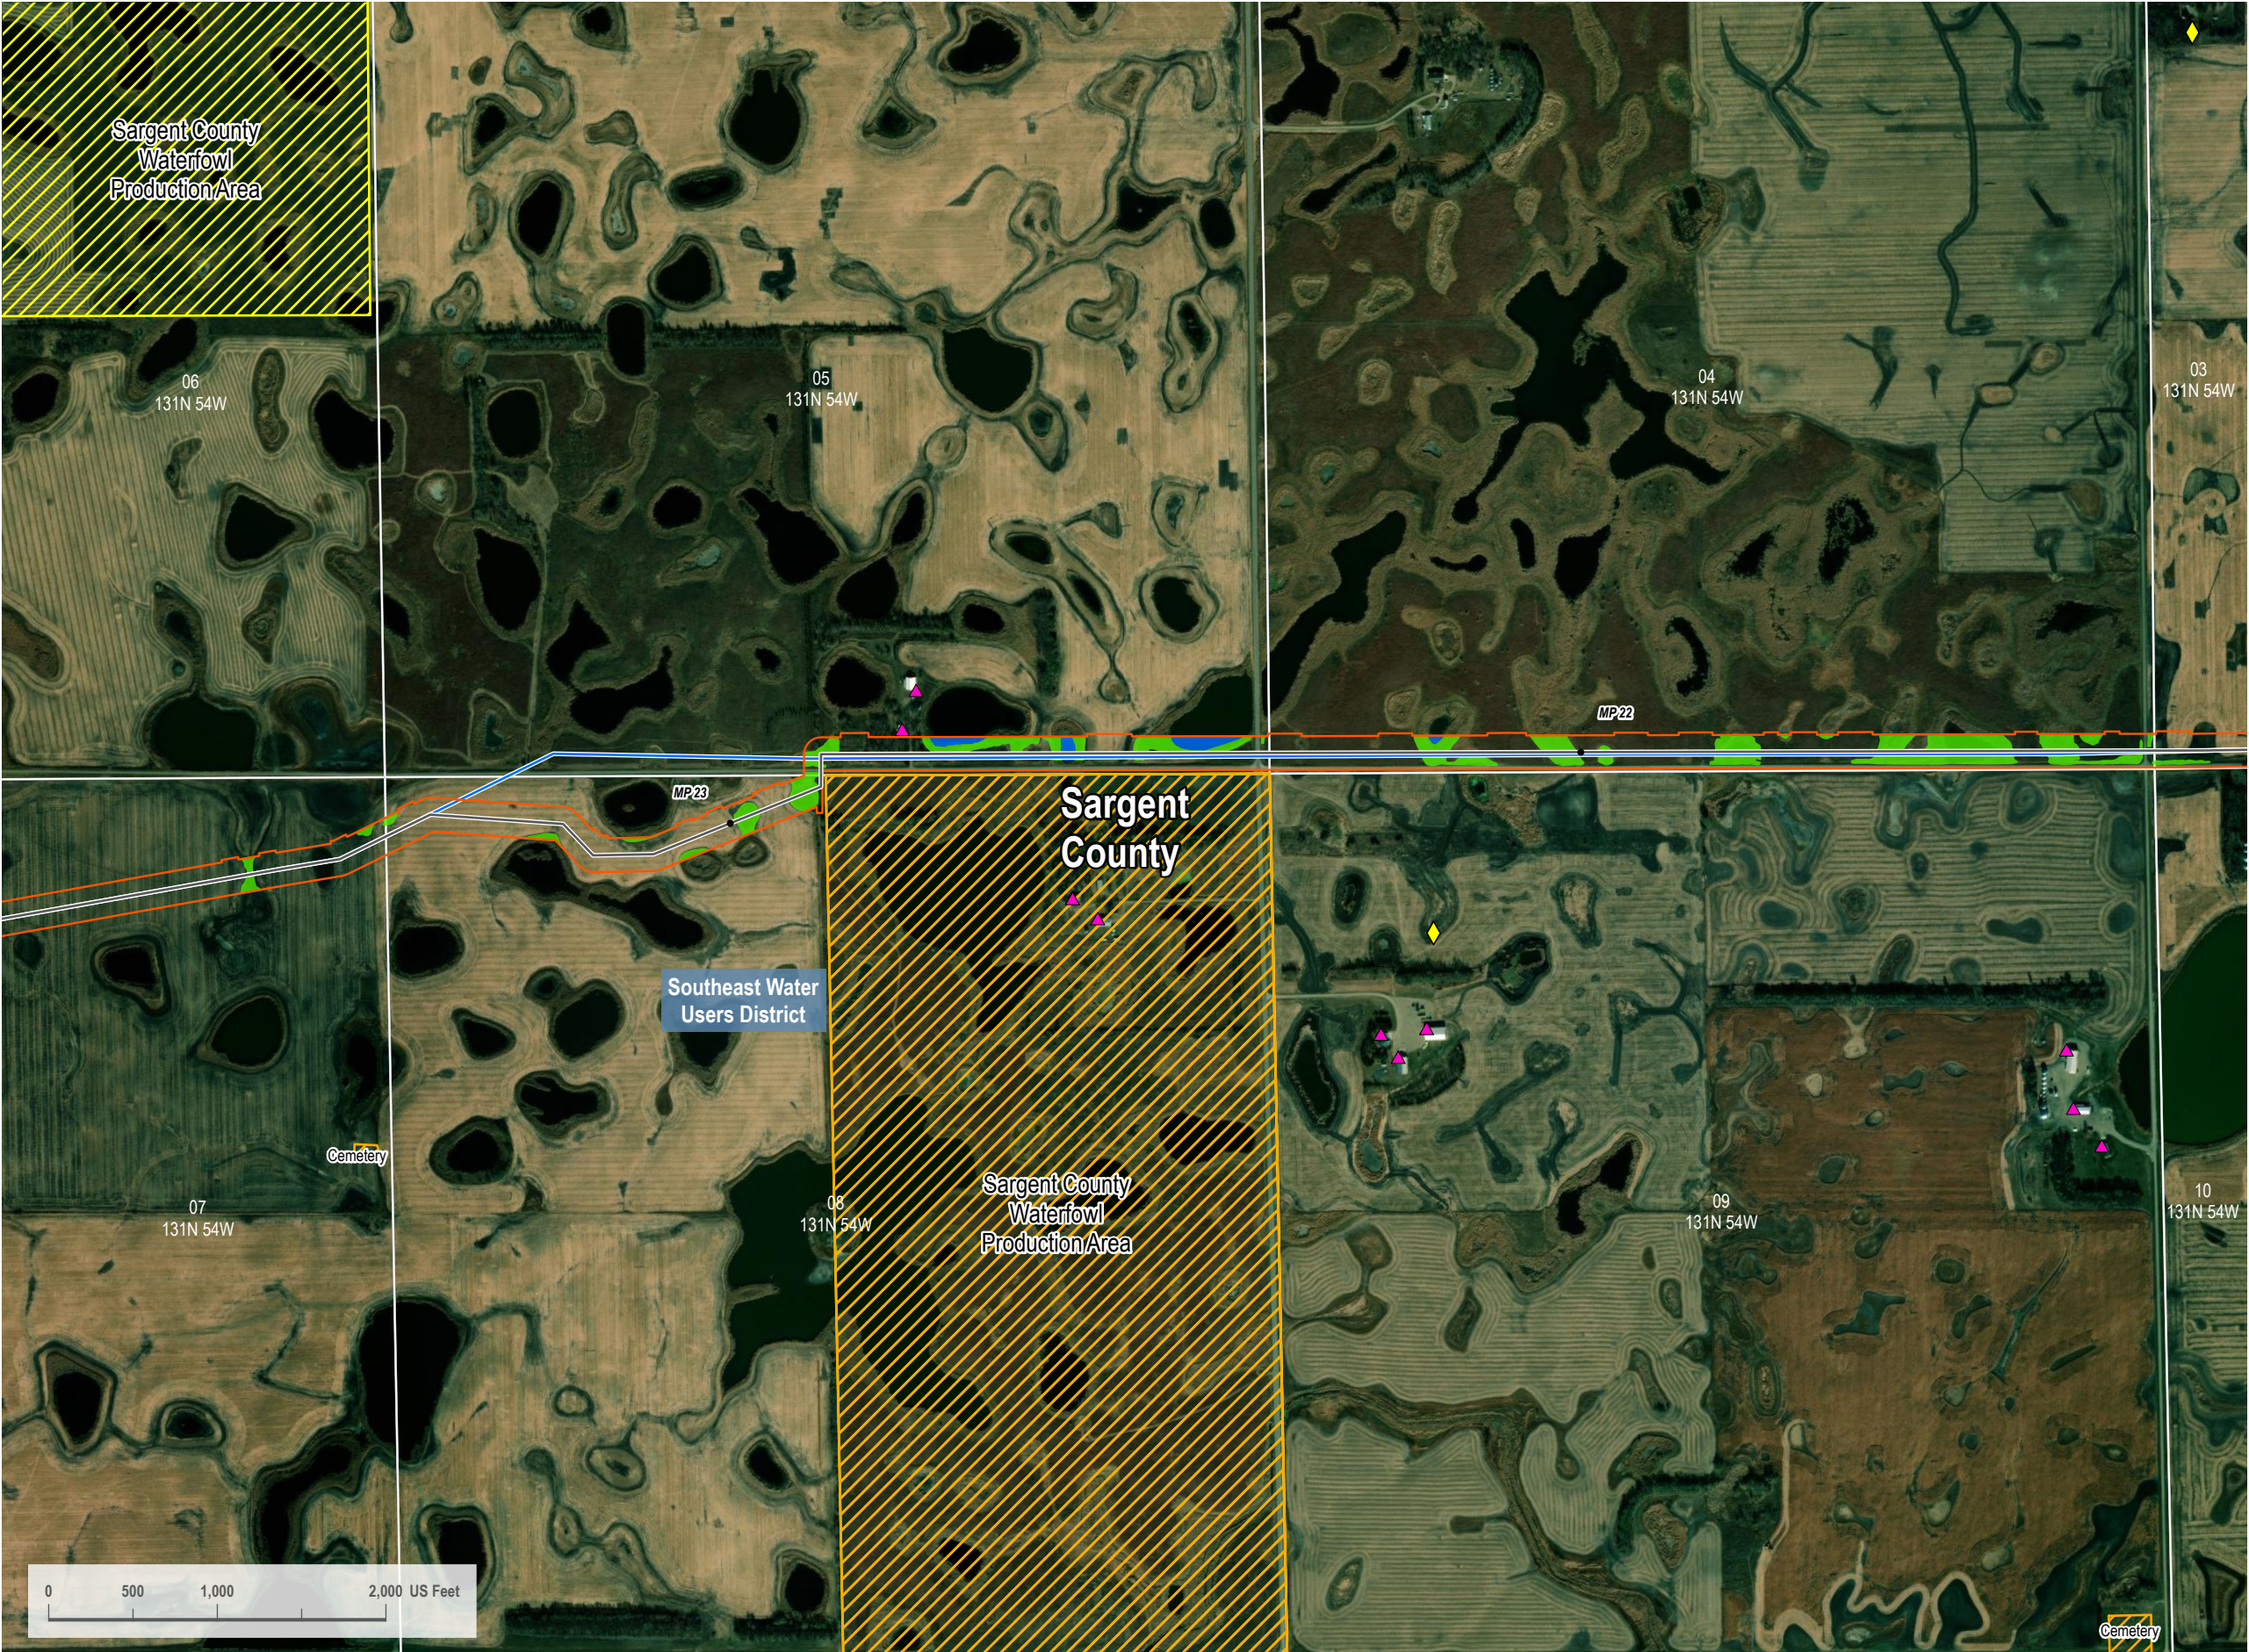

VICINITY MAP



LEGEND

- Centerline Mileposts
- Water Well (Avoidance)
- Domestic Structure or Business (Avoidance)
- Updated Proposed Project Route 08/15/2023
- October 17, 2023 Original PSC Application Route
- Section Line
- Avoidance Area
- Open Water
- PEM Wetland
- 200-foot Siting Corridor
- Resource Management Area



REVISIONS

Date:	2023-08-17	Revised by:	CW	Checked by:	RC
A - Issued for Review					
Date:		Revised by:		Checked by:	
Date:		Revised by:		Checked by:	

PREPARED BY

**Summit Carbon Solutions**  
2321 North Loop Drive, Suite 221  
Ames, Iowa 50010  
United States of America  
[www.summitcarbonsolutions.com](http://www.summitcarbonsolutions.com)




**SUMMIT CARBON**  
SOLUTIONS

PROJECT INFORMATION

Figure Title: <b>ND PSC - Aerial Map Book - NDT-211</b>	
Figure Number: <b>Map Book 1</b>	
Scale: <b>1 : 12,000</b> 1 inch equals 1,000 feet	Projection: <b>Transverse Mercator</b> NAD 1983 UTM Zone 14N
Sheet: <b>84</b> 84 of 139	Drawing Number: <b>1001-01-003</b> Revision A



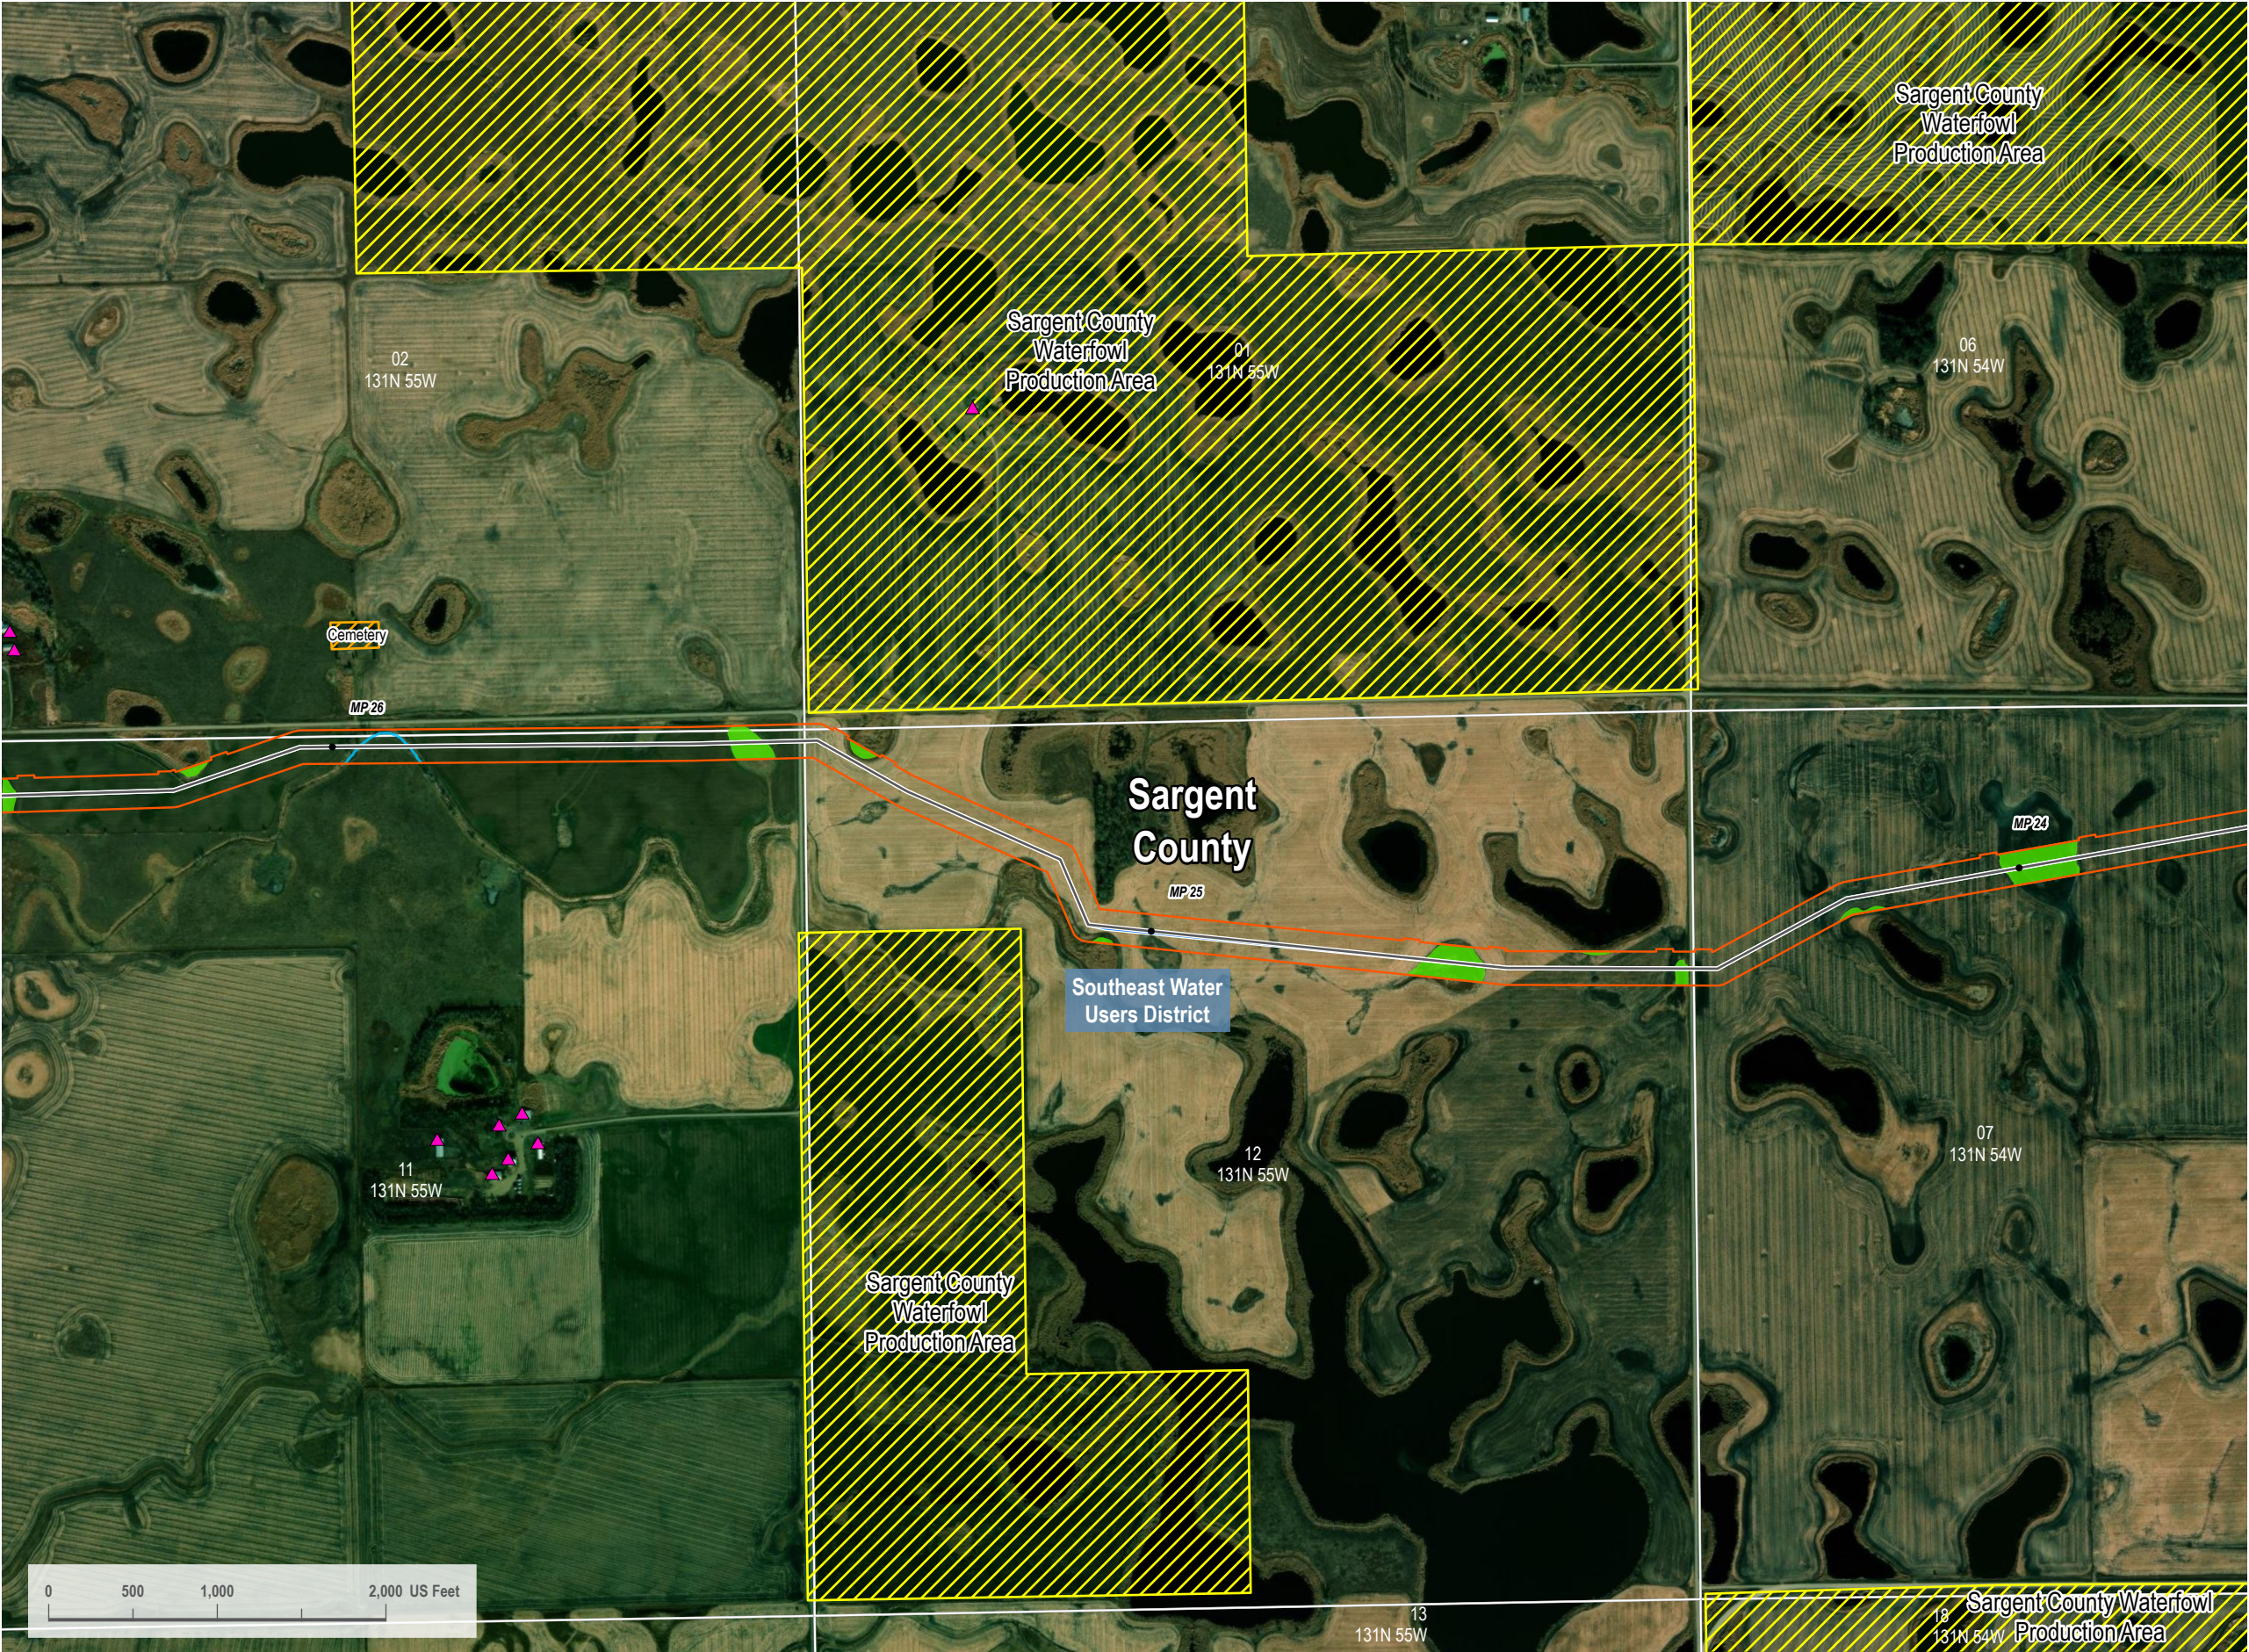


VICINITY MAP



LEGEND

- Centerline Mileposts
- Domestic Structure or Business (Avoidance)
- Updated Proposed Project Route 08/15/2023
- October 17, 2023 Original PSC Application Route
- Section Line
- Avoidance Area
- PEM Wetland
- Stream
- 200-foot Siting Corridor
- Resource Management Area

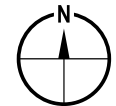

REVISIONS

Date:	2023-08-17	Revised by:	CW	Checked by:	RC
A - Issued for Review					
Date:		Revised by:		Checked by:	
Date:		Revised by:		Checked by:	

PREPARED BY

**Summit Carbon Solutions**  
2321 North Loop Drive, Suite 221  
Ames, Iowa 50010  
United States of America  
[www.summitcarbonsolutions.com](http://www.summitcarbonsolutions.com)



**SUMMIT CARBON**  
SOLUTIONS

PROJECT INFORMATION

Figure Title: <b>ND PSC - Aerial Map Book - NDT-211</b>	
Figure Number: <b>Map Book 1</b>	
Scale: <b>1 : 12,000</b> 1 inch equals 1,000 feet	Projection: Transverse Mercator NAD 1983 UTM Zone 14N
Sheet: <b>85</b> 85 of 139	Drawing Number: <b>1001-01-003</b> Revision A





VICINITY MAP

LEGEND

- Centerline Mileposts
- Water Well (Avoidance)
- Domestic Structure or Business (Avoidance)
- Updated Proposed Project Route 08/15/2023
- October 17, 2023 Original PSC Application Route
- Section Line
- PEM Wetland
- 200-foot Siting Corridor
- Resource Management Area

REVISIONS

Date: 2023-08-17	Revised by: CW	Checked by: RC
A - Issued for Review		
Date:	Revised by:	Checked by:
Date:	Revised by:	Checked by:

PREPARED BY

Summit Carbon Solutions

2321 North Loop Drive, Suite 221  
Ames, Iowa 50010  
United States of America

www.summitcarbonsolutions.com


PROJECT INFORMATION

Figure Title:  
ND PSC - Aerial Map Book - NDT-211

Figure Number:  
Map Book 1

Scale: 1 : 12,000 1 inch equals 1,000 feet	Projection: Transverse Mercator NAD 1983 UTM Zone 14N
Sheet: 86 86 of 139	Drawing Number: 1001-01-003 Revision A



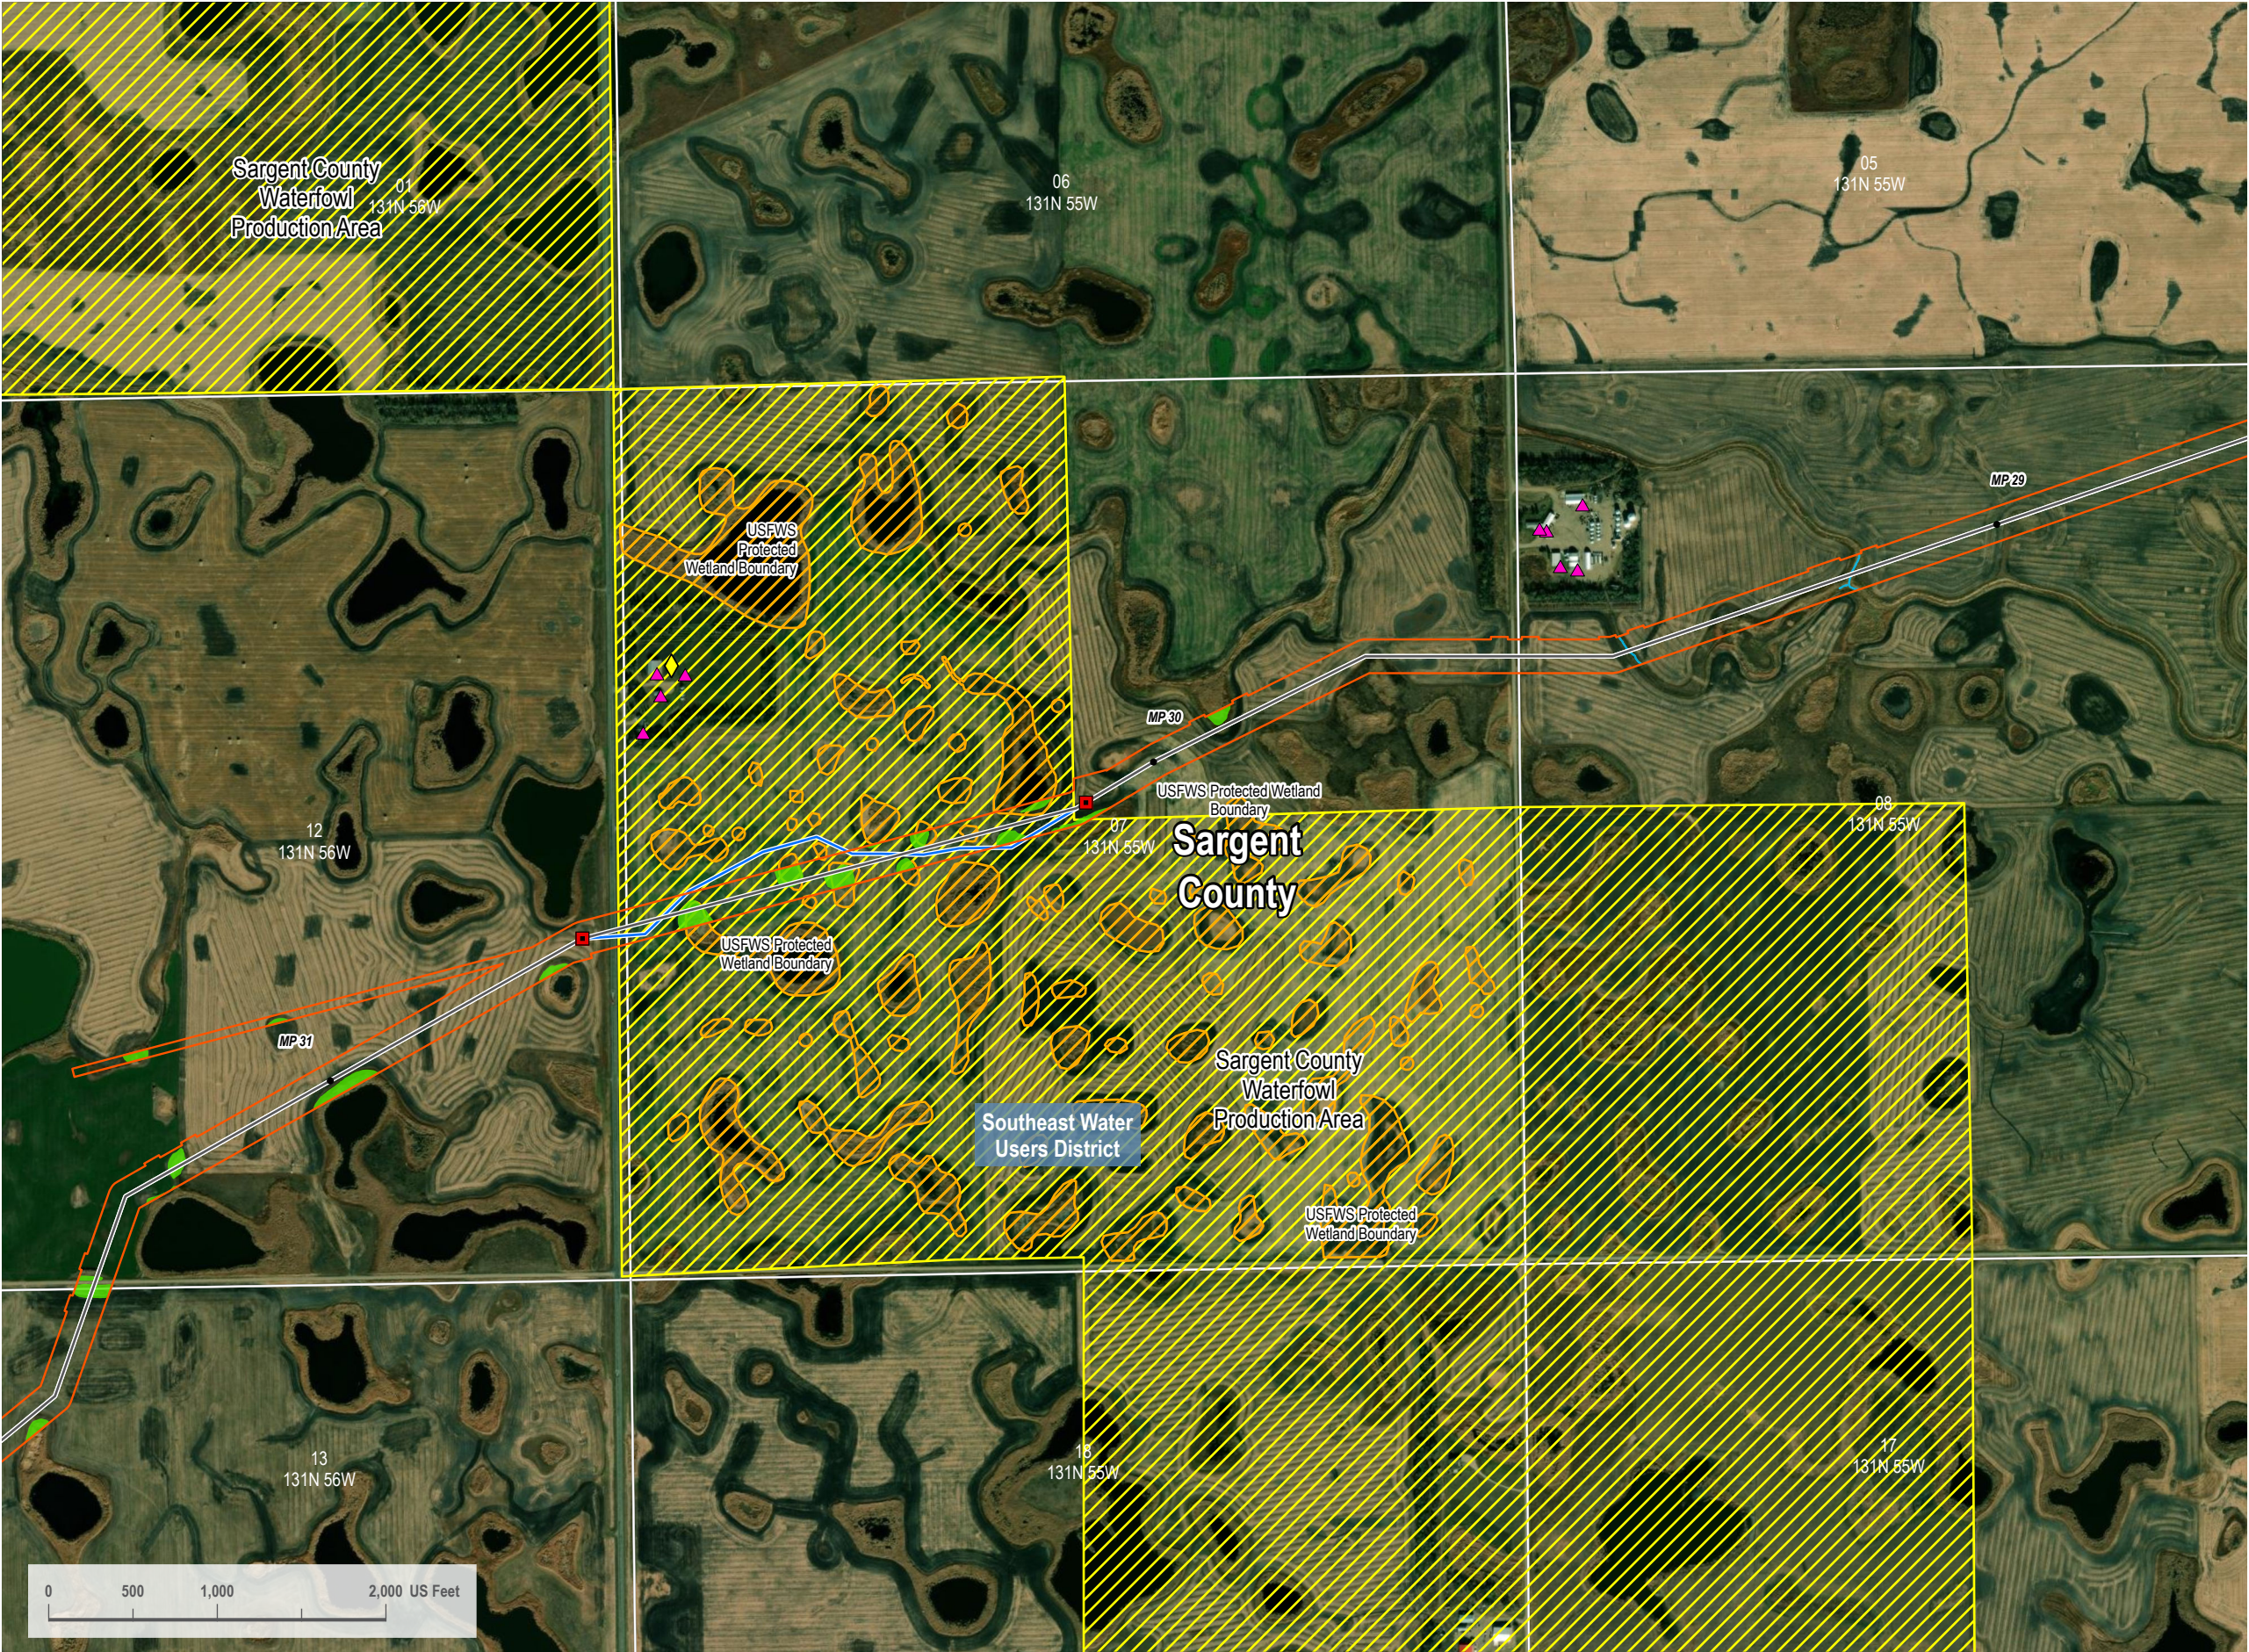

VICINITY MAP



LEGEND

- HDD Entry/Exit
- Centerline Mileposts
- Water Well (Avoidance)
- Domestic Structure or Business (Avoidance)
- Updated Proposed Project Route 08/15/2023
- October 17, 2023 Original PSC Application Route
- Section Line
- Avoidance Area
- PEM Wetland
- Stream
- 200-foot Siting Corridor
- Resource Management Area



REVISIONS

Date: 2023-08-17	Revised by: CW	Checked by: RC
A - Issued for Review		
Date:	Revised by:	Checked by:
Date:	Revised by:	Checked by:

PREPARED BY

**Summit Carbon Solutions**  
2321 North Loop Drive, Suite 221  
Ames, Iowa 50010  
United States of America  
[www.summitcarbonsolutions.com](http://www.summitcarbonsolutions.com)



**SUMMIT CARBON SOLUTIONS**

PROJECT INFORMATION

Figure Title: <b>ND PSC - Aerial Map Book - NDT-211</b>	
Figure Number: <b>Map Book 1</b>	
Scale: <b>1 : 12,000</b> 1 inch equals 1,000 feet	Projection: <b>Transverse Mercator</b> NAD 1983 UTM Zone 14N
Sheet: <b>87</b> 87 of 139	Drawing Number: <b>1001-01-003</b> Revision A





VICINITY MAP



LEGEND

- HDD Entry/Exit
- Centerline Mileposts
- Water Well (Avoidance)
- Domestic Structure or Business (Avoidance)
- Updated Proposed Project Route 08/15/2023
- October 17, 2023 Original PSC Application Route
- Section Line
- Open Water
- PEM Wetland
- 200-foot Stiling Corridor
- Resource Management Area



REVISIONS

Date: 2023-08-17	Revised by: CW	Checked by: RC
A - Issued for Review		
Date:	Revised by:	Checked by:
Date:	Revised by:	Checked by:

PREPARED BY

**Summit Carbon Solutions**  
2321 North Loop Drive, Suite 221  
Ames, Iowa 50010  
United States of America  
[www.summitcarbonsolutions.com](http://www.summitcarbonsolutions.com)



**SUMMIT CARBON**  
SOLUTIONS

PROJECT INFORMATION

Figure Title: <b>ND PSC - Aerial Map Book - NDT-211</b>	
Figure Number: <b>Map Book 1</b>	
Scale: <b>1 : 12,000</b> 1 inch equals 1,000 feet	Projection: <b>Transverse Mercator</b> NAD 1983 UTM Zone 14N
Sheet: <b>88</b> 88 of 139	Drawing Number: <b>1001-01-003</b> Revision A





VICINITY MAP

LEGEND

- Centerline Mileposts
- Water Well (Avoidance)
- Domestic Structure or Business (Avoidance)
- Updated Proposed Project Route 08/15/2023
- October 17, 2023 Original PSC Application Route
- Section Line
- PEM Wetland
- 200-foot Siting Corridor
- Resource Management Area

REVISIONS

Date: 2023-08-17	Revised by: CW	Checked by: RC
A - Issued for Review		
Date:	Revised by:	Checked by:
Date:	Revised by:	Checked by:

PREPARED BY

Summit Carbon Solutions

2321 North Loop Drive, Suite 221  
Ames, Iowa 50010  
United States of America  
[www.summitcarbonsolutions.com](http://www.summitcarbonsolutions.com)


PROJECT INFORMATION

Figure Title:  
ND PSC - Aerial Map Book - NDT-211

Figure Number:  
Map Book 1

Scale: 1 : 12,000 1 inch equals 1,000 feet	Projection: Transverse Mercator NAD 1983 UTM Zone 14N
Sheet: 89 89 of 139	Drawing Number: 1001-01-003 Revision A



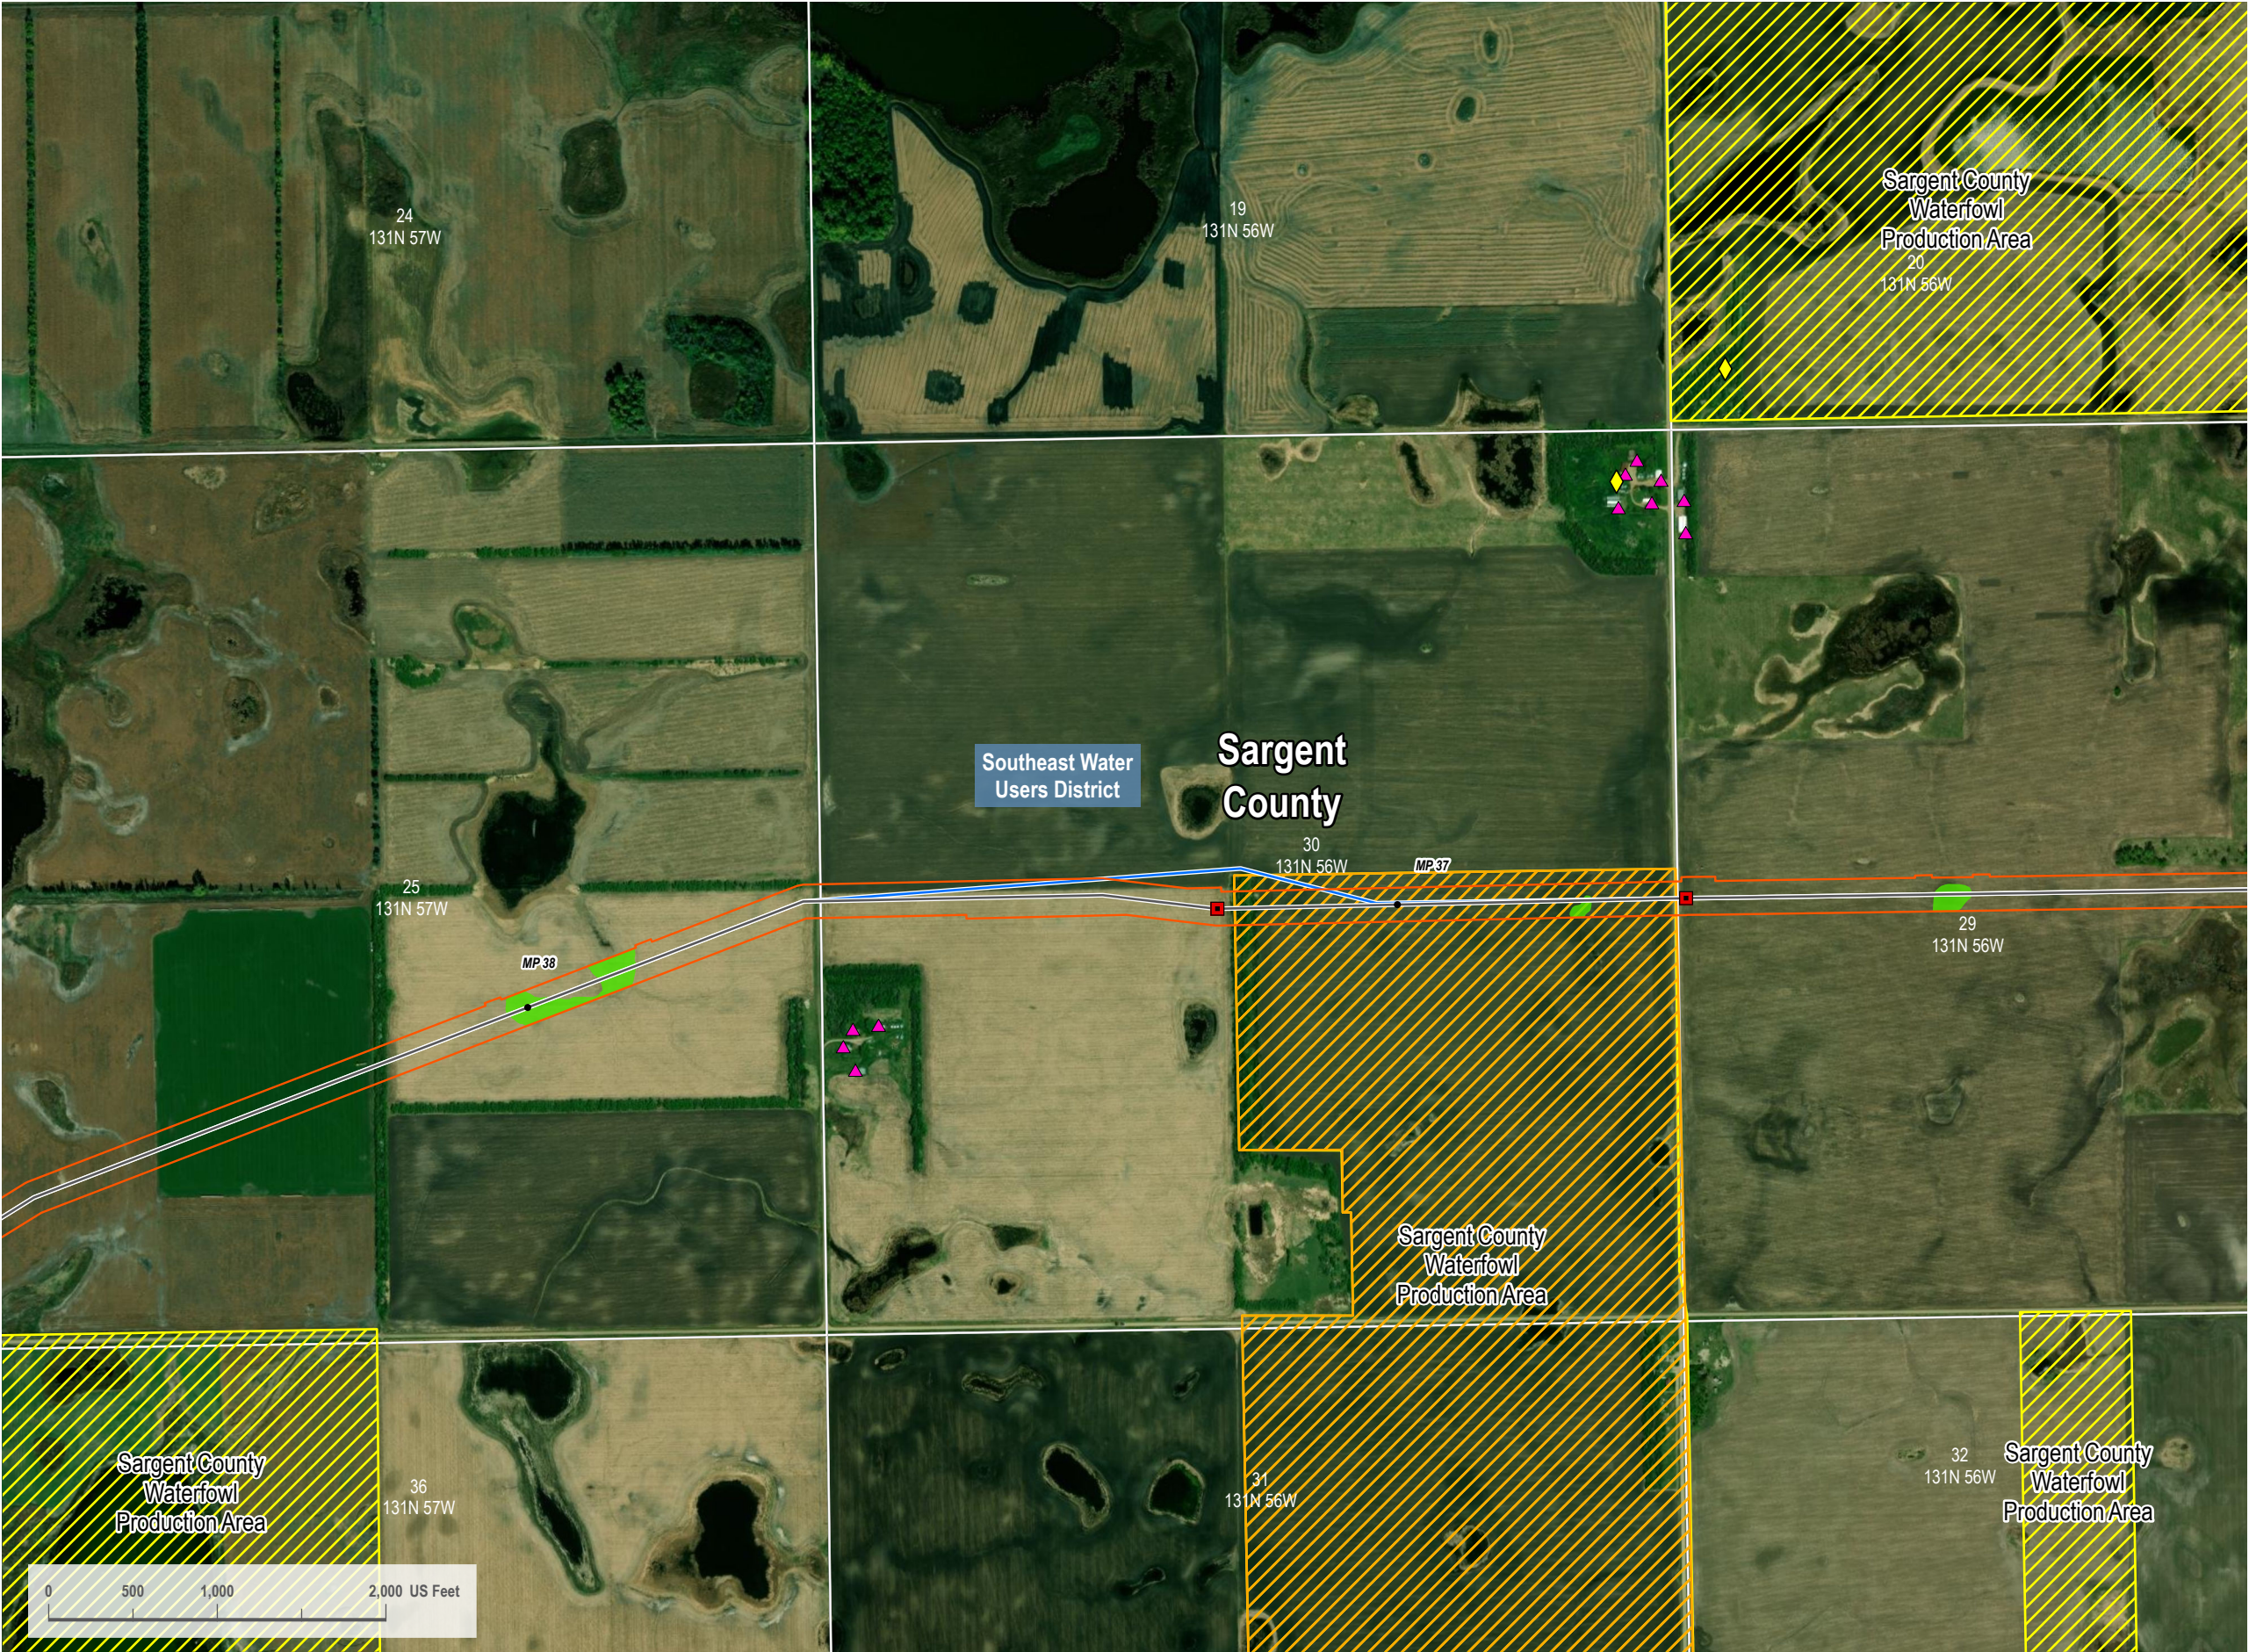

VICINITY MAP



LEGEND

- HDD Entry/Exit
- Centerline Mileposts
- Water Well (Avoidance)
- Domestic Structure or Business (Avoidance)
- Updated Proposed Project Route 08/15/2023
- October 17, 2023 Original PSC Application Route
- Section Line
- Avoidance Area
- PEM Wetland
- 200-foot Siting Corridor
- Resource Management Area



REVISIONS

Date:	2023-08-17	Revised by:	CW	Checked by:	RC
A - Issued for Review					
Date:		Revised by:		Checked by:	
Date:		Revised by:		Checked by:	

PREPARED BY

**Summit Carbon Solutions**  
2321 North Loop Drive, Suite 221  
Ames, Iowa 50010  
United States of America  
[www.summitcarbonsolutions.com](http://www.summitcarbonsolutions.com)



**SUMMIT CARBON**  
SOLUTIONS

PROJECT INFORMATION

Figure Title: <b>ND PSC - Aerial Map Book - NDT-211</b>	
Figure Number: <b>Map Book 1</b>	
Scale: <b>1 : 12,000</b> 1 inch equals 1,000 feet	Projection: <b>Transverse Mercator</b> NAD 1983 UTM Zone 14N
Sheet: <b>90</b> 90 of 139	Drawing Number: <b>1001-01-003</b> Revision A





VICINITY MAP



LEGEND

- Centerline Mileposts
- Water Well (Avoidance)
- Mainline Valve Location
- Domestic Structure or Business (Avoidance)
- Updated Proposed Project Route 08/15/2023
- October 17, 2023 Original PSC Application Route
- Section Line
- Access Road
- Avoidance Area
- PEM Wetland
- Stream
- 200-foot Siting Corridor
- Resource Management Area



REVISIONS

Date:	2023-08-17	Revised by:	CW	Checked by:	RC
A - Issued for Review					
Date:		Revised by:		Checked by:	
Date:		Revised by:		Checked by:	

PREPARED BY

**Summit Carbon Solutions**  
2321 North Loop Drive, Suite 221  
Ames, Iowa 50010  
United States of America  
[www.summitcarbonsolutions.com](http://www.summitcarbonsolutions.com)



**SUMMIT CARBON SOLUTIONS**

PROJECT INFORMATION

Figure Title: <b>ND PSC - Aerial Map Book - NDT-211</b>	
Figure Number: <b>Map Book 1</b>	
Scale: <b>1 : 12,000</b> 1 inch equals 1,000 feet	Projection: <b>Transverse Mercator</b> NAD 1983 UTM Zone 14N
Sheet: <b>91</b> 91 of 139	Drawing Number: <b>1001-01-003</b> Revision A





VICINITY MAP



LEGEND

- HDD Entry/Exit
- Centerline Mileposts
- Water Well (Avoidance)
- Domestic Structure or Business (Avoidance)
- Updated Proposed Project Route 08/15/2023
- October 17, 2023 Original PSC Application Route
- Section Line
- Access Road
- Avoidance Area
- PEM Wetland
- Stream
- 200-foot Siting Corridor



REVISIONS

Date: 2023-08-17	Revised by: CW	Checked by: RC
A - Issued for Review		
Date:	Revised by:	Checked by:
Date:	Revised by:	Checked by:


PREPARED BY

**Summit Carbon Solutions**  
2321 North Loop Drive, Suite 221  
Ames, Iowa 50010  
United States of America  
[www.summitcarbonsolutions.com](http://www.summitcarbonsolutions.com)

PROJECT INFORMATION

Figure Title: <b>ND PSC - Aerial Map Book - NDT-211</b>	
Figure Number: <b>Map Book 1</b>	
Scale: <b>1 : 12,000</b> 1 inch equals 1,000 feet	Projection: <b>Transverse Mercator</b> NAD 1983 UTM Zone 14N
Sheet: <b>92</b> 92 of 139	Drawing Number: <b>1001-01-003</b> Revision A



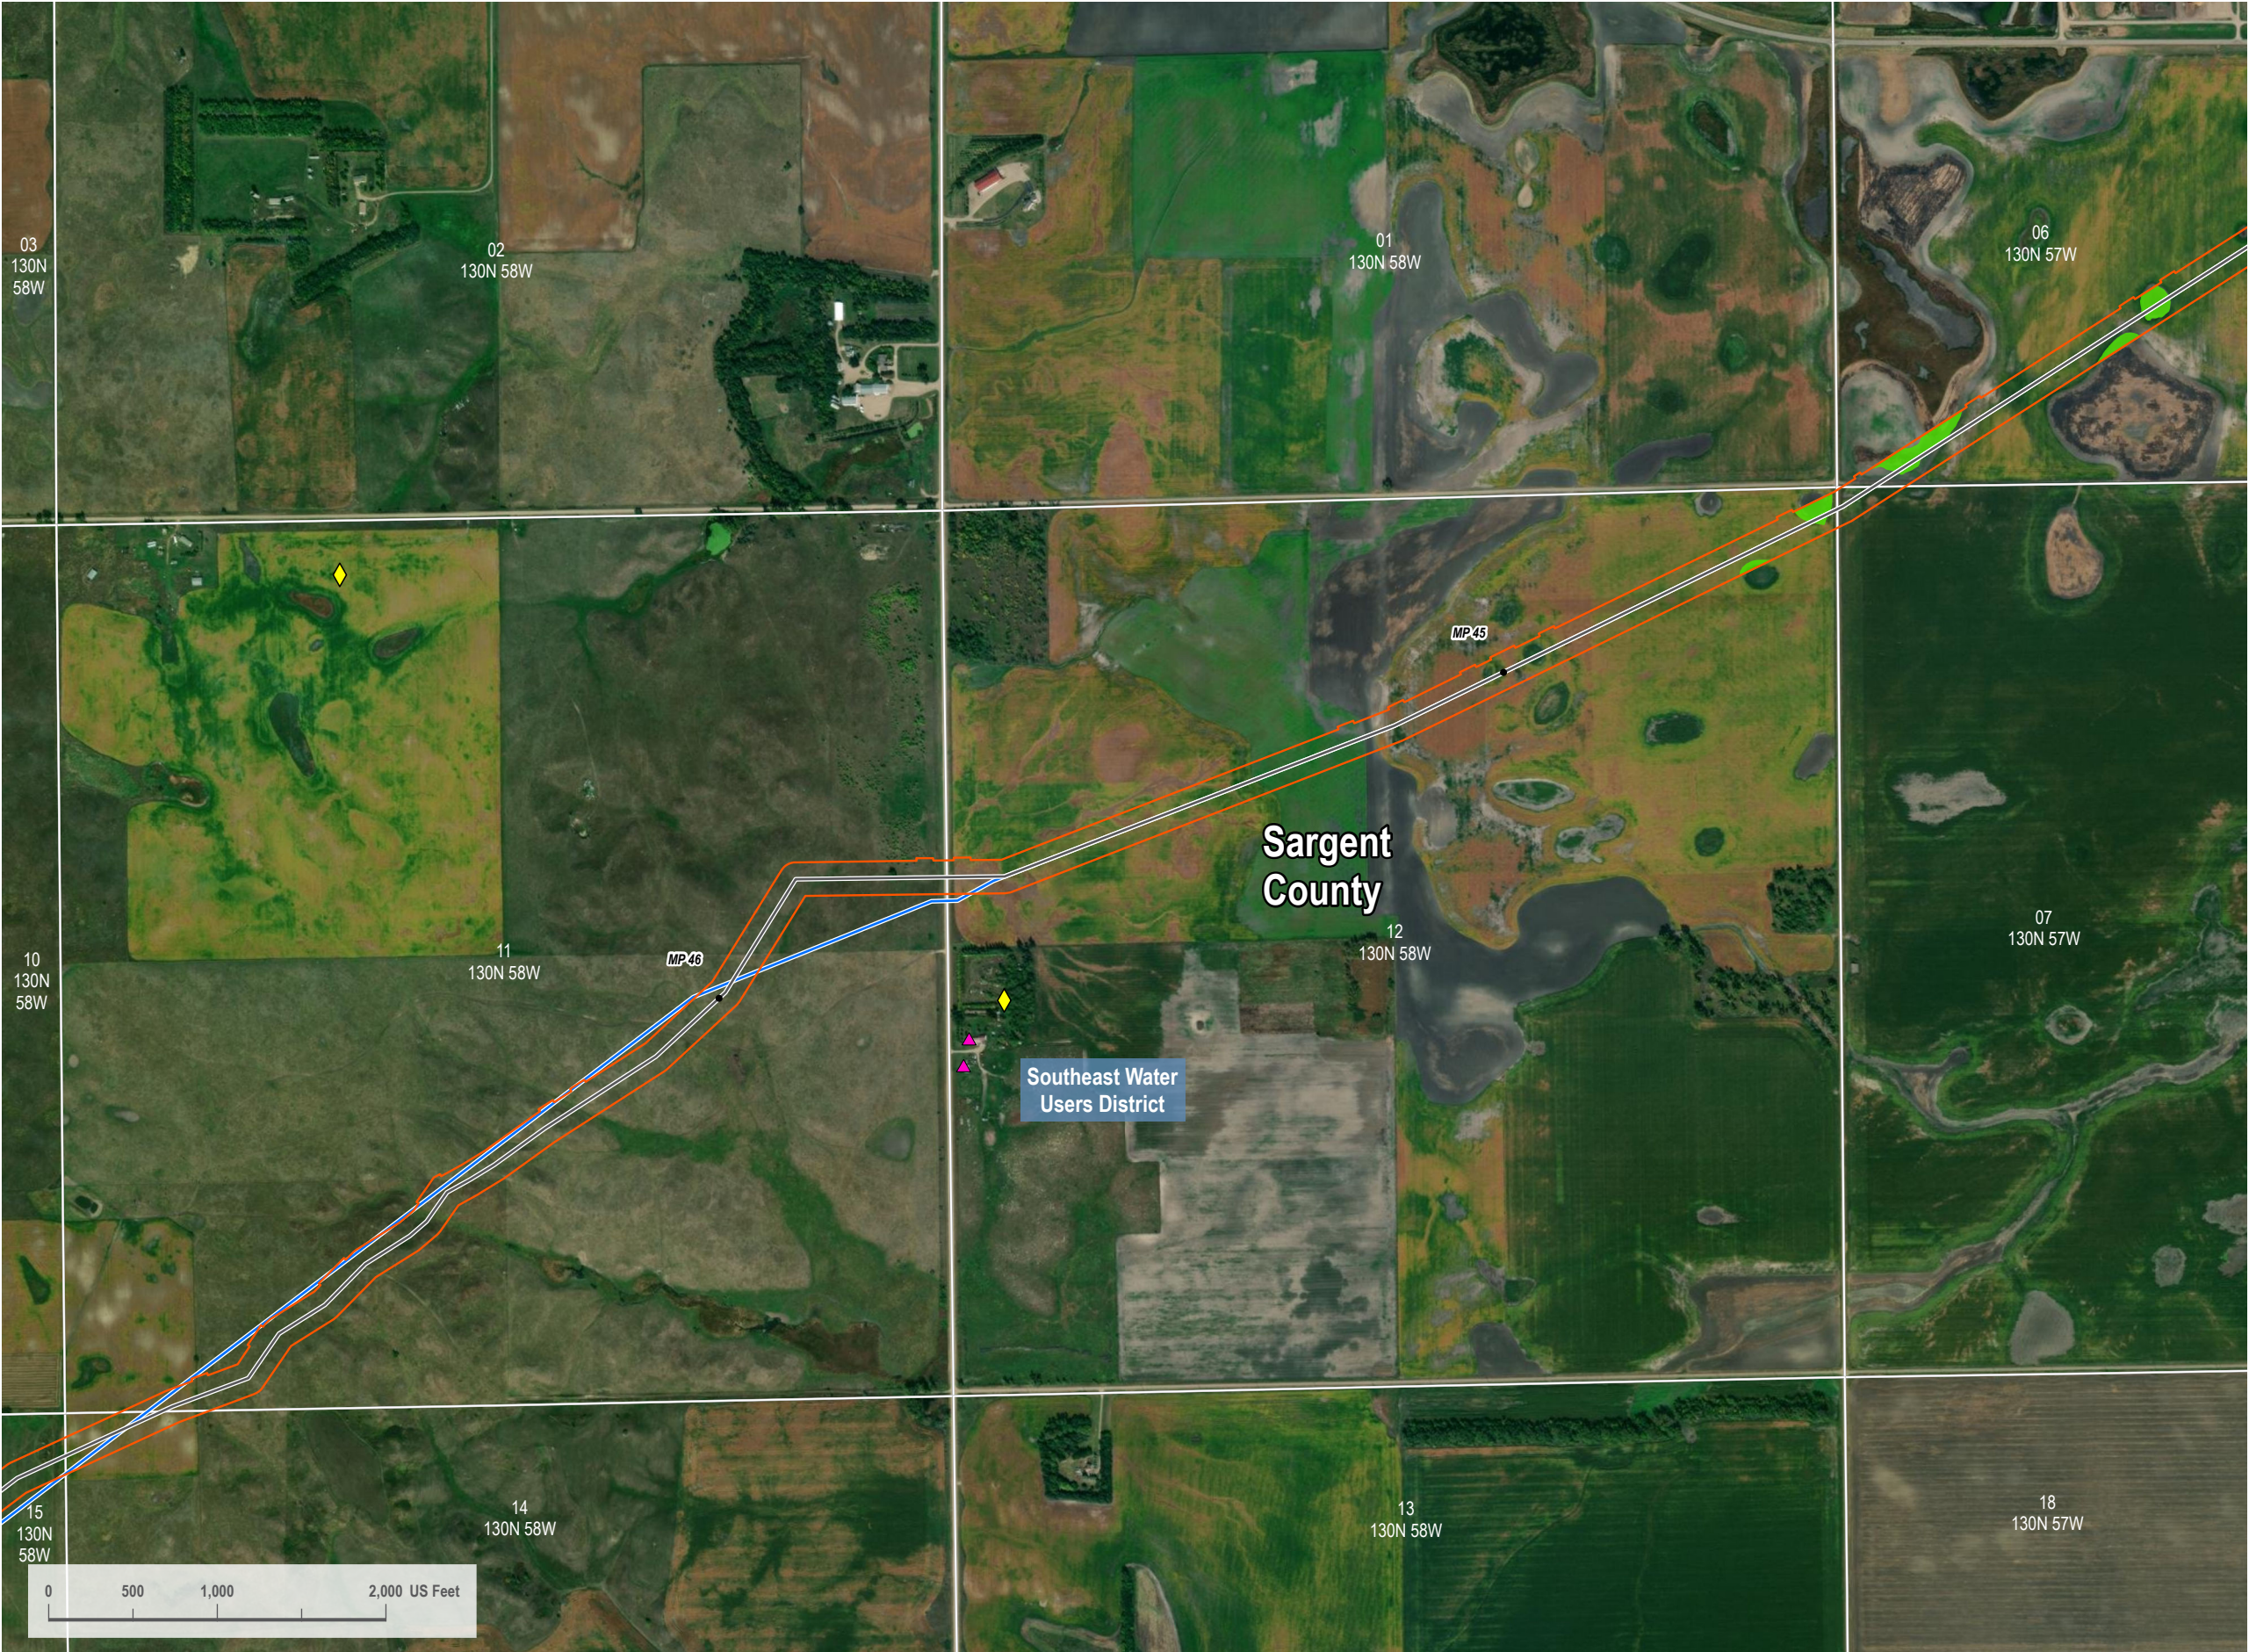

VICINITY MAP



LEGEND

- Centerline Mileposts
- Water Well (Avoidance)
- Domestic Structure or Business (Avoidance)
- Updated Proposed Project Route 08/15/2023
- October 17, 2023 Original PSC Application Route
- Section Line
- PEM Wetland
- 200-foot Siting Corridor



REVISIONS

Date:	2023-08-17	Revised by:	CW	Checked by:	RC
A - Issued for Review					
Date:		Revised by:		Checked by:	
Date:		Revised by:		Checked by:	

PREPARED BY

**Summit Carbon Solutions**  
2321 North Loop Drive, Suite 221  
Ames, Iowa 50010  
United States of America  
[www.summitcarbonsolutions.com](http://www.summitcarbonsolutions.com)




**SUMMIT CARBON**  
SOLUTIONS

PROJECT INFORMATION

Figure Title: <b>ND PSC - Aerial Map Book - NDT-211</b>	
Figure Number: <b>Map Book 1</b>	
Scale: <b>1 : 12,000</b> 1 inch equals 1,000 feet	Projection: <b>Transverse Mercator</b> NAD 1983 UTM Zone 14N
Sheet: <b>93</b> 93 of 139	Drawing Number: <b>1001-01-003</b> Revision A



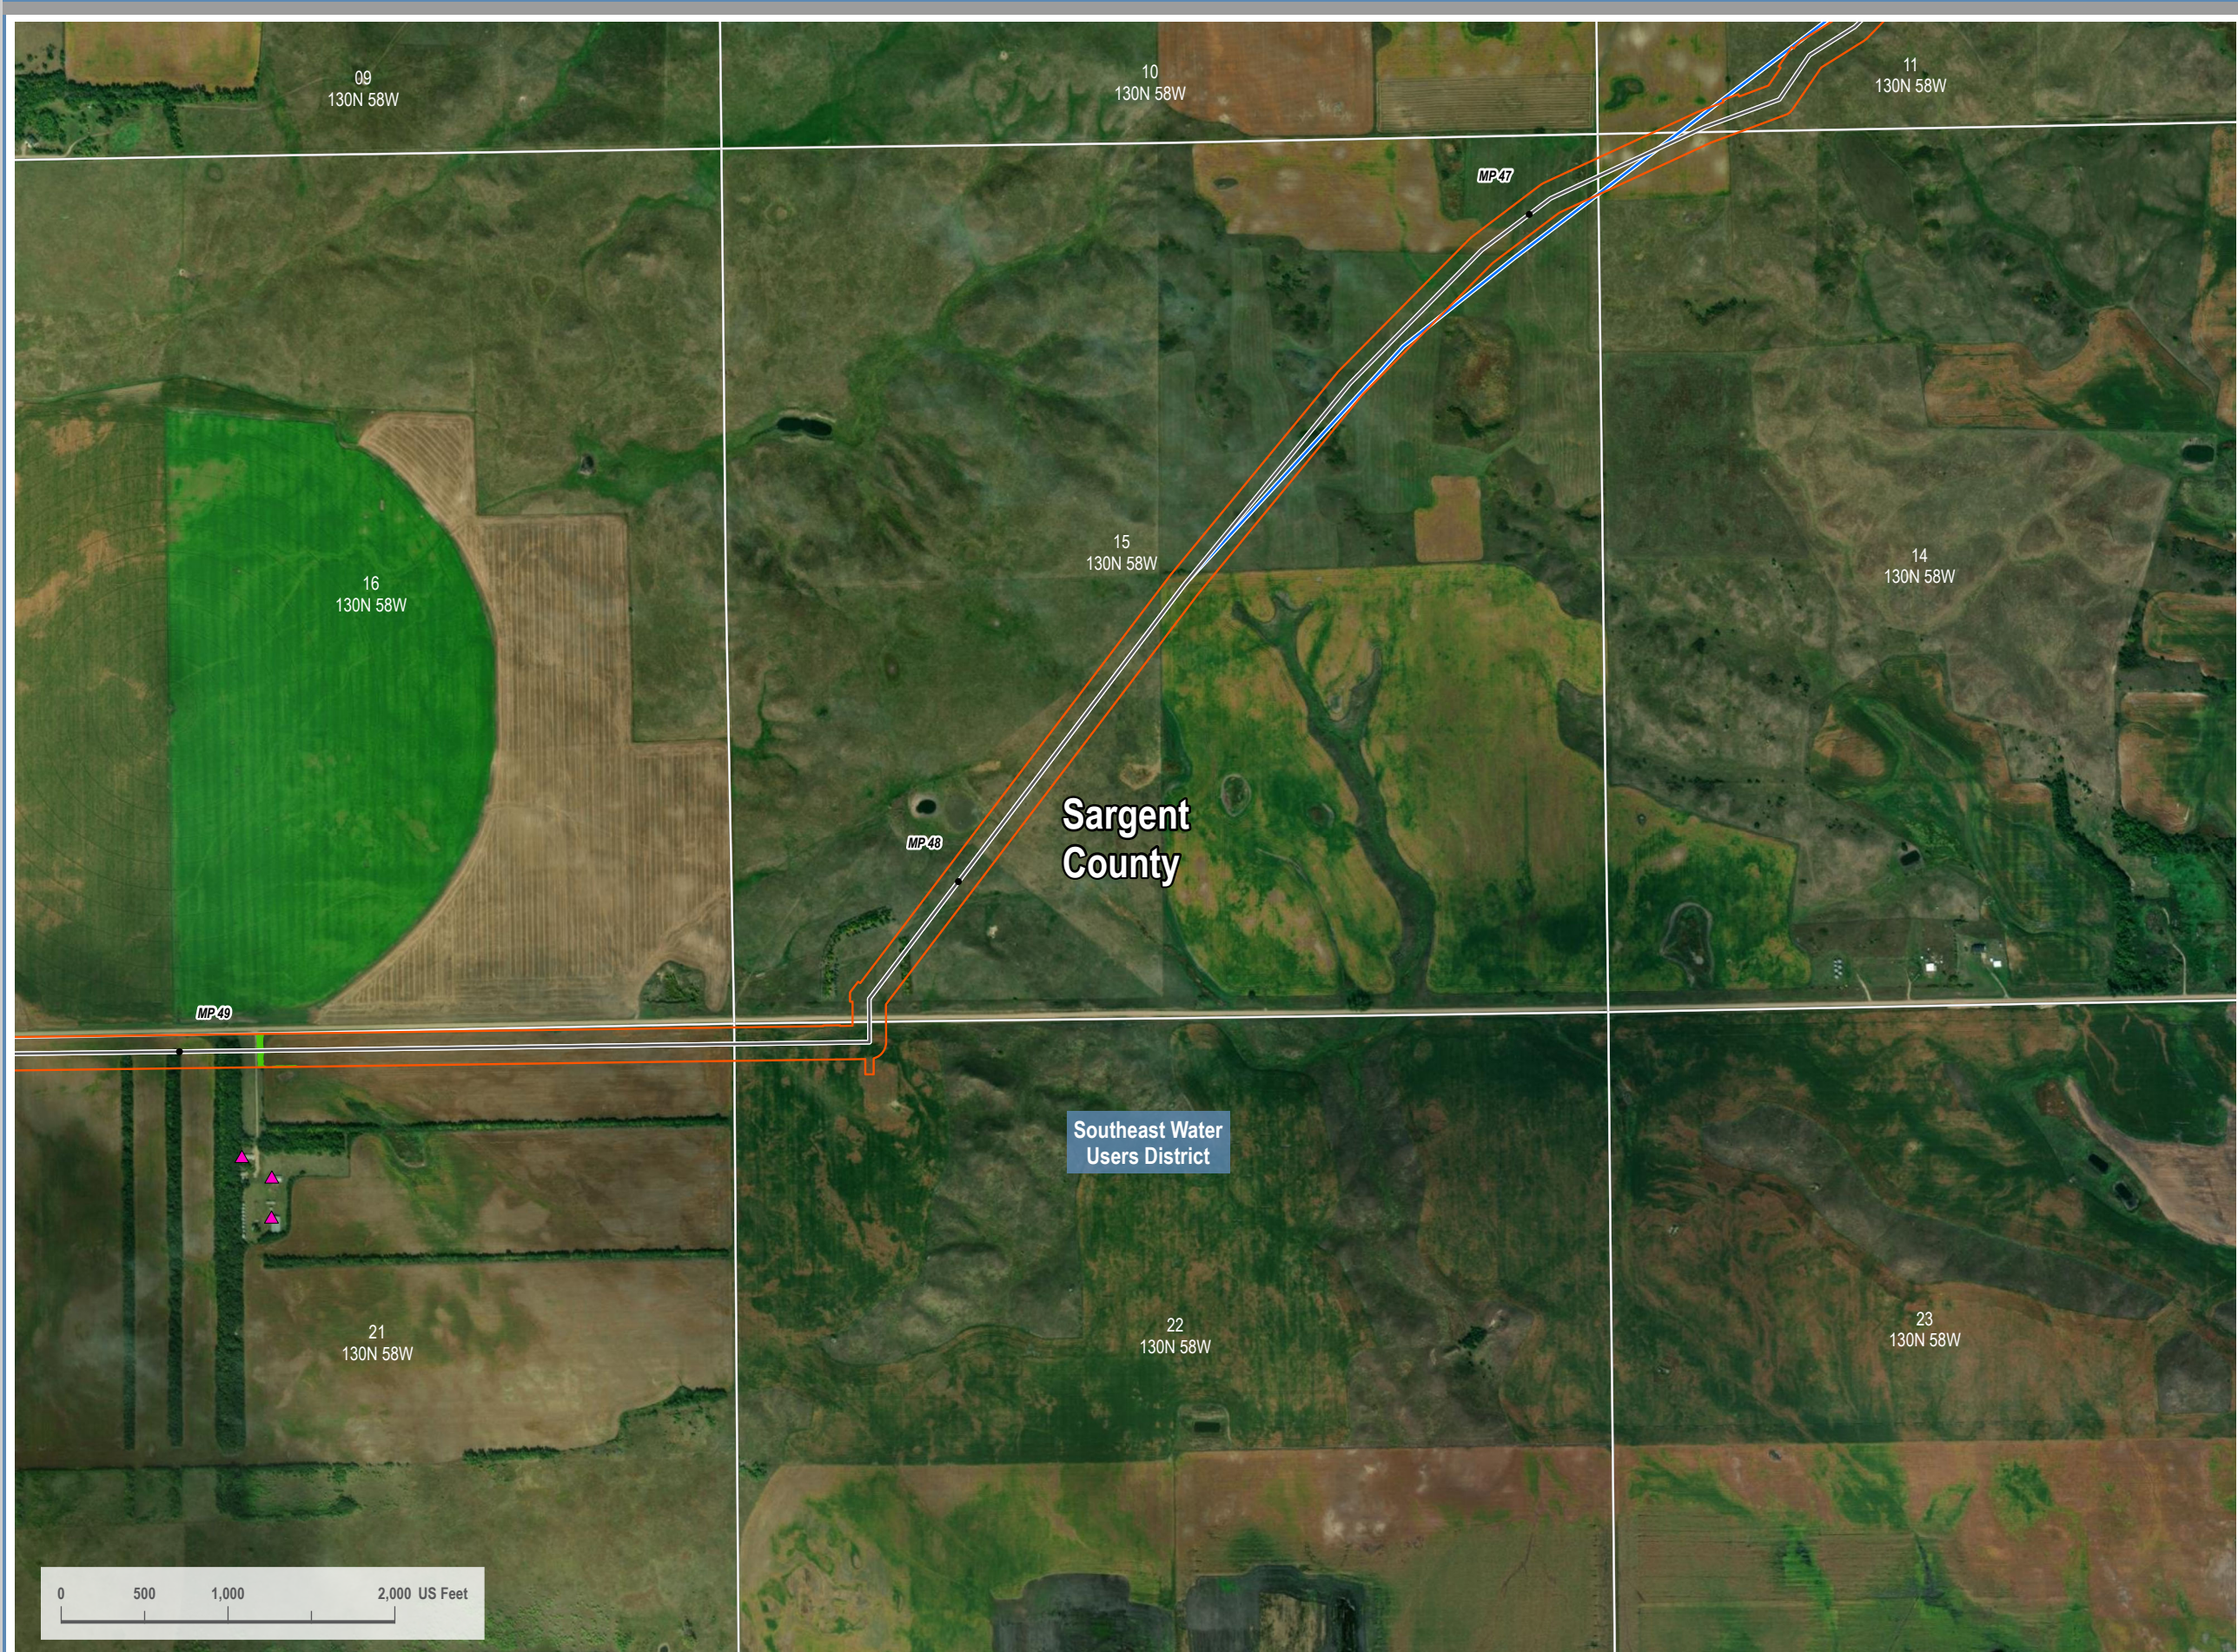


 



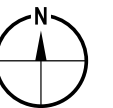


## VICINITY MAP



### LEGEND

-  Centerline Mileposts
  PEM Wetland
-  Domestic Structure or Business (Avoidance)
  200-foot Siltng Corridor
-  Updated Proposed Project Route 08/15/2023
-  October 17, 2023 Original PSC Application Route
-  Section Line



## REVISIONS

Date: 2023-08-17      Revised by: CW      Checked by: RC

**A - Issued for Review**

Date: \_\_\_\_\_ Revised by: \_\_\_\_\_ Checked by: \_\_\_\_\_

Date: \_\_\_\_\_ Revised by: \_\_\_\_\_ Checked by: \_\_\_\_\_

PREPARED BY

**Summit Carbon Solutions**

2321 North Loop Drive, Suite 221  
Ames, Iowa 50010  
United States of America



**SUMMIT CARBON**  
SOLUTIONS

[www.summitcarbonsolutions.com](http://www.summitcarbonsolutions.com)



## PROJECT INFORMATION

Figure Title:

ND PSC - Aerial Map Book - NDT-211

Figure Number: **Map Book 1**

**Scale:**  
**1 : 12,000**  
1 inch equals 1,000 feet

**Projection:**  
**Transverse Mercator**  
NAD 1983 UTM Zone 14N

Sheet:	Drawing Number:
94	1001-01-003
94 of 139	Revision A





VICINITY MAP



LEGEND

- Centerline Mileposts
- Domestic Structure or Business (Avoidance)
- Updated Proposed Project Route 08/15/2023
- October 17, 2023 Original PSC Application Route
- Section Line
- Avoidance Area
- PEM Wetland
- 200-foot Siting Corridor
- Resource Management Area



REVISIONS

Date:	2023-08-17	Revised by:	CW	Checked by:	RC
A - Issued for Review					
Date:		Revised by:		Checked by:	
Date:		Revised by:		Checked by:	

PREPARED BY

**Summit Carbon Solutions**  
2321 North Loop Drive, Suite 221  
Ames, Iowa 50010  
United States of America  
[www.summitcarbonsolutions.com](http://www.summitcarbonsolutions.com)



**SUMMIT CARBON**  
SOLUTIONS

PROJECT INFORMATION

Figure Title: <b>ND PSC - Aerial Map Book - NDT-211</b>	
Figure Number: <b>Map Book 1</b>	
Scale: <b>1 : 12,000</b> 1 inch equals 1,000 feet	Projection: <b>Transverse Mercator</b> NAD 1983 UTM Zone 14N
Sheet: <b>95</b> 95 of 139	Drawing Number: <b>1001-01-003</b> Revision A





VICINITY MAP



LEGEND

- Centerline Mileposts
- Water Well (Avoidance)
- Domestic Structure or Business (Avoidance)
- Updated Proposed Project Route 08/15/2023
- October 17, 2023 Original PSC Application Route
- Section Line
- Open Water
- PEM Wetland
- 200-foot Stiling Corridor



REVISIONS

Date: 2023-08-17 Revised by: CW Checked by: RC  
A - Issued for Review

Date: Revised by: Checked by:

Date: Revised by: Checked by:

PREPARED BY

**Summit Carbon Solutions**  
2321 North Loop Drive, Suite 221  
Ames, Iowa 50010  
United States of America  
[www.summitcarbonsolutions.com](http://www.summitcarbonsolutions.com)



PROJECT INFORMATION

Figure Title:  
ND PSC - Aerial Map Book - NDT-211

Figure Number:  
Map Book 1


Scale:  
1 : 12,000  
1 inch equals 1,000 feet

Projection:  
Transverse Mercator  
NAD 1983 UTM Zone 14N

Sheet:  
96  
96 of 139

Drawing Number:  
1001-01-003  
Revision A



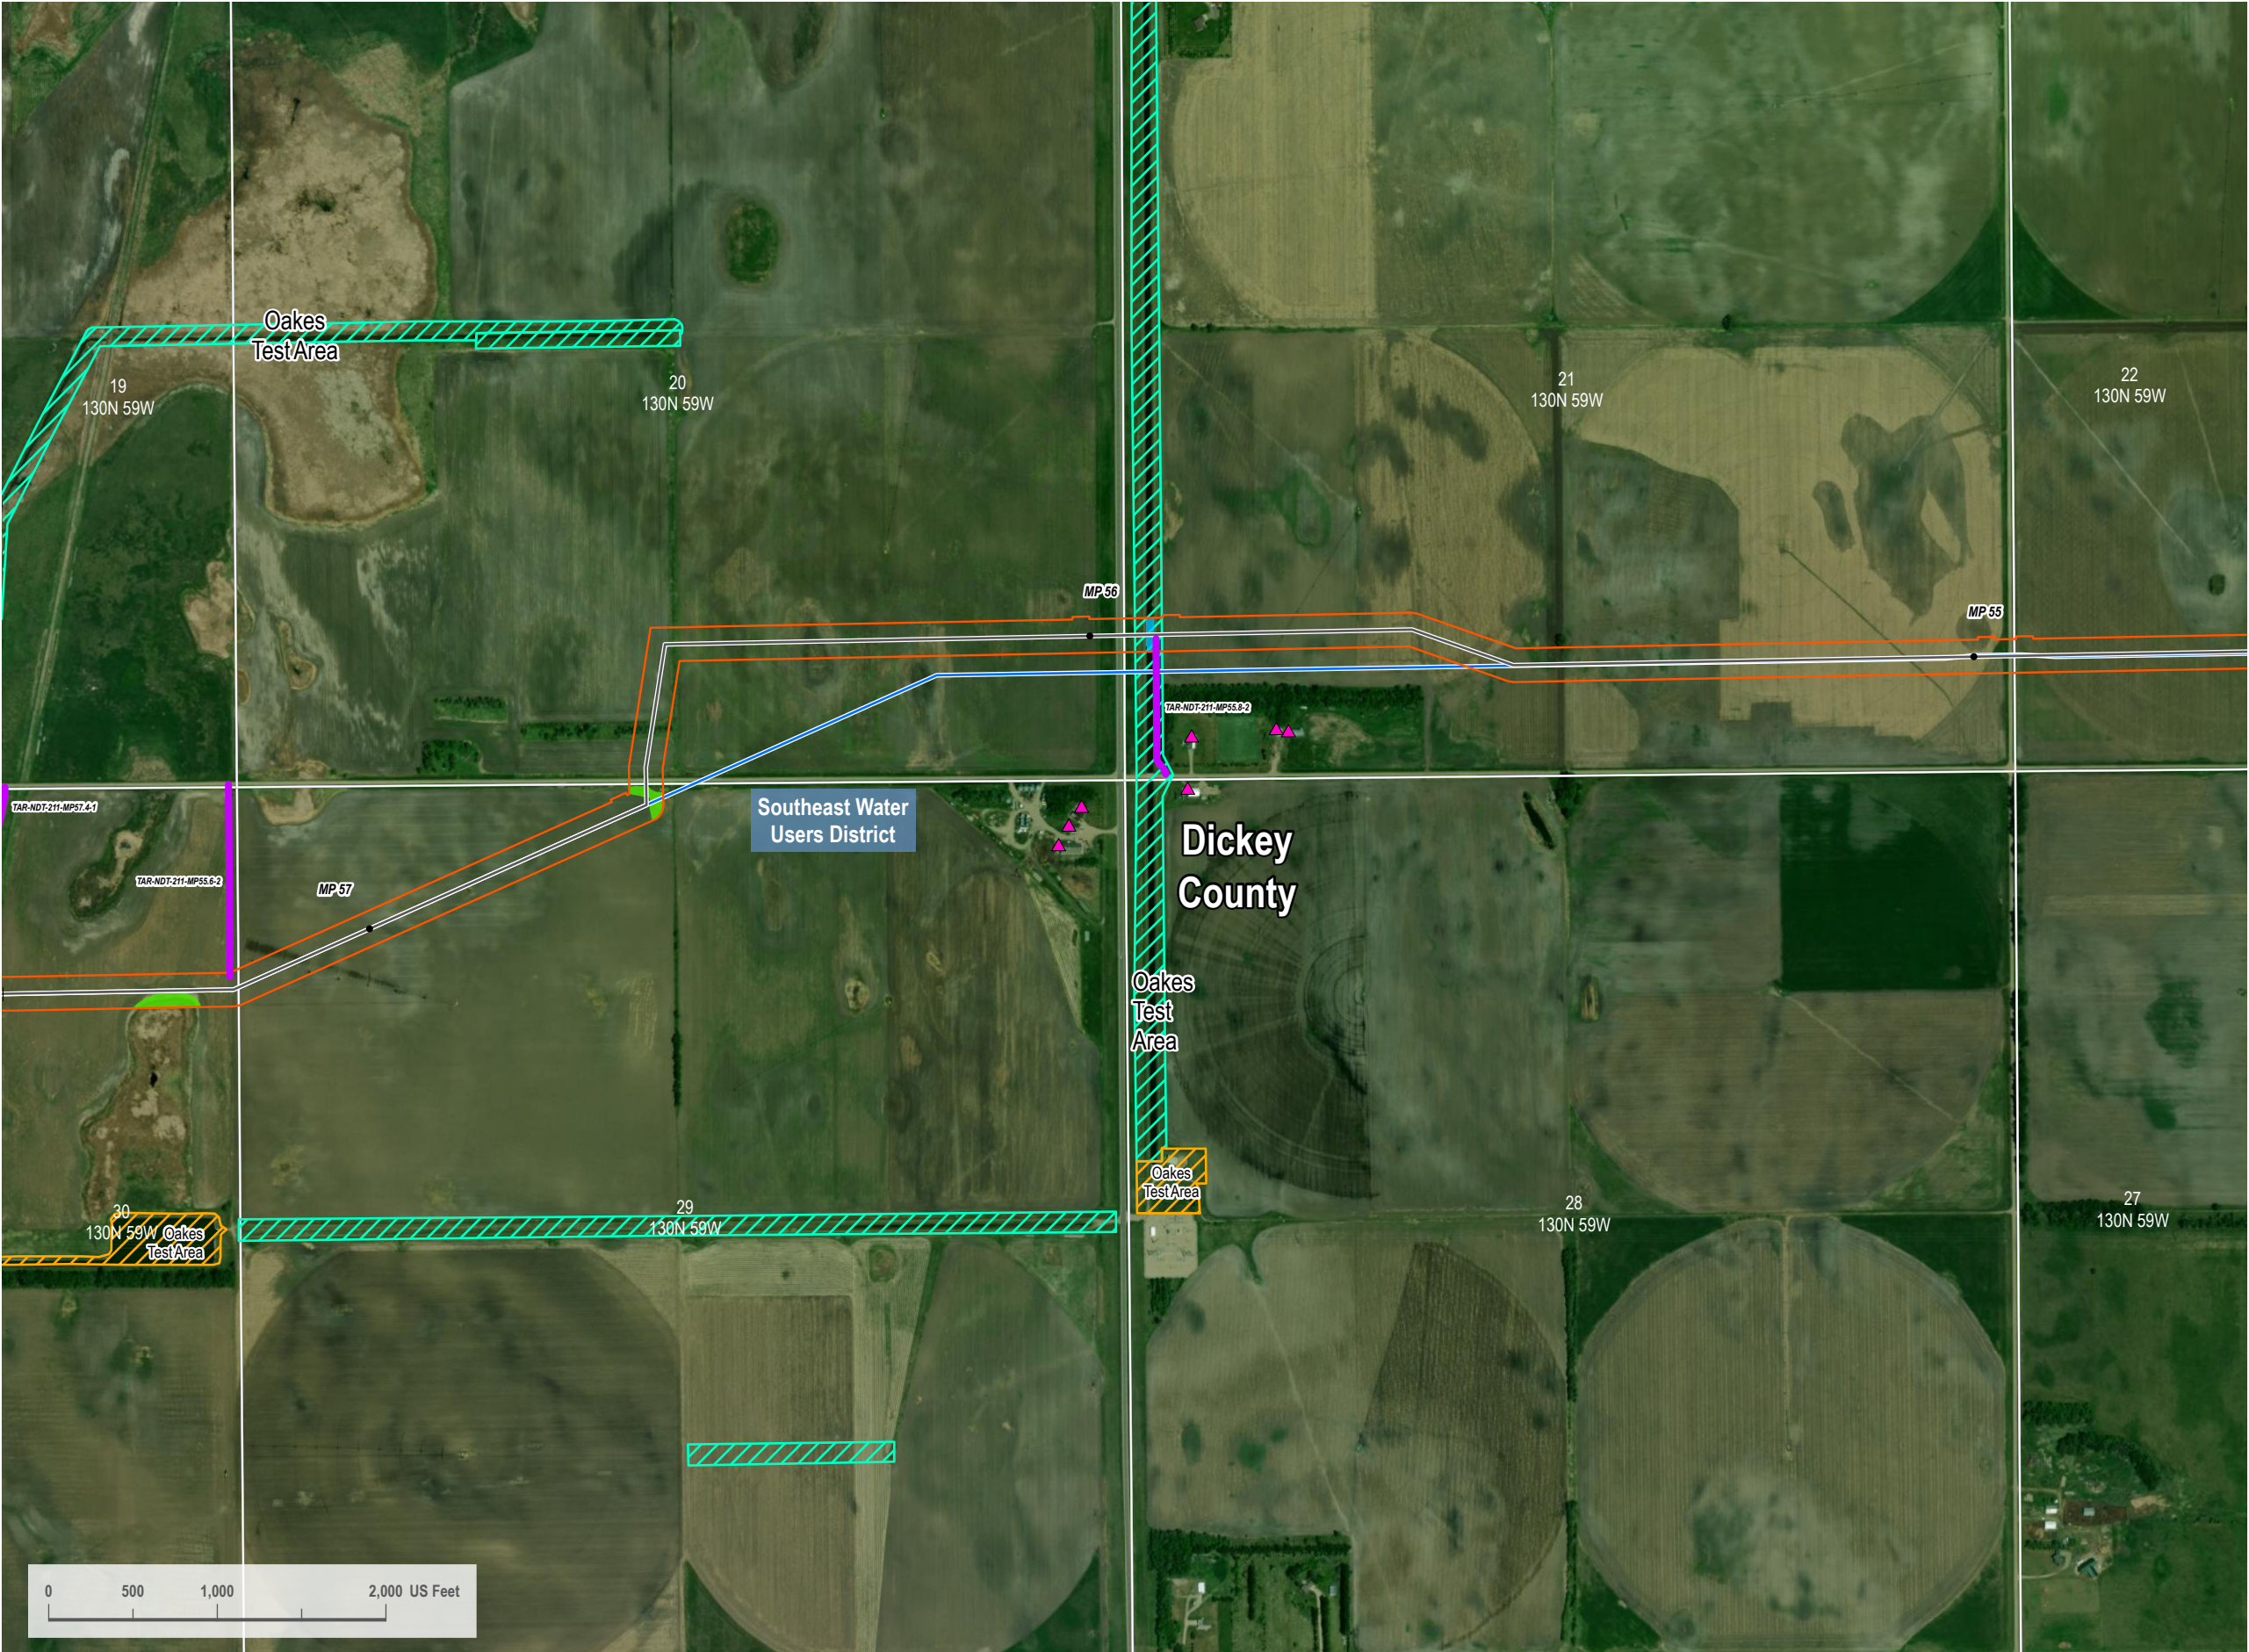

VICINITY MAP



LEGEND

- |   |                          |
|---|--------------------------|
| HDD Entry/Exit                                  | Avoidance Area           |
| Centerline Mileposts                            | PEM Wetland              |
| Domestic Structure or Business (Avoidance)      | Stream                   |
| Updated Proposed Project Route 08/15/2023       | 200-foot Siting Corridor |
| October 17, 2023 Original PSC Application Route | Reclamation Land         |
| Section Line                                    | Access Road              |



REVISIONS

Date:	2023-08-17	Revised by:	CW	Checked by:	RC
A - Issued for Review					
Date:		Revised by:		Checked by:	
Date:		Revised by:		Checked by:	

PREPARED BY

**Summit Carbon Solutions**  
2321 North Loop Drive, Suite 221  
Ames, Iowa 50010  
United States of America  
[www.summitcarbonsolutions.com](http://www.summitcarbonsolutions.com)

PROJECT INFORMATION

Figure Title: <b>ND PSC - Aerial Map Book - NDT-211</b>	
Figure Number: <b>Map Book 1</b>	
Scale: <b>1 : 12,000</b> 1 inch equals 1,000 feet	Projection: <b>Transverse Mercator</b> NAD 1983 UTM Zone 14N
Sheet: <b>97</b> <small>97 of 139</small>	Drawing Number: <b>1001-01-003</b> Revision A





VICINITY MAP



LEGEND

- |   |                          |
|---|--------------------------|
| HDD Entry/Exit                                  | Avoidance Area           |
| Centerline Mileposts                            | PEM Wetland              |
| Mainline Valve Location                         | Stream                   |
| Domestic Structure or Business (Avoidance)      | 200-foot Siting Corridor |
| Updated Proposed Project Route 08/15/2023       | Conservation Easement    |
| October 17, 2023 Original PSC Application Route | Reclamation Land         |
| Section Line                                    | Resource Management Area |
| Access Road                                     |                          |



REVISIONS

Date:	2023-08-17	Revised by:	CW	Checked by:	RC
A - Issued for Review					
Date:		Revised by:		Checked by:	
Date:		Revised by:		Checked by:	


PREPARED BY

**Summit Carbon Solutions**  
2321 North Loop Drive, Suite 221  
Ames, Iowa 50010  
United States of America  
[www.summitcarbonsolutions.com](http://www.summitcarbonsolutions.com)

PROJECT INFORMATION

Figure Title: <b>ND PSC - Aerial Map Book - NDT-211</b>	
Figure Number: <b>Map Book 1</b>	
Scale: <b>1 : 12,000</b> 1 inch equals 1,000 feet	Projection: <b>Transverse Mercator</b> NAD 1983 UTM Zone 14N
Sheet: <b>98</b> 98 of 139	Drawing Number: <b>1001-01-003</b> Revision A



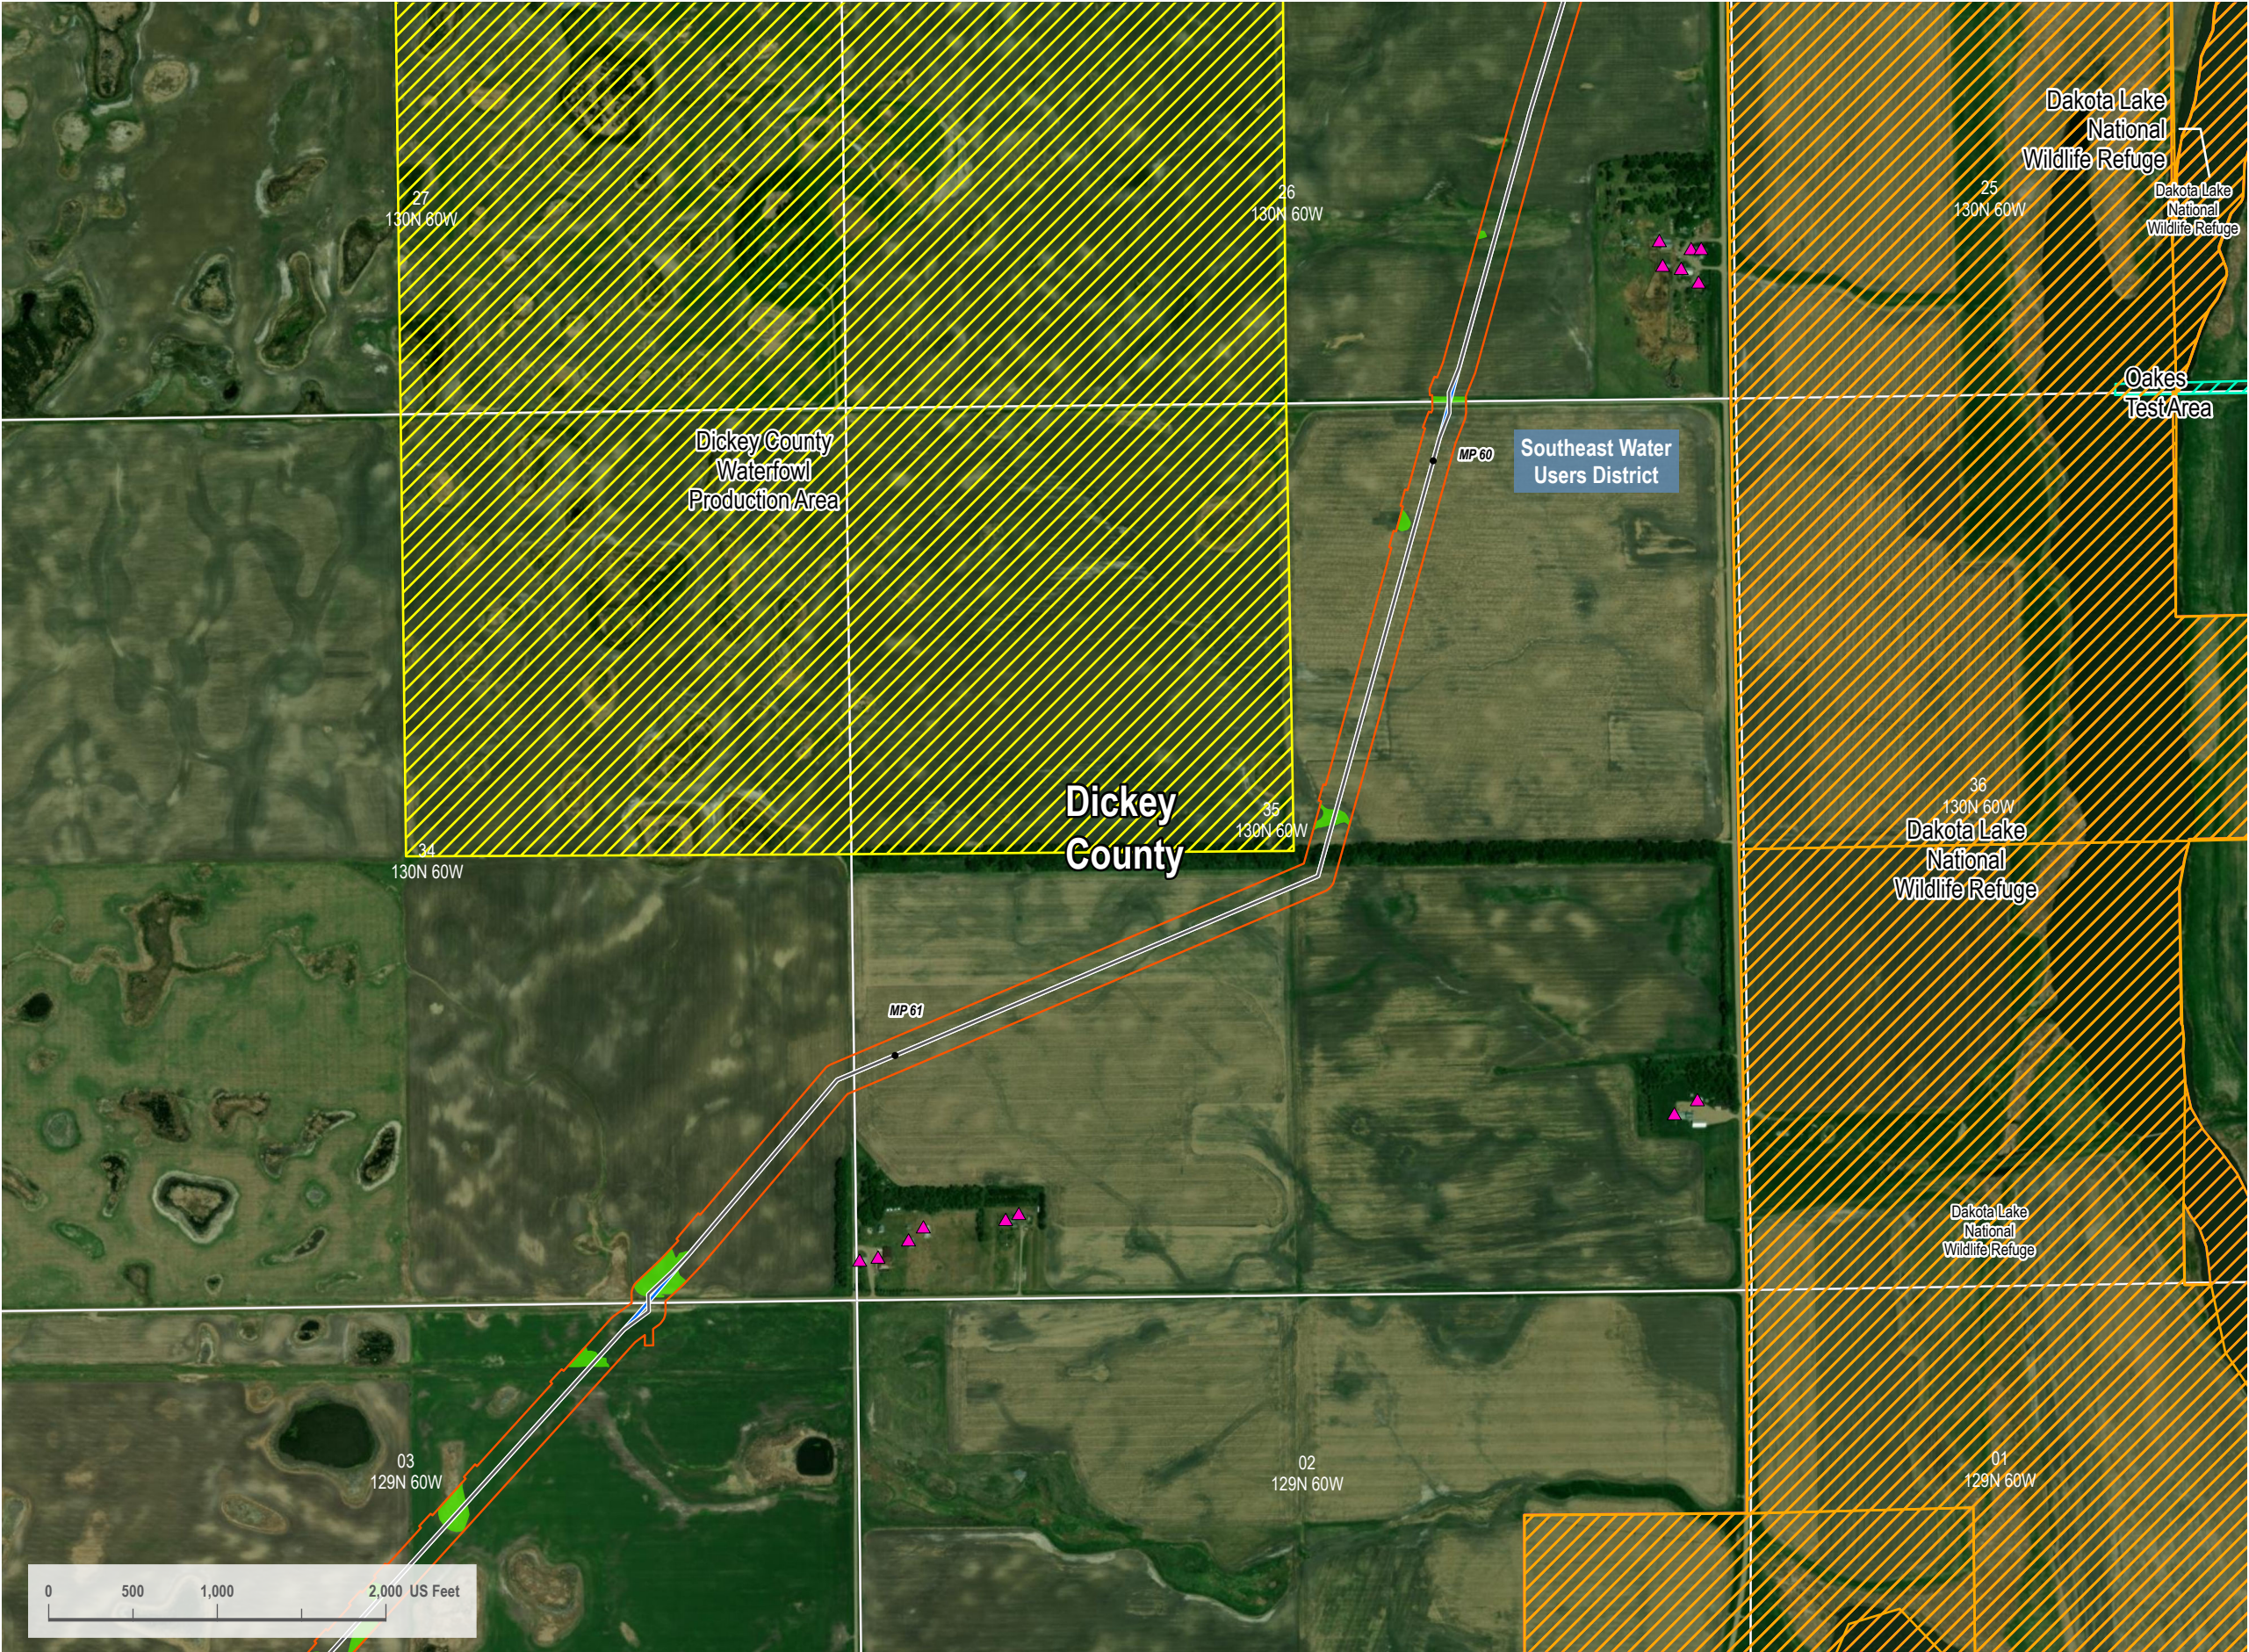

VICINITY MAP



LEGEND

- Centerline Mileposts
- Domestic Structure or Business (Avoidance)
- Updated Proposed Project Route 08/15/2023
- October 17, 2023 Original PSC Application Route
- Section Line
- Avoidance Area
- PEM Wetland
- 200-foot Siting Corridor
- Conservation Easement
- Reclamation Land
- Resource Management Area



REVISIONS

Date:	2023-08-17	Revised by:	CW	Checked by:	RC
A - Issued for Review					
Date:		Revised by:		Checked by:	
Date:		Revised by:		Checked by:	

PREPARED BY

**Summit Carbon Solutions**  
2321 North Loop Drive, Suite 221  
Ames, Iowa 50010  
United States of America  
[www.summitcarbonsolutions.com](http://www.summitcarbonsolutions.com)

PROJECT INFORMATION

Figure Title: <b>ND PSC - Aerial Map Book - NDT-211</b>	
Figure Number: <b>Map Book 1</b>	
Scale: <b>1 : 12,000</b> 1 inch equals 1,000 feet	Projection: <b>Transverse Mercator</b> NAD 1983 UTM Zone 14N
Sheet: <b>99</b> 99 of 139	Drawing Number: <b>1001-01-003</b> Revision A





VICINITY MAP



LEGEND

- Centerline Mileposts
- Domestic Structure or Business (Avoidance)
- Updated Proposed Project Route 08/15/2023
- October 17, 2023 Original PSC Application Route
- Section Line
- PEM Wetland
- 200-foot Siting Corridor
- Resource Management Area



REVISIONS

Date:	2023-08-17	Revised by:	CW	Checked by:	RC
A - Issued for Review					
Date:		Revised by:		Checked by:	
Date:		Revised by:		Checked by:	

PREPARED BY

**Summit Carbon Solutions**  
2321 North Loop Drive, Suite 221  
Ames, Iowa 50010  
United States of America  
[www.summitcarbonsolutions.com](http://www.summitcarbonsolutions.com)




**SUMMIT CARBON**  
SOLUTIONS

PROJECT INFORMATION

Figure Title: <b>ND PSC - Aerial Map Book - NDT-211</b>	
Figure Number: <b>Map Book 1</b>	
Scale: <b>1 : 12,000</b> 1 inch equals 1,000 feet	Projection: <b>Transverse Mercator</b> NAD 1983 UTM Zone 14N
Sheet: <b>100</b> 100 of 139	Drawing Number: <b>1001-01-003</b> Revision A



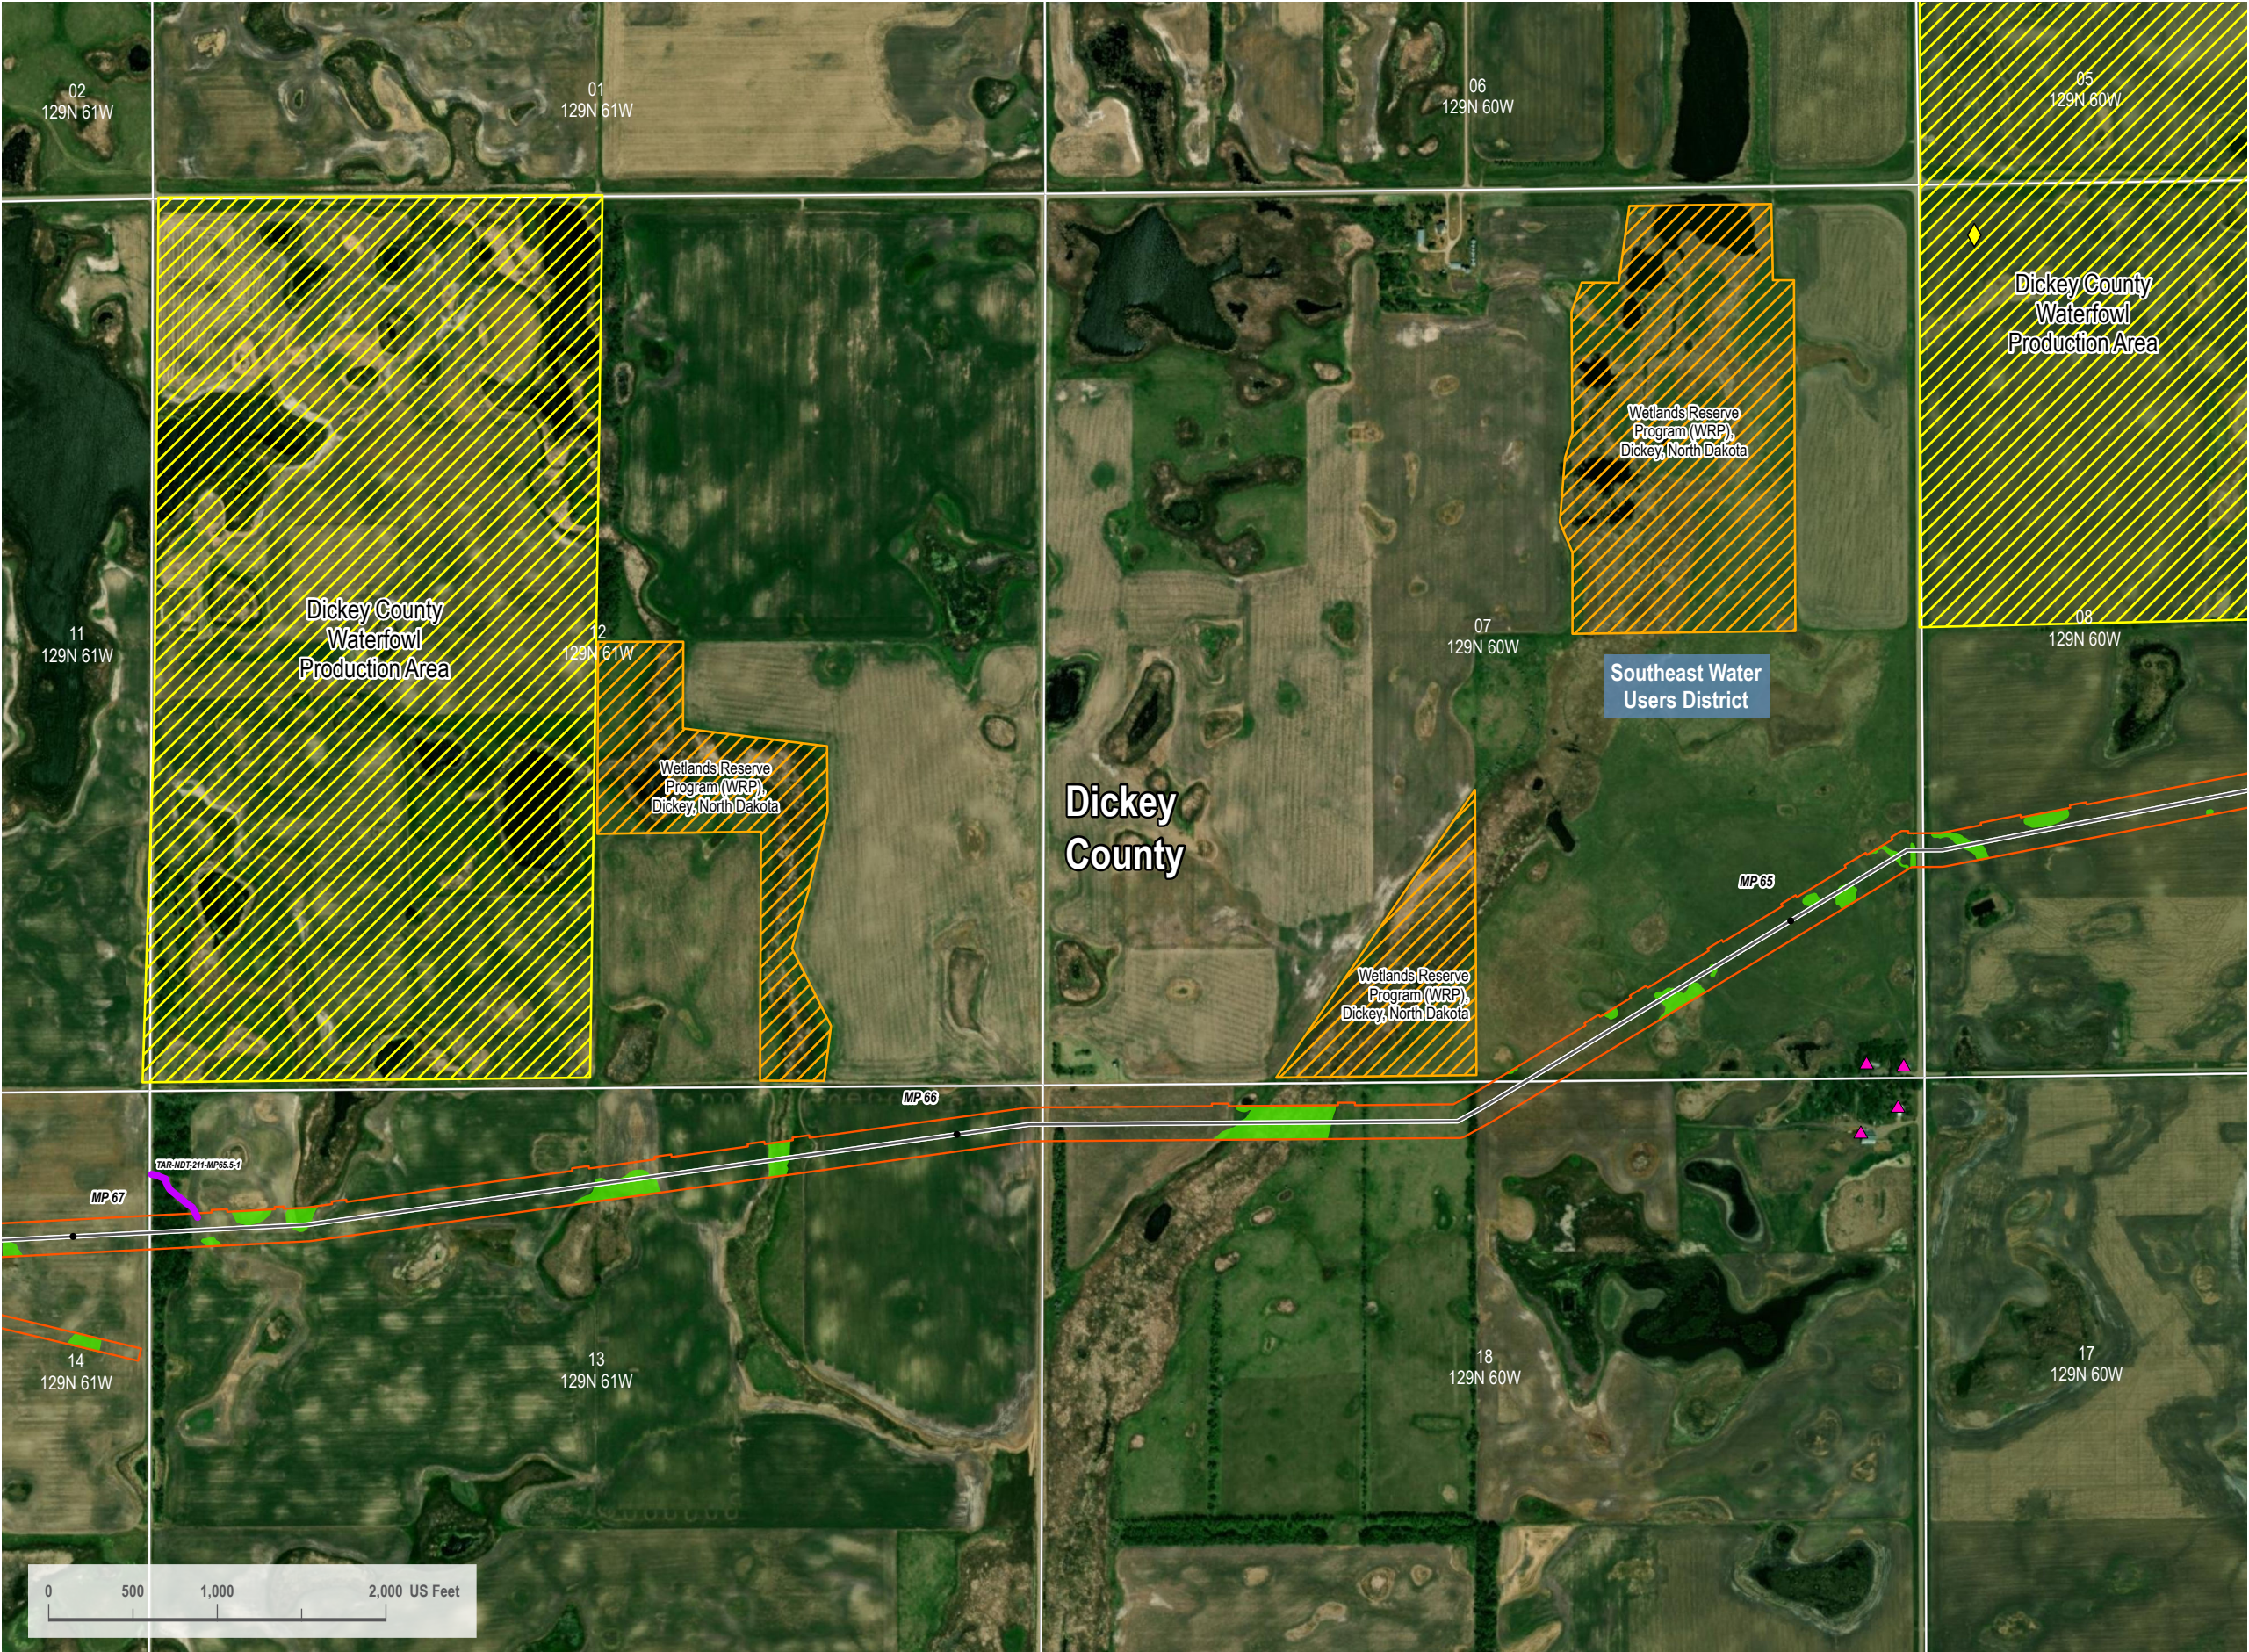

VICINITY MAP

North Dakota

South Dakota

LEGEND

Centerline Mileposts	Avoidance Area
Water Well (Avoidance)	PEM Wetland
Domestic Structure or Business (Avoidance)	200-foot Siting Corridor
Updated Proposed Project Route 08/15/2023	Resource Management Area
October 17, 2023 Original PSC Application Route	
Section Line	
Access Road	

REVISIONS

Date: 2023-08-17	Revised by: CW	Checked by: RC
A - Issued for Review		
Date:	Revised by:	Checked by:
Date:	Revised by:	Checked by:

PREPARED BY

Summit Carbon Solutions

2321 North Loop Drive, Suite 221  
Ames, Iowa 50010  
United States of America  
[www.summitcarbonsolutions.com](http://www.summitcarbonsolutions.com)

PROJECT INFORMATION

Figure Title:

ND PSC - Aerial Map Book - NDT-211

Figure Number:

Map Book 1

Scale:	Projection:
1 : 12,000	Transverse Mercator
1 inch equals 1,000 feet	NAD 1983 UTM Zone 14N
Sheet:	Drawing Number:
101	1001-01-003
101 of 139	Revision A






VICINITY MAP



LEGEND

- HDD Entry/Exit
- Centerline Mileposts
- Domestic Structure or Business (Avoidance)
- Updated Proposed Project Route 08/15/2023
- October 17, 2023 Original PSC Application Route
- Section Line
- Access Road
- Avoidance Area
- PEM Wetland
- 200-foot Siting Corridor
- Resource Management Area

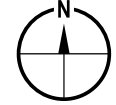

REVISIONS

Date: 2023-08-17	Revised by: CW	Checked by: RC
A - Issued for Review		
Date:	Revised by:	Checked by:
Date:	Revised by:	Checked by:

PREPARED BY

**Summit Carbon Solutions**  
2321 North Loop Drive, Suite 221  
Ames, Iowa 50010  
United States of America  
[www.summitcarbonsolutions.com](http://www.summitcarbonsolutions.com)




**SUMMIT CARBON**  
SOLUTIONS

PROJECT INFORMATION

Figure Title: <b>ND PSC - Aerial Map Book - NDT-211</b>	
Figure Number: <b>Map Book 1</b>	
Scale: <b>1 : 12,000</b> 1 inch equals 1,000 feet	Projection: <b>Transverse Mercator</b> NAD 1983 UTM Zone 14N
Sheet: <b>102</b> 102 of 139	Drawing Number: <b>1001-01-003</b> Revision A



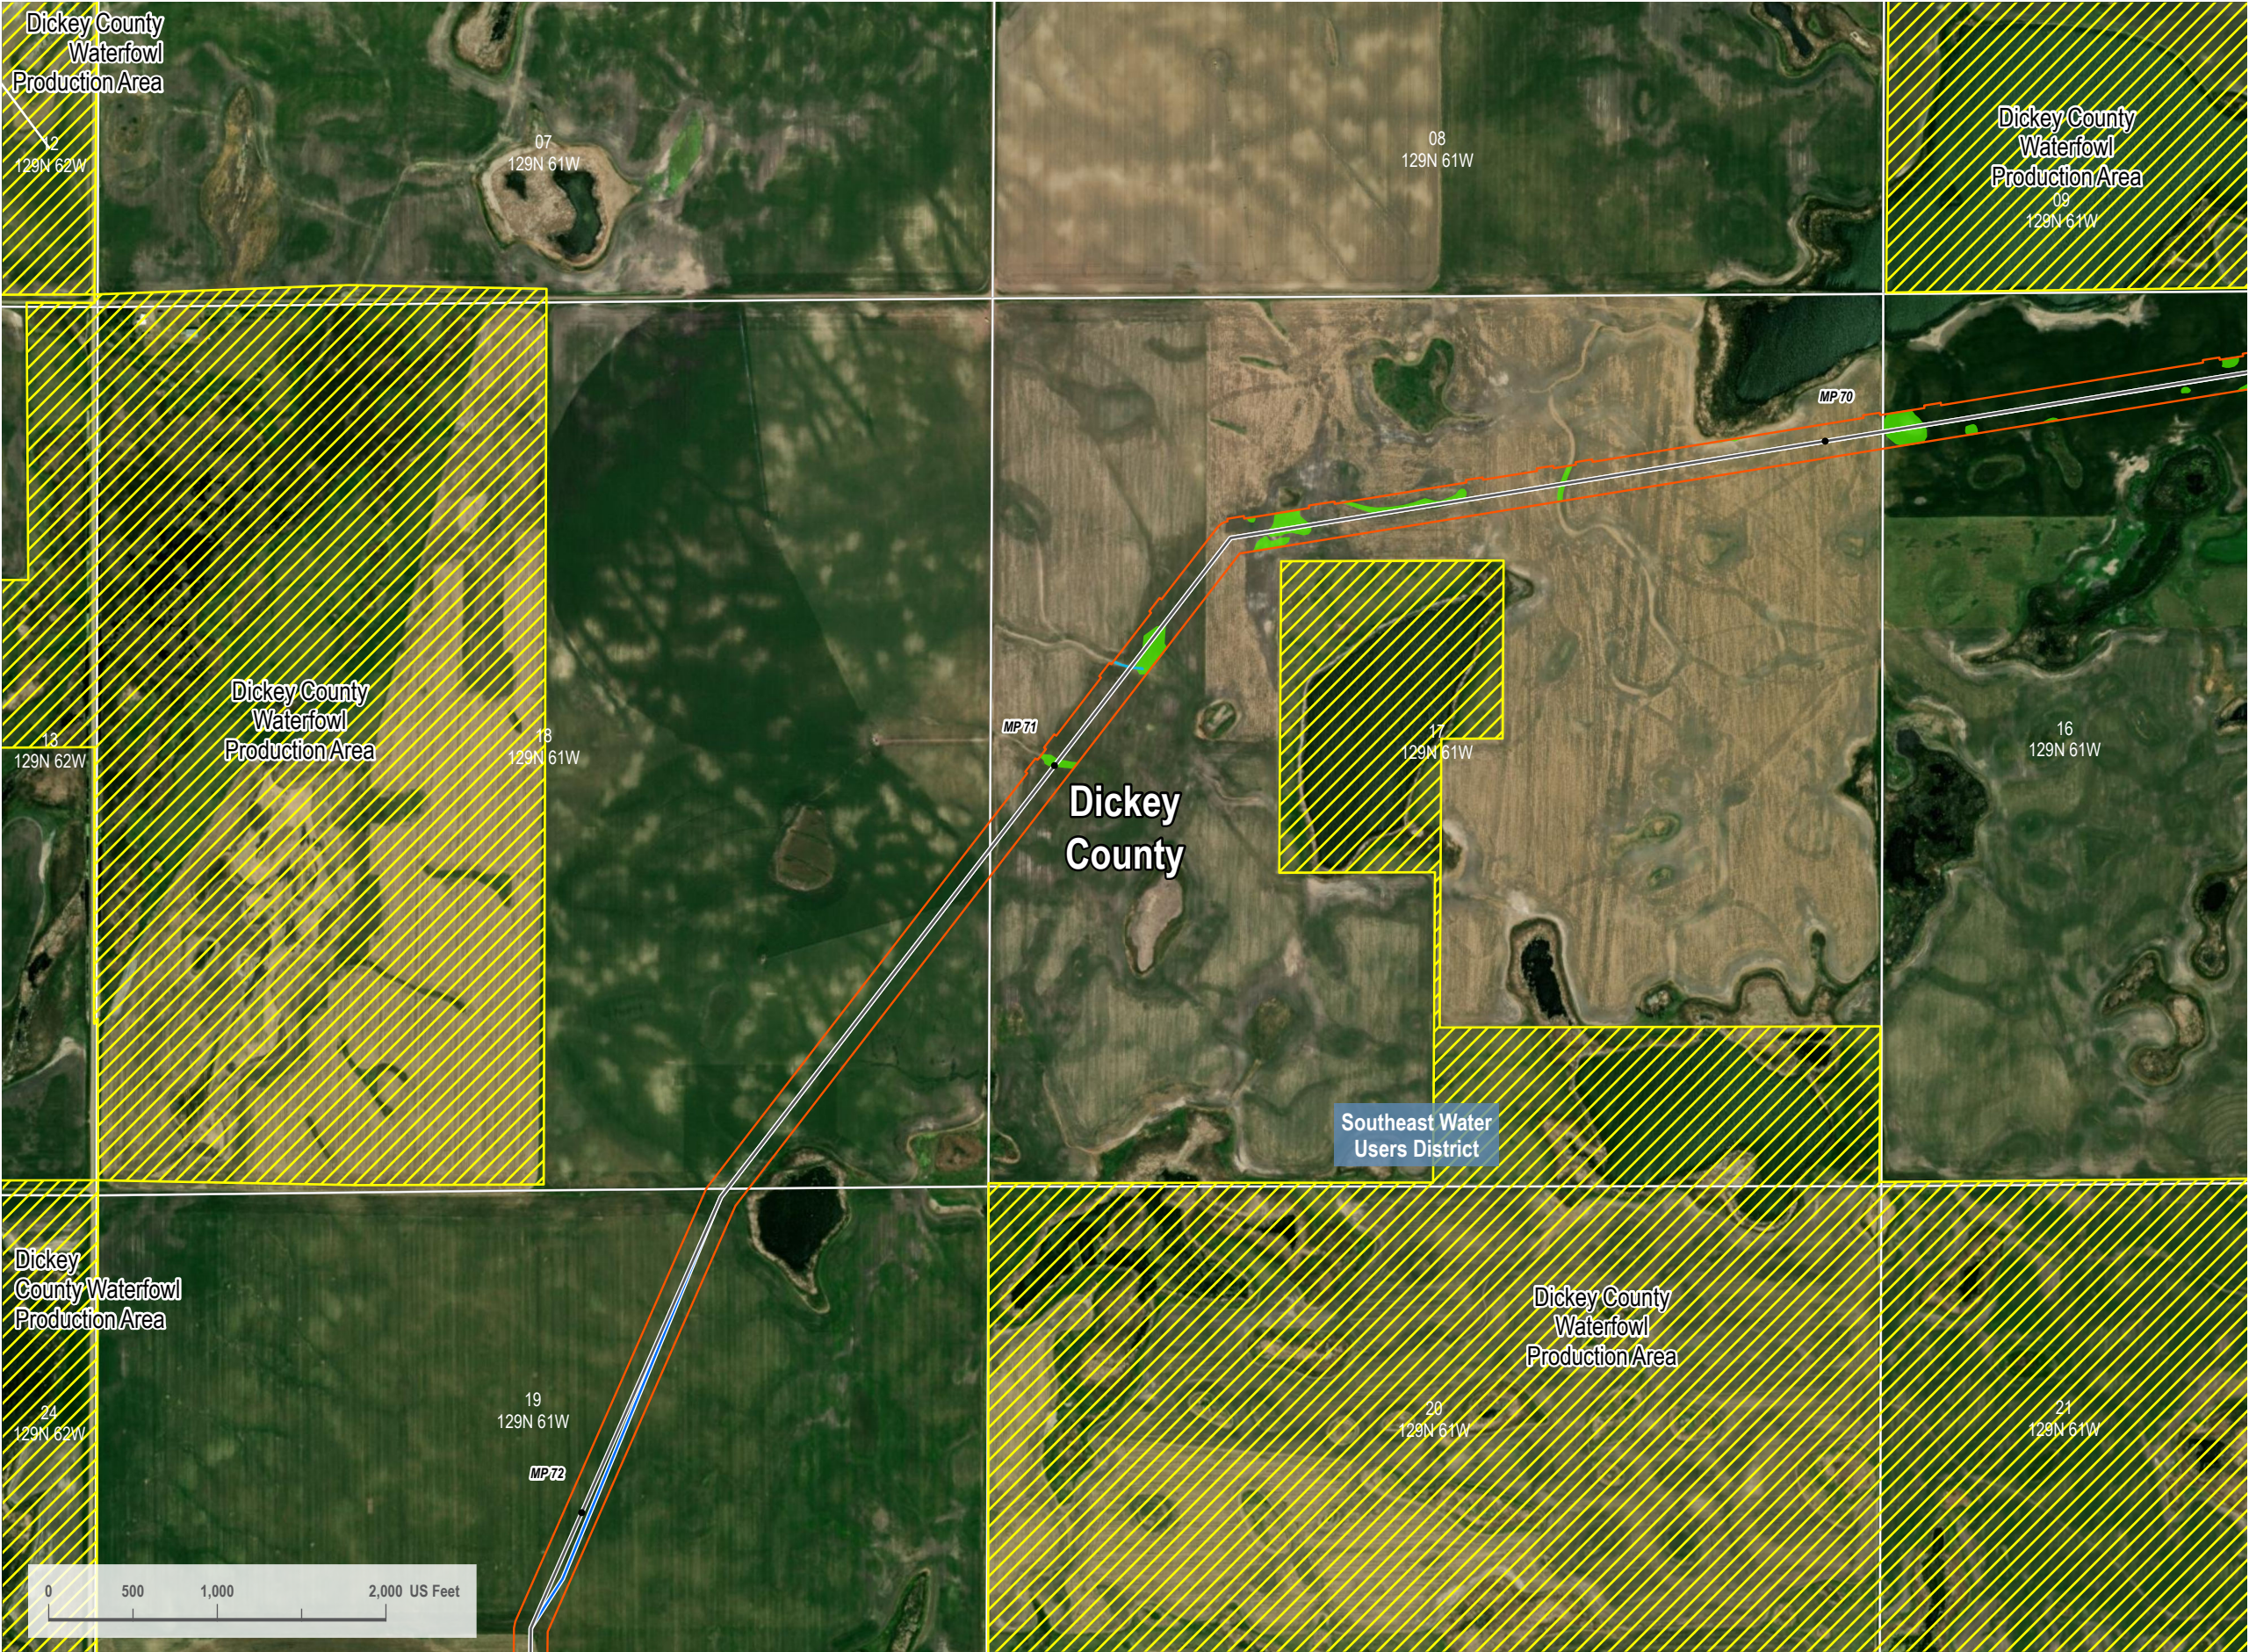


VICINITY MAP



LEGEND

- Centerline Mileposts
- Updated Proposed Project Route 08/15/2023
- October 17, 2023 Original PSC Application Route
- Section Line
- PEM Wetland
- Stream
- 200-foot Siting Corridor
- Resource Management Area

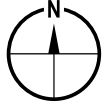

REVISIONS

Date:	2023-08-17	Revised by:	CW	Checked by:	RC
A - Issued for Review					
Date:		Revised by:		Checked by:	
Date:		Revised by:		Checked by:	

PREPARED BY

**Summit Carbon Solutions**  
2321 North Loop Drive, Suite 221  
Ames, Iowa 50010  
United States of America  
[www.summitcarbonsolutions.com](http://www.summitcarbonsolutions.com)



**SUMMIT CARBON**  
SOLUTIONS

PROJECT INFORMATION

Figure Title: <b>ND PSC - Aerial Map Book - NDT-211</b>	
Figure Number: <b>Map Book 1</b>	
Scale: <b>1 : 12,000</b> 1 inch equals 1,000 feet	Projection: <b>Transverse Mercator</b> NAD 1983 UTM Zone 14N
Sheet: <b>103</b> 103 of 139	Drawing Number: <b>1001-01-003</b> Revision A





VICINITY MAP



LEGEND

- Centerline Mileposts
- Domestic Structure or Business (Avoidance)
- Updated Proposed Project Route 08/15/2023
- October 17, 2023 Original PSC Application Route
- Section Line
- PEM Wetland
- 200-foot Siting Corridor
- Resource Management Area



REVISIONS

Date: 2023-08-17	Revised by: CW	Checked by: RC
A - Issued for Review		
Date:	Revised by:	Checked by:
Date:	Revised by:	Checked by:

PREPARED BY

**Summit Carbon Solutions**  
2321 North Loop Drive, Suite 221  
Ames, Iowa 50010  
United States of America  
[www.summitcarbonsolutions.com](http://www.summitcarbonsolutions.com)




**SUMMIT CARBON**  
SOLUTIONS

PROJECT INFORMATION

Figure Title: <b>ND PSC - Aerial Map Book - NDT-211</b>	
Figure Number: <b>Map Book 1</b>	
Scale: <b>1 : 12,000</b> 1 inch equals 1,000 feet	Projection: <b>Transverse Mercator</b> NAD 1983 UTM Zone 14N
Sheet: <b>104</b> 104 of 139	Drawing Number: <b>1001-01-003</b> Revision A



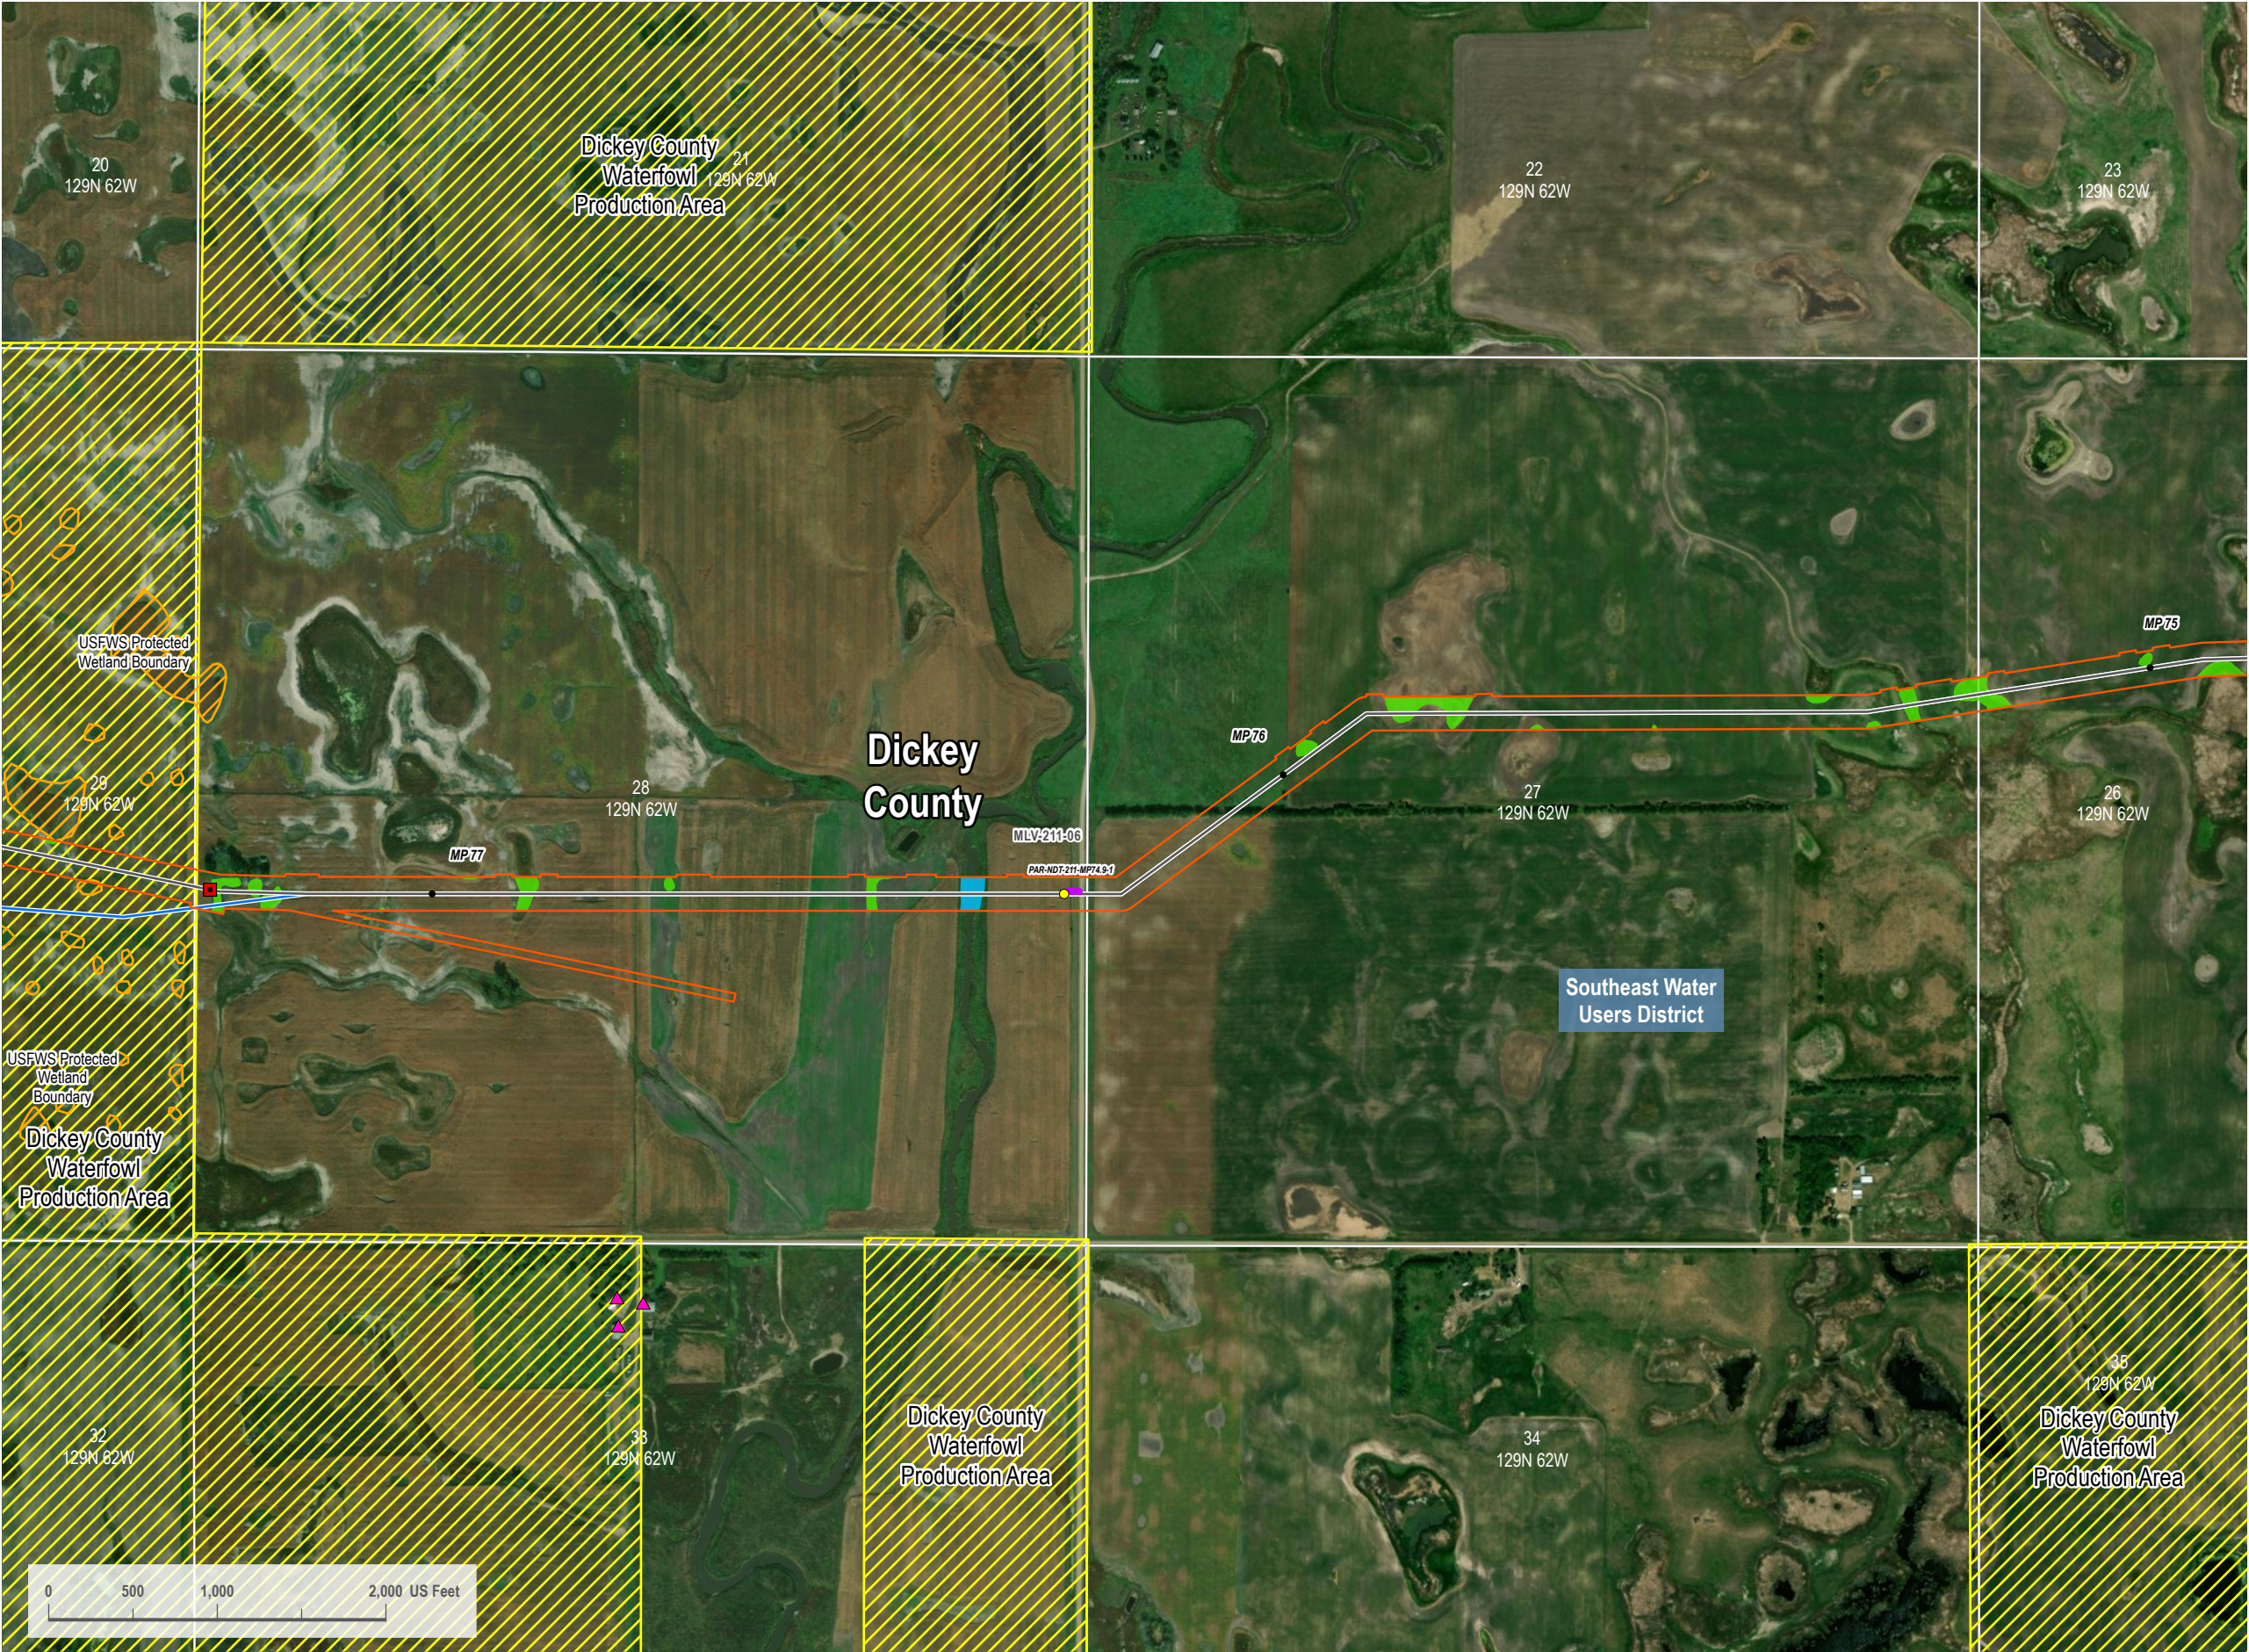

VICINITY MAP



LEGEND

- |   |                          |
|---|--------------------------|
| HDD Entry/Exit                                  | Avoidance Area           |
| Centerline Mileposts                            | PEM Wetland              |
| Mainline Valve Location                         | Stream                   |
| Domestic Structure or Business (Avoidance)      | 200-foot Siting Corridor |
| Updated Proposed Project Route 08/15/2023       | Resource Management Area |
| October 17, 2023 Original PSC Application Route |                          |
| Section Line                                    |                          |
| Access Road                                     |                          |



REVISIONS

Date:	2023-08-17	Revised by:	CW	Checked by:	RC
A - Issued for Review					
Date:		Revised by:		Checked by:	
Date:		Revised by:		Checked by:	

PREPARED BY

**Summit Carbon Solutions**  
2321 North Loop Drive, Suite 221  
Ames, Iowa 50010  
United States of America  
[www.summitcarbonsolutions.com](http://www.summitcarbonsolutions.com)




**SUMMIT CARBON SOLUTIONS**

PROJECT INFORMATION

Figure Title: <b>ND PSC - Aerial Map Book - NDT-211</b>	
Figure Number: <b>Map Book 1</b>	
Scale: <b>1 : 12,000</b> 1 inch equals 1,000 feet	Projection: <b>Transverse Mercator</b> NAD 1983 UTM Zone 14N
Sheet: <b>105</b> 105 of 139	Drawing Number: <b>1001-01-003</b> Revision A



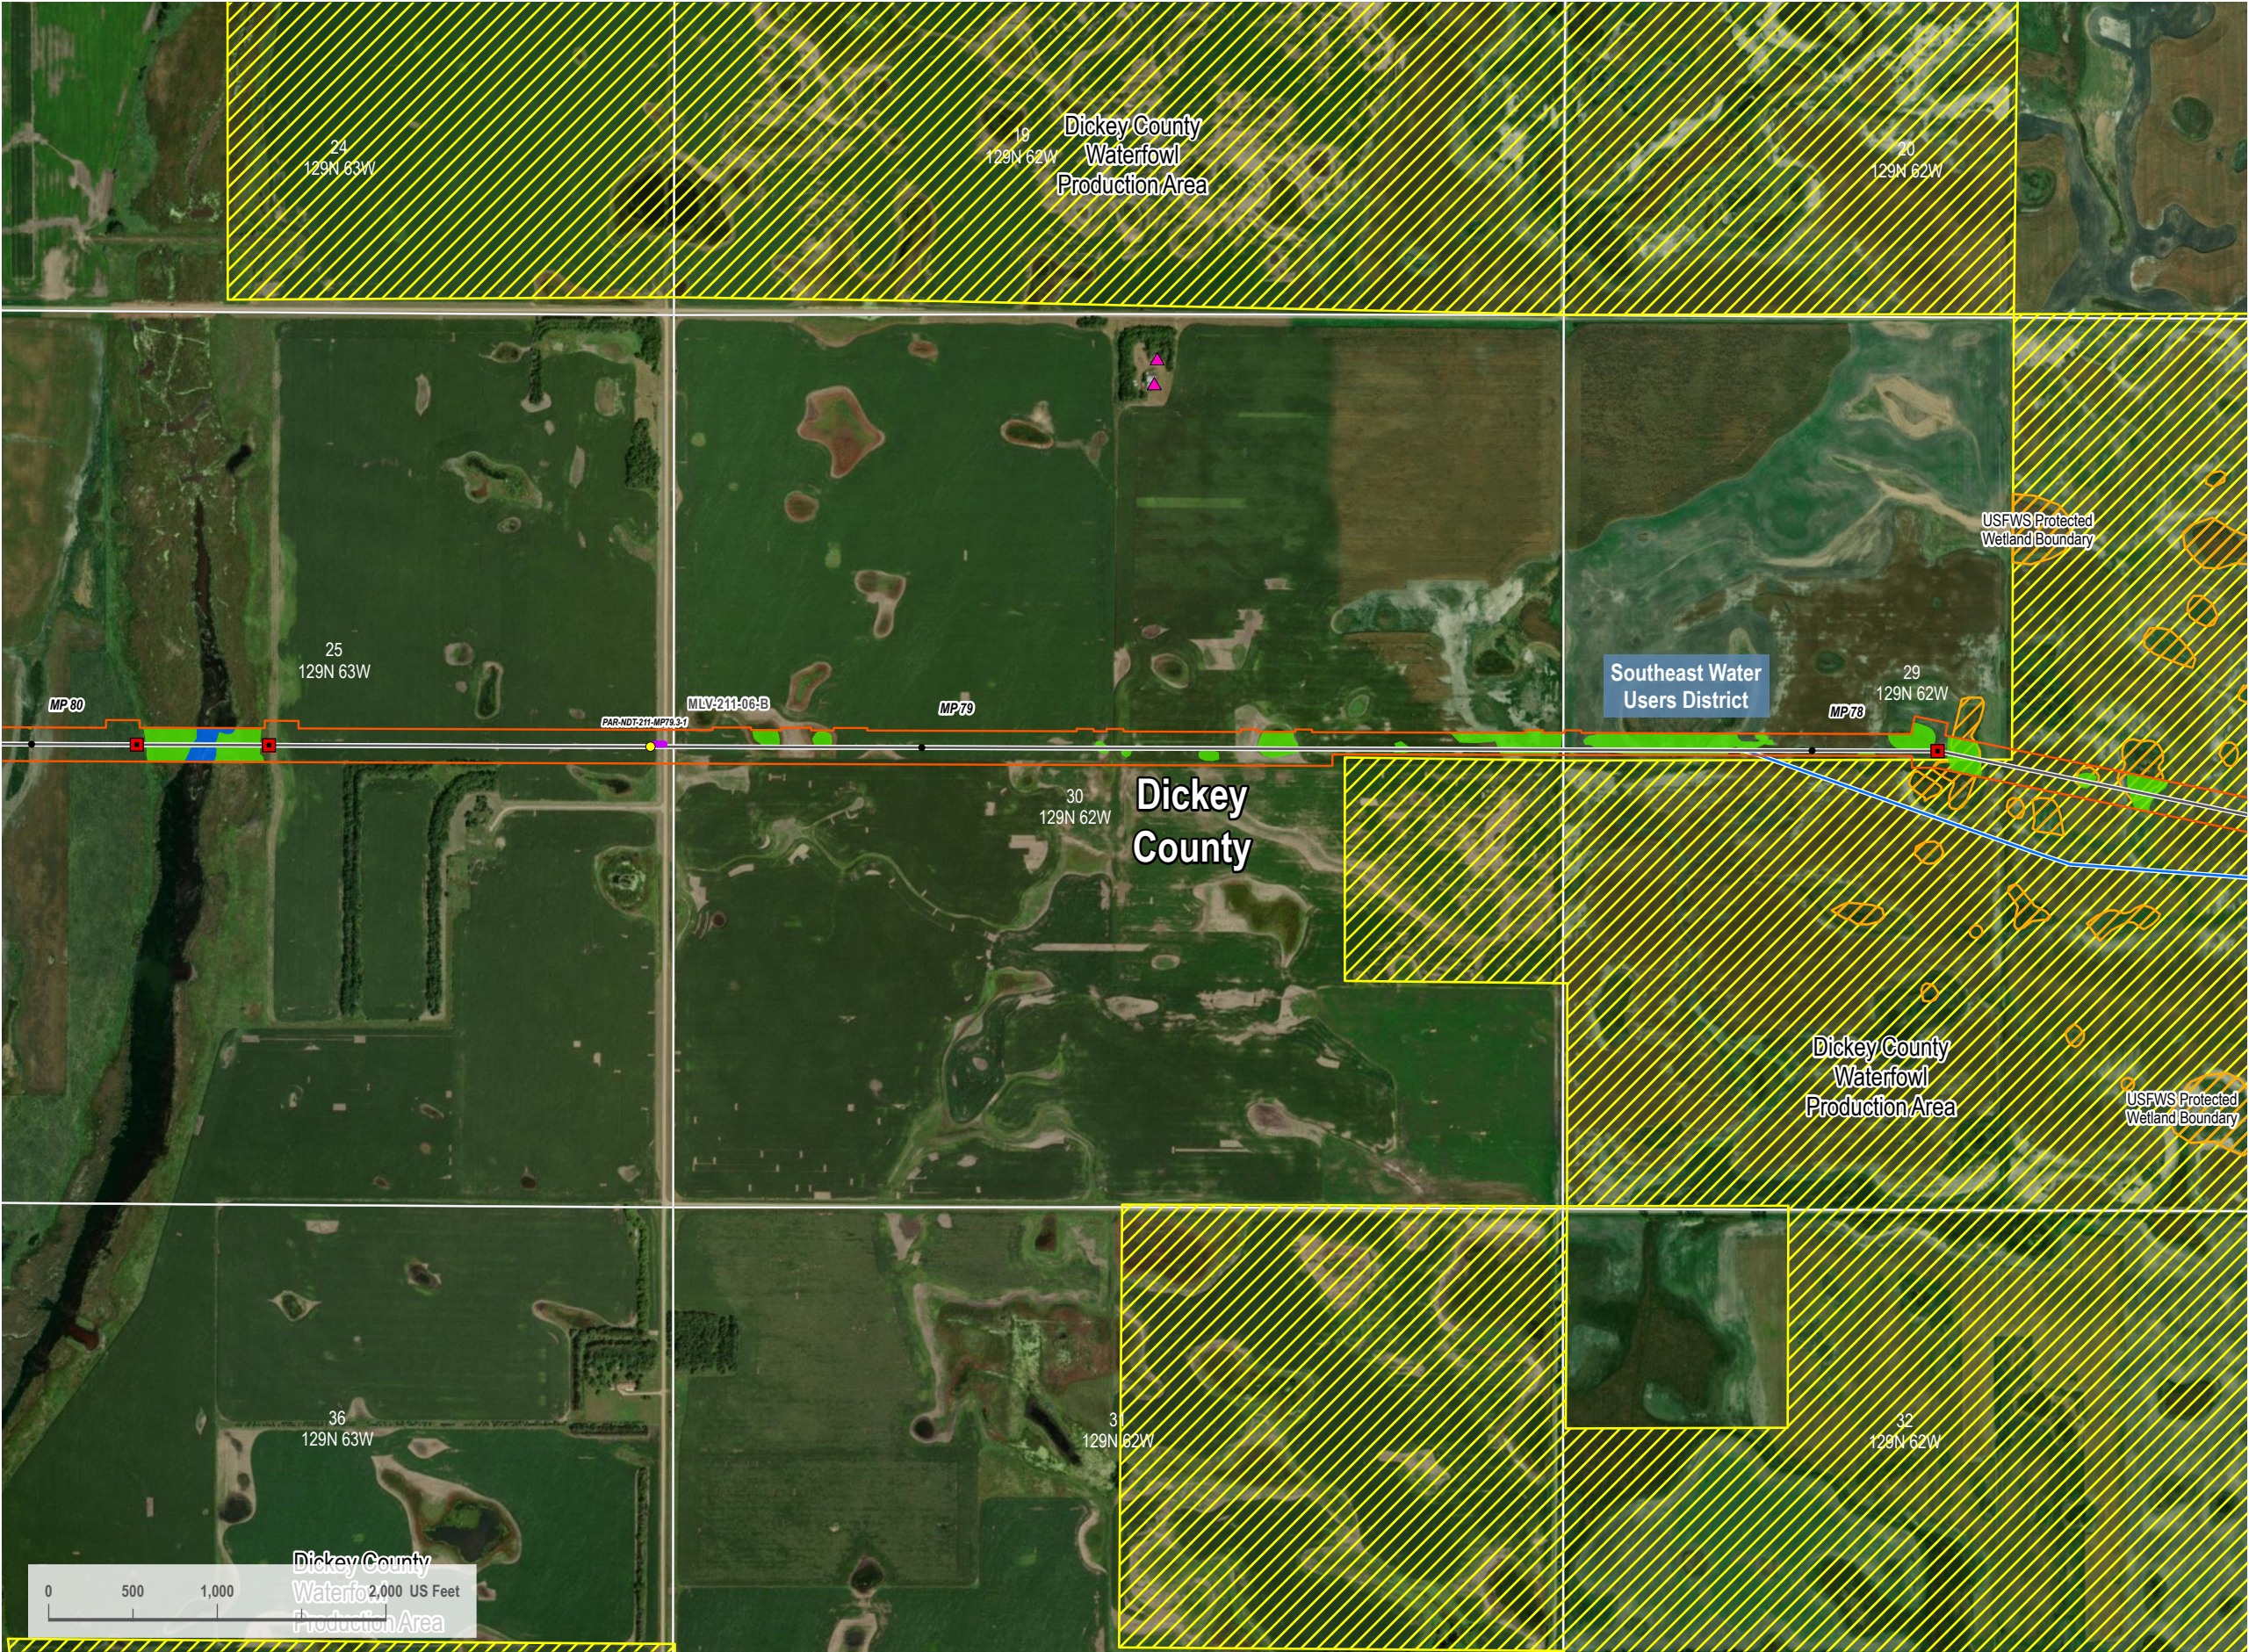

VICINITY MAP



LEGEND

- HDD Entry/Exit
- Centerline Mileposts
- Mainline Valve Location
- Domestic Structure or Business (Avoidance)
- Updated Proposed Project Route 08/15/2023
- October 17, 2023 Original PSC Application Route
- Section Line
- Access Road
- Avoidance Area
- Open Water
- PEM Wetland
- 200-foot Siting Corridor
- Resource Management Area



REVISIONS

Date:	2023-08-17	Revised by:	CW	Checked by:	RC
A - Issued for Review					
Date:		Revised by:		Checked by:	
Date:		Revised by:		Checked by:	


PREPARED BY

**Summit Carbon Solutions**  
2321 North Loop Drive, Suite 221  
Ames, Iowa 50010  
United States of America  
[www.summitcarbonsolutions.com](http://www.summitcarbonsolutions.com)

PROJECT INFORMATION

Figure Title: <b>ND PSC - Aerial Map Book - NDT-211</b>	
Figure Number: <b>Map Book 1</b>	
Scale: <b>1 : 12,000</b> 1 inch equals 1,000 feet	Projection: <b>Transverse Mercator</b> NAD 1983 UTM Zone 14N
Sheet: <b>106</b> 106 of 139	Drawing Number: <b>1001-01-003</b> Revision A



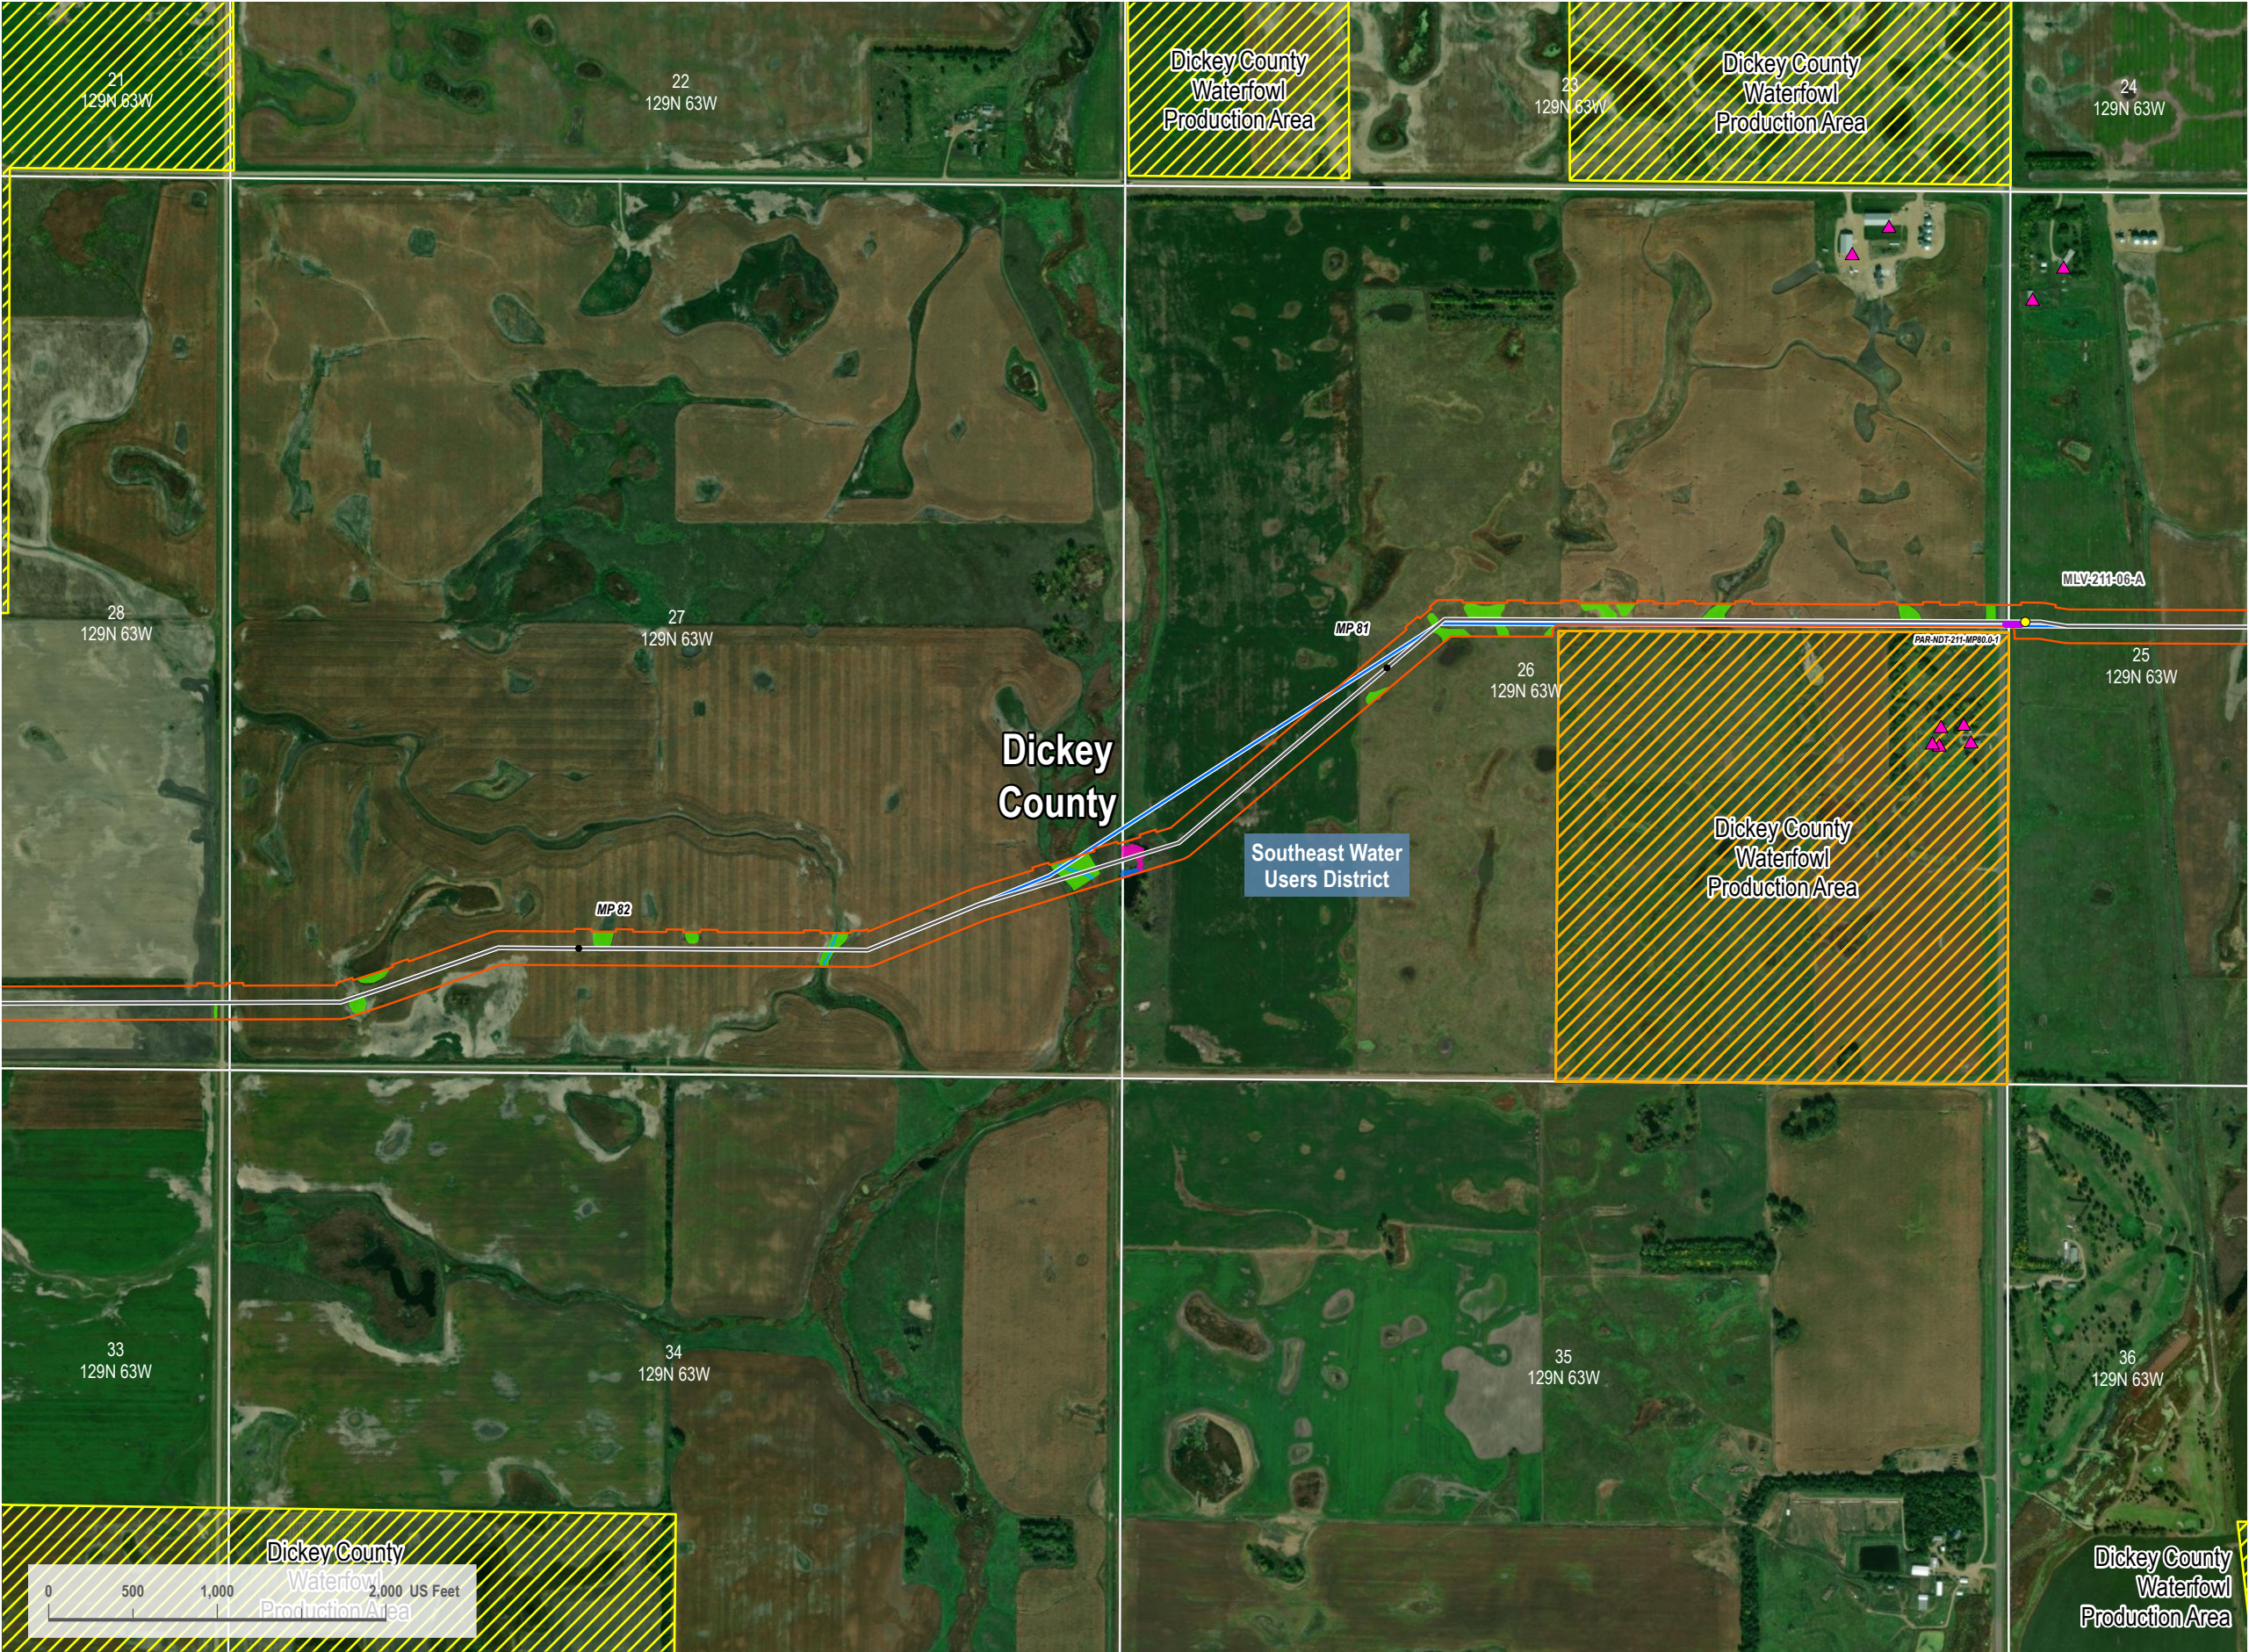

VICINITY MAP

LEGEND

Centerline Mileposts	Avoidance Area
Mainline Valve Location	Open Water
Domestic Structure or Business (Avoidance)	PEM Wetland
Updated Proposed Project Route 08/15/2023	PSS Wetland
October 17, 2023 Original PSC Application Route	Stream
Section Line	200-foot Siting Corridor
Access Road	Resource Management Area

REVISIONS

Date: 2023-08-17	Revised by: CW	Checked by: RC
A - Issued for Review		
Date:	Revised by:	Checked by:
Date:	Revised by:	Checked by:

PREPARED BY

Summit Carbon Solutions  
2321 North Loop Drive, Suite 221  
Ames, Iowa 50010  
United States of America  
[www.summitcarbonsolutions.com](http://www.summitcarbonsolutions.com)


PROJECT INFORMATION

Figure Title:  
ND PSC - Aerial Map Book - NDT-211

Figure Number:  
Map Book 1

Scale: 1 : 12,000 1 inch equals 1,000 feet	Projection: Transverse Mercator NAD 1983 UTM Zone 14N
Sheet: 107 107 of 139	Drawing Number: 1001-01-003 Revision A



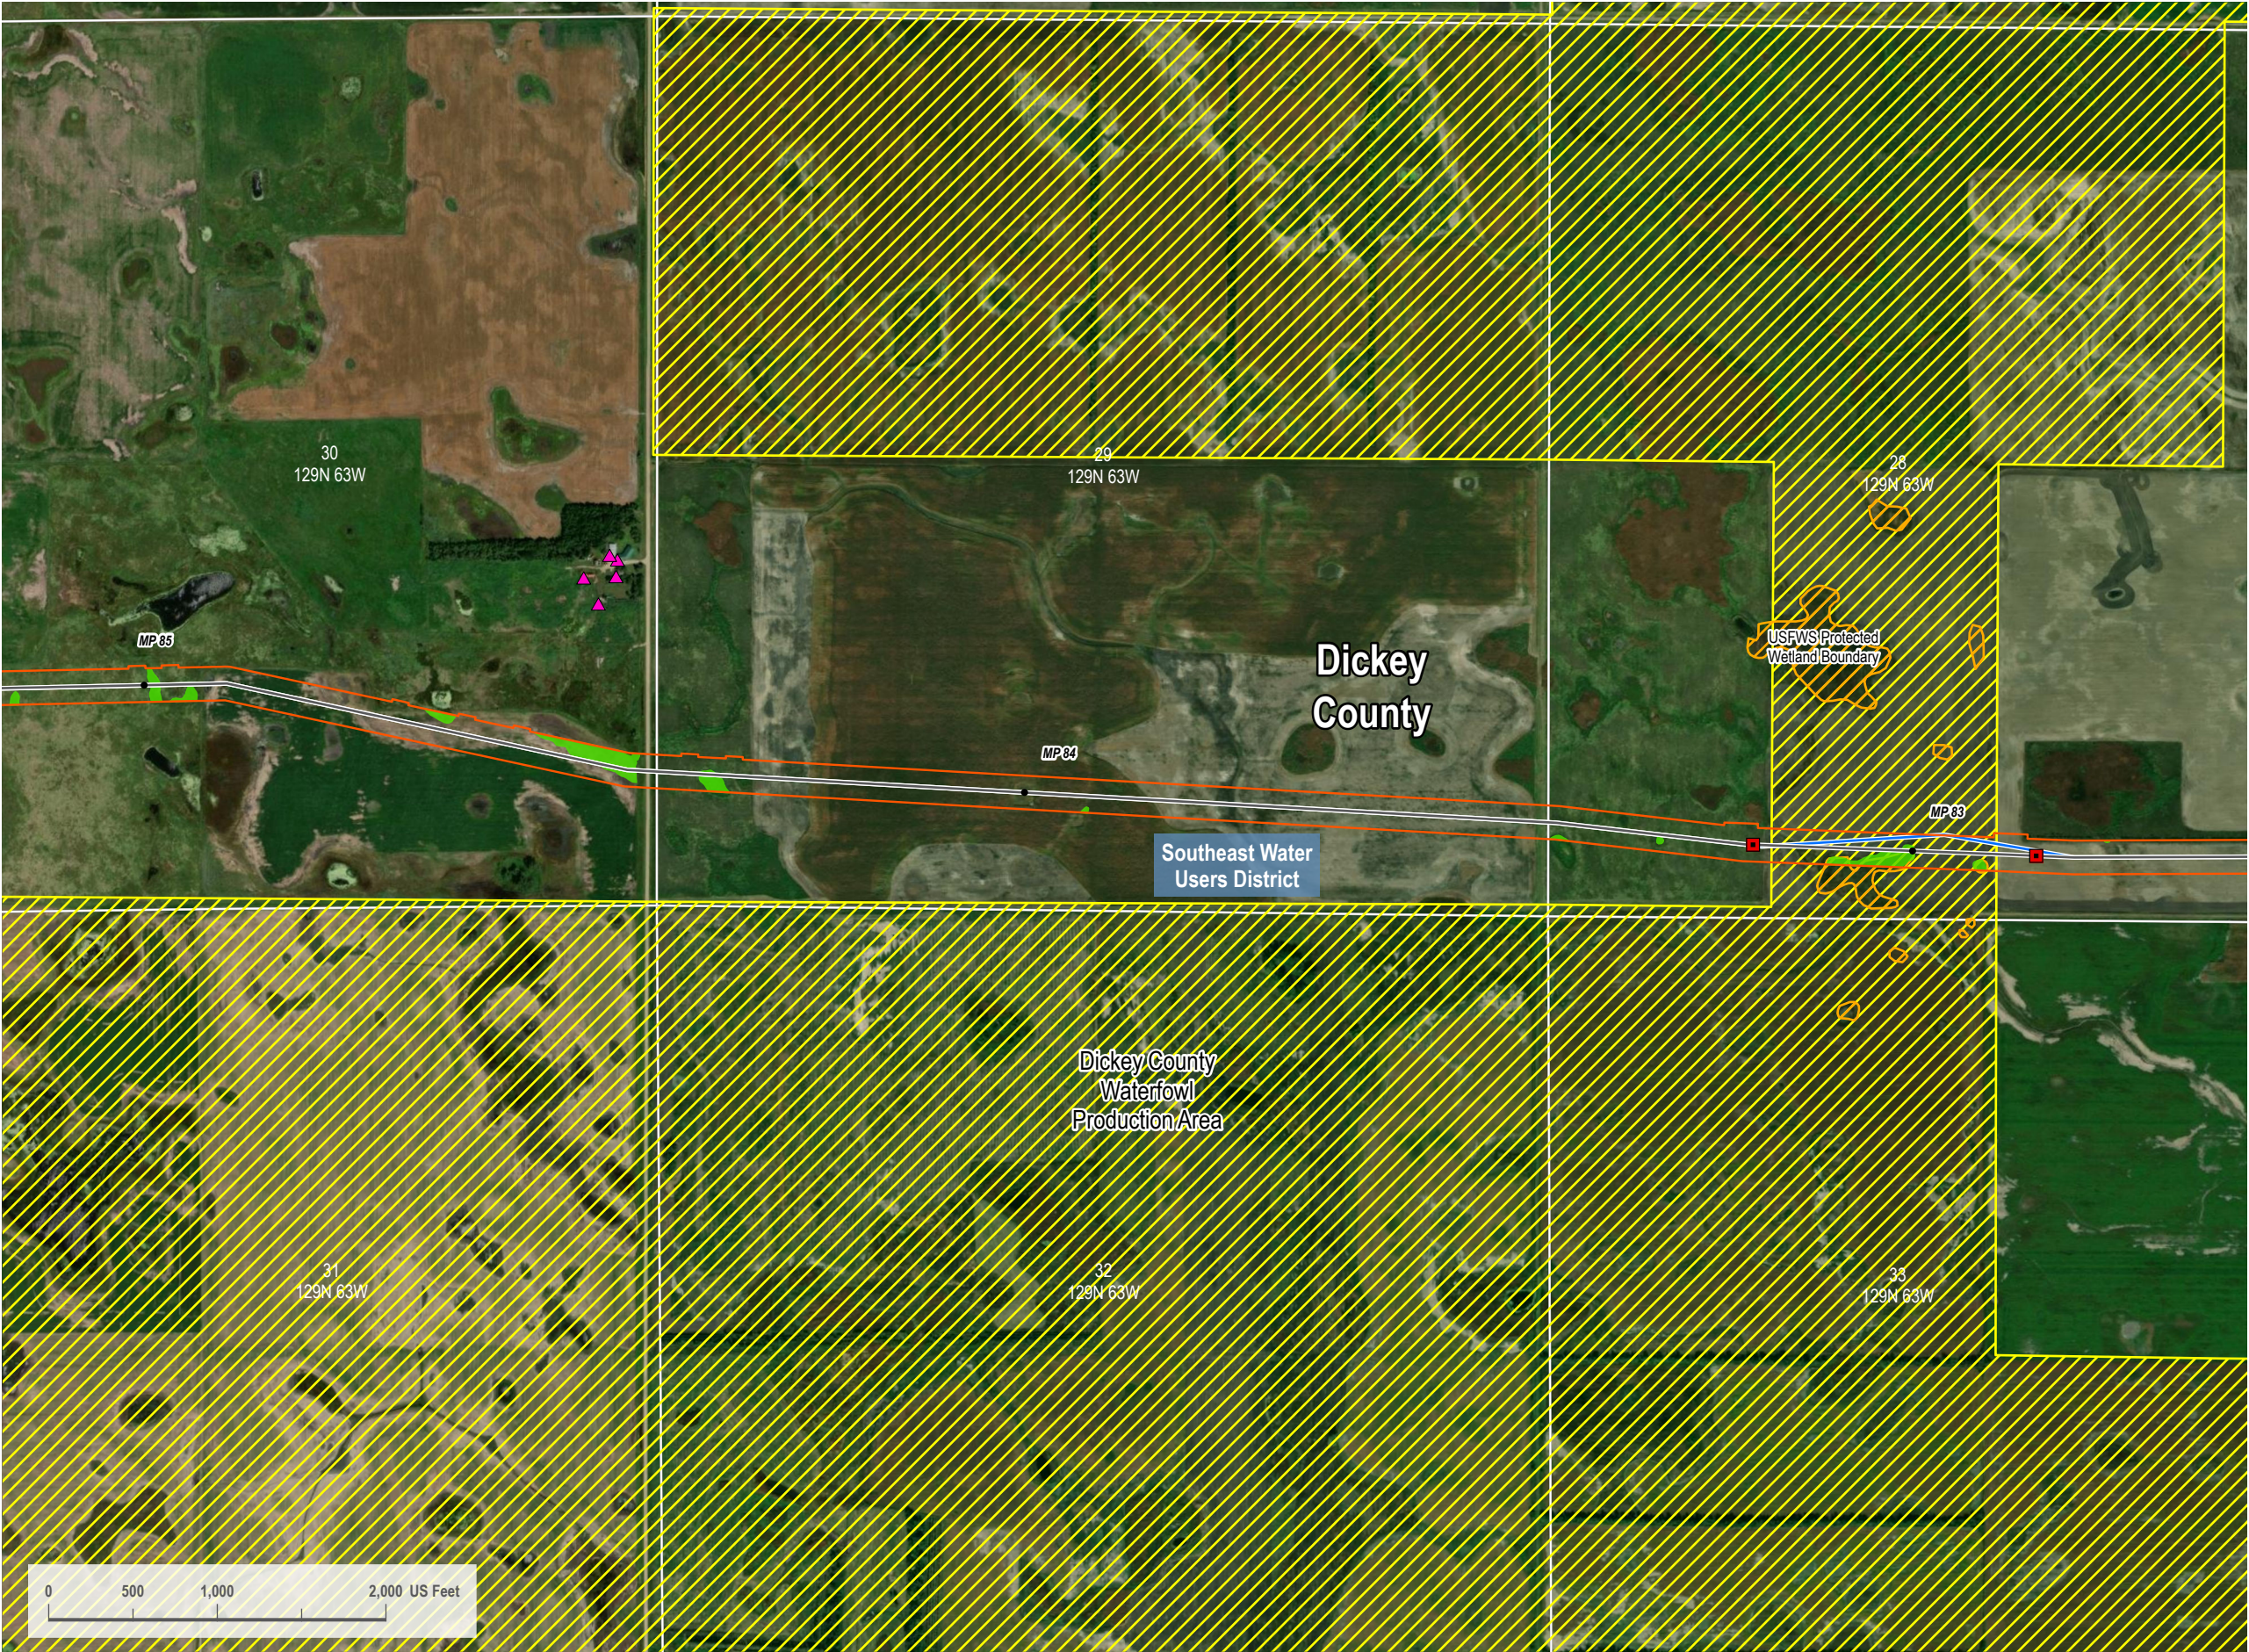

VICINITY MAP

LEGEND

HDD Entry/Exit	Avoidance Area
Centerline Mileposts	PEM Wetland
Domestic Structure or Business (Avoidance)	200-foot Siting Corridor
Updated Proposed Project Route 08/15/2023	Resource Management Area
October 17, 2023 Original PSC Application Route	
Section Line	

REVISIONS

Date: 2023-08-17	Revised by: CW	Checked by: RC
A - Issued for Review		
Date:	Revised by:	Checked by:
Date:	Revised by:	Checked by:

PREPARED BY

Summit Carbon Solutions

2321 North Loop Drive, Suite 221  
Ames, Iowa 50010  
United States of America

[www.summitcarbonsolutions.com](http://www.summitcarbonsolutions.com)


PROJECT INFORMATION

Figure Title:  
ND PSC - Aerial Map Book - NDT-211

Figure Number:  
Map Book 1

Scale: 1 : 12,000 1 inch equals 1,000 feet	Projection: Transverse Mercator NAD 1983 UTM Zone 14N
Sheet: 108 108 of 139	Drawing Number: 1001-01-003 Revision A



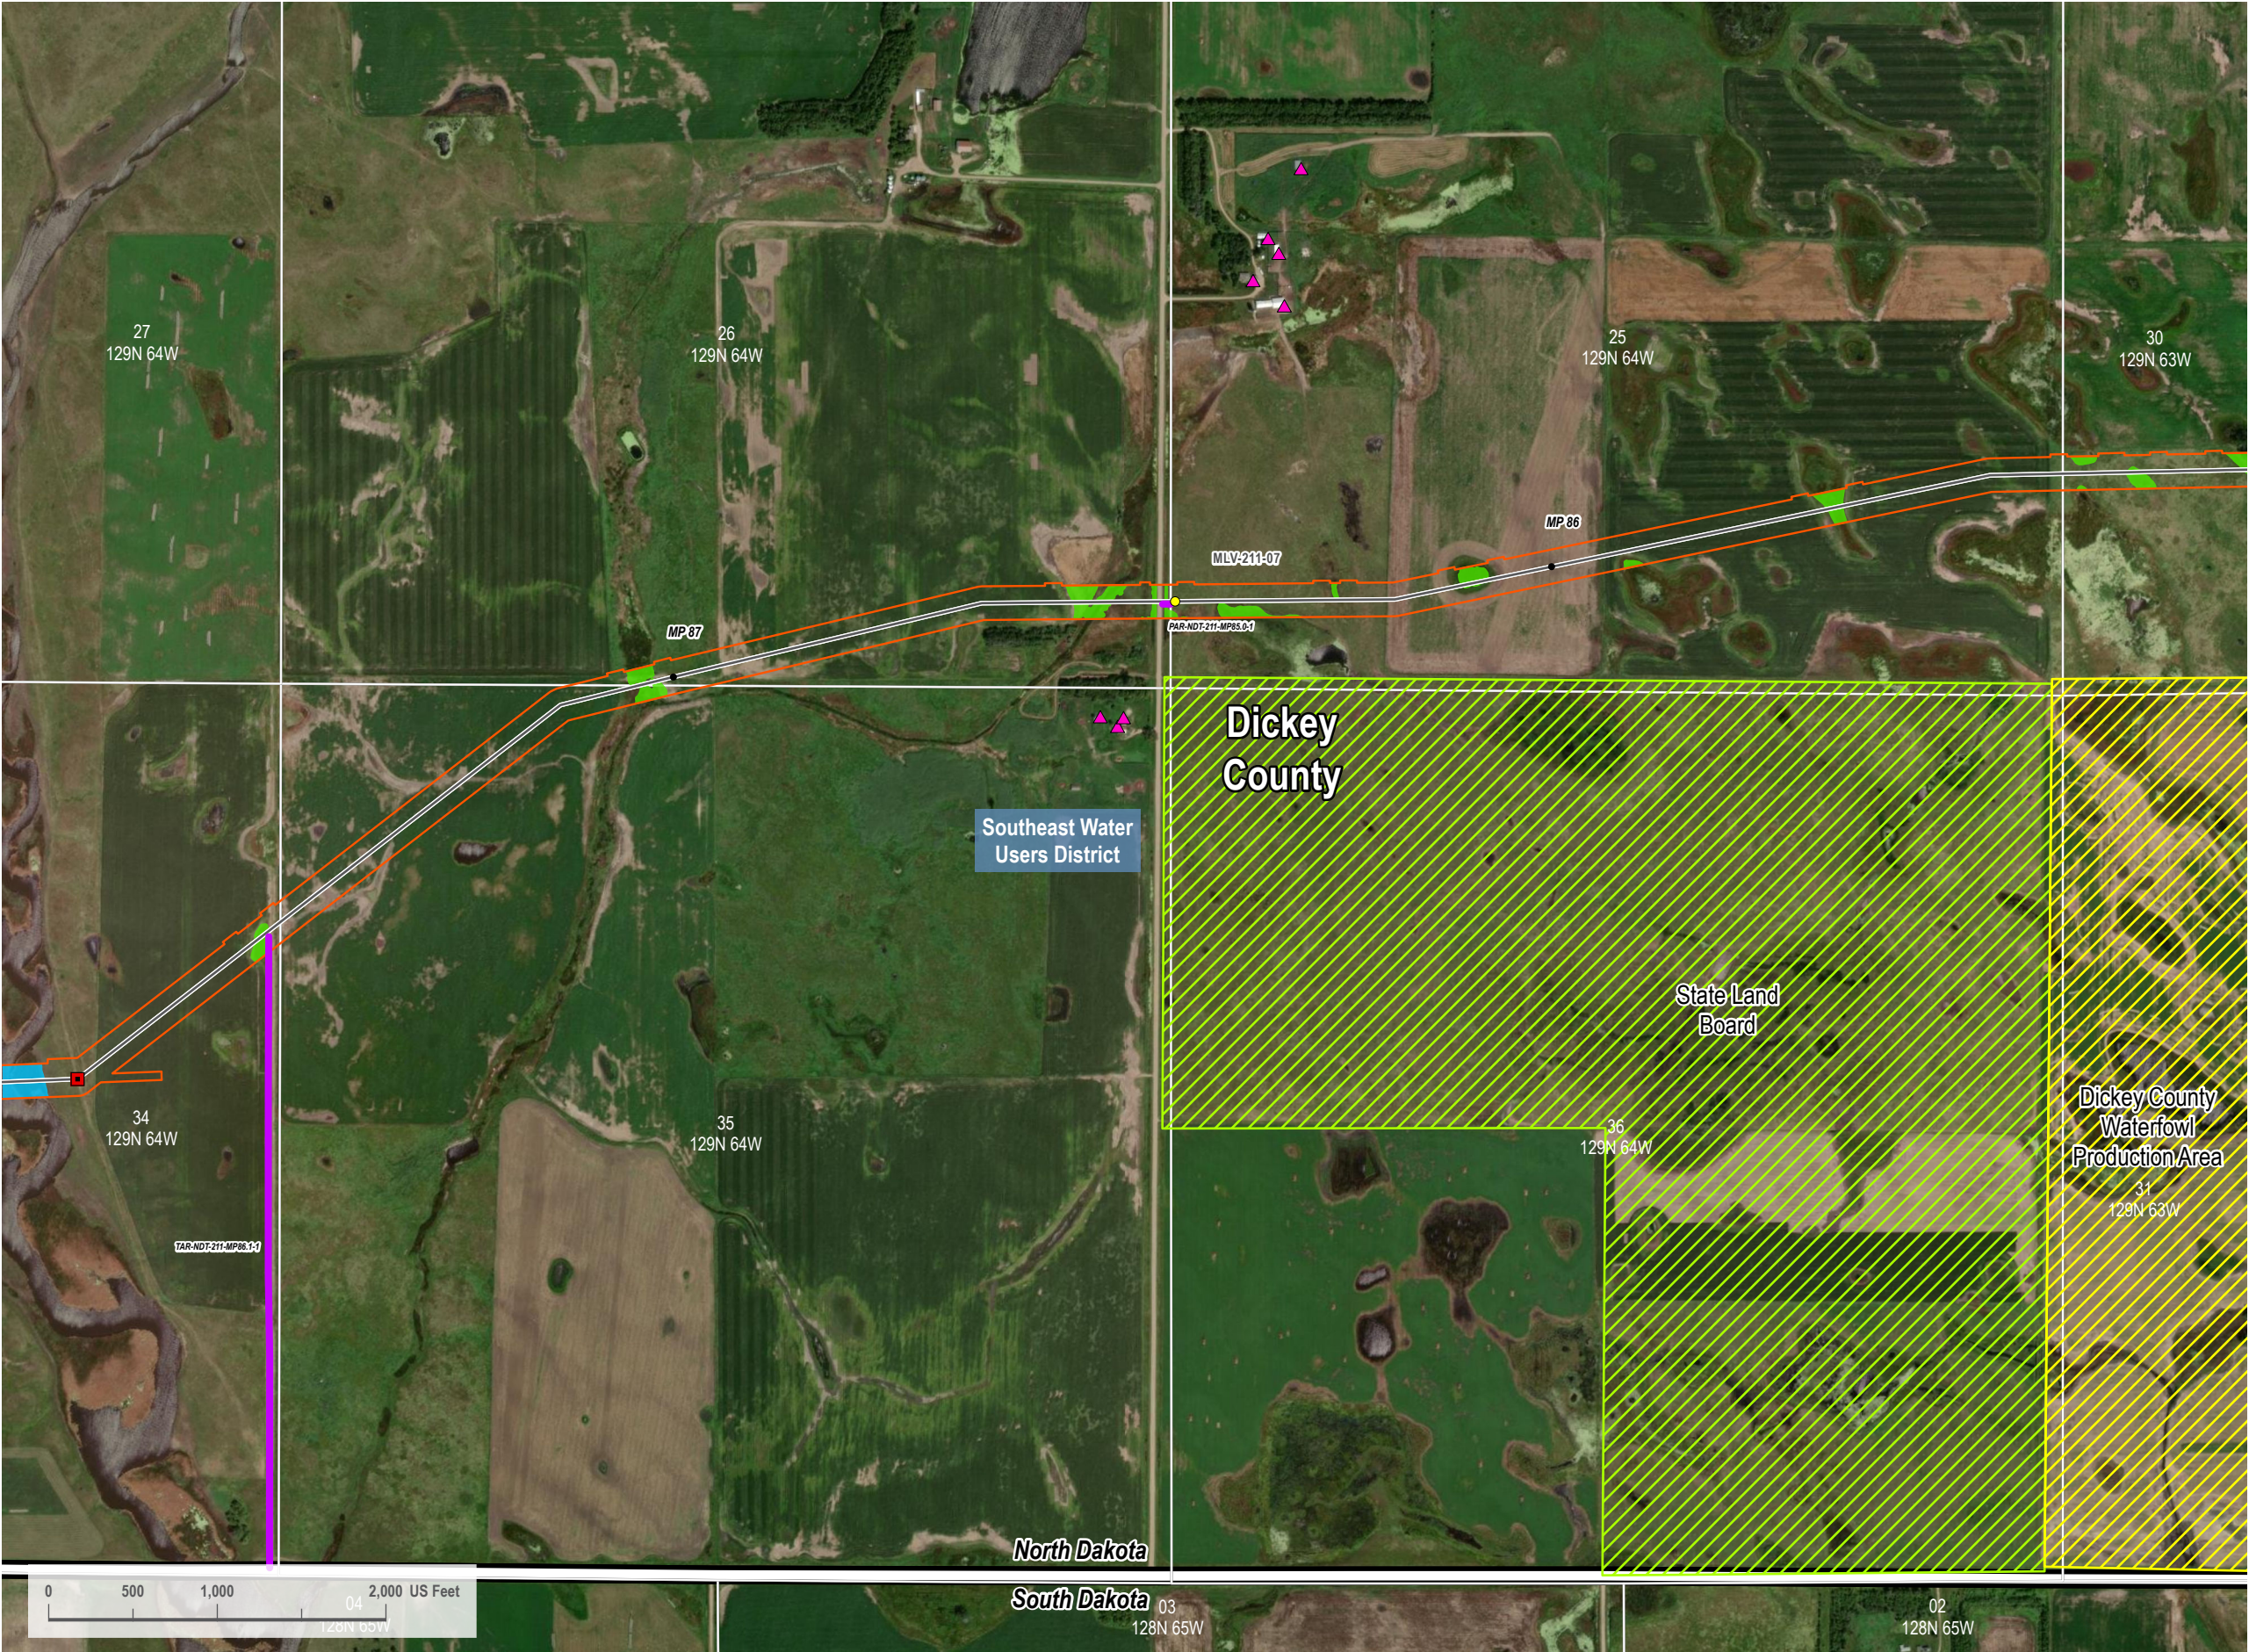

Southeast Water Users District

Dickey County

State Land Board

Dickey County Waterfowl Production Area

North Dakota

South Dakota

P:\G\Projects\1001-01-003 ND PSC Mapbook\Rev 04\MapBook\1001-01-003 ND PSC Mapbook.aprx

VICINITY MAP



LEGEND

- HDD Entry/Exit
- Centerline Mileposts
- Mainline Valve Location
- Domestic Structure or Business (Avoidance)
- Updated Proposed Project Route 08/15/2023
- October 17, 2023 Original PSC Application Route
- Section Line
- Access Road
- PEM Wetland
- Stream
- 200-foot Siting Corridor
- Resource Management Area
- State Resource Management Area



REVISIONS

Date: 2023-08-17	Revised by: CW	Checked by: RC
A - Issued for Review		
Date:	Revised by:	Checked by:
Date:	Revised by:	Checked by:

PREPARED BY

**Summit Carbon Solutions**  
2321 North Loop Drive, Suite 221  
Ames, Iowa 50010  
United States of America  
[www.summitcarbonsolutions.com](http://www.summitcarbonsolutions.com)




**SUMMIT CARBON SOLUTIONS**

PROJECT INFORMATION

Figure Title:	ND PSC - Aerial Map Book - NDT-211	
Figure Number:	Map Book 1	
Scale:	1 : 12,000 1 inch equals 1,000 feet	Projection: Transverse Mercator NAD 1983 UTM Zone 14N
Sheet:	109 109 of 139	Drawing Number: 1001-01-003 Revision A



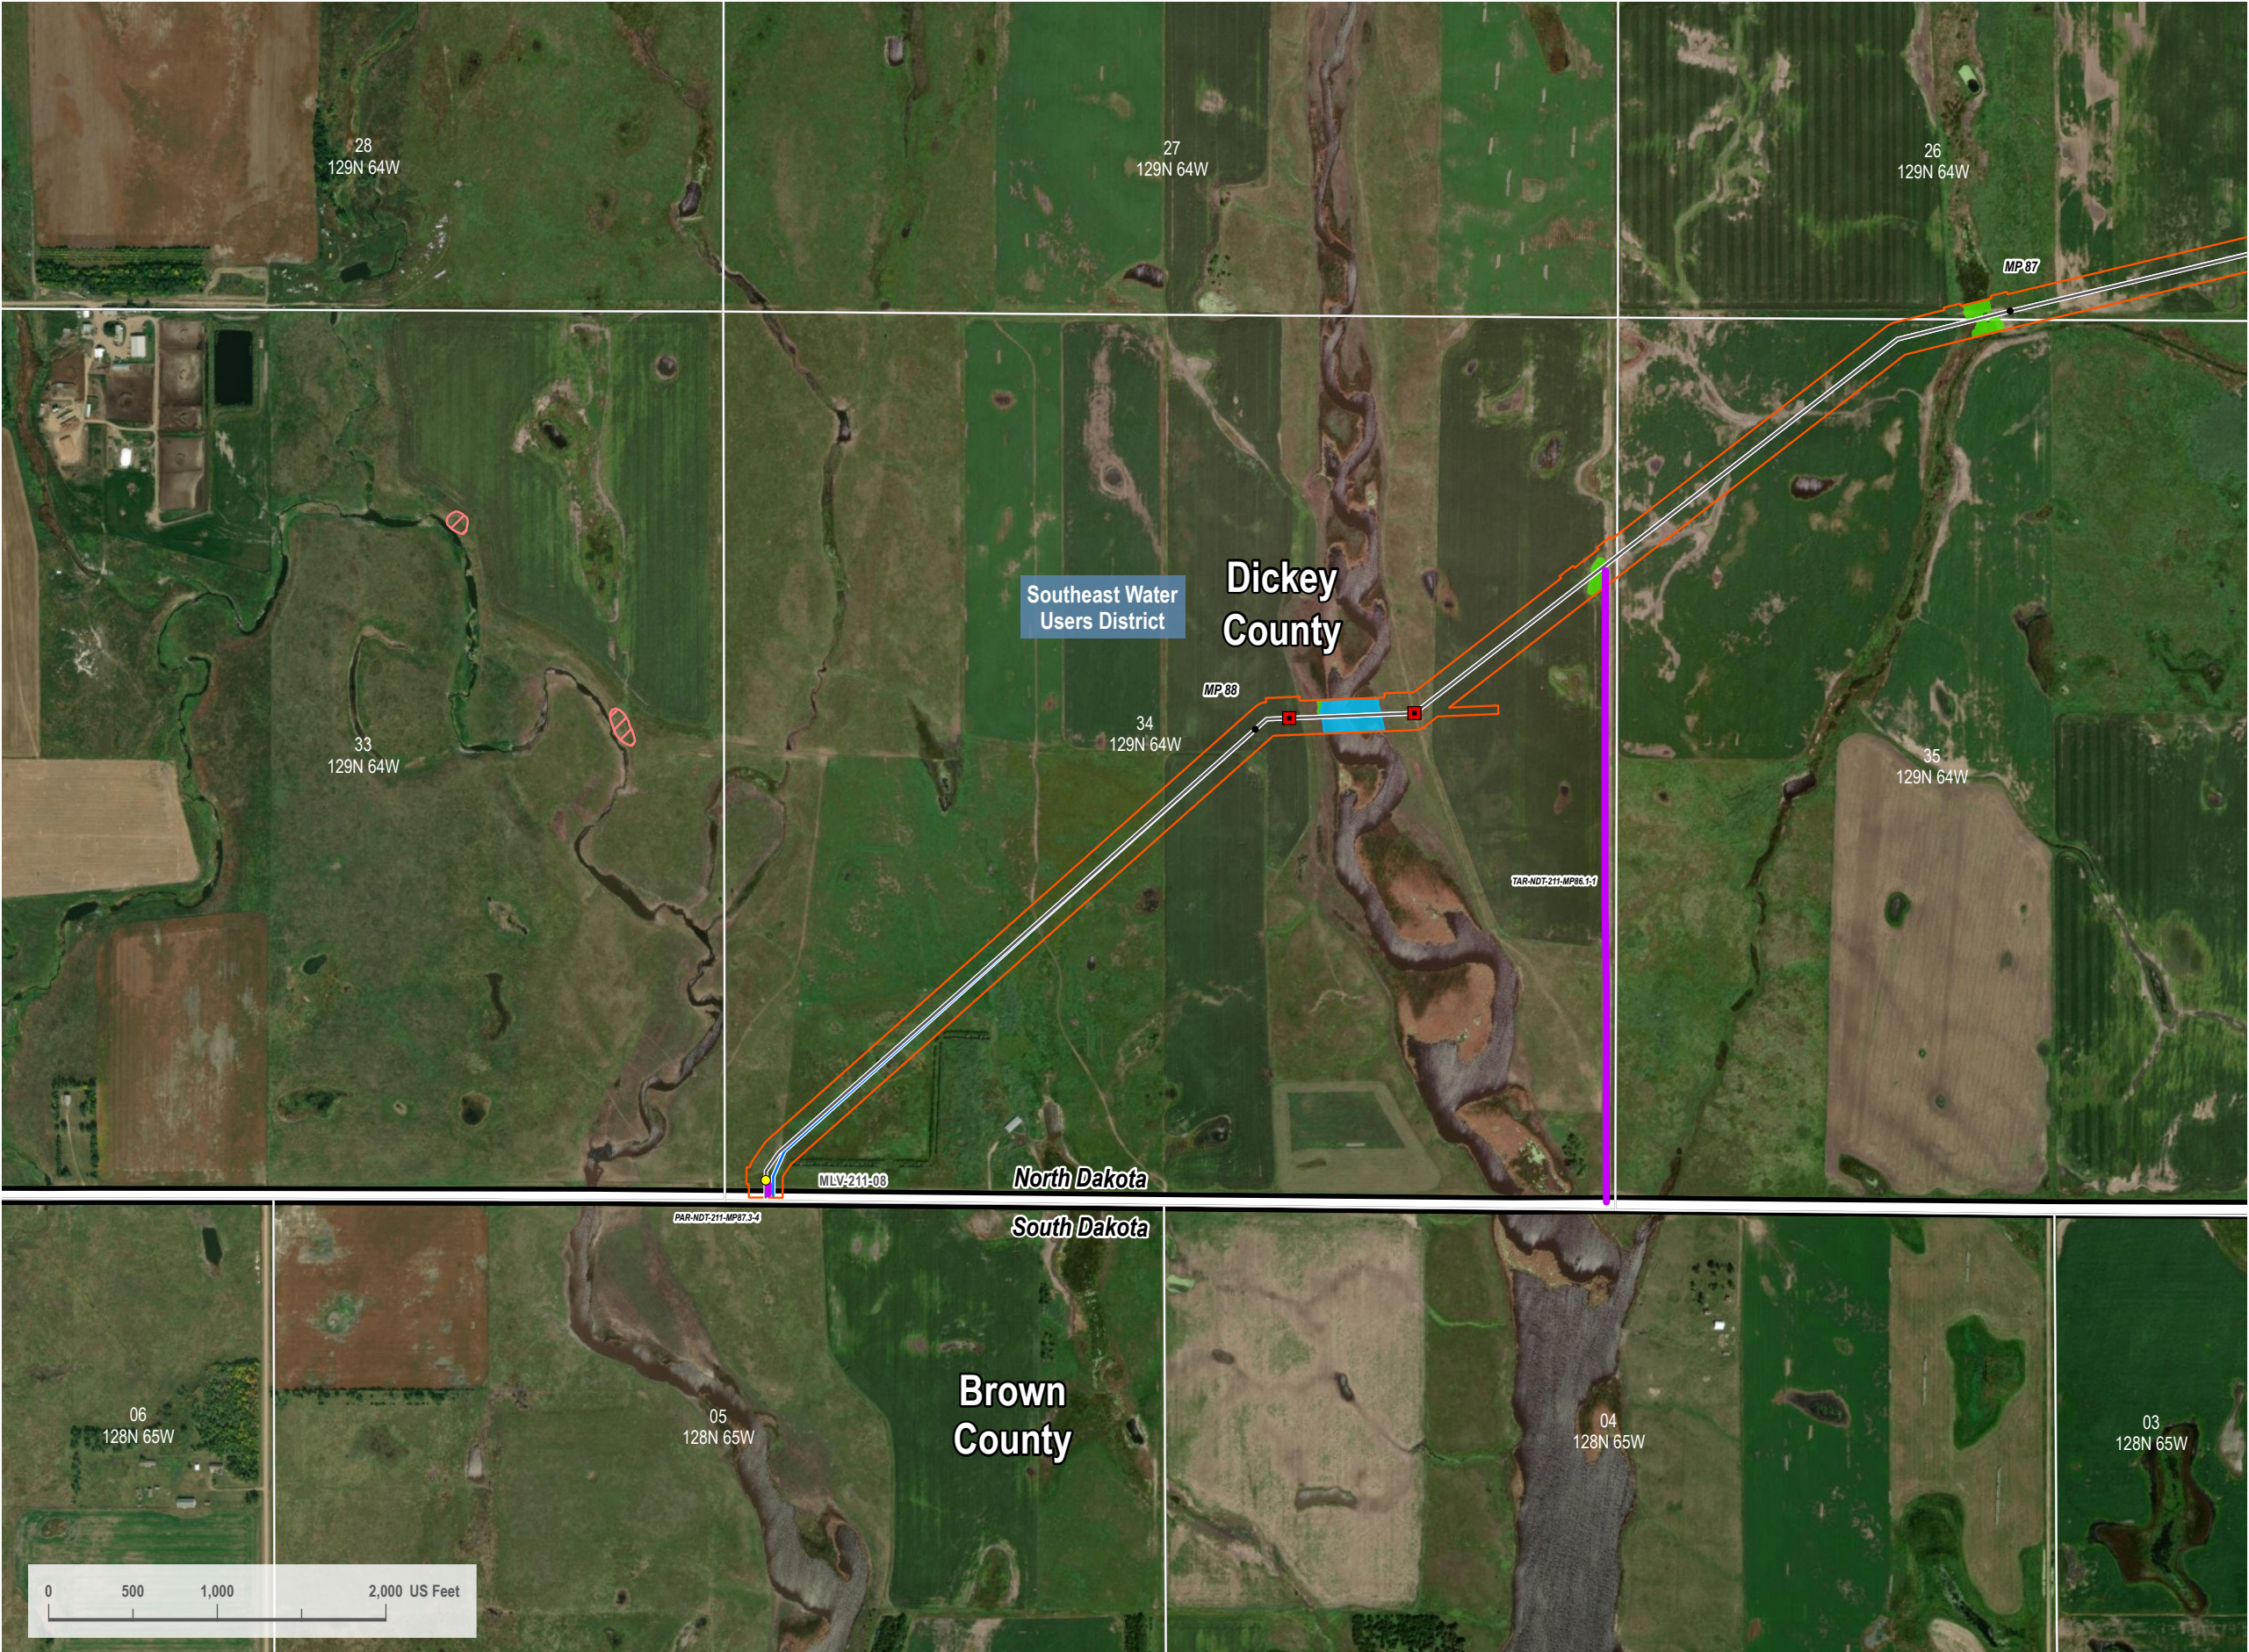


VICINITY MAP



LEGEND

- HDD Entry/Exit
- Centerline Mileposts
- Mainline Valve Location
- Updated Proposed Project Route 08/15/2023
- October 17, 2023 Original PSC Application Route
- Section Line
- Access Road
- Landslide Deposit (Avoidance)
- PEM Wetland
- Stream
- 200-foot Siting Corridor

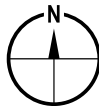

REVISIONS

Date: 2023-08-17	Revised by: CW	Checked by: RC
A - Issued for Review		
Date:	Revised by:	Checked by:
Date:	Revised by:	Checked by:

PREPARED BY


Summit Carbon Solutions  
2321 North Loop Drive, Suite 221  
Ames, Iowa 50010  
United States of America  
[www.summitcarbonsolutions.com](http://www.summitcarbonsolutions.com)

  
**SUMMIT CARBON**  
SOLUTIONS

PROJECT INFORMATION

Figure Title: ND PSC - Aerial Map Book - NDT-211	
Figure Number: Map Book 1	
Scale: 1 : 12,000 1 inch equals 1,000 feet	Projection: Transverse Mercator NAD 1983 UTM Zone 14N
Sheet: 110 110 of 139	Drawing Number: 1001-01-003 Revision A



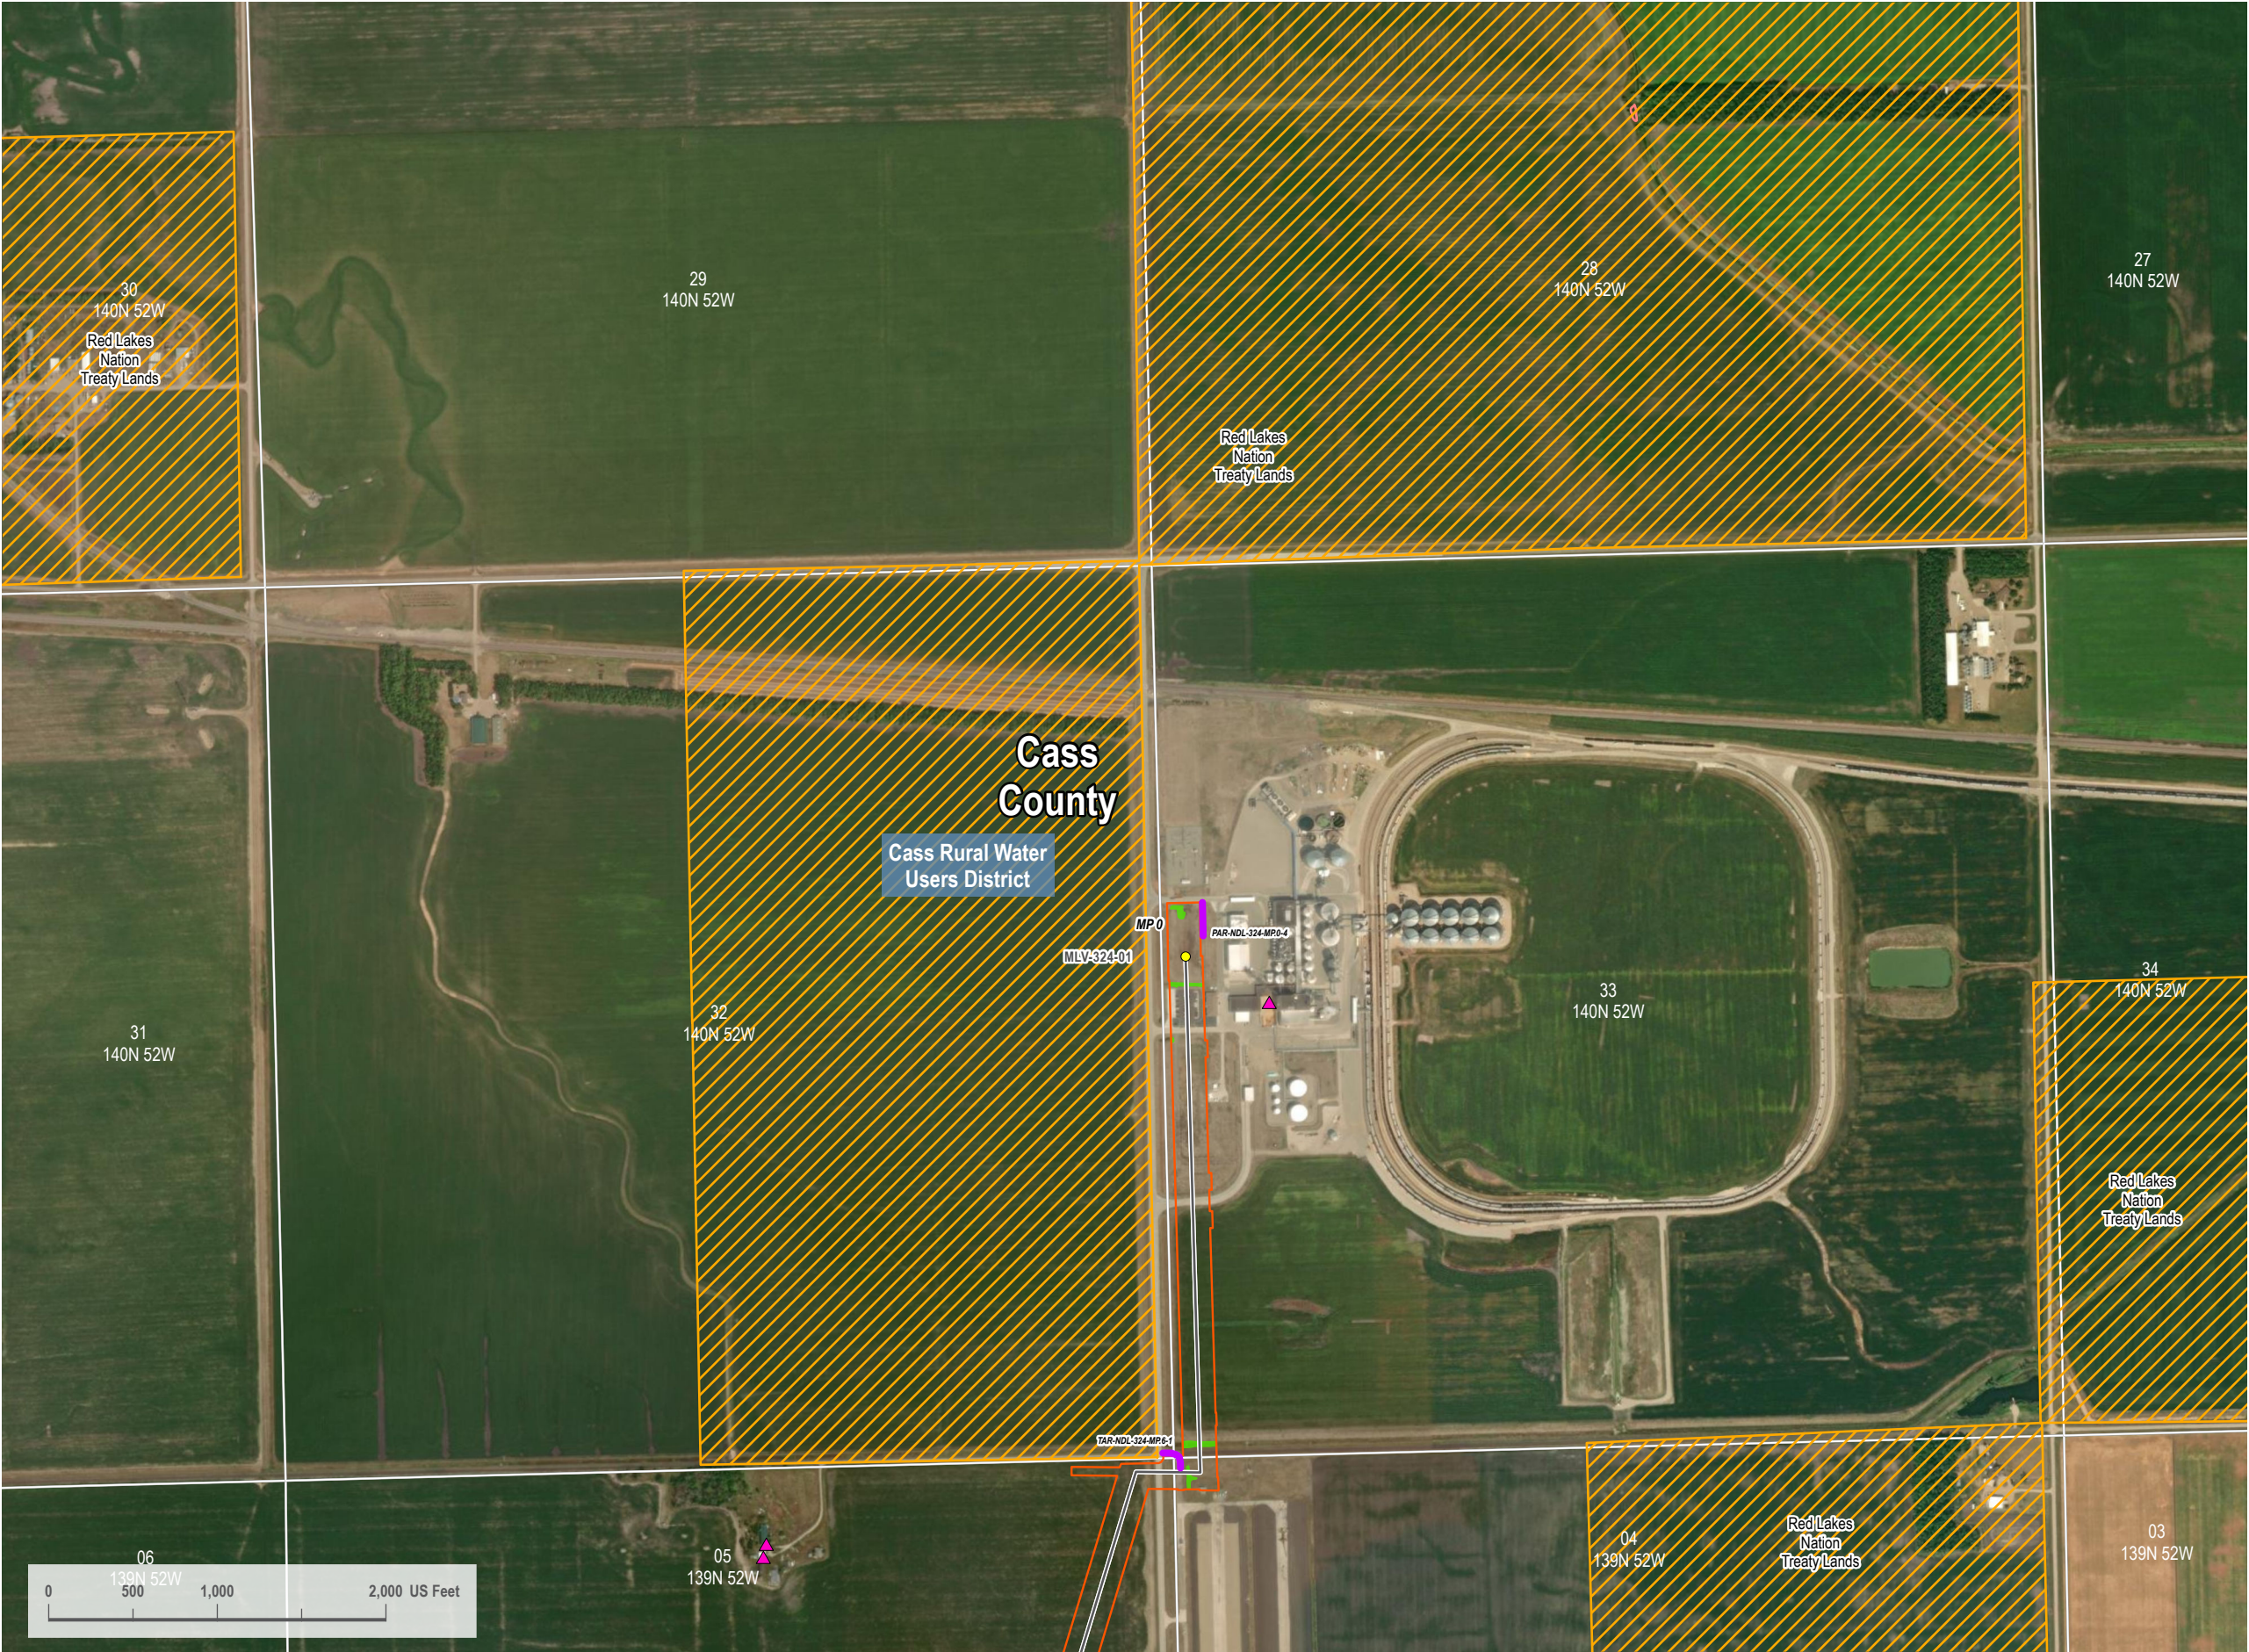

VICINITY MAP



LEGEND

- Centerline Mileposts
- Mainline Valve Location
- Domestic Structure or Business (Avoidance)
- Updated Proposed Project Route 08/15/2023
- October 17, 2023 Original PSC Application Route
- Section Line
- Access Road
- Landslide Deposit (Avoidance)
- Avoidance Area
- PEM Wetland
- 200-foot Siting Corridor



REVISIONS

Date: 2023-08-17 Revised by: CW Checked by: RC  
A - Issued for Review

Date: Revised by: Checked by:

Date: Revised by: Checked by:

PREPARED BY

**Summit Carbon Solutions**  
2321 North Loop Drive, Suite 221  
Ames, Iowa 50010  
United States of America  
www.summitcarbonsolutions.com



PROJECT INFORMATION

Figure Title:  
ND PSC - Aerial Map Book - NDL-324

Figure Number:  
Map Book 1


Scale:  
1 : 12,000  
1 inch equals 1,000 feet

Projection:  
Transverse Mercator  
NAD 1983 UTM Zone 14N

Sheet:  
111  
111 of 139

Drawing Number:  
1001-01-003  
Revision A



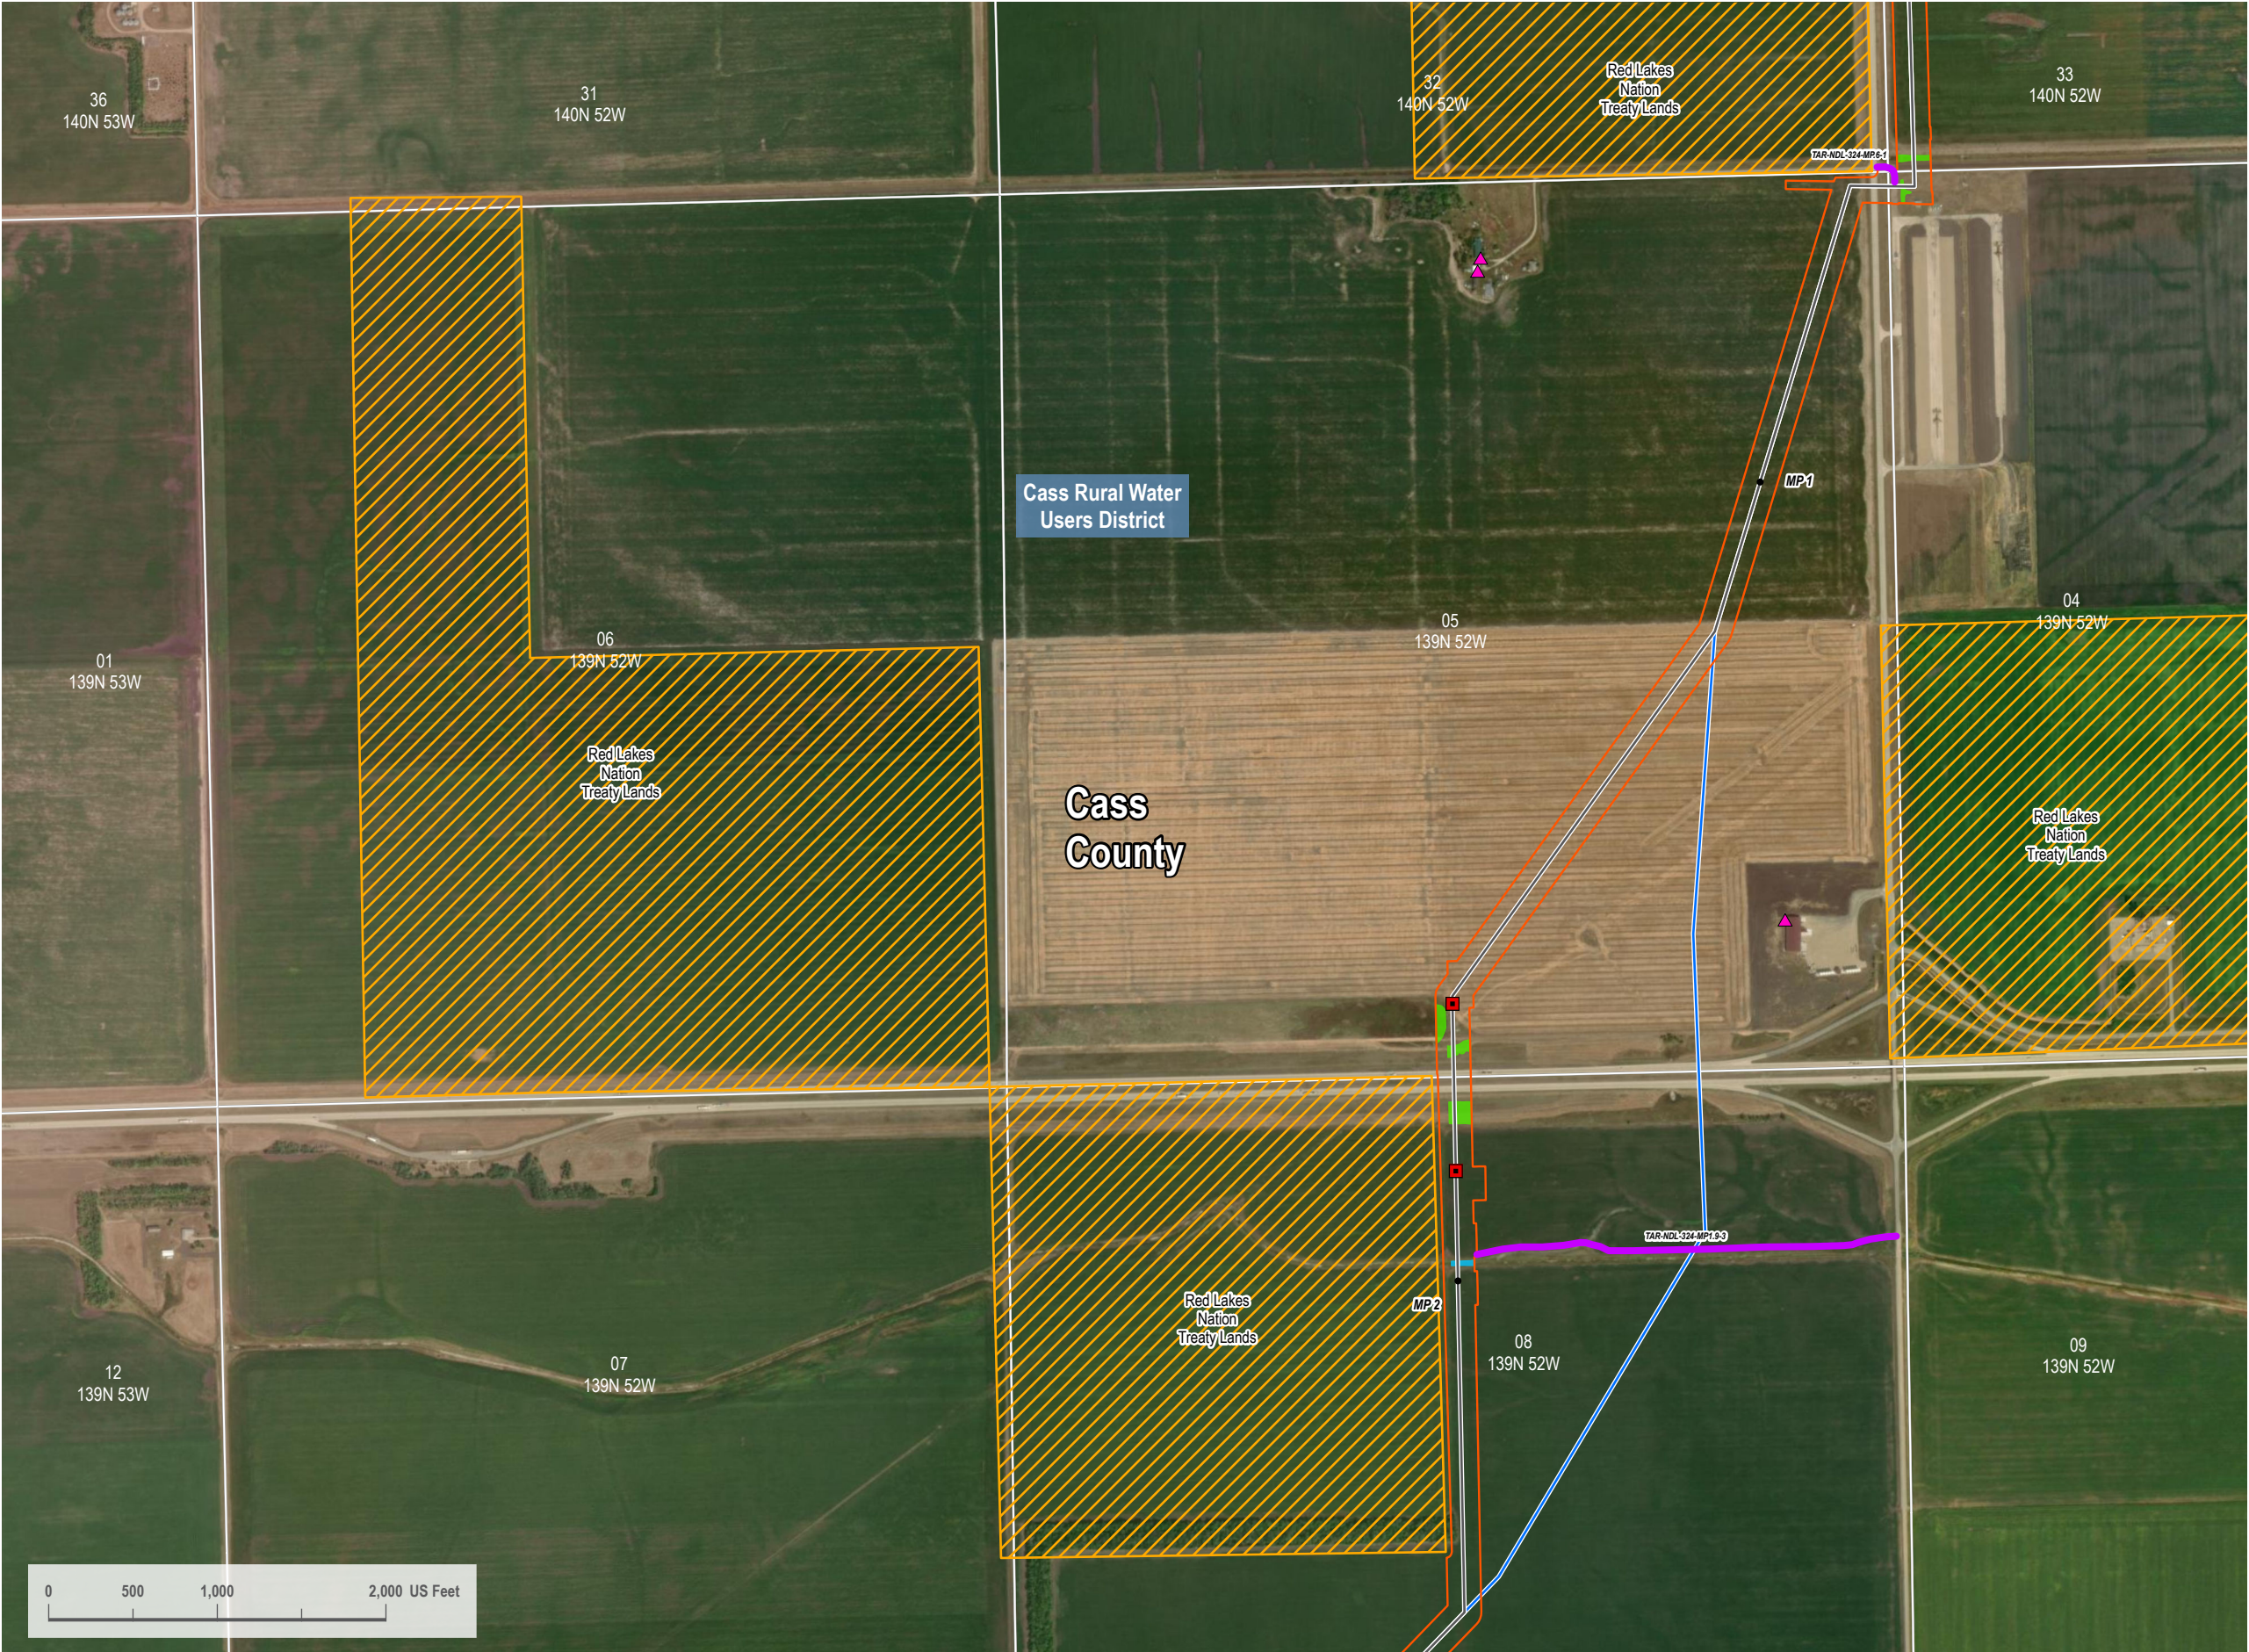


VICINITY MAP



LEGEND

- HDD Entry/Exit
- Centerline Mileposts
- Domestic Structure or Business (Avoidance)
- Updated Proposed Project Route 08/15/2023
- October 17, 2023 Original PSC Application Route
- Section Line
- Access Road
- Avoidance Area
- PEM Wetland
- Stream
- 200-foot Siting Corridor

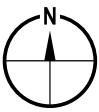

REVISIONS

Date: 2023-08-17	Revised by: CW	Checked by: RC
A - Issued for Review		
Date:	Revised by:	Checked by:
Date:	Revised by:	Checked by:

PREPARED BY

**Summit Carbon Solutions**  
2321 North Loop Drive, Suite 221  
Ames, Iowa 50010  
United States of America  
[www.summitcarbonsolutions.com](http://www.summitcarbonsolutions.com)

PROJECT INFORMATION

Figure Title: <b>ND PSC - Aerial Map Book - NDL-324</b>	
Figure Number: <b>Map Book 1</b>	
Scale: <b>1 : 12,000</b> 1 inch equals 1,000 feet	Projection: <b>Transverse Mercator</b> NAD 1983 UTM Zone 14N
Sheet: <b>112</b> 112 of 139	Drawing Number: <b>1001-01-003</b> Revision A





VICINITY MAP



LEGEND

- Centerline Mileposts
- Domestic Structure or Business (Avoidance)
- Updated Proposed Project Route 08/15/2023
- October 17, 2023 Original PSC Application Route
- Section Line
- Avoidance Area
- 200-foot Siting Corridor



REVISIONS

Date:	2023-08-17	Revised by:	CW	Checked by:	RC
A - Issued for Review					
Date:		Revised by:		Checked by:	
Date:		Revised by:		Checked by:	

PREPARED BY

**Summit Carbon Solutions**  
2321 North Loop Drive, Suite 221  
Ames, Iowa 50010  
United States of America  
[www.summitcarbonsolutions.com](http://www.summitcarbonsolutions.com)



**SUMMIT CARBON**  
SOLUTIONS

PROJECT INFORMATION

Figure Title: <b>ND PSC - Aerial Map Book - NDL-324</b>	
Figure Number: <b>Map Book 1</b>	
Scale: <b>1 : 12,000</b> 1 inch equals 1,000 feet	Projection: <b>Transverse Mercator</b> NAD 1983 UTM Zone 14N
Sheet: <b>113</b> 113 of 139	Drawing Number: <b>1001-01-003</b> Revision A





VICINITY MAP



LEGEND

- Centerline Mileposts
- Domestic Structure or Business (Avoidance)
- Updated Proposed Project Route 08/15/2023
- October 17, 2023 Original PSC Application Route
- Section Line
- Landslide Deposit (Avoidance)
- Avoidance Area
- PEM Wetland
- Stream
- 200-foot Siting Corridor



REVISIONS

Date: 2023-08-17	Revised by: CW	Checked by: RC
A - Issued for Review		
Date:	Revised by:	Checked by:
Date:	Revised by:	Checked by:

PREPARED BY

**Summit Carbon Solutions**  
2321 North Loop Drive, Suite 221  
Ames, Iowa 50010  
United States of America  
[www.summitcarbonsolutions.com](http://www.summitcarbonsolutions.com)



**SUMMIT CARBON**  
SOLUTIONS

PROJECT INFORMATION

Figure Title: <b>ND PSC - Aerial Map Book - NDL-324</b>	
Figure Number: <b>Map Book 1</b>	
Scale: <b>1 : 12,000</b> 1 inch equals 1,000 feet	Projection: <b>Transverse Mercator</b> NAD 1983 UTM Zone 14N
Sheet: <b>114</b> 114 of 139	Drawing Number: <b>1001-01-003</b> Revision A





VICINITY MAP



LEGEND

- Centerline Mileposts
- Domestic Structure or Business (Avoidance)
- Updated Proposed Project Route 08/15/2023
- October 17, 2023 Original PSC Application Route
- Section Line
- Landslide Deposit (Avoidance)
- Avoidance Area
- PEM Wetland
- Stream
- 200-foot Siting Corridor



REVISIONS

Date:	2023-08-17	Revised by:	CW	Checked by:	RC
A - Issued for Review					
Date:		Revised by:		Checked by:	
Date:		Revised by:		Checked by:	

PREPARED BY

**Summit Carbon Solutions**  
2321 North Loop Drive, Suite 221  
Ames, Iowa 50010  
United States of America  
[www.summitcarbonsolutions.com](http://www.summitcarbonsolutions.com)




**SUMMIT CARBON**  
SOLUTIONS

PROJECT INFORMATION

Figure Title: <b>ND PSC - Aerial Map Book - NDL-324</b>	
Figure Number: <b>Map Book 1</b>	
Scale: <b>1 : 12,000</b> 1 inch equals 1,000 feet	Projection: <b>Transverse Mercator</b> NAD 1983 UTM Zone 14N
Sheet: <b>115</b> 115 of 139	Drawing Number: <b>1001-01-003</b> Revision A



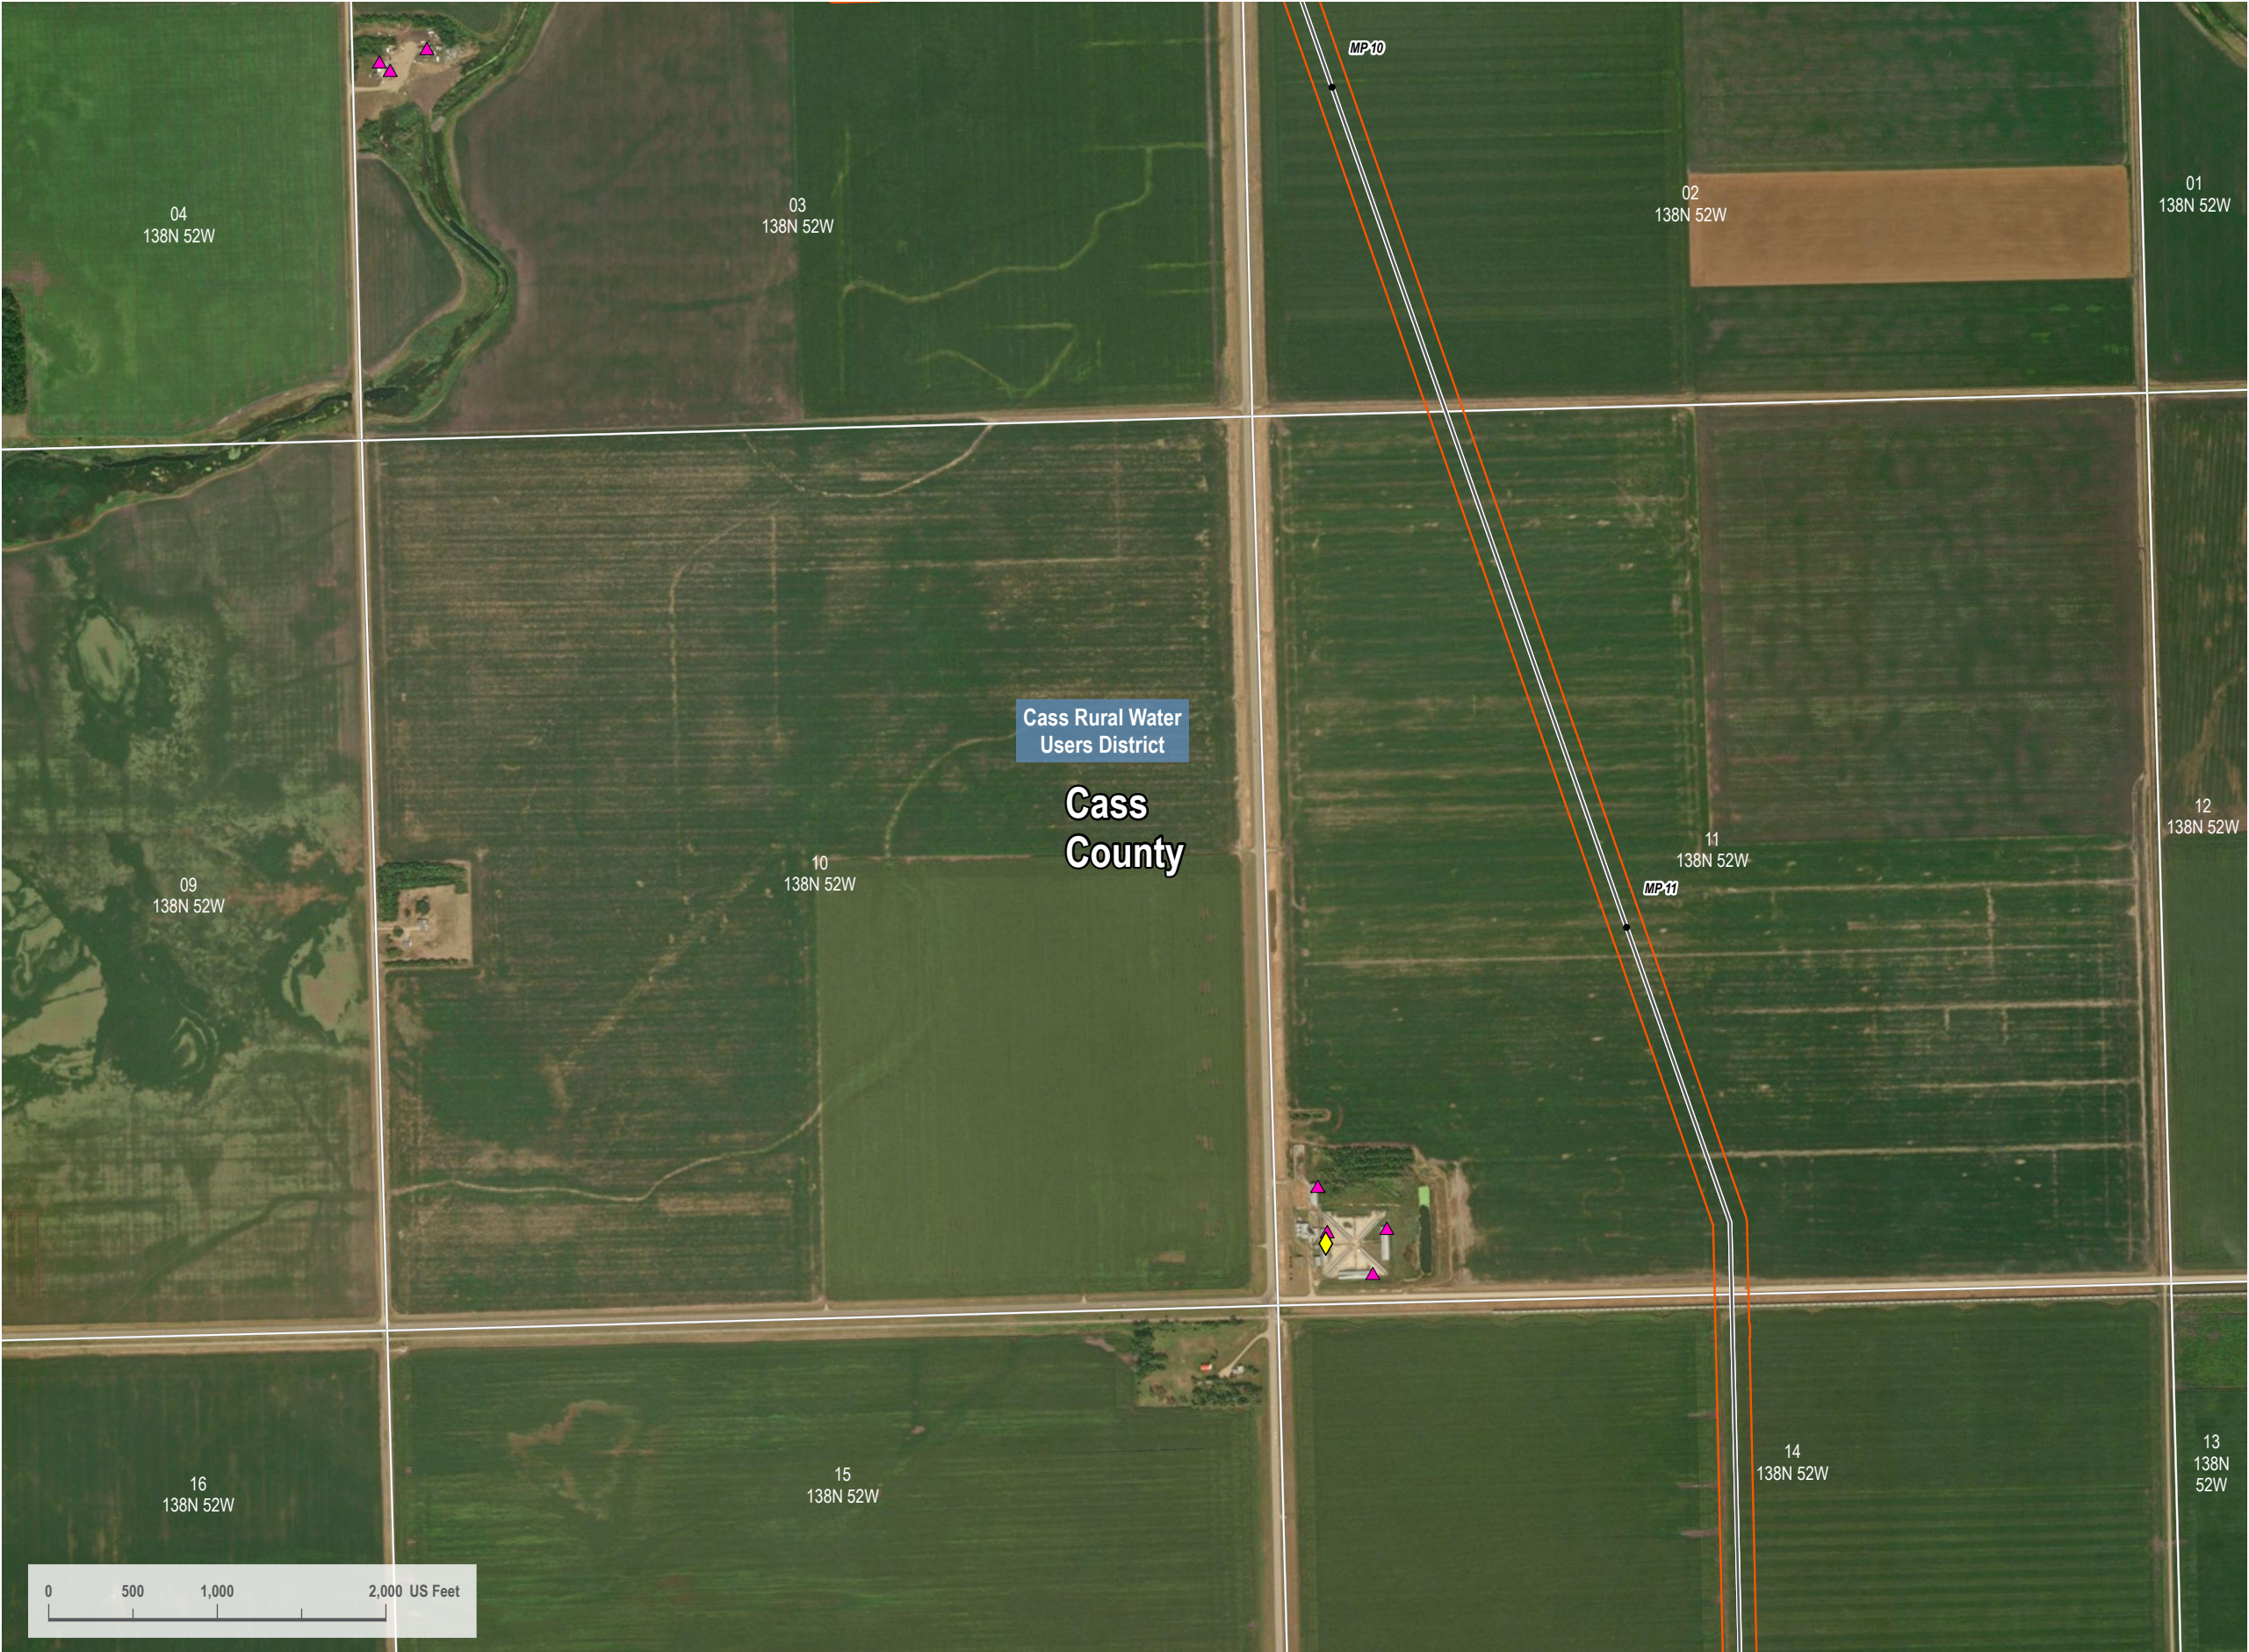

VICINITY MAP



LEGEND

- Centerline Mileposts
- Water Well (Avoidance)
- Domestic Structure or Business (Avoidance)
- Updated Proposed Project Route 08/15/2023
- October 17, 2023 Original PSC Application Route
- Section Line
- 200-foot Siltation Corridor



REVISIONS

Date: 2023-08-17 Revised by: CW Checked by: RC  
A - Issued for Review

Date: Revised by: Checked by:

Date: Revised by: Checked by:

PREPARED BY

**Summit Carbon Solutions**  
2321 North Loop Drive, Suite 221  
Ames, Iowa 50010  
United States of America  
[www.summitcarbonsolutions.com](http://www.summitcarbonsolutions.com)



PROJECT INFORMATION

Figure Title:

ND PSC - Aerial Map Book - NDL-324

Figure Number:

Map Book 1

Scale:  
1 : 12,000  
1 inch equals 1,000 feet

Projection:  
Transverse Mercator  
NAD 1983 UTM Zone 14N

Sheet:  
116  
116 of 139

Drawing Number:  
1001-01-003  
Revision A





VICINITY MAP



LEGEND

- HDD Entry/Exit
- Centerline Mileposts
- Domestic Structure or Business (Avoidance)
- Updated Proposed Project Route 08/15/2023
- October 17, 2023 Original PSC Application Route
- Section Line
- Landside Deposit (Avoidance)
- PFO Wetland
- Stream
- 200-foot Siting Corridor



REVISIONS

Date: 2023-08-17	Revised by: CW	Checked by: RC
A - Issued for Review		
Date:	Revised by:	Checked by:
Date:	Revised by:	Checked by:

PREPARED BY

**Summit Carbon Solutions**  
2321 North Loop Drive, Suite 221  
Ames, Iowa 50010  
United States of America  
[www.summitcarbonsolutions.com](http://www.summitcarbonsolutions.com)



**SUMMIT CARBON SOLUTIONS**

PROJECT INFORMATION

Figure Title: <b>ND PSC - Aerial Map Book - NDL-324</b>	
Figure Number: <b>Map Book 1</b>	
Scale: <b>1 : 12,000</b> 1 inch equals 1,000 feet	Projection: <b>Transverse Mercator</b> NAD 1983 UTM Zone 14N
Sheet: <b>117</b> 117 of 139	Drawing Number: <b>1001-01-003</b> Revision A





VICINITY MAP



LEGEND

- Centerline Mileposts
- Domestic Structure or Business (Avoidance)
- Updated Proposed Project Route 08/15/2023
- October 17, 2023 Original PSC Application Route
- Section Line
- 200-foot Siting Corridor



REVISIONS

Date:	2023-08-17	Revised by:	CW	Checked by:	RC
A - Issued for Review					
Date:		Revised by:		Checked by:	
Date:		Revised by:		Checked by:	

PREPARED BY

**Summit Carbon Solutions**  
2321 North Loop Drive, Suite 221  
Ames, Iowa 50010  
United States of America  
[www.summitcarbonsolutions.com](http://www.summitcarbonsolutions.com)



**SUMMIT CARBON**  
SOLUTIONS

PROJECT INFORMATION

Figure Title: <b>ND PSC - Aerial Map Book - NDL-324</b>	
Figure Number: <b>Map Book 1</b>	
Scale: <b>1 : 12,000</b> 1 inch equals 1,000 feet	Projection: <b>Transverse Mercator</b> NAD 1983 UTM Zone 14N
Sheet: <b>118</b> 118 of 139	Drawing Number: <b>1001-01-003</b> Revision A





VICINITY MAP



LEGEND

- Centerline Mileposts
- Water Well (Avoidance)
- Mainline Valve Location
- Domestic Structure or Business (Avoidance)
- Updated Proposed Project Route 08/15/2023
- October 17, 2023 Original PSC Application Route
- Section Line
- Access Road
- Avoidance Area
- PEM Wetland
- Stream
- 200-foot Siting Corridor



REVISIONS

Date:	2023-08-17	Revised by:	CW	Checked by:	RC
A - Issued for Review					
Date:		Revised by:		Checked by:	
Date:		Revised by:		Checked by:	

PREPARED BY

**Summit Carbon Solutions**  
2321 North Loop Drive, Suite 221  
Ames, Iowa 50010  
United States of America  
[www.summitcarbonsolutions.com](http://www.summitcarbonsolutions.com)




**SUMMIT CARBON SOLUTIONS**

PROJECT INFORMATION

Figure Title: <b>ND PSC - Aerial Map Book - NDL-324</b>	
Figure Number: <b>Map Book 1</b>	
Scale: <b>1 : 12,000</b> 1 inch equals 1,000 feet	Projection: <b>Transverse Mercator</b> NAD 1983 UTM Zone 14N
Sheet: <b>119</b> 119 of 139	Drawing Number: <b>1001-01-003</b> Revision A



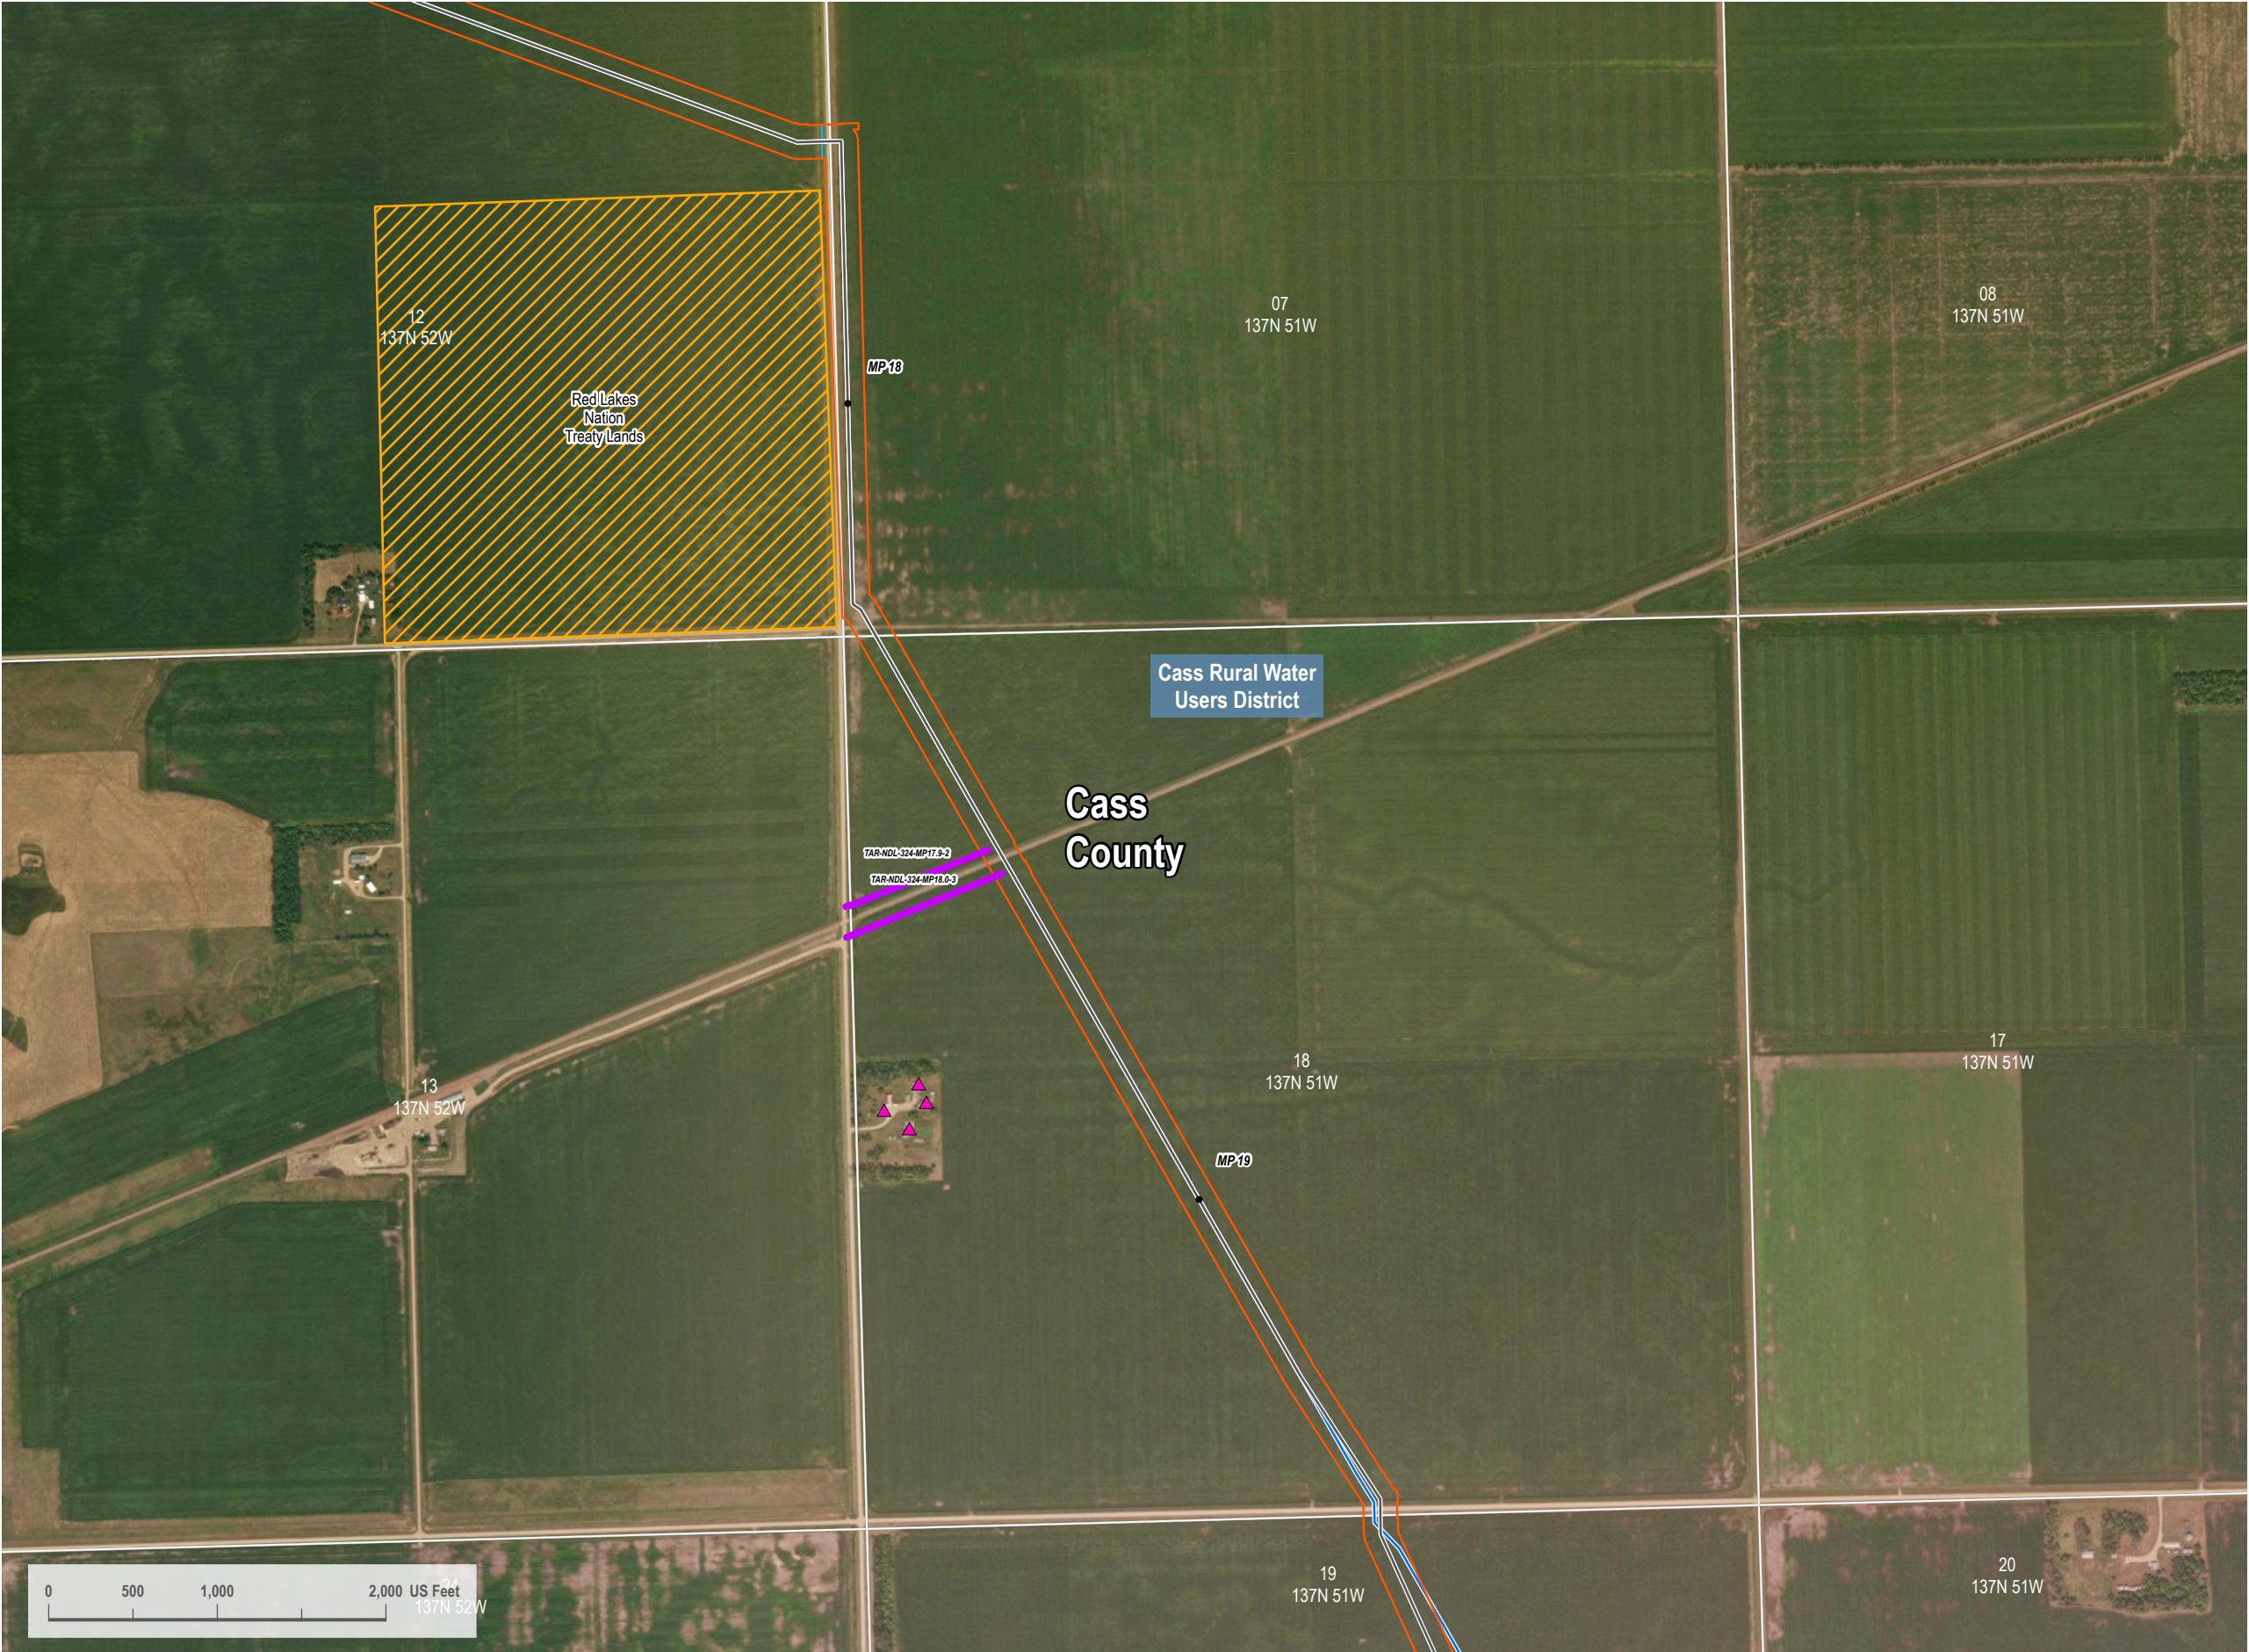

VICINITY MAP



LEGEND

- Centerline Mileposts
- Domestic Structure or Business (Avoidance)
- Updated Proposed Project Route 08/15/2023
- October 17, 2023 Original PSC Application Route
- Section Line
- Access Road
- Avoidance Area
- Stream
- 200-foot Siting Corridor



REVISIONS

Date: 2023-08-17	Revised by: CW	Checked by: RC
A - Issued for Review		
Date:	Revised by:	Checked by:
Date:	Revised by:	Checked by:

PREPARED BY

**Summit Carbon Solutions**  
2321 North Loop Drive, Suite 221  
Ames, Iowa 50010  
United States of America  
[www.summitcarbonsolutions.com](http://www.summitcarbonsolutions.com)



**SUMMIT CARBON**  
SOLUTIONS

PROJECT INFORMATION

Figure Title: <b>ND PSC - Aerial Map Book - NDL-324</b>	
Figure Number: <b>Map Book 1</b>	
Scale: <b>1 : 12,000</b> 1 inch equals 1,000 feet	Projection: <b>Transverse Mercator</b> NAD 1983 UTM Zone 14N
Sheet: <b>120</b> 120 of 139	Drawing Number: <b>1001-01-003</b> Revision A





VICINITY MAP



LEGEND

- Centerline Mileposts
- Water Well (Avoidance)
- Domestic Structure or Business (Avoidance)
- Updated Proposed Project Route 08/15/2023
- October 17, 2023 Original PSC Application Route
- Section Line
- PEM Wetland
- 200-foot Siting Corridor



REVISIONS

Date: 2023-08-17	Revised by: CW	Checked by: RC
A - Issued for Review		
Date:	Revised by:	Checked by:
Date:	Revised by:	Checked by:

PREPARED BY

**Summit Carbon Solutions**  
2321 North Loop Drive, Suite 221  
Ames, Iowa 50010  
United States of America  
[www.summitcarbonsolutions.com](http://www.summitcarbonsolutions.com)




**SUMMIT CARBON**  
SOLUTIONS

PROJECT INFORMATION

Figure Title: <b>ND PSC - Aerial Map Book - NDL-324</b>	
Figure Number: <b>Map Book 1</b>	
Scale: <b>1 : 12,000</b> 1 inch equals 1,000 feet	Projection: <b>Transverse Mercator</b> NAD 1983 UTM Zone 14N
Sheet: <b>121</b> 121 of 139	Drawing Number: <b>1001-01-003</b> Revision A



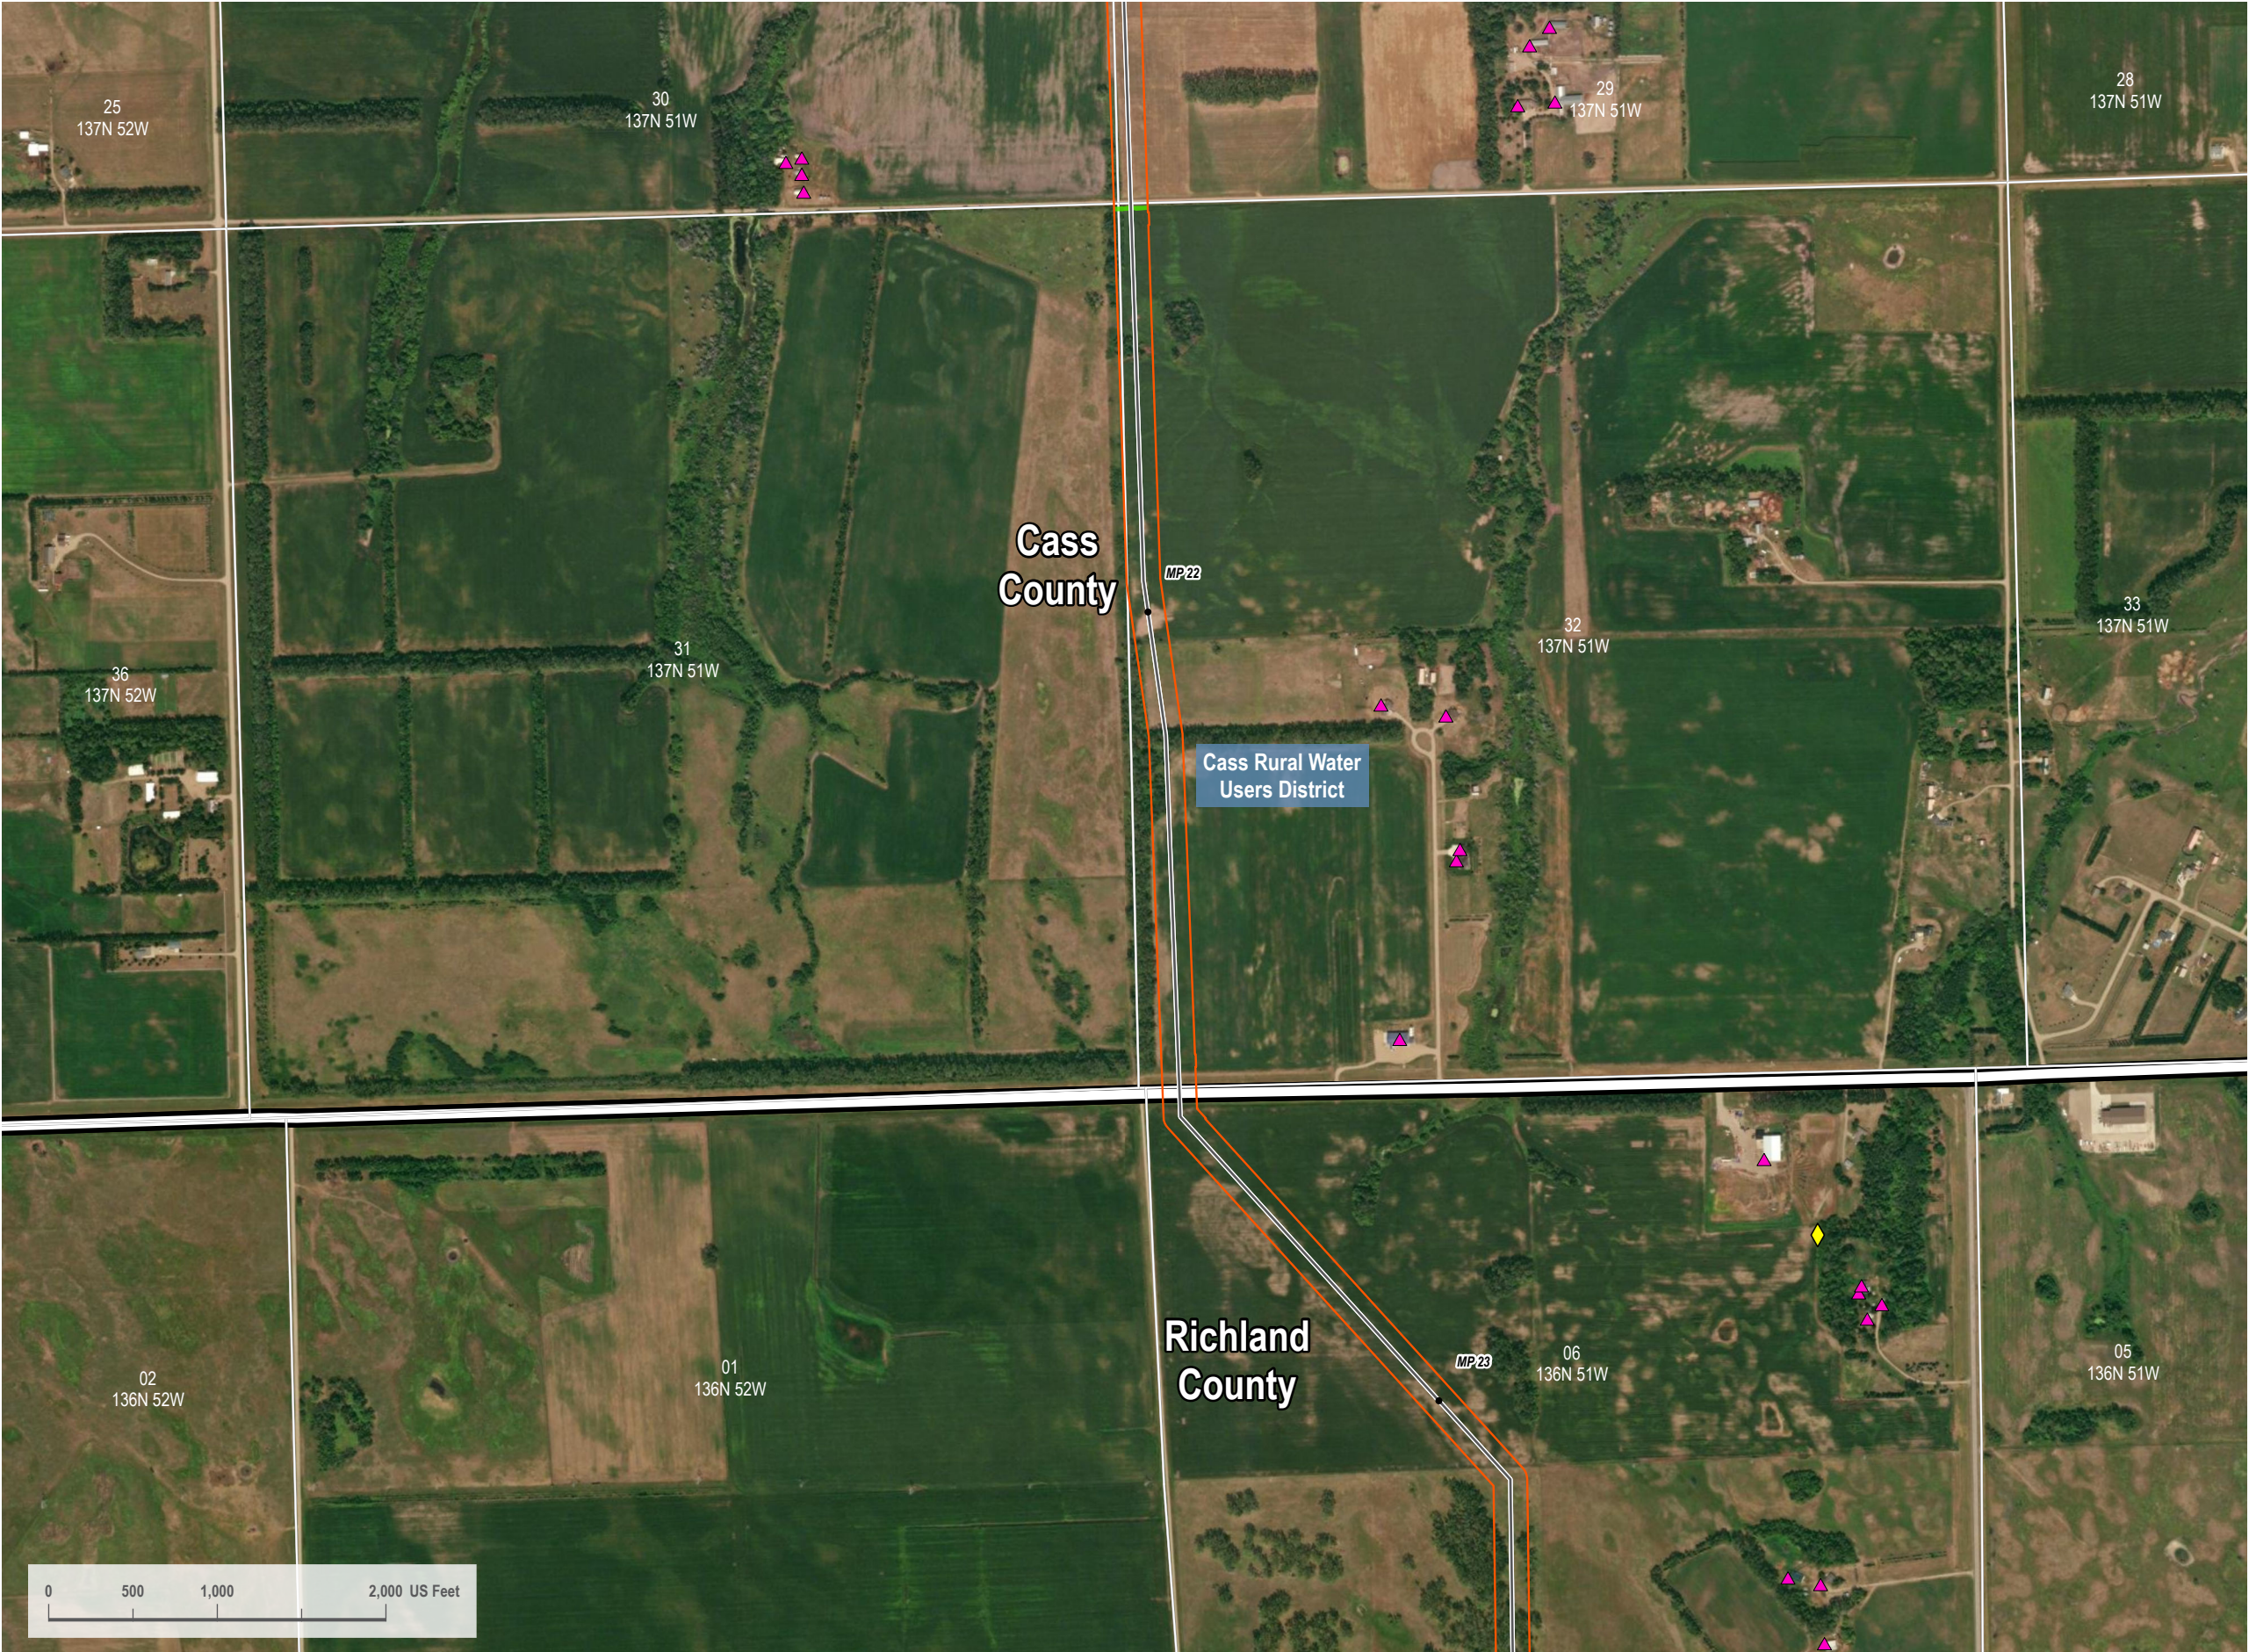


VICINITY MAP



LEGEND

- Centerline Mileposts
- Water Well (Avoidance)
- Domestic Structure or Business (Avoidance)
- Updated Proposed Project Route 08/15/2023
- October 17, 2023 Original PSC Application Route
- Section Line
- PEM Wetland
- 200-foot Siting Corridor

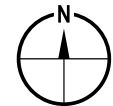

REVISIONS

Date: 2023-08-17	Revised by: CW	Checked by: RC
A - Issued for Review		
Date:	Revised by:	Checked by:
Date:	Revised by:	Checked by:

PREPARED BY

**Summit Carbon Solutions**  
2321 North Loop Drive, Suite 221  
Ames, Iowa 50010  
United States of America  
[www.summitcarbonsolutions.com](http://www.summitcarbonsolutions.com)



**SUMMIT CARBON**  
SOLUTIONS

PROJECT INFORMATION

Figure Title: <b>ND PSC - Aerial Map Book - NDL-324</b>	
Figure Number: <b>Map Book 1</b>	
Scale: <b>1 : 12,000</b> 1 inch equals 1,000 feet	Projection: <b>Transverse Mercator</b> NAD 1983 UTM Zone 14N
Sheet: <b>122</b> 122 of 139	Drawing Number: <b>1001-01-003</b> Revision A





VICINITY MAP



LEGEND

- Centerline Mileposts
- Mainline Valve Location
- Domestic Structure or Business (Avoidance)
- Updated Proposed Project Route 08/15/2023
- October 17, 2023 Original PSC Application Route
- Section Line
- Access Road
- PEM Wetland
- 200-foot Siting Corridor



REVISIONS

Date:	2023-08-17	Revised by:	CW	Checked by:	RC
A - Issued for Review					
Date:		Revised by:		Checked by:	
Date:		Revised by:		Checked by:	

PREPARED BY

**Summit Carbon Solutions**  
2321 North Loop Drive, Suite 221  
Ames, Iowa 50010  
United States of America  
[www.summitcarbonsolutions.com](http://www.summitcarbonsolutions.com)



**SUMMIT CARBON**  
SOLUTIONS

PROJECT INFORMATION

Figure Title: <b>ND PSC - Aerial Map Book - NDL-324</b>	
Figure Number: <b>Map Book 1</b>	
Scale: <b>1 : 12,000</b> 1 inch equals 1,000 feet	Projection: <b>Transverse Mercator</b> NAD 1983 UTM Zone 14N
Sheet: <b>123</b> 123 of 139	Drawing Number: <b>1001-01-003</b> Revision A





VICINITY MAP



LEGEND

- Centerline Mileposts
- Mainline Valve Location
- Domestic Structure or Business (Avoidance)
- Updated Proposed Project Route 08/15/2023
- October 17, 2023 Original PSC Application Route
- Section Line
- Access Road
- Avoidance Area
- Open Water
- PEM Wetland
- 200-foot Siting Corridor
- Conservation Easement



REVISIONS

Date:	2023-08-17	Revised by:	CW	Checked by:	RC
A - Issued for Review					
Date:		Revised by:		Checked by:	
Date:		Revised by:		Checked by:	

PREPARED BY

**Summit Carbon Solutions**  
2321 North Loop Drive, Suite 221  
Ames, Iowa 50010  
United States of America  
[www.summitcarbonsolutions.com](http://www.summitcarbonsolutions.com)

PROJECT INFORMATION

Figure Title: <b>ND PSC - Aerial Map Book - NDL-324</b>	
Figure Number: <b>Map Book 1</b>	
Scale: <b>1 : 12,000</b> 1 inch equals 1,000 feet	Projection: <b>Transverse Mercator</b> NAD 1983 UTM Zone 14N
Sheet: <b>124</b> 124 of 139	Drawing Number: <b>1001-01-003</b> Revision A





LEGEND

HDD Entry/Exit	Stream
Centerline Mileposts	200-foot Siting Corridor
Updated Proposed Project Route 08/15/2023	
October 17, 2023 Original PSC Application Route	
Section Line	
Landside Deposit (Avoidance)	

N

REVISIONS		
Date: 2023-08-17	Revised by: CW	Checked by: RC
A - Issued for Review		
Date:	Revised by:	Checked by:
Date:	Revised by:	Checked by:

PREPARED BY


**Summit Carbon Solutions**

2321 North Loop Drive, Suite 221  
Ames, Iowa 50010  
United States of America

[www.summitcarbonsolutions.com](http://www.summitcarbonsolutions.com)

PROJECT INFORMATION	
Figure Title:	ND PSC - Aerial Map Book - NDL-324
Figure Number:	Map Book 1
Scale:	Projection:
1 : 12,000	Transverse Mercator
1 inch equals 1,000 feet	NAD 1983 UTM Zone 14N
Sheet:	Drawing Number:
125	1001-01-003
125 of 139	Revision A



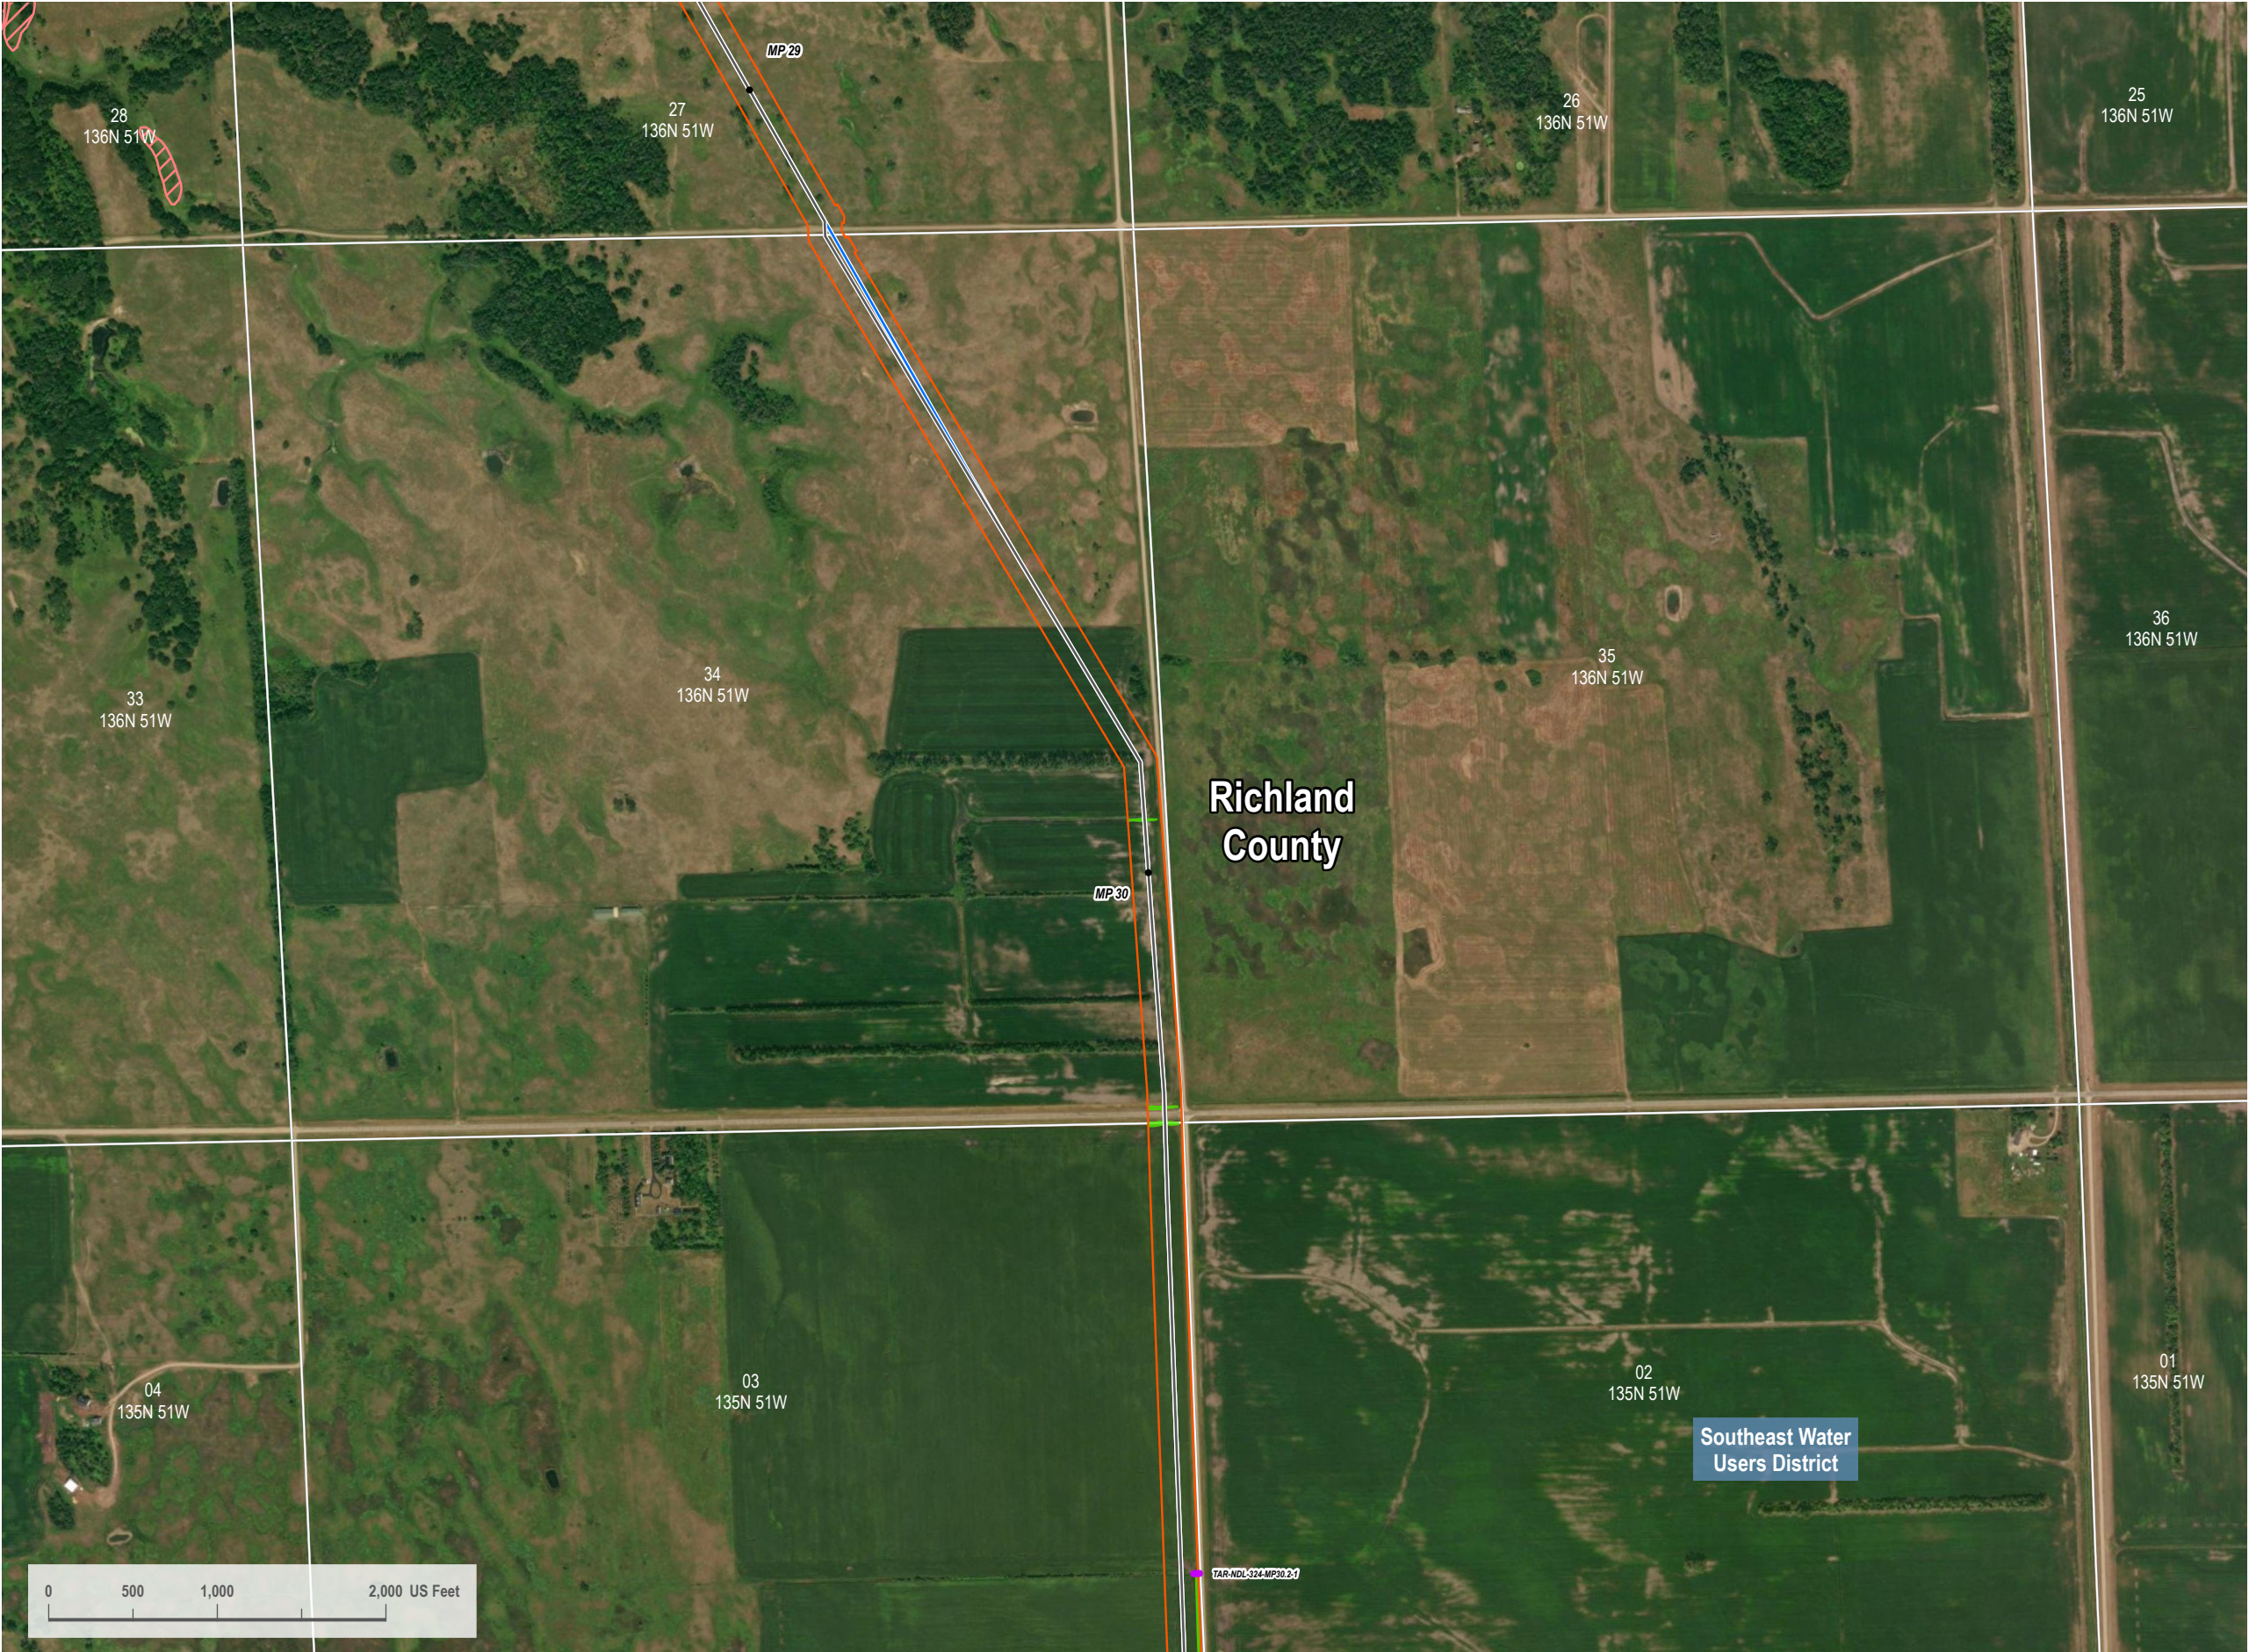


VICINITY MAP



LEGEND

- Centerline Mileposts
- Updated Proposed Project Route 08/15/2023
- October 17, 2023 Original PSC Application Route
- Section Line
- Access Road
- Landslide Deposit (Avoidance)
- PEM Wetland
- 200-foot Siting Corridor

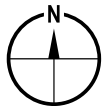

REVISIONS

Date:	2023-08-17	Revised by:	CW	Checked by:	RC
A - Issued for Review					
Date:		Revised by:		Checked by:	
Date:		Revised by:		Checked by:	

PREPARED BY

**Summit Carbon Solutions**  
2321 North Loop Drive, Suite 221  
Ames, Iowa 50010  
United States of America  
[www.summitcarbonsolutions.com](http://www.summitcarbonsolutions.com)




**SUMMIT CARBON**  
SOLUTIONS

PROJECT INFORMATION

Figure Title: <b>ND PSC - Aerial Map Book - NDL-324</b>	
Figure Number: <b>Map Book 1</b>	
Scale: <b>1 : 12,000</b> 1 inch equals 1,000 feet	Projection: <b>Transverse Mercator</b> NAD 1983 UTM Zone 14N
Sheet: <b>126</b> 126 of 139	Drawing Number: <b>1001-01-003</b> Revision A



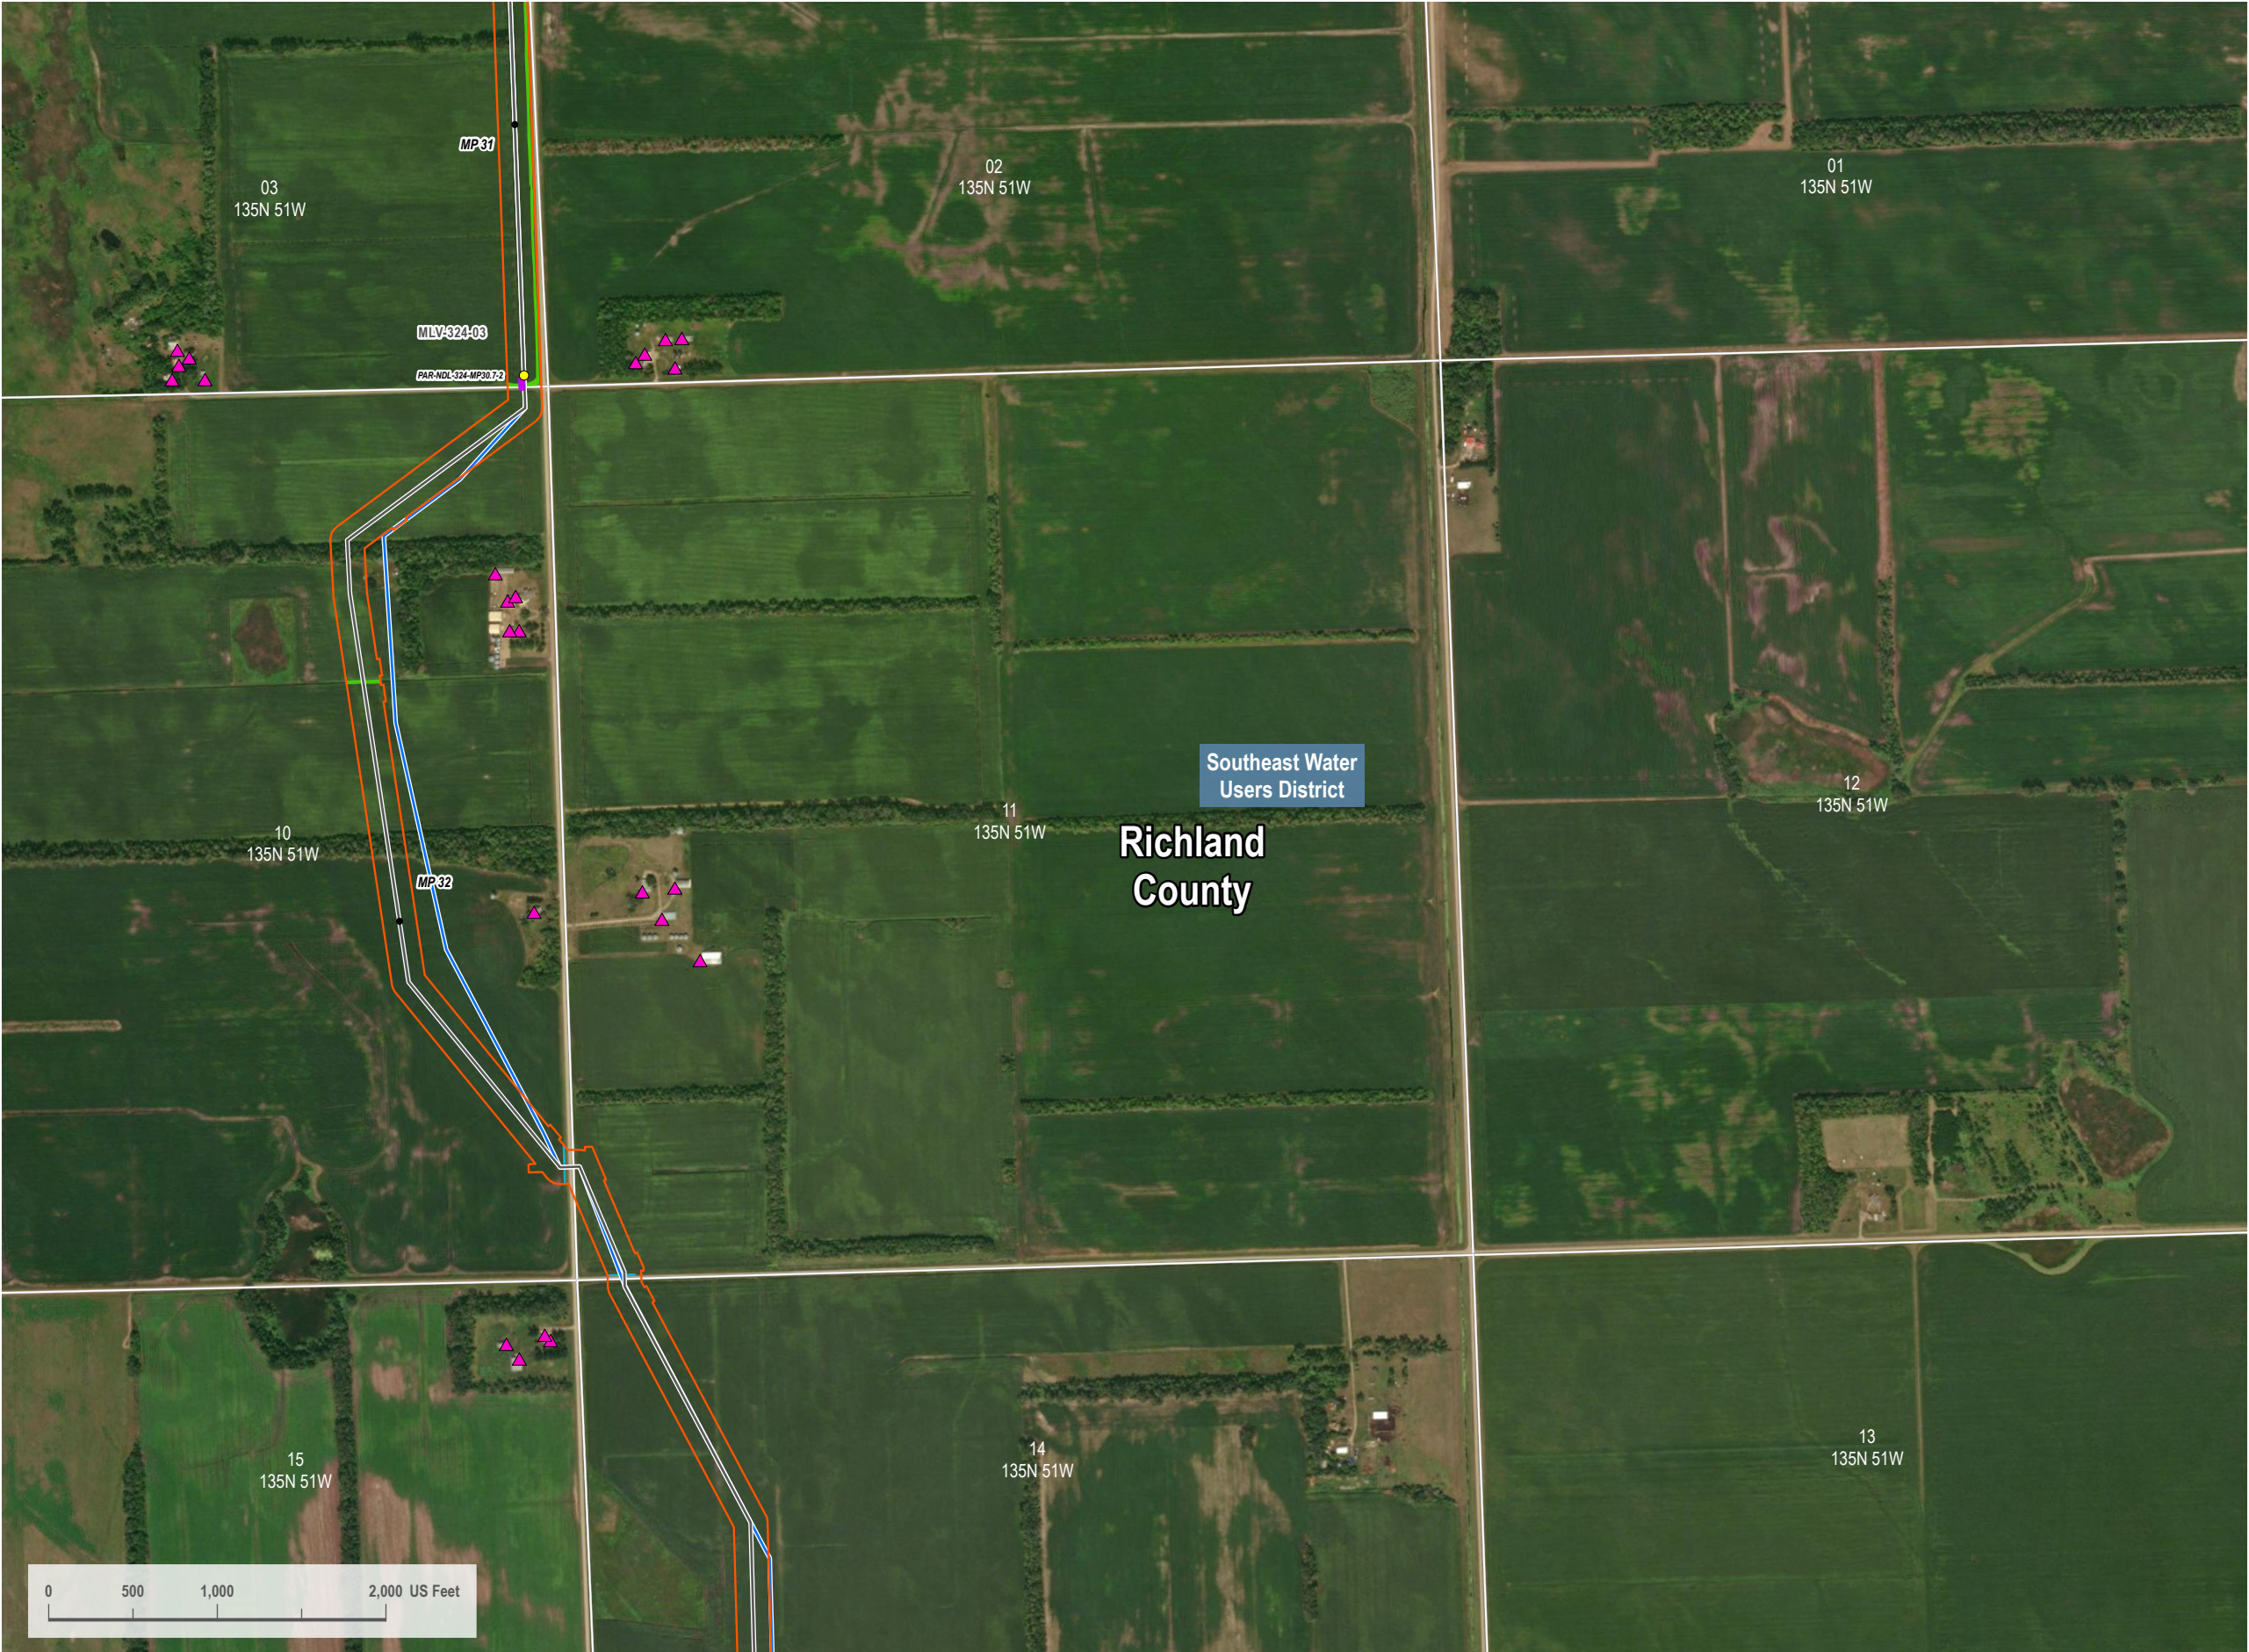


VICINITY MAP



LEGEND

- Centerline Mileposts
- Mainline Valve Location
- Domestic Structure or Business (Avoidance)
- Updated Proposed Project Route 08/15/2023
- October 17, 2023 Original PSC Application Route
- Section Line
- Access Road
- PEM Wetland
- Stream
- 200-foot Siting Corridor

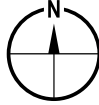

REVISIONS

Date:	2023-08-17	Revised by:	CW	Checked by:	RC
A - Issued for Review					
Date:		Revised by:		Checked by:	
Date:		Revised by:		Checked by:	

PREPARED BY

**Summit Carbon Solutions**  
2321 North Loop Drive, Suite 221  
Ames, Iowa 50010  
United States of America  
[www.summitcarbonsolutions.com](http://www.summitcarbonsolutions.com)




**SUMMIT CARBON**  
SOLUTIONS

PROJECT INFORMATION

Figure Title: <b>ND PSC - Aerial Map Book - NDL-324</b>	
Figure Number: <b>Map Book 1</b>	
Scale: <b>1 : 12,000</b> 1 inch equals 1,000 feet	Projection: <b>Transverse Mercator</b> NAD 1983 UTM Zone 14N
Sheet: <b>127</b> 127 of 139	Drawing Number: <b>1001-01-003</b> Revision A



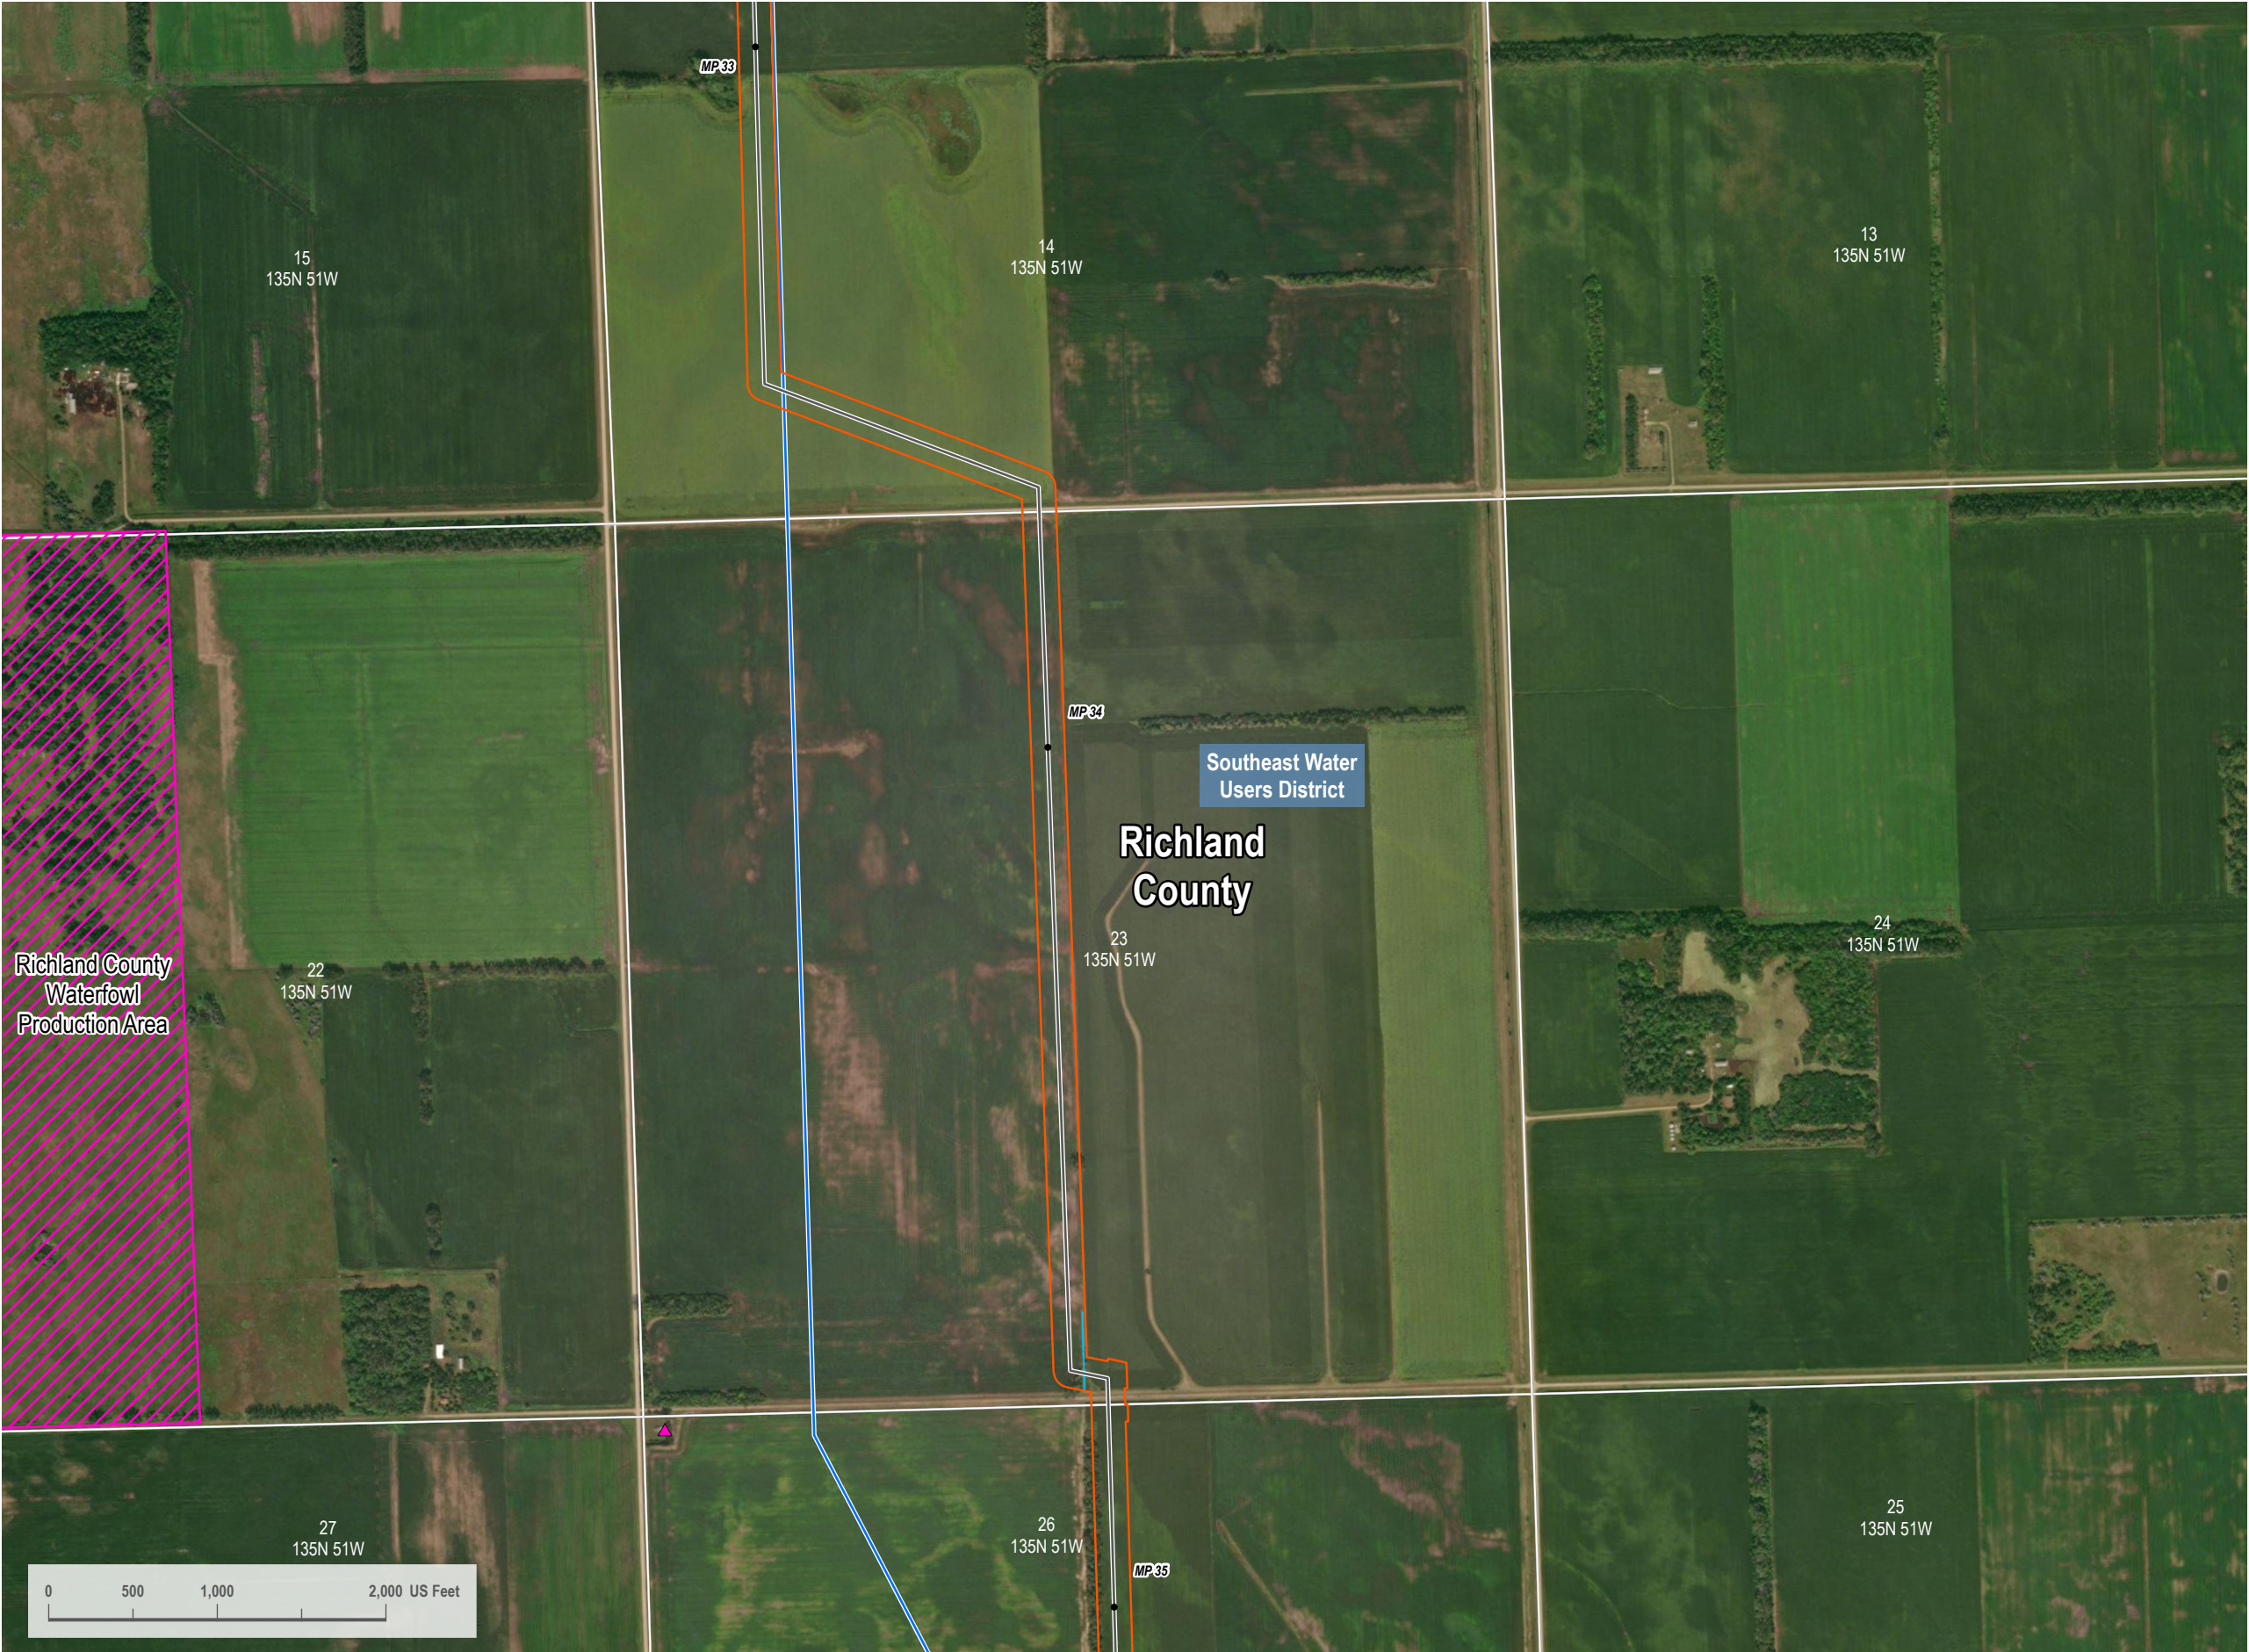

VICINITY MAP



LEGEND

- Centerline Mileposts
- Domestic Structure or Business (Avoidance)
- Updated Proposed Project Route 08/15/2023
- October 17, 2023 Original PSC Application Route
- Section Line
- Stream
- 200-foot Siting Corridor
- Conservation Easement



REVISIONS

Date:	2023-08-17	Revised by:	CW	Checked by:	RC
A - Issued for Review					
Date:		Revised by:		Checked by:	
Date:		Revised by:		Checked by:	

PREPARED BY

**Summit Carbon Solutions**  
2321 North Loop Drive, Suite 221  
Ames, Iowa 50010  
United States of America  
[www.summitcarbonsolutions.com](http://www.summitcarbonsolutions.com)




**SUMMIT CARBON**  
SOLUTIONS

PROJECT INFORMATION

Figure Title: <b>ND PSC - Aerial Map Book - NDL-324</b>	
Figure Number: <b>Map Book 1</b>	
Scale: <b>1 : 12,000</b> 1 inch equals 1,000 feet	Projection: <b>Transverse Mercator</b> NAD 1983 UTM Zone 14N
Sheet: <b>128</b> 128 of 139	Drawing Number: <b>1001-01-003</b> Revision A



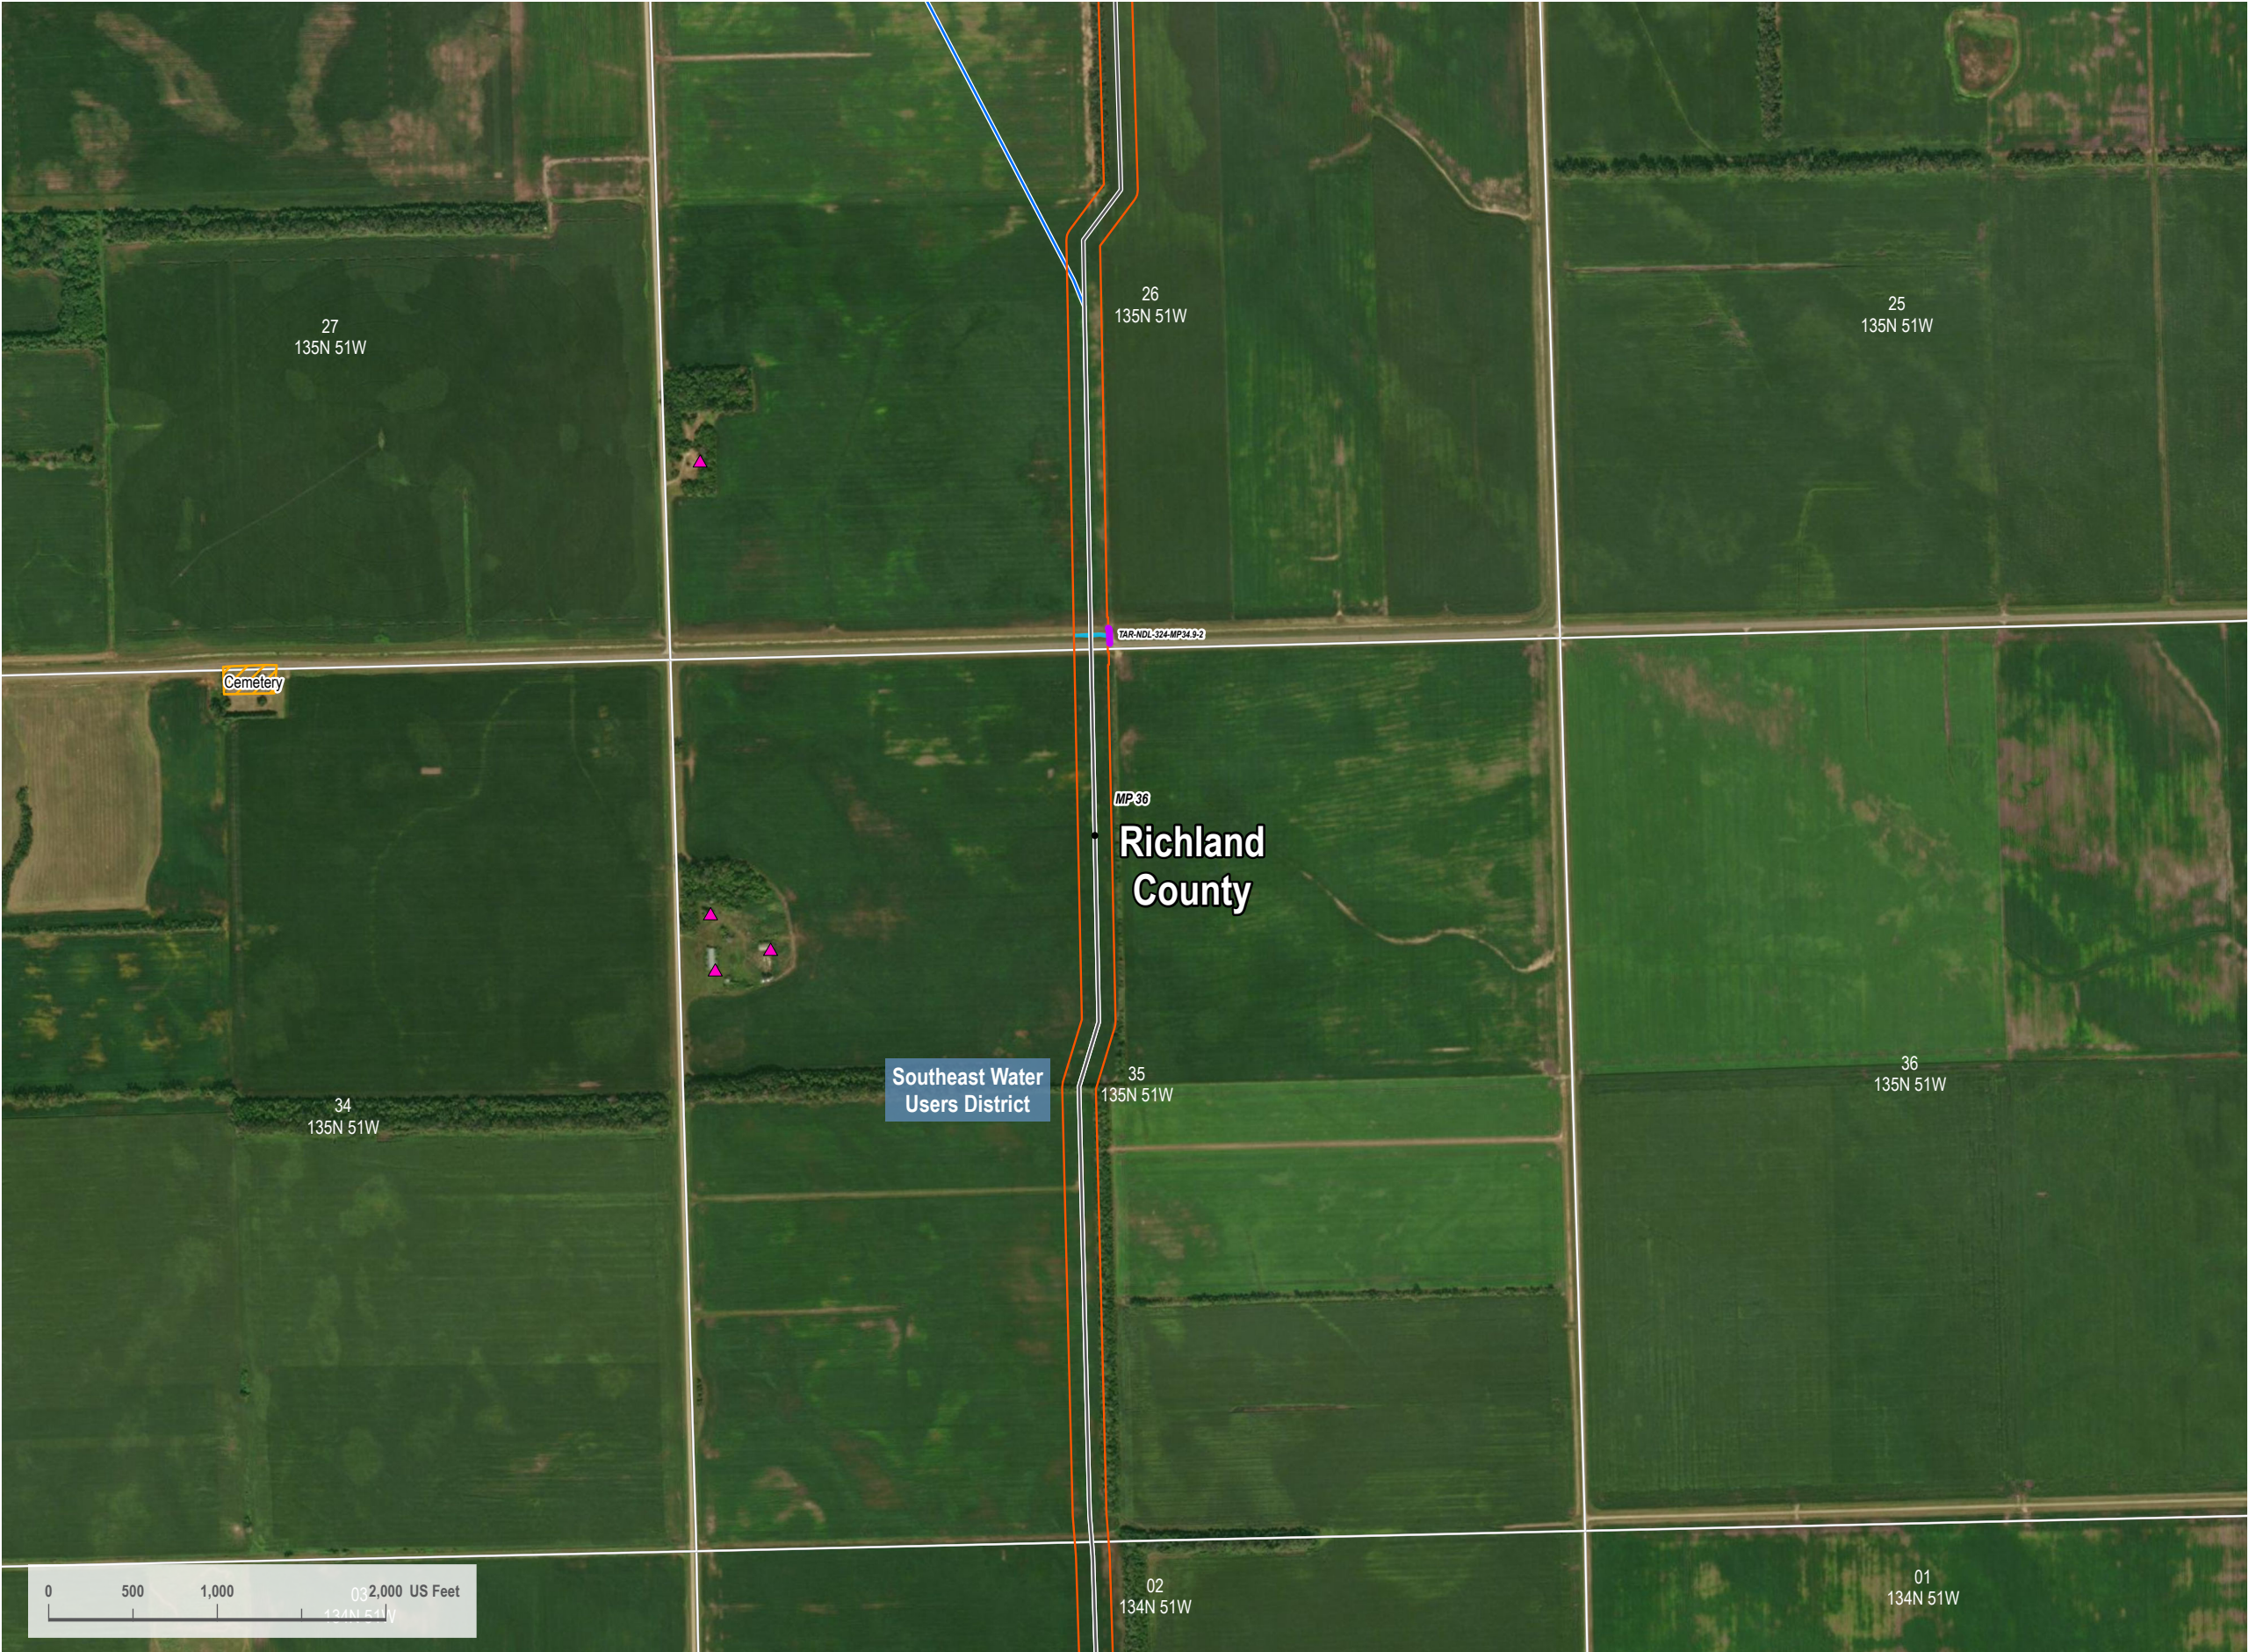


VICINITY MAP



LEGEND

- Centerline Mileposts
- Domestic Structure or Business (Avoidance)
- Updated Proposed Project Route 08/15/2023
- October 17, 2023 Original PSC Application Route
- Section Line
- Access Road
- Avoidance Area
- Stream
- 200-foot Siting Corridor

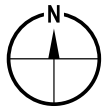

REVISIONS

Date: 2023-08-17	Revised by: CW	Checked by: RC
A - Issued for Review		
Date:	Revised by:	Checked by:
Date:	Revised by:	Checked by:

PREPARED BY

**Summit Carbon Solutions**  
2321 North Loop Drive, Suite 221  
Ames, Iowa 50010  
United States of America  
[www.summitcarbonsolutions.com](http://www.summitcarbonsolutions.com)




**SUMMIT CARBON**  
SOLUTIONS

PROJECT INFORMATION

Figure Title: <b>ND PSC - Aerial Map Book - NDL-324</b>	
Figure Number: <b>Map Book 1</b>	
Scale: <b>1 : 12,000</b> 1 inch equals 1,000 feet	Projection: <b>Transverse Mercator</b> NAD 1983 UTM Zone 14N
Sheet: <b>129</b> 129 of 139	Drawing Number: <b>1001-01-003</b> Revision A



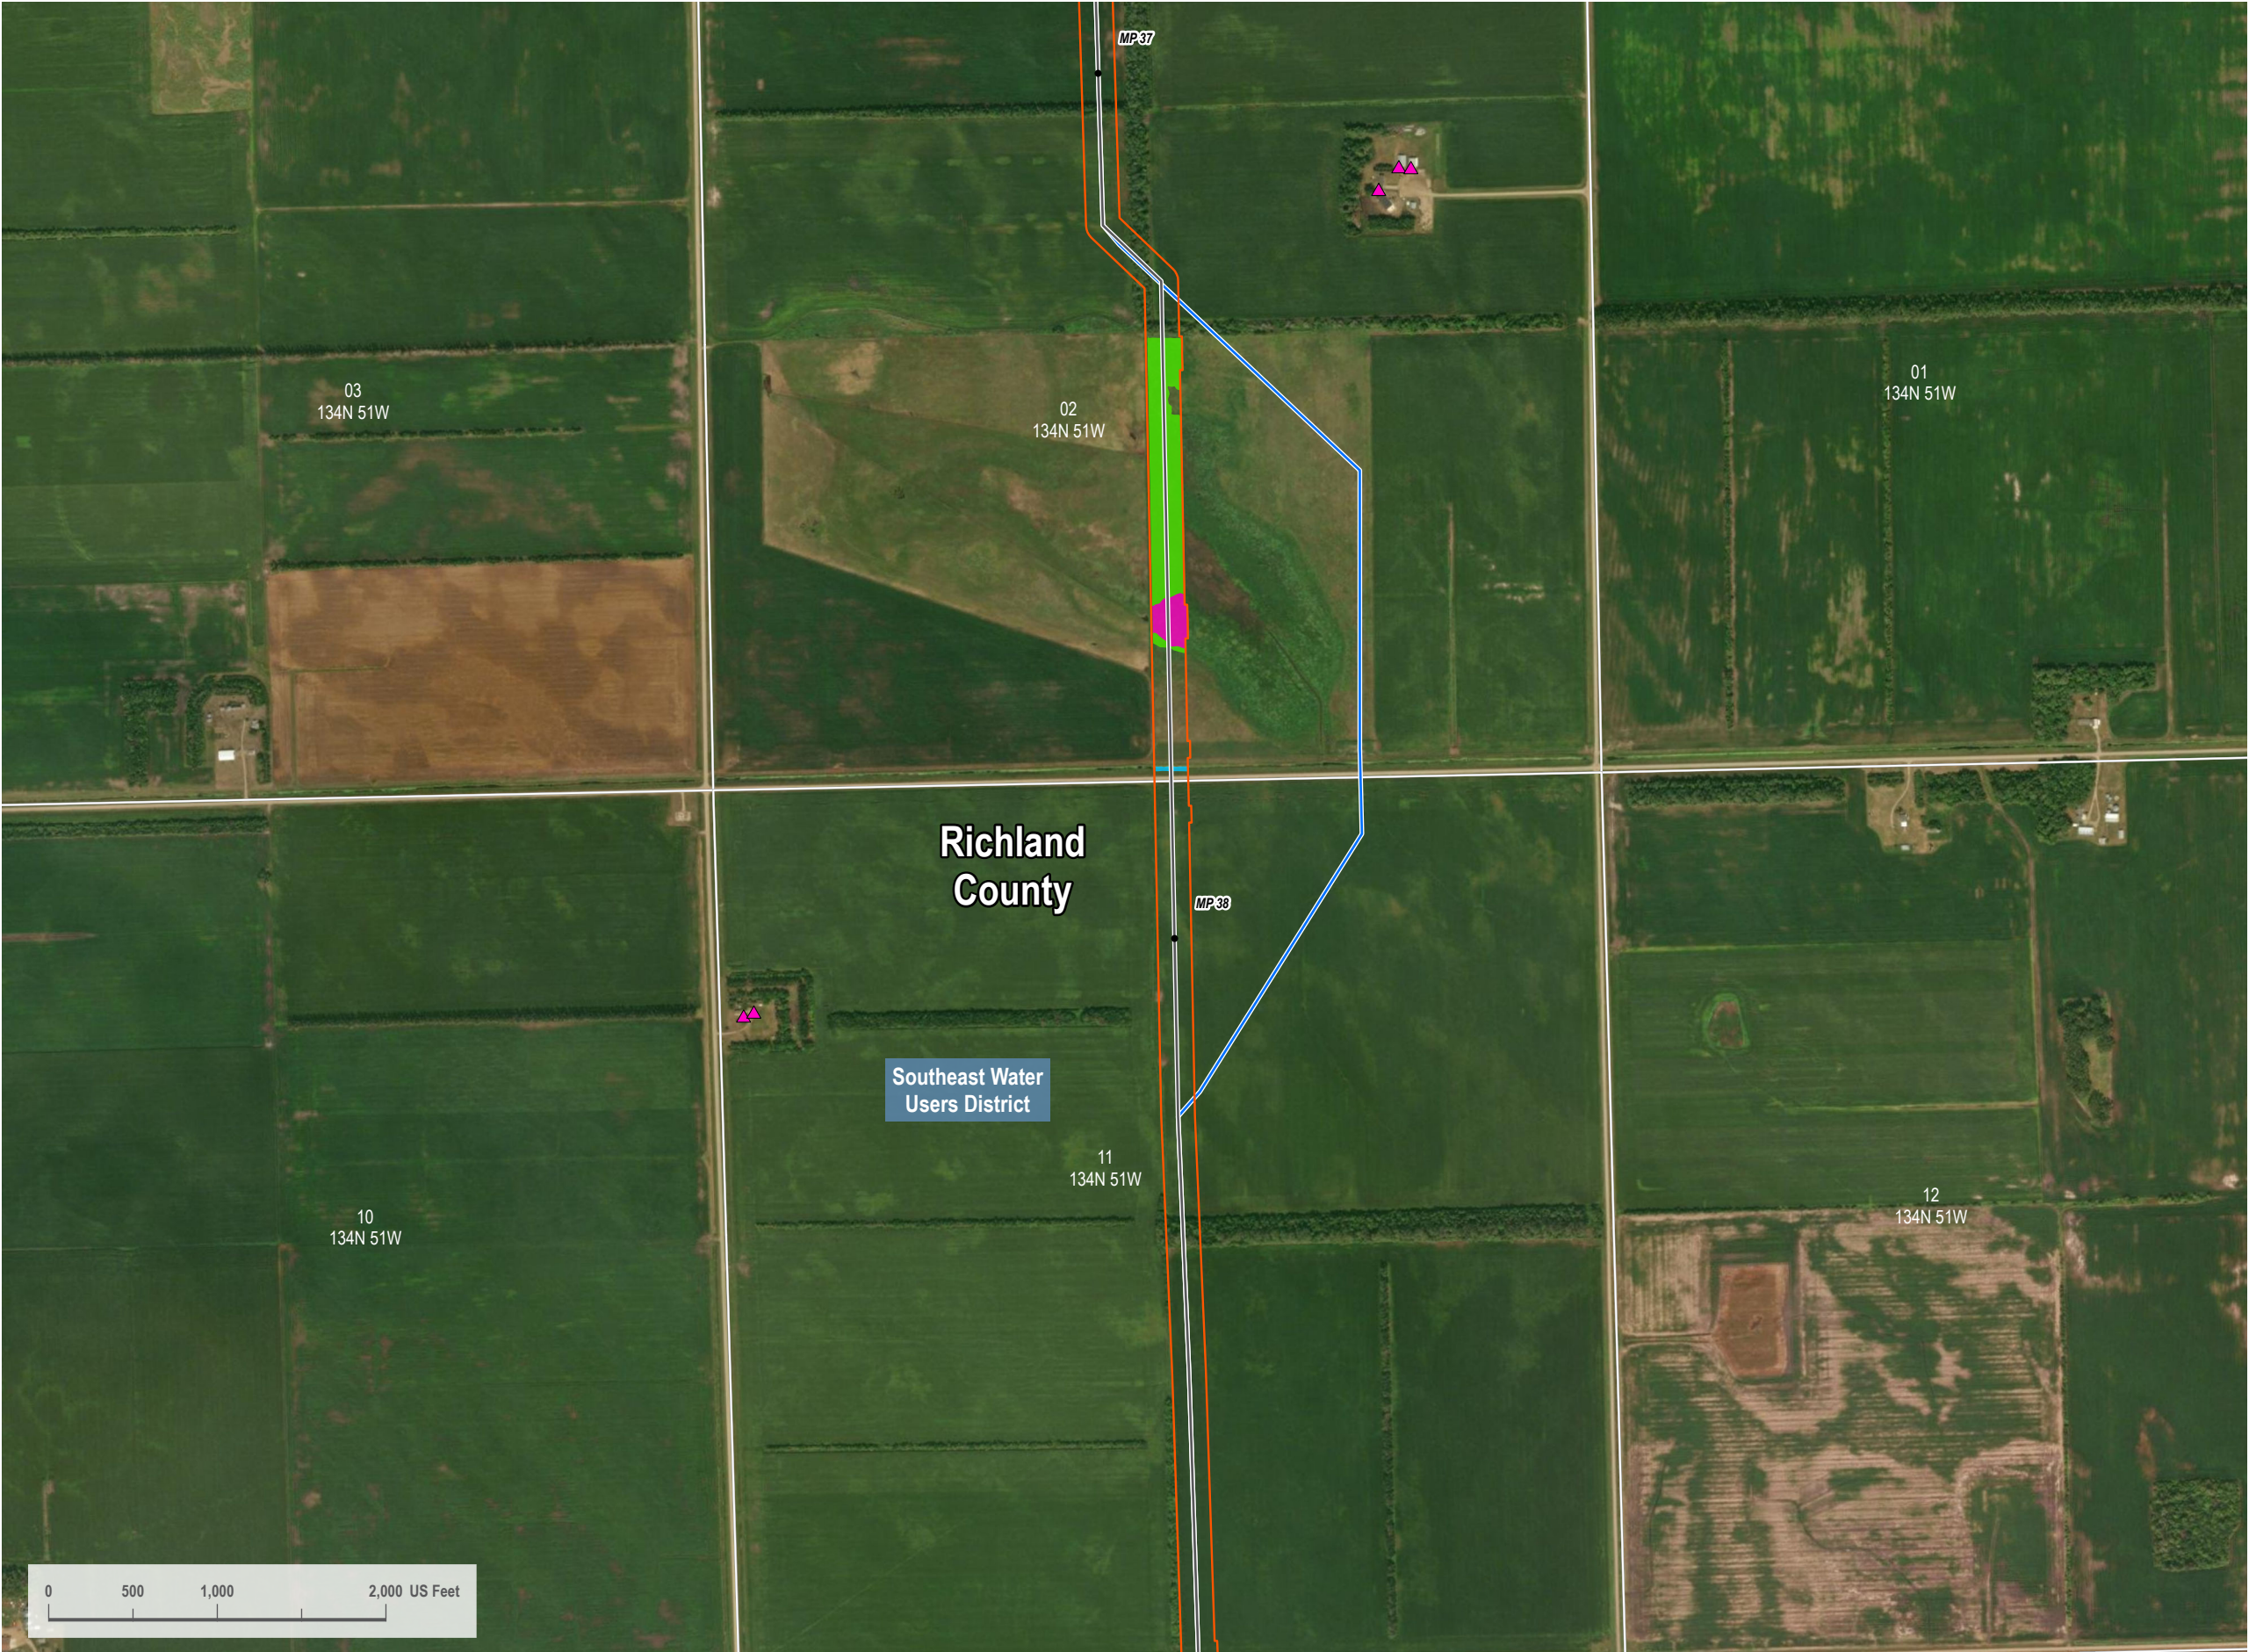


VICINITY MAP



LEGEND

- Centerline Mileposts
- Domestic Structure or Business (Avoidance)
- Updated Proposed Project Route 08/15/2023
- October 17, 2023 Original PSC Application Route
- Section Line
- PEM Wetland
- PSS Wetland
- Stream
- 200-foot Siting Corridor

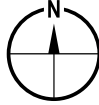

REVISIONS

Date:	2023-08-17	Revised by:	CW	Checked by:	RC
A - Issued for Review					
Date:		Revised by:		Checked by:	
Date:		Revised by:		Checked by:	

PREPARED BY

**Summit Carbon Solutions**  
2321 North Loop Drive, Suite 221  
Ames, Iowa 50010  
United States of America  
[www.summitcarbonsolutions.com](http://www.summitcarbonsolutions.com)



**SUMMIT CARBON**  
SOLUTIONS

PROJECT INFORMATION

Figure Title: <b>ND PSC - Aerial Map Book - NDL-324</b>	
Figure Number: <b>Map Book 1</b>	
Scale: <b>1 : 12,000</b> 1 inch equals 1,000 feet	Projection: <b>Transverse Mercator</b> NAD 1983 UTM Zone 14N
Sheet: <b>130</b> 130 of 139	Drawing Number: <b>1001-01-003</b> Revision A






VICINITY MAP



LEGEND

- Centerline Mileposts
- Domestic Structure or Business (Avoidance)
- Updated Proposed Project Route 08/15/2023
- October 17, 2023 Original PSC Application Route
- Section Line
- PEM Wetland
- Stream
- 200-foot Stiling Corridor

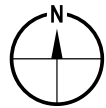

REVISIONS

Date:	2023-08-17	Revised by:	CW	Checked by:	RC
A - Issued for Review					
Date:		Revised by:		Checked by:	
Date:		Revised by:		Checked by:	

PREPARED BY

**Summit Carbon Solutions**  
2321 North Loop Drive, Suite 221  
Ames, Iowa 50010  
United States of America  
[www.summitcarbonsolutions.com](http://www.summitcarbonsolutions.com)




**SUMMIT CARBON**  
SOLUTIONS

PROJECT INFORMATION

Figure Title: <b>ND PSC - Aerial Map Book - NDL-324</b>	
Figure Number: <b>Map Book 1</b>	
Scale: <b>1 : 12,000</b> 1 inch equals 1,000 feet	Projection: <b>Transverse Mercator</b> NAD 1983 UTM Zone 14N
Sheet: <b>131</b> 131 of 139	Drawing Number: <b>1001-01-003</b> Revision A



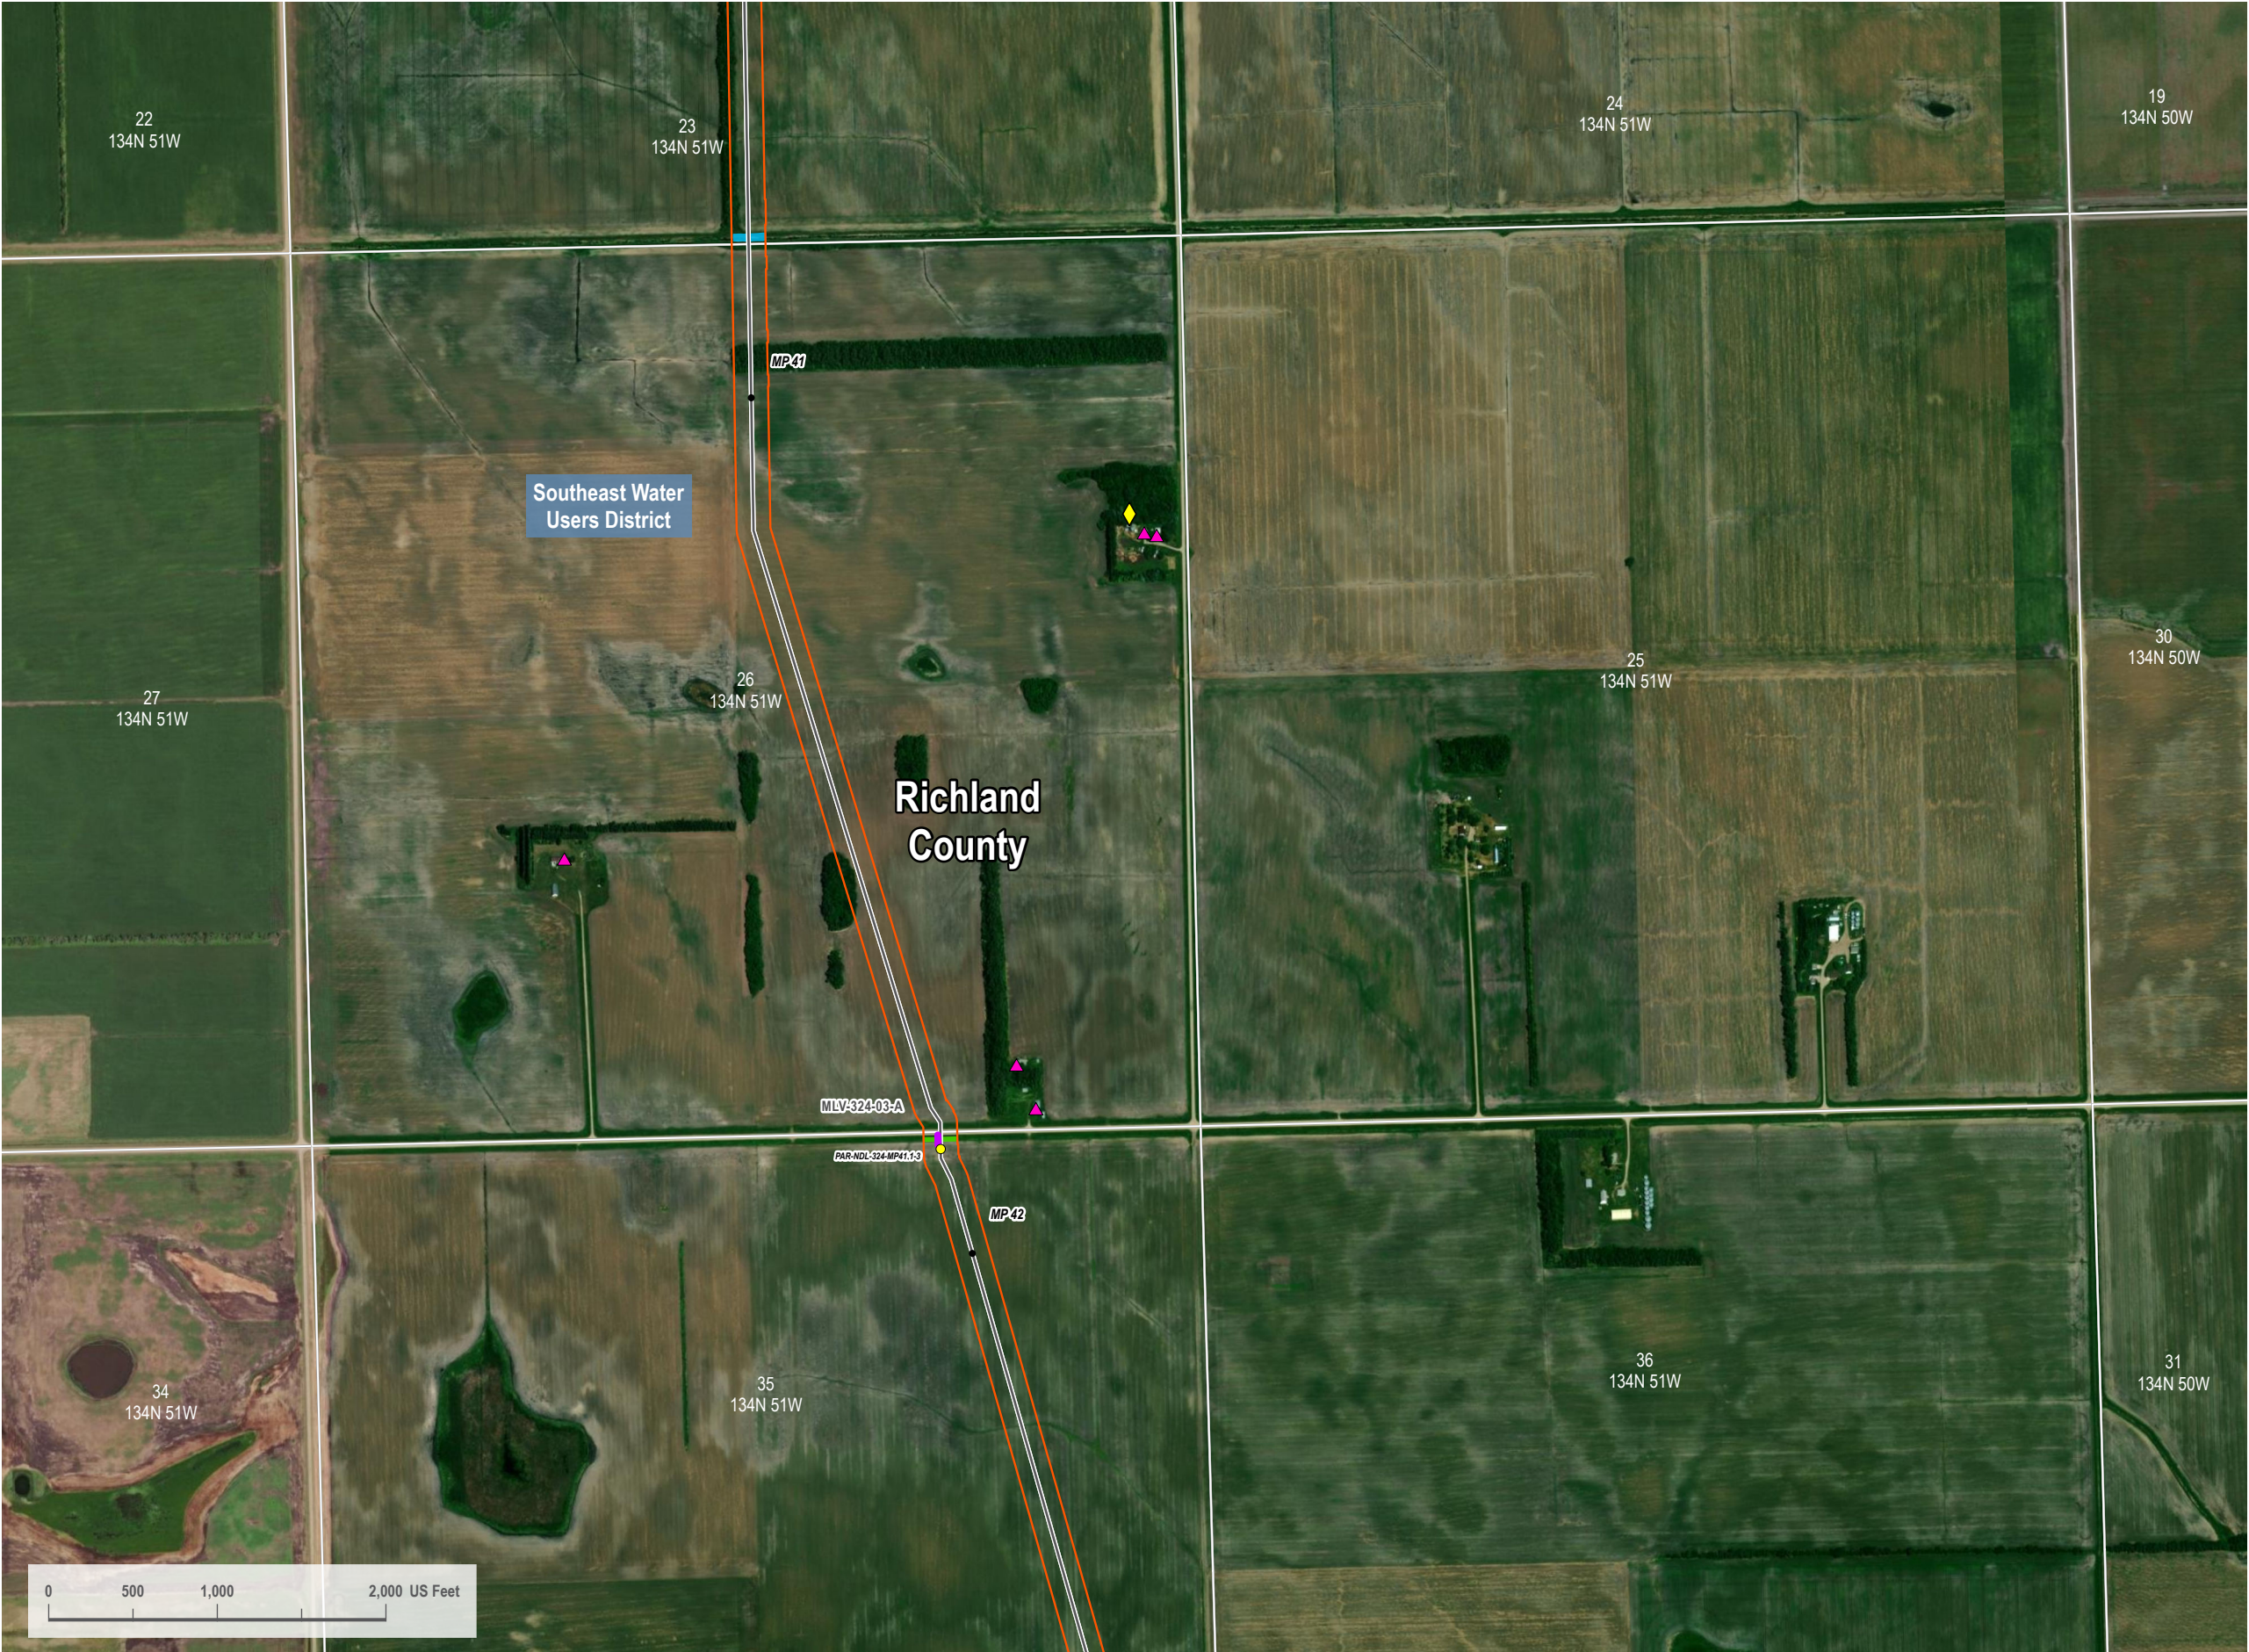

VICINITY MAP



LEGEND

- Centerline Mileposts
- Water Well (Avoidance)
- Mainline Valve Location
- Domestic Structure or Business (Avoidance)
- Updated Proposed Project Route 08/15/2023
- October 17, 2023 Original PSC Application Route
- Section Line
- Access Road
- PEM Wetland
- Stream
- 200-foot Siting Corridor



REVISIONS

Date: 2023-08-17	Revised by: CW	Checked by: RC
A - Issued for Review		
Date:	Revised by:	Checked by:
Date:	Revised by:	Checked by:

PREPARED BY

**Summit Carbon Solutions**  
2321 North Loop Drive, Suite 221  
Ames, Iowa 50010  
United States of America  
[www.summitcarbonsolutions.com](http://www.summitcarbonsolutions.com)




**SUMMIT CARBON**  
SOLUTIONS

PROJECT INFORMATION

Figure Title: <b>ND PSC - Aerial Map Book - NDL-324</b>	
Figure Number: <b>Map Book 1</b>	
Scale: <b>1 : 12,000</b> 1 inch equals 1,000 feet	Projection: <b>Transverse Mercator</b> NAD 1983 UTM Zone 14N
Sheet: <b>132</b> 132 of 139	Drawing Number: <b>1001-01-003</b> Revision A



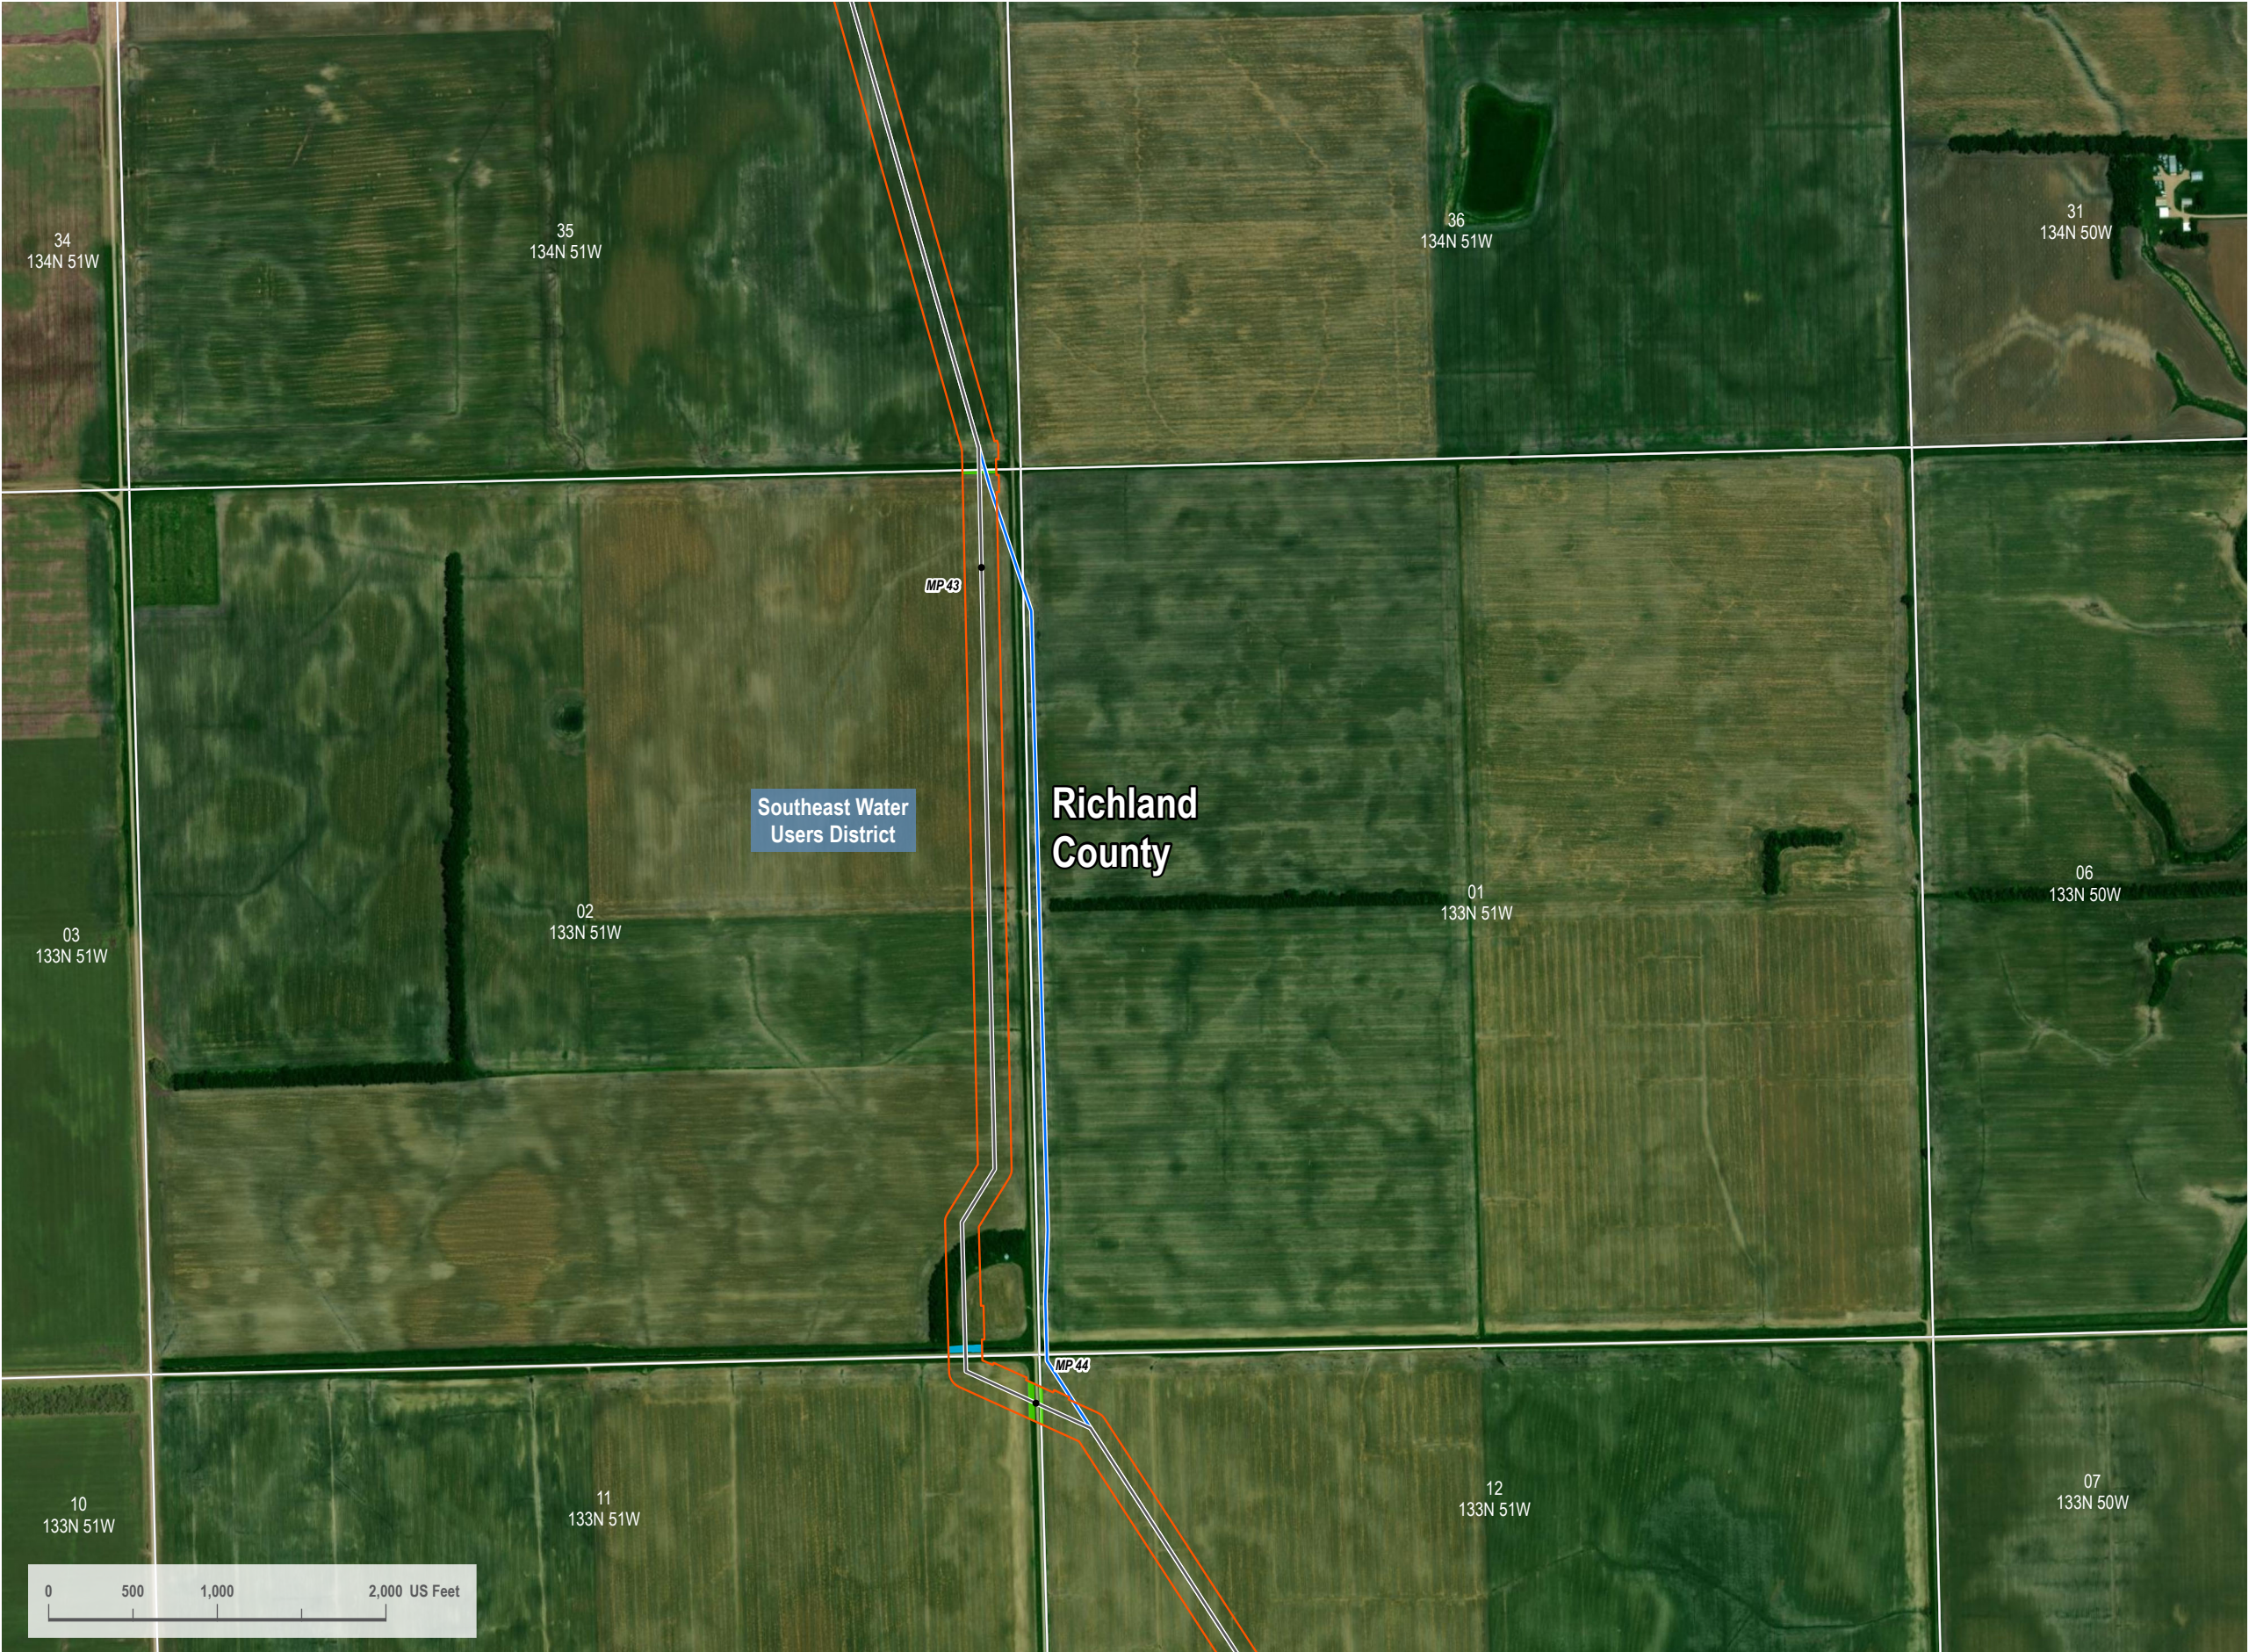

VICINITY MAP



LEGEND

- Centerline Mileposts
- Updated Proposed Project Route 08/15/2023
- October 17, 2023 Original PSC Application Route
- Section Line
- PEM Wetland
- Stream
- 200-foot Stiling Corridor



REVISIONS

Date:	2023-08-17	Revised by:	CW	Checked by:	RC
A - Issued for Review					
Date:		Revised by:		Checked by:	
Date:		Revised by:		Checked by:	

PREPARED BY

**Summit Carbon Solutions**  
2321 North Loop Drive, Suite 221  
Ames, Iowa 50010  
United States of America  
[www.summitcarbonsolutions.com](http://www.summitcarbonsolutions.com)




**SUMMIT CARBON**  
SOLUTIONS

PROJECT INFORMATION

Figure Title: <b>ND PSC - Aerial Map Book - NDL-324</b>	
Figure Number: <b>Map Book 1</b>	
Scale: <b>1 : 12,000</b> 1 inch equals 1,000 feet	Projection: <b>Transverse Mercator</b> NAD 1983 UTM Zone 14N
Sheet: <b>133</b> 133 of 139	Drawing Number: <b>1001-01-003</b> Revision A



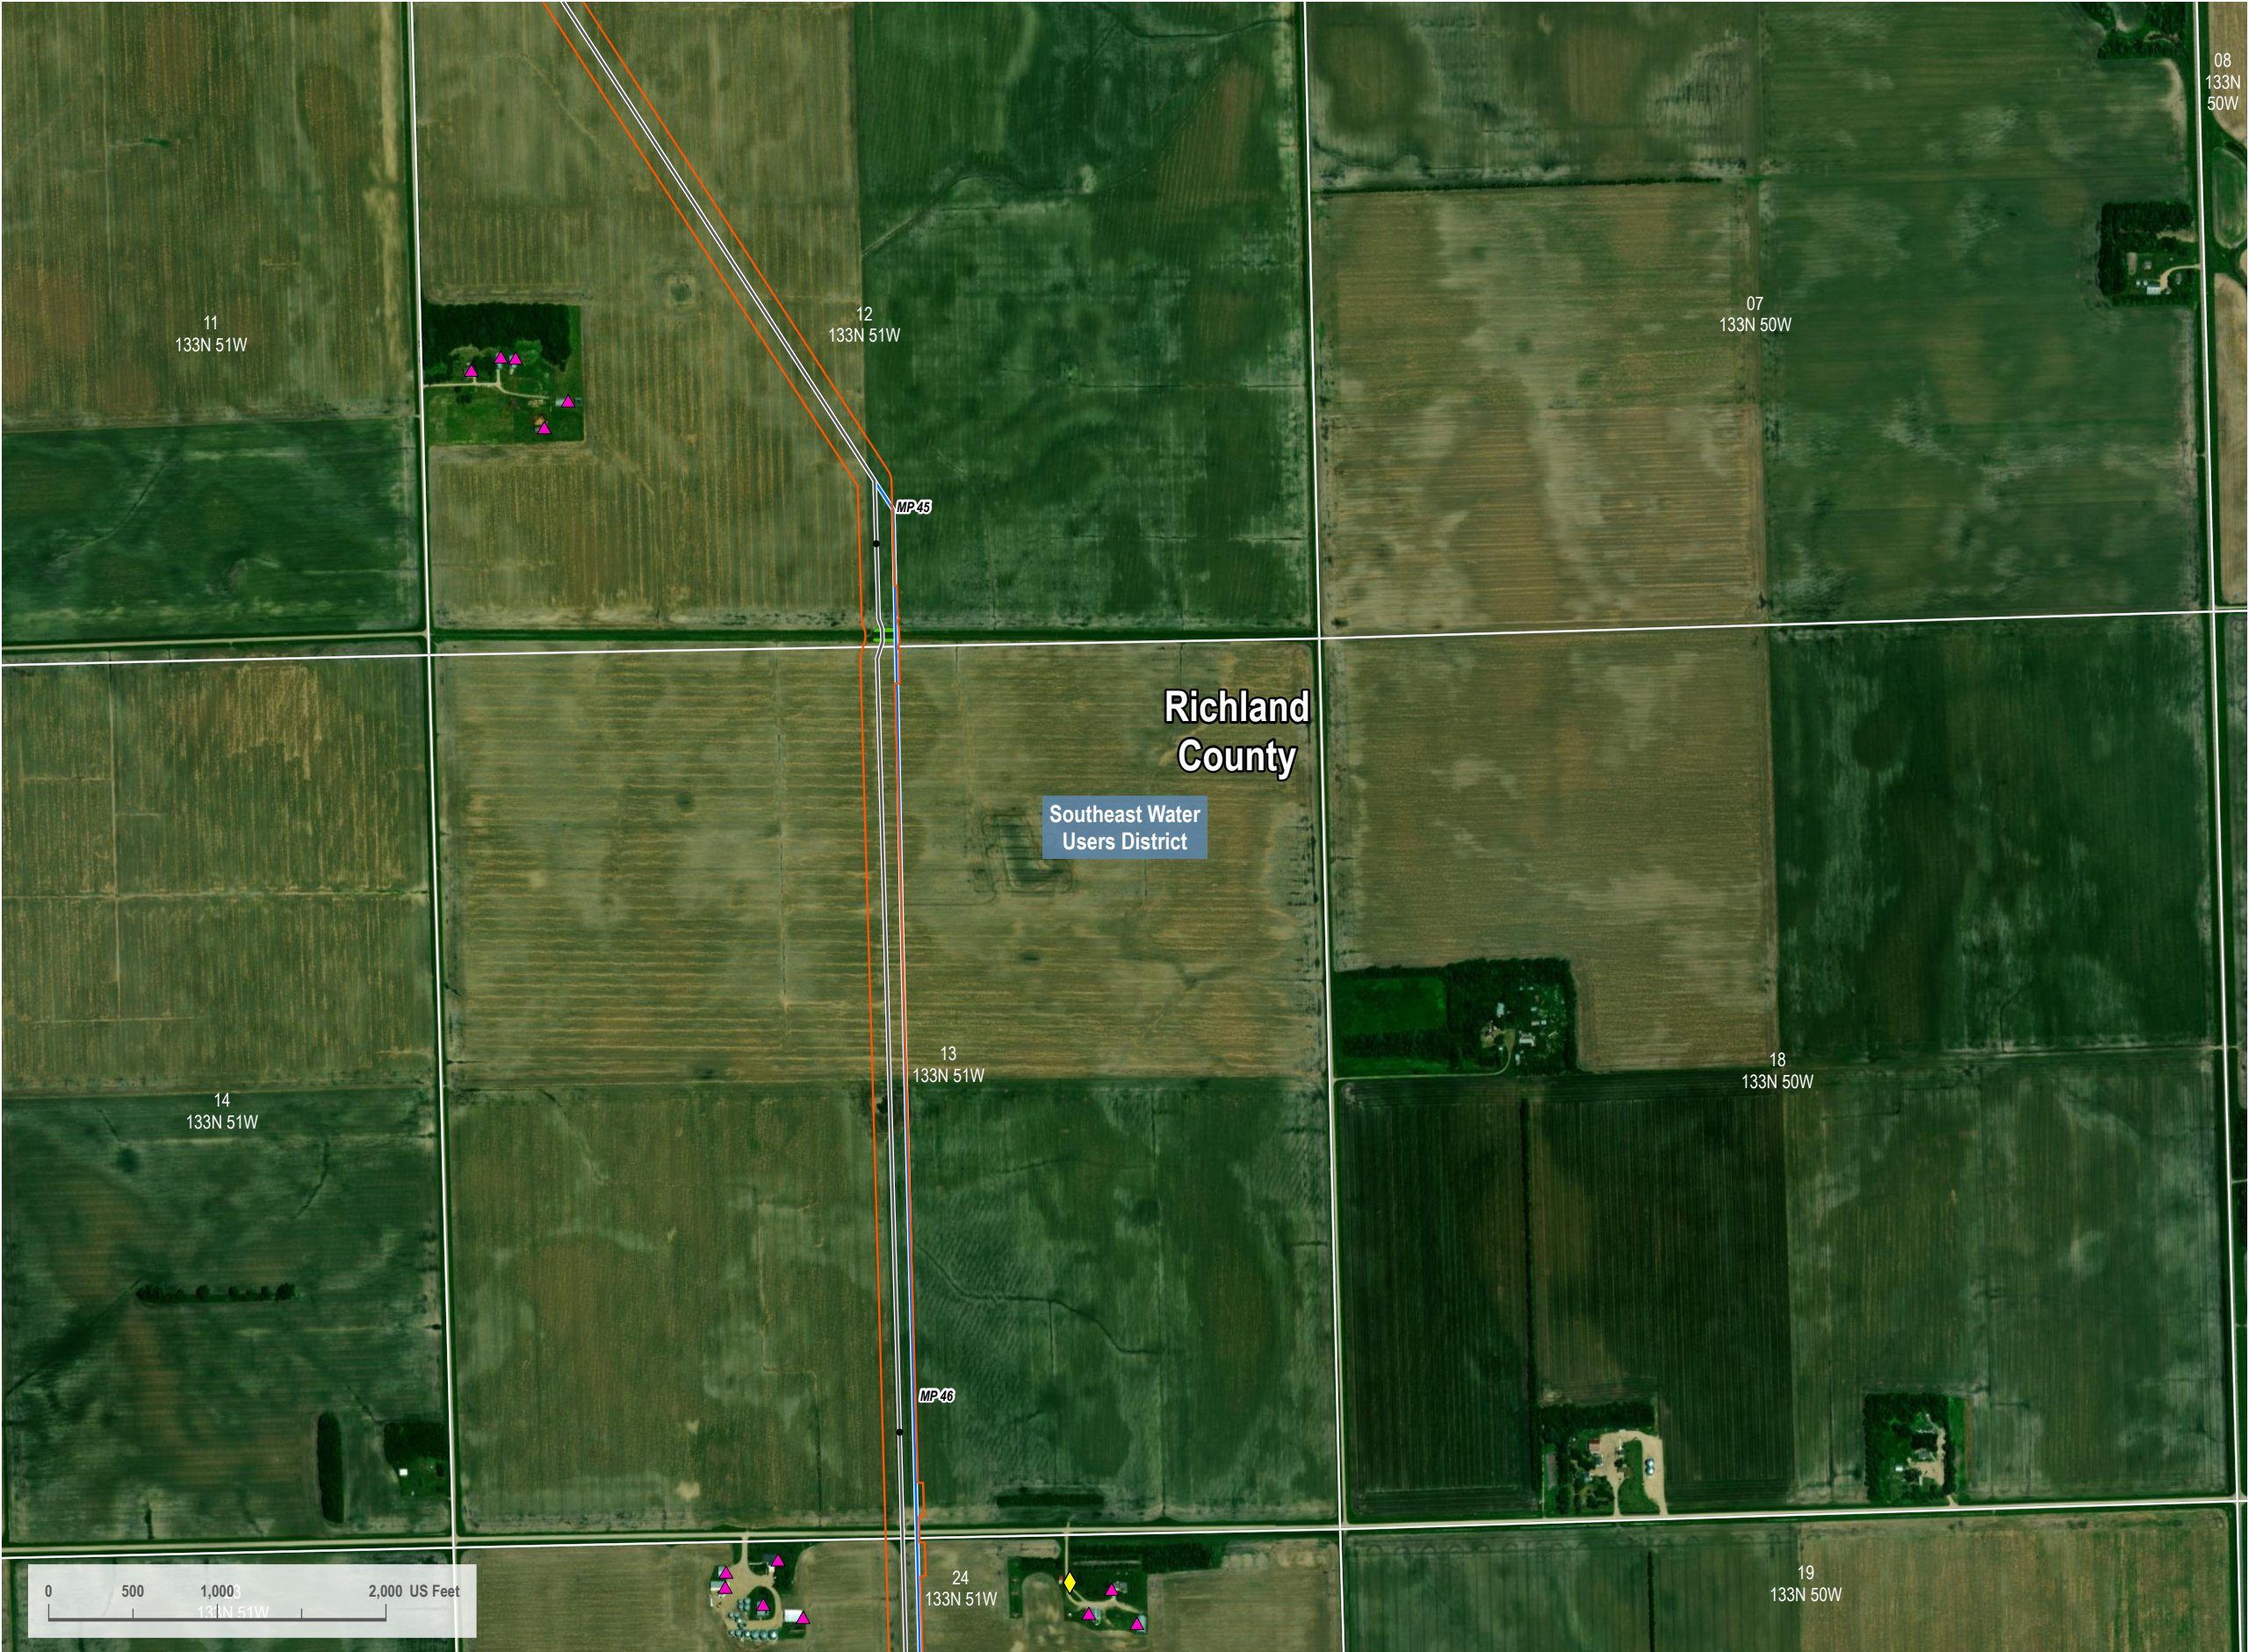

VICINITY MAP

LEGEND

- Centerline Mileposts
- Water Well (Avoidance)
- Domestic Structure or Business (Avoidance)
- Updated Proposed Project Route 08/15/2023
- October 17, 2023 Original PSC Application Route
- Section Line
- PEM Wetland
- 200-foot Siting Corridor

REVISIONS

Date: 2023-08-17	Revised by: CW	Checked by: RC
A - Issued for Review		
Date:	Revised by:	Checked by:
Date:	Revised by:	Checked by:

PREPARED BY

Summit Carbon Solutions

2321 North Loop Drive, Suite 221  
Ames, Iowa 50010  
United States of America

www.summitcarbonsolutions.com


PROJECT INFORMATION

Figure Title:  
ND PSC - Aerial Map Book - NDL-324

Figure Number:  
Map Book 1

Scale: 1 : 12,000 1 inch equals 1,000 feet	Projection: Transverse Mercator NAD 1983 UTM Zone 14N
Sheet: 134 134 of 139	Drawing Number: 1001-01-003 Revision A



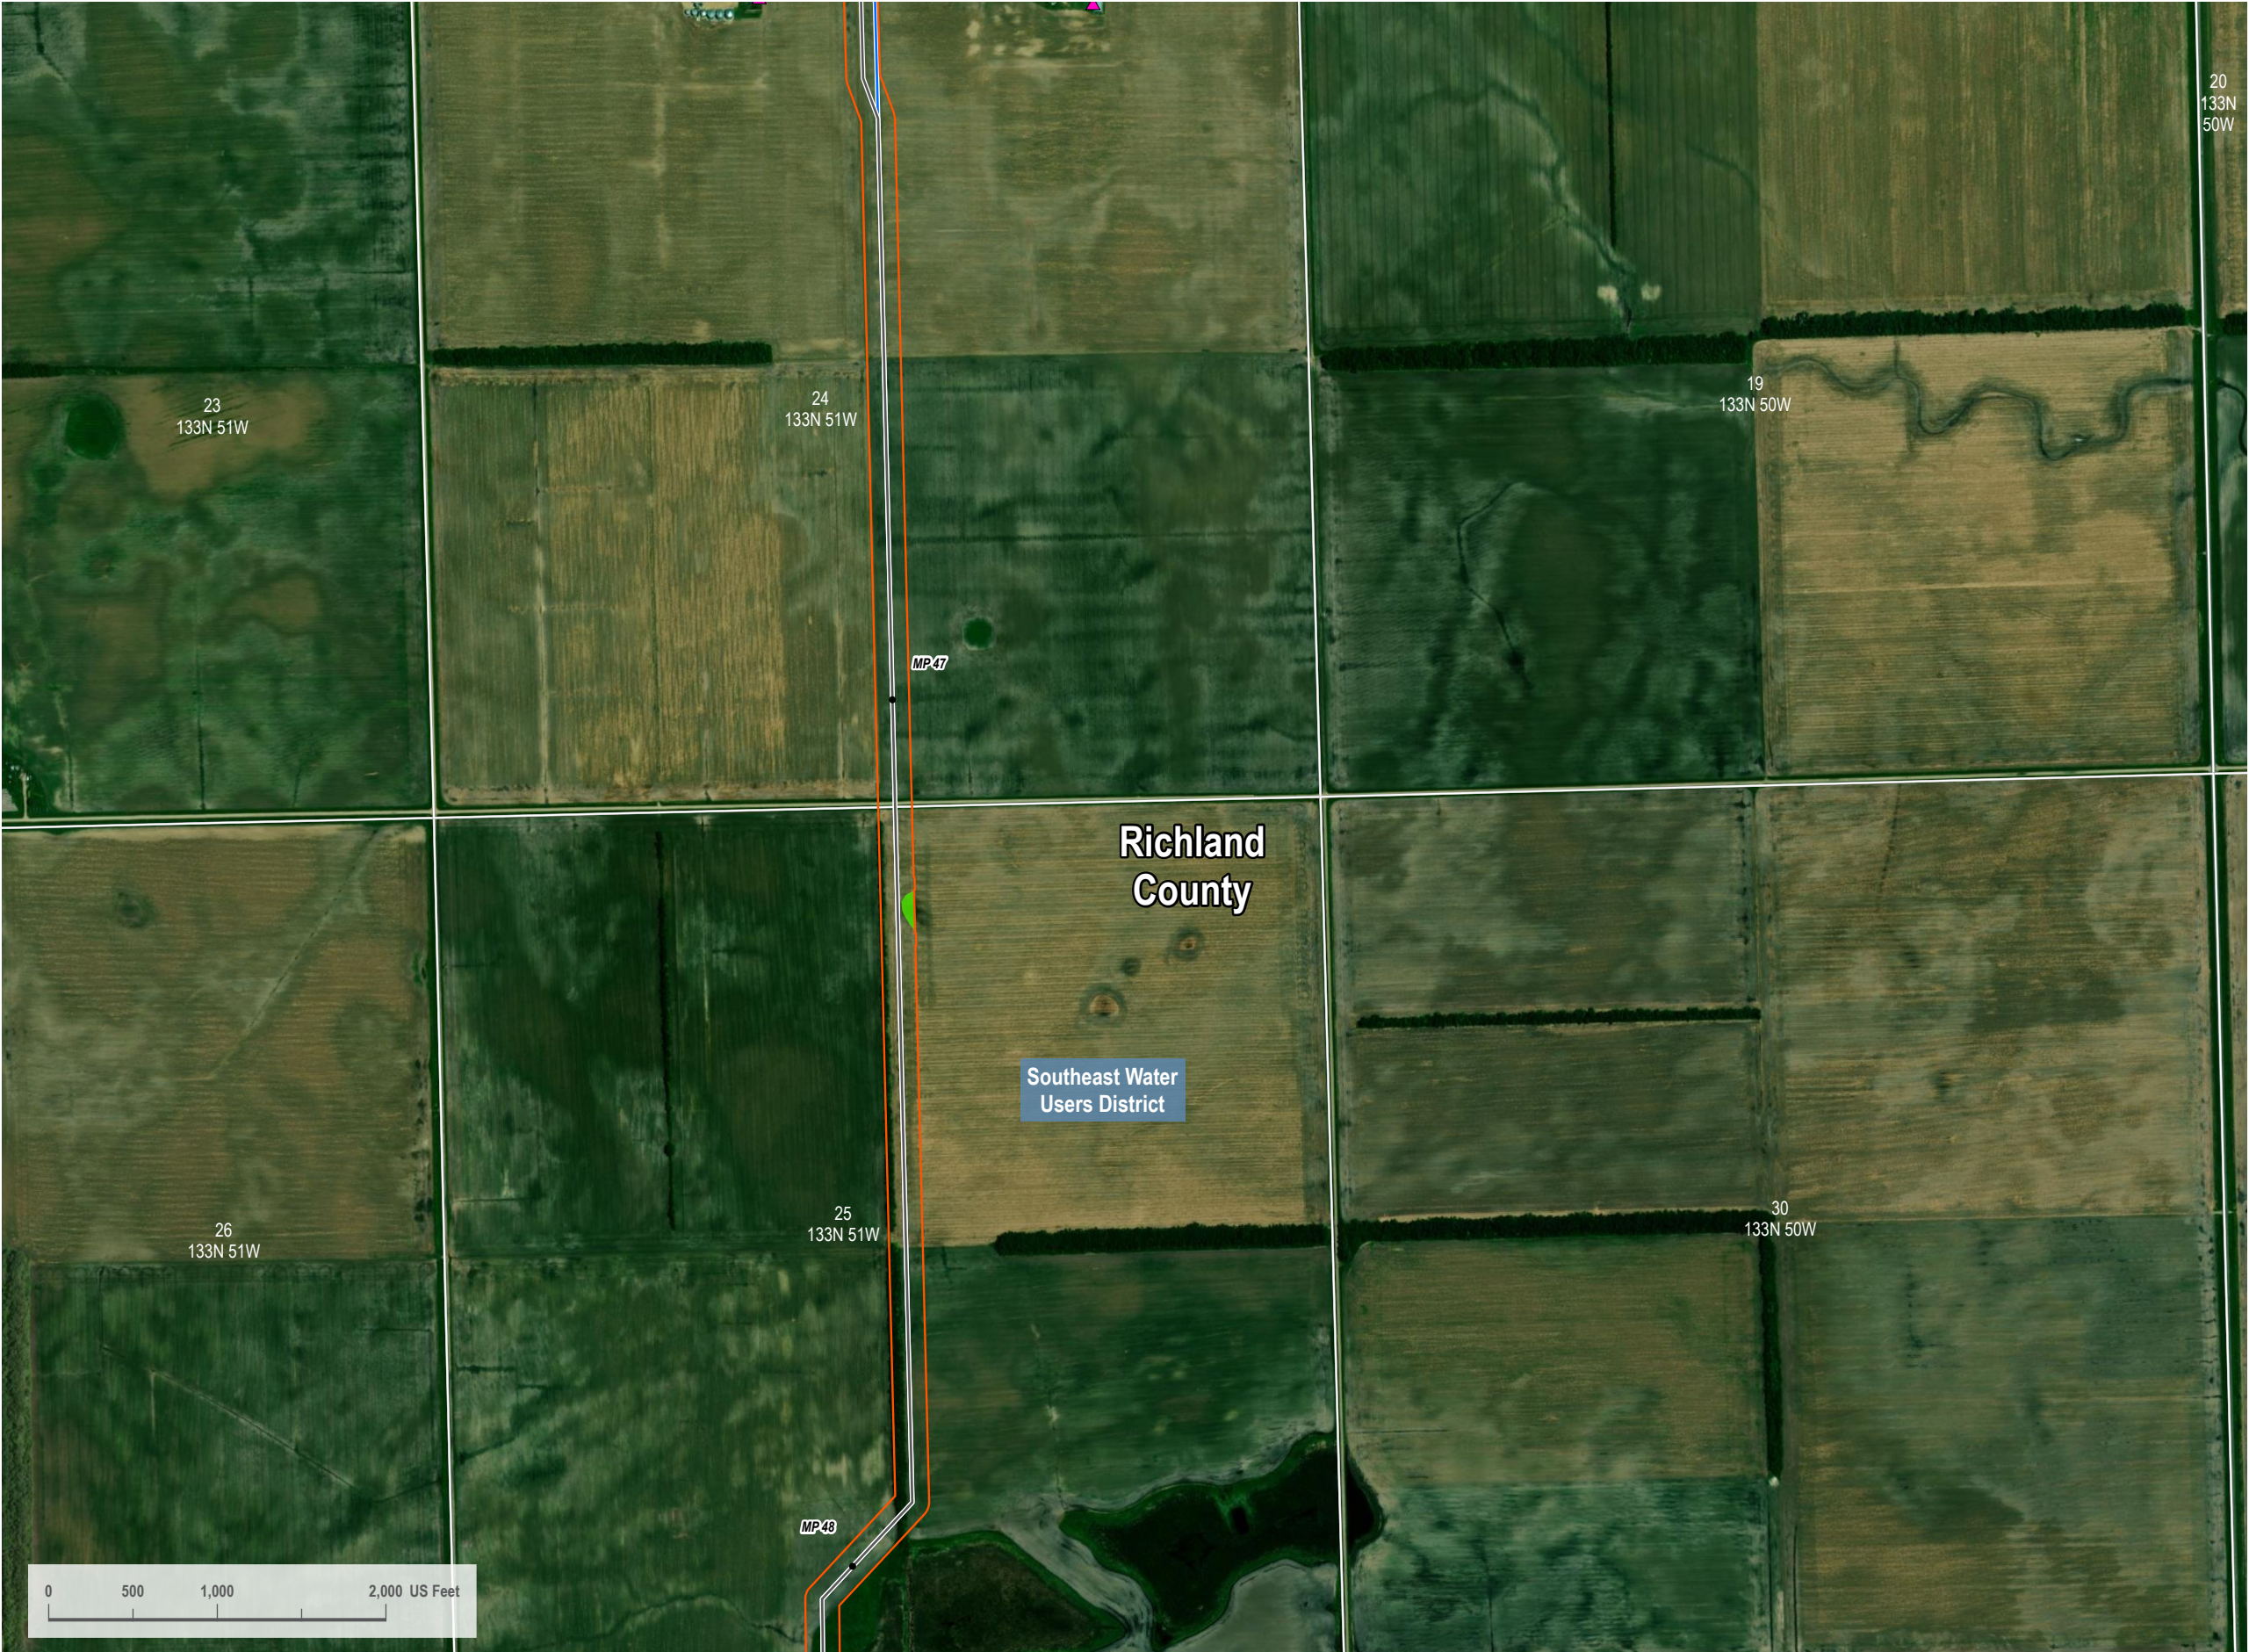

VICINITY MAP



LEGEND

- Centerline Mileposts
- Domestic Structure or Business (Avoidance)
- Updated Proposed Project Route 08/15/2023
- October 17, 2023 Original PSC Application Route
- Section Line
- PEM Wetland
- 200-foot Stiling Corridor



REVISIONS

Date: 2023-08-17 Revised by: CW Checked by: RC  
A - Issued for Review

Date: Revised by: Checked by:

Date: Revised by: Checked by:

PREPARED BY

**Summit Carbon Solutions**  
2321 North Loop Drive, Suite 221  
Ames, Iowa 50010  
United States of America  
[www.summitcarbonsolutions.com](http://www.summitcarbonsolutions.com)



PROJECT INFORMATION

Figure Title:  
ND PSC - Aerial Map Book - NDL-324

Figure Number:  
Map Book 1


Scale:  
1 : 12,000  
1 inch equals 1,000 feet

Projection:  
Transverse Mercator  
NAD 1983 UTM Zone 14N

Sheet:  
135  
135 of 139

Drawing Number:  
1001-01-003  
Revision A



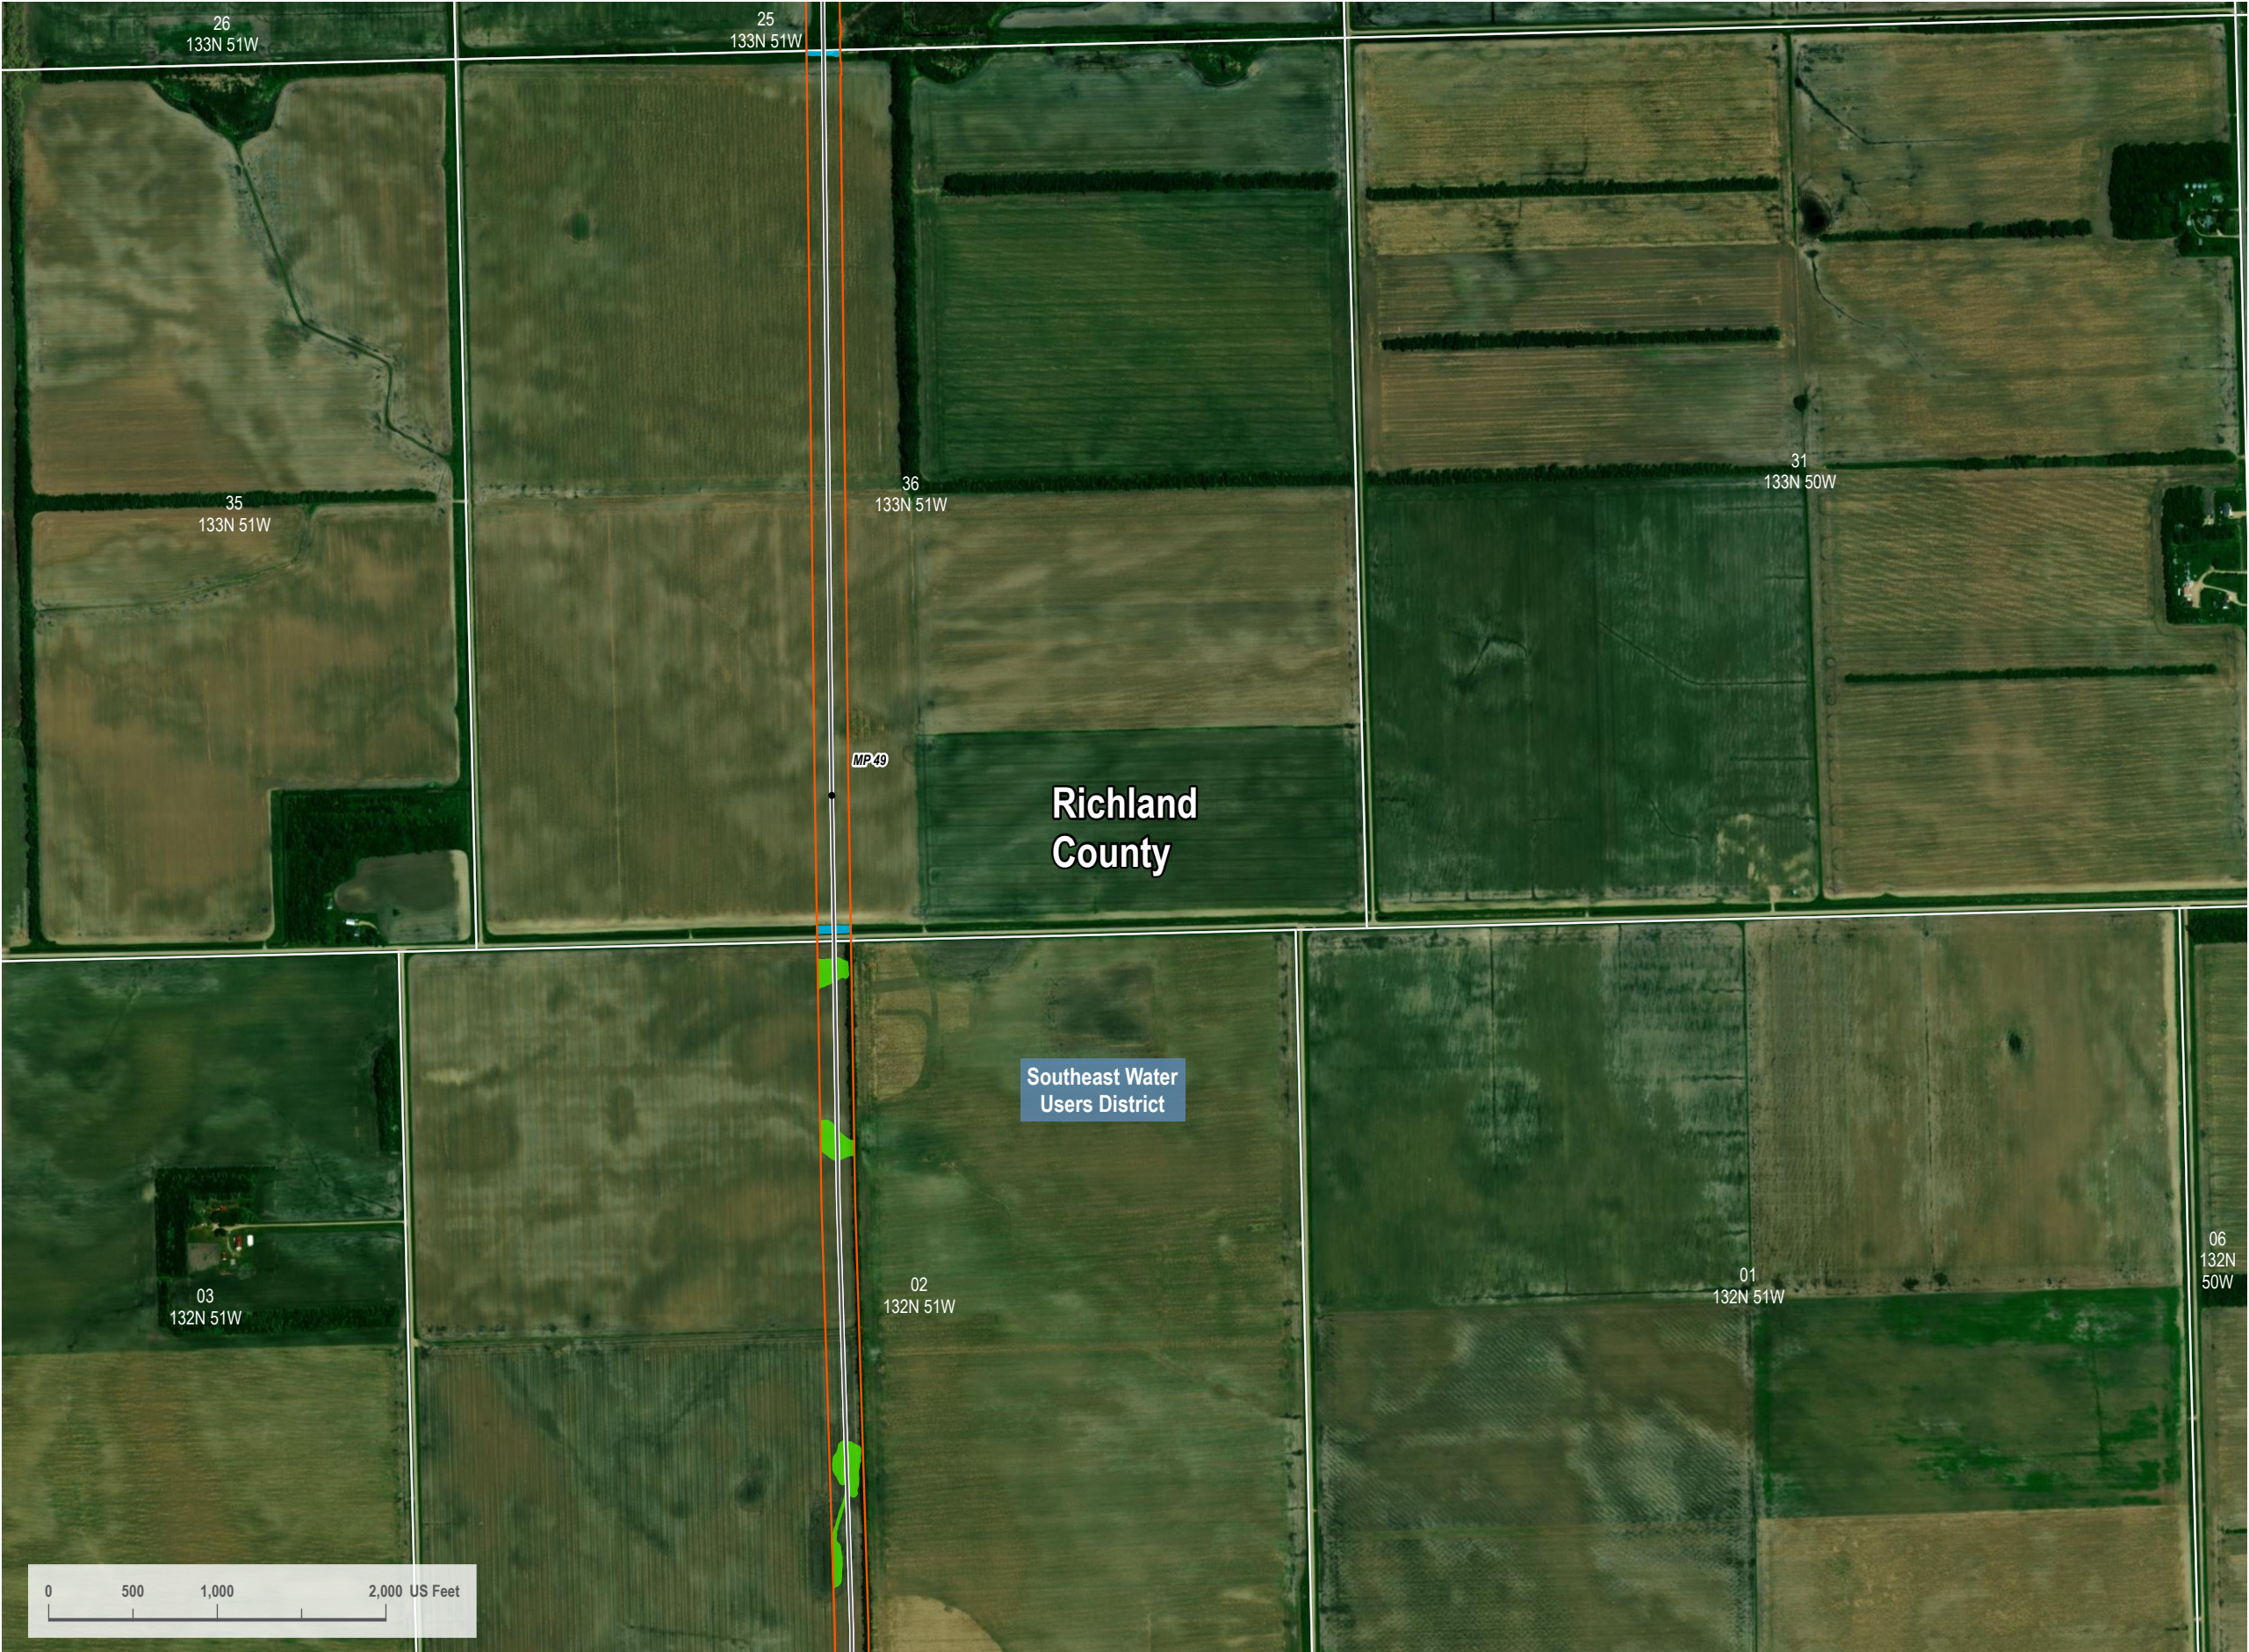


VICINITY MAP



LEGEND

- Centerline Mileposts
- Updated Proposed Project Route 08/15/2023
- October 17, 2023 Original PSC Application Route
- Section Line
- PEM Wetland
- Stream
- 200-foot Siting Corridor

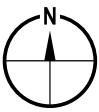

REVISIONS

Date: 2023-08-17 Revised by: CW Checked by: RC  
A - Issued for Review

Date: Revised by: Checked by:

Date: Revised by: Checked by:

PREPARED BY

**Summit Carbon Solutions**  
2321 North Loop Drive, Suite 221  
Ames, Iowa 50010  
United States of America  
[www.summitcarbonsolutions.com](http://www.summitcarbonsolutions.com)



**SUMMIT CARBON**  
SOLUTIONS

PROJECT INFORMATION

Figure Title:  
ND PSC - Aerial Map Book - NDL-324

Figure Number:  
Map Book 1


Scale:  
1 : 12,000  
1 inch equals 1,000 feet

Projection:  
Transverse Mercator  
NAD 1983 UTM Zone 14N

Sheet:  
136  
136 of 139

Drawing Number:  
1001-01-003  
Revision A



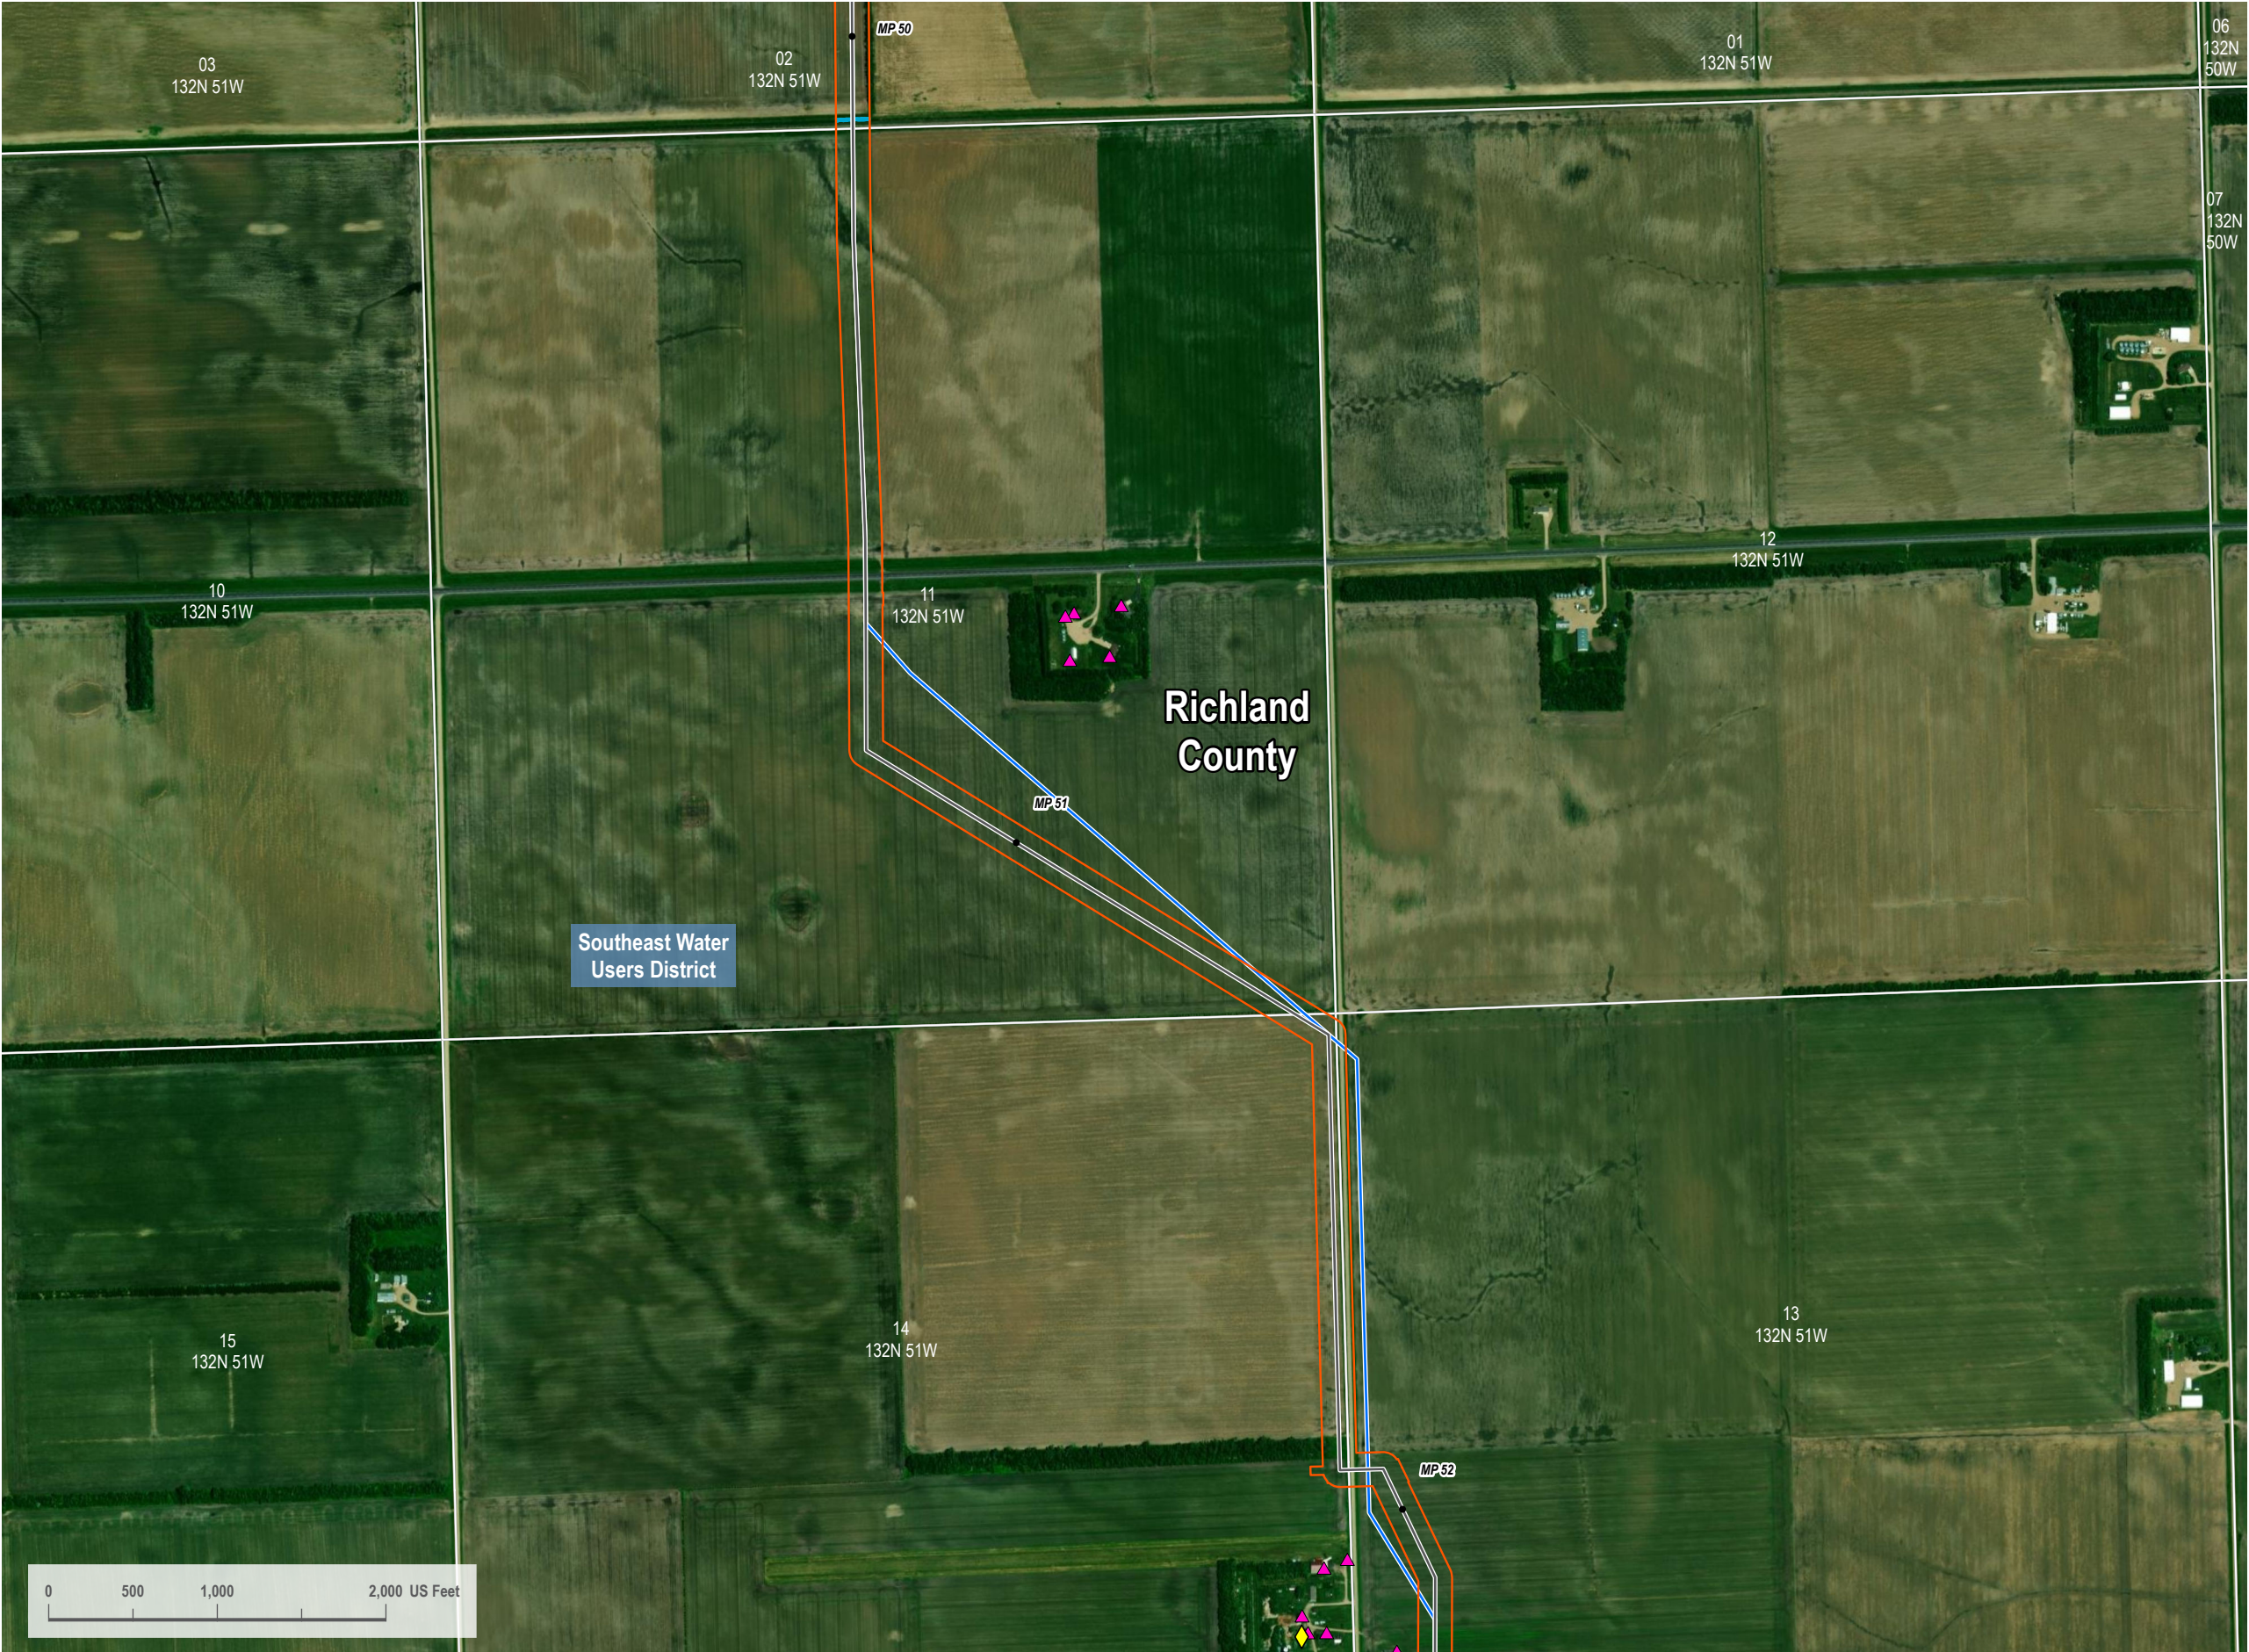

VICINITY MAP



LEGEND

- Centerline Mileposts
- Water Well (Avoidance)
- Domestic Structure or Business (Avoidance)
- Updated Proposed Project Route 08/15/2023
- October 17, 2023 Original PSC Application Route
- Section Line
- Stream
- 200-foot Siting Corridor



REVISIONS

Date: 2023-08-17	Revised by: CW	Checked by: RC
A - Issued for Review		
Date:	Revised by:	Checked by:
Date:	Revised by:	Checked by:

PREPARED BY

**Summit Carbon Solutions**  
2321 North Loop Drive, Suite 221  
Ames, Iowa 50010  
United States of America  
[www.summitcarbonsolutions.com](http://www.summitcarbonsolutions.com)




**SUMMIT CARBON SOLUTIONS**

PROJECT INFORMATION

Figure Title: <b>ND PSC - Aerial Map Book - NDL-324</b>	
Figure Number: <b>Map Book 1</b>	
Scale: <b>1 : 12,000</b> 1 inch equals 1,000 feet	Projection: <b>Transverse Mercator</b> NAD 1983 UTM Zone 14N
Sheet: <b>137</b> 137 of 139	Drawing Number: <b>1001-01-003</b> Revision A



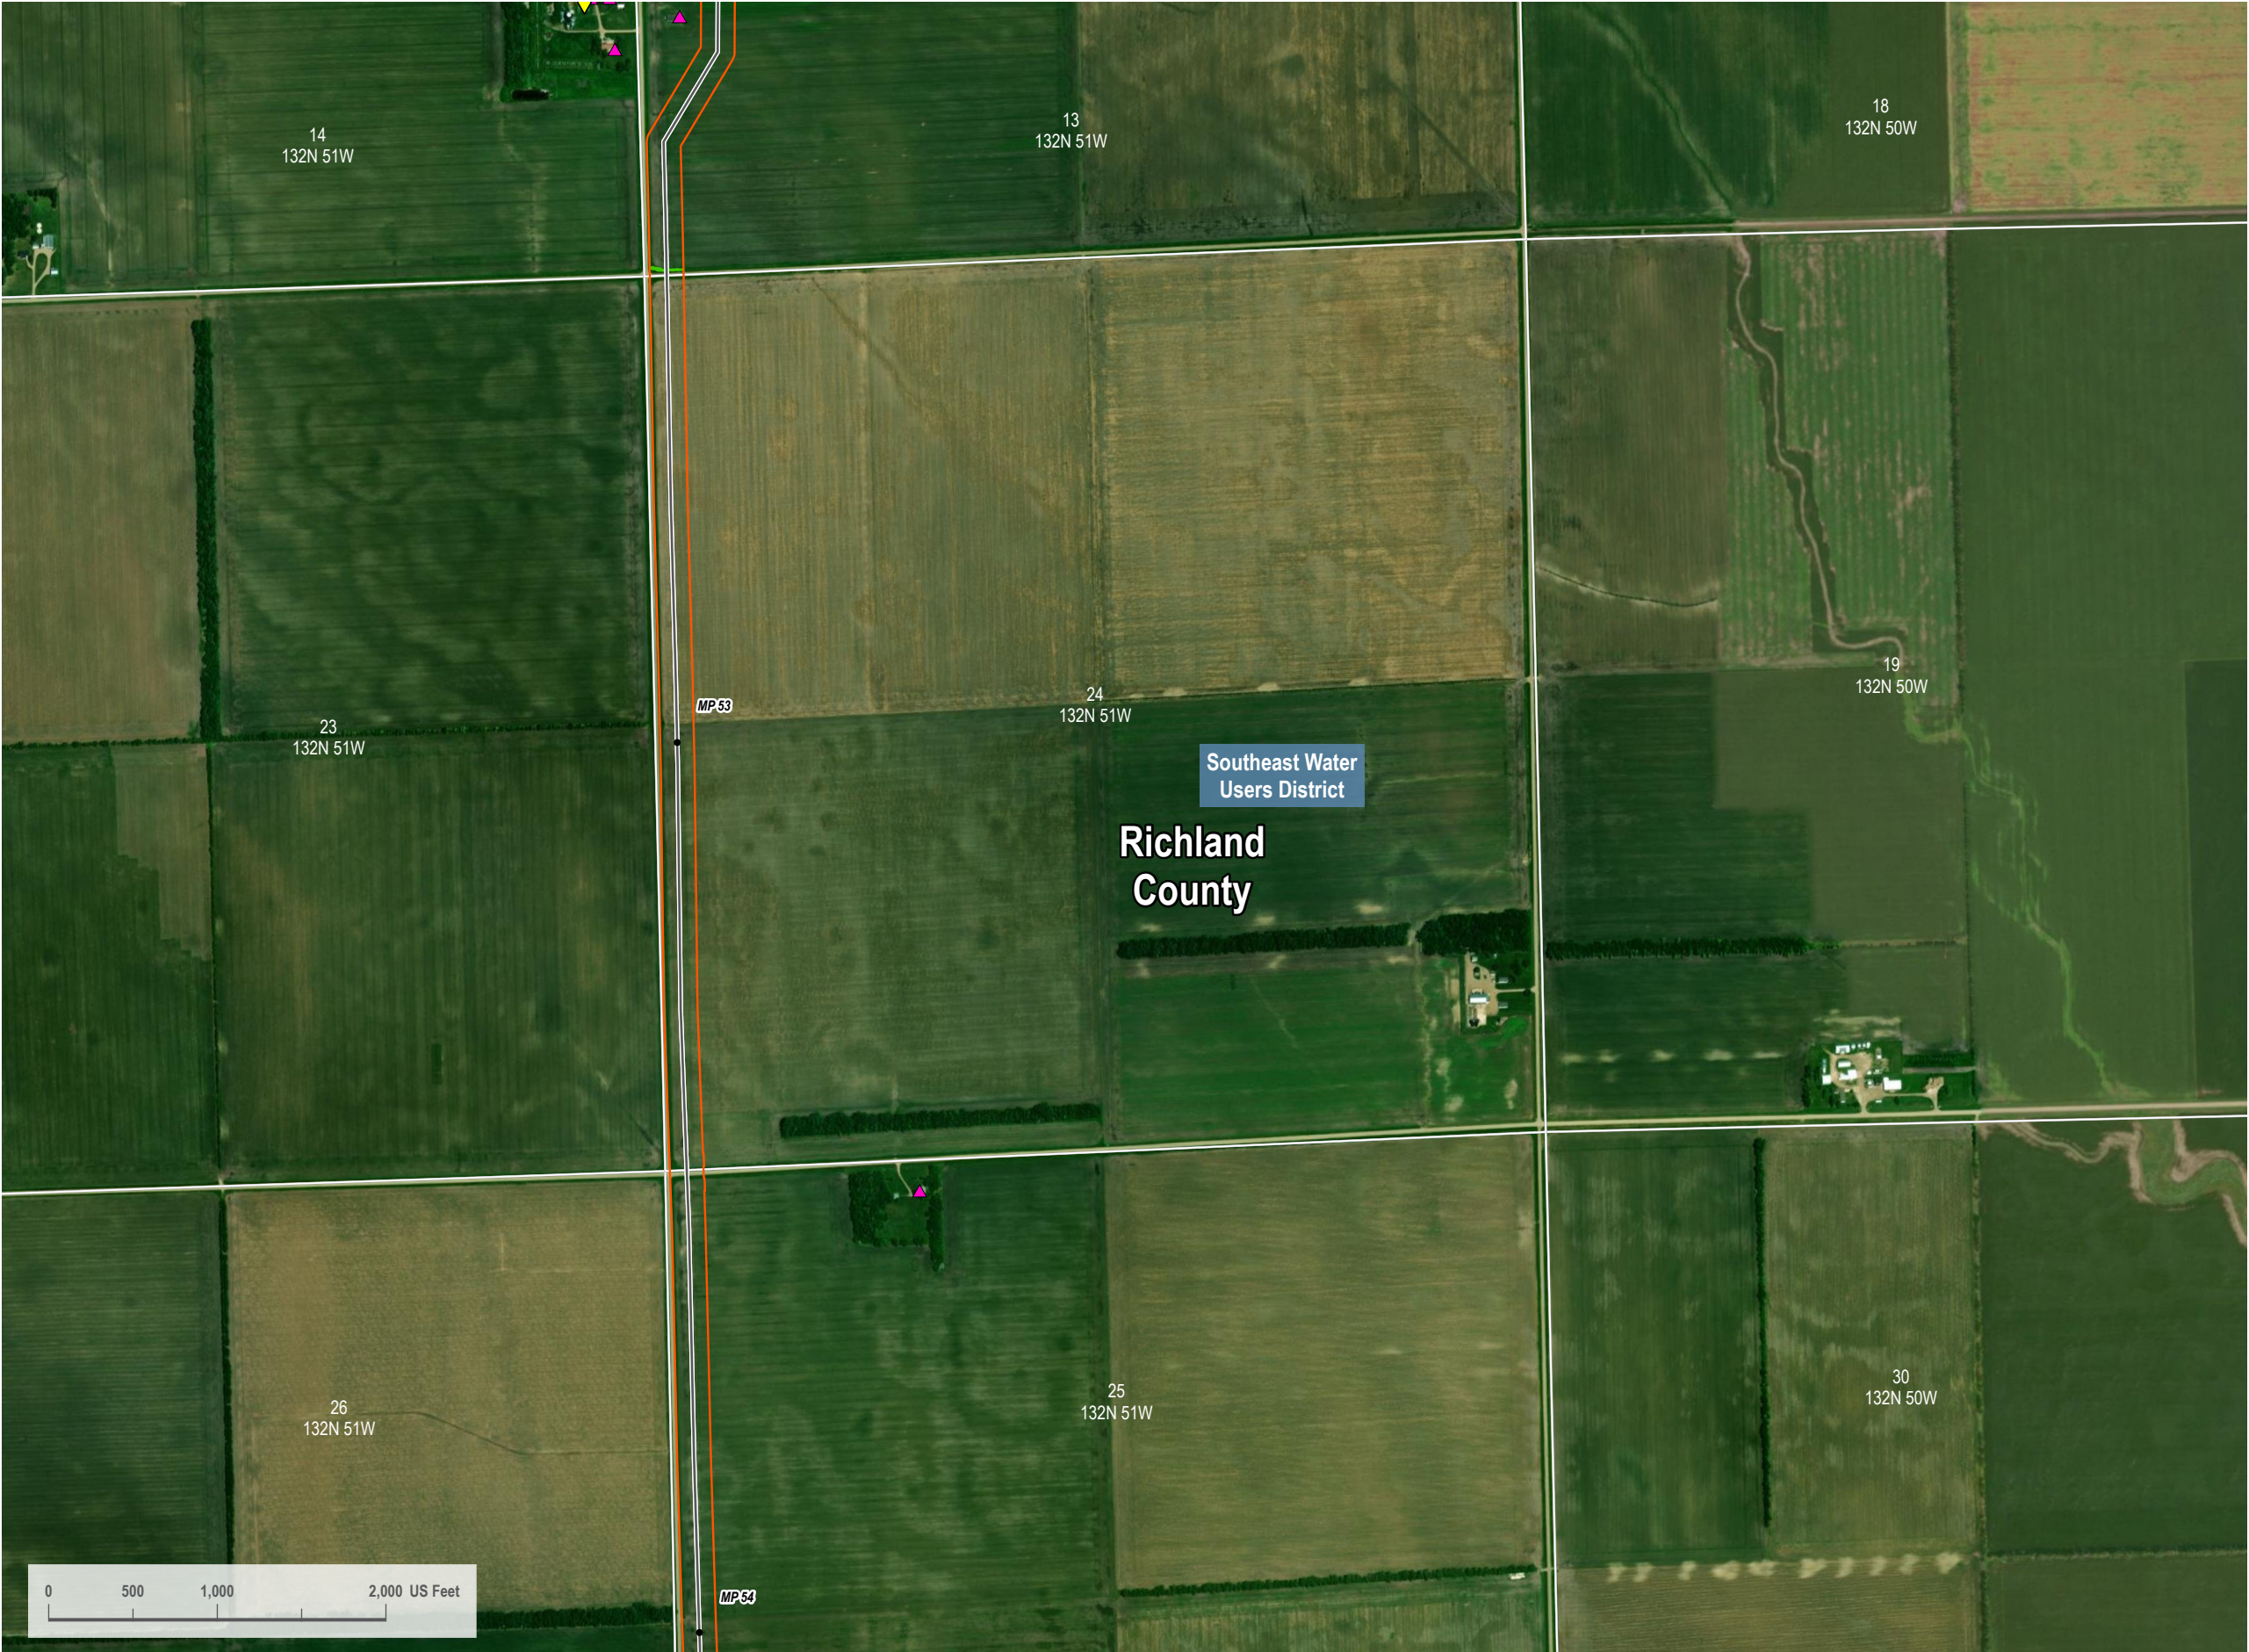

VICINITY MAP



LEGEND

- Centerline Mileposts
- Water Well (Avoidance)
- Domestic Structure or Business (Avoidance)
- Updated Proposed Project Route 08/15/2023
- October 17, 2023 Original PSC Application Route
- Section Line
- PEM Wetland
- 200-foot Siting Corridor



REVISIONS

Date:	2023-08-17	Revised by:	CW	Checked by:	RC
A - Issued for Review					
Date:		Revised by:		Checked by:	
Date:		Revised by:		Checked by:	

PREPARED BY

**Summit Carbon Solutions**  
2321 North Loop Drive, Suite 221  
Ames, Iowa 50010  
United States of America  
[www.summitcarbonsolutions.com](http://www.summitcarbonsolutions.com)



**SUMMIT CARBON**  
SOLUTIONS

PROJECT INFORMATION

Figure Title: <b>ND PSC - Aerial Map Book - NDL-324</b>	
Figure Number: <b>Map Book 1</b>	
Scale: <b>1 : 12,000</b> 1 inch equals 1,000 feet	Projection: <b>Transverse Mercator</b> NAD 1983 UTM Zone 14N
Sheet: <b>138</b> 138 of 139	Drawing Number: <b>1001-01-003</b> Revision A






VICINITY MAP



LEGEND

- HDD Entry/Exit
- Centerline Mileposts
- Mainline Valve Location
- Domestic Structure or Business (Avoidance)
- Updated Proposed Project Route 08/15/2023
- October 17, 2023 Original PSC Application Route
- Section Line
- Access Road
- PEM Wetland
- 200-foot Siting Corridor

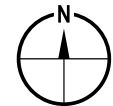

REVISIONS

Date:	2023-08-17	Revised by:	CW	Checked by:	RC
A - Issued for Review					
Date:		Revised by:		Checked by:	
Date:		Revised by:		Checked by:	

PREPARED BY

**Summit Carbon Solutions**  
2321 North Loop Drive, Suite 221  
Ames, Iowa 50010  
United States of America  
[www.summitcarbonsolutions.com](http://www.summitcarbonsolutions.com)



**SUMMIT CARBON**  
SOLUTIONS

PROJECT INFORMATION

Figure Title: <b>ND PSC - Aerial Map Book - NDL-323, NDT-211, NDL-324</b>	
Figure Number: <b>Map Book 1</b>	
Scale: <b>1 : 12,000</b> 1 inch equals 1,000 feet	Projection: <b>Transverse Mercator</b> NAD 1983 UTM Zone 14N
Sheet: <b>139</b> 139 of 139	Drawing Number: <b>1001-01-003</b> Revision A