


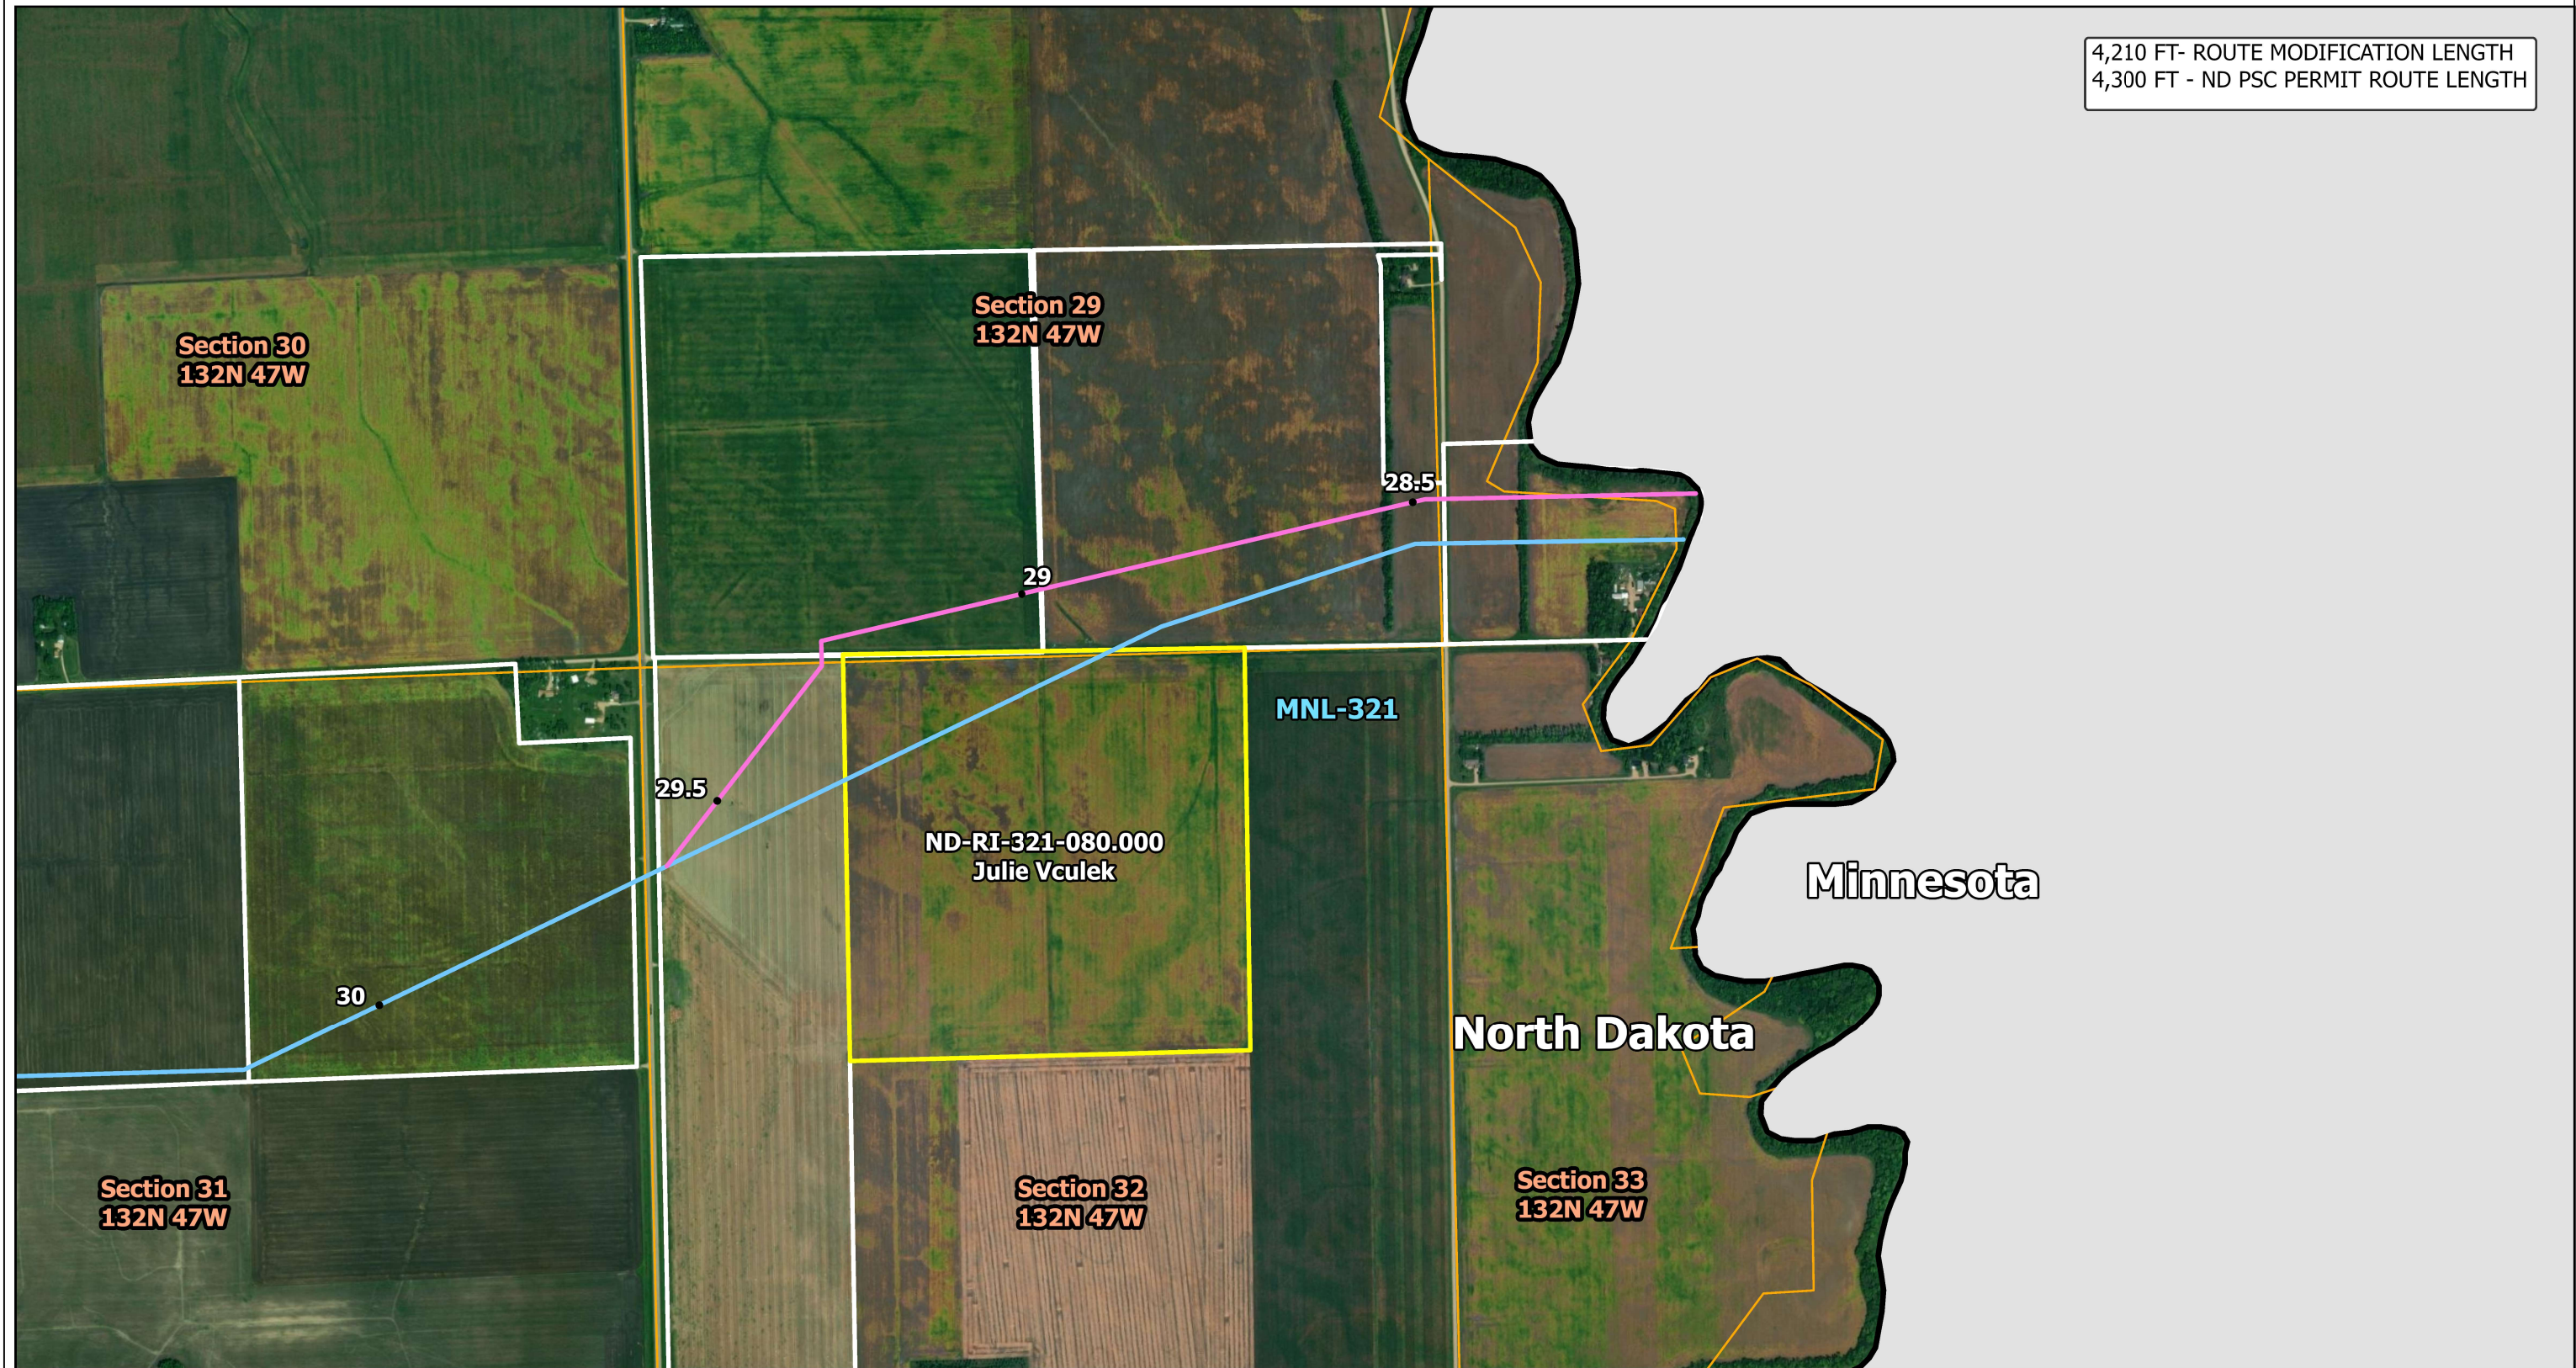

4,210 FT- ROUTE MODIFICATION LENGTH
4,300 FT - ND PSC PERMIT ROUTE LENGTH

LO ROUTE
MODIFICATION 1
NORTH DAKOTA

Date: 08/16/2023


- | | |
|-----------------------------|----------------------|
| • Mileposts | Landowner Intervenor |
| Proposed Route Modification | Online Properties |
| ND PSC Permit Route | PLSS Boundaries |



SUMMIT
CARBON
SOLUTIONS



0 0.17 0.35 0.7 Miles

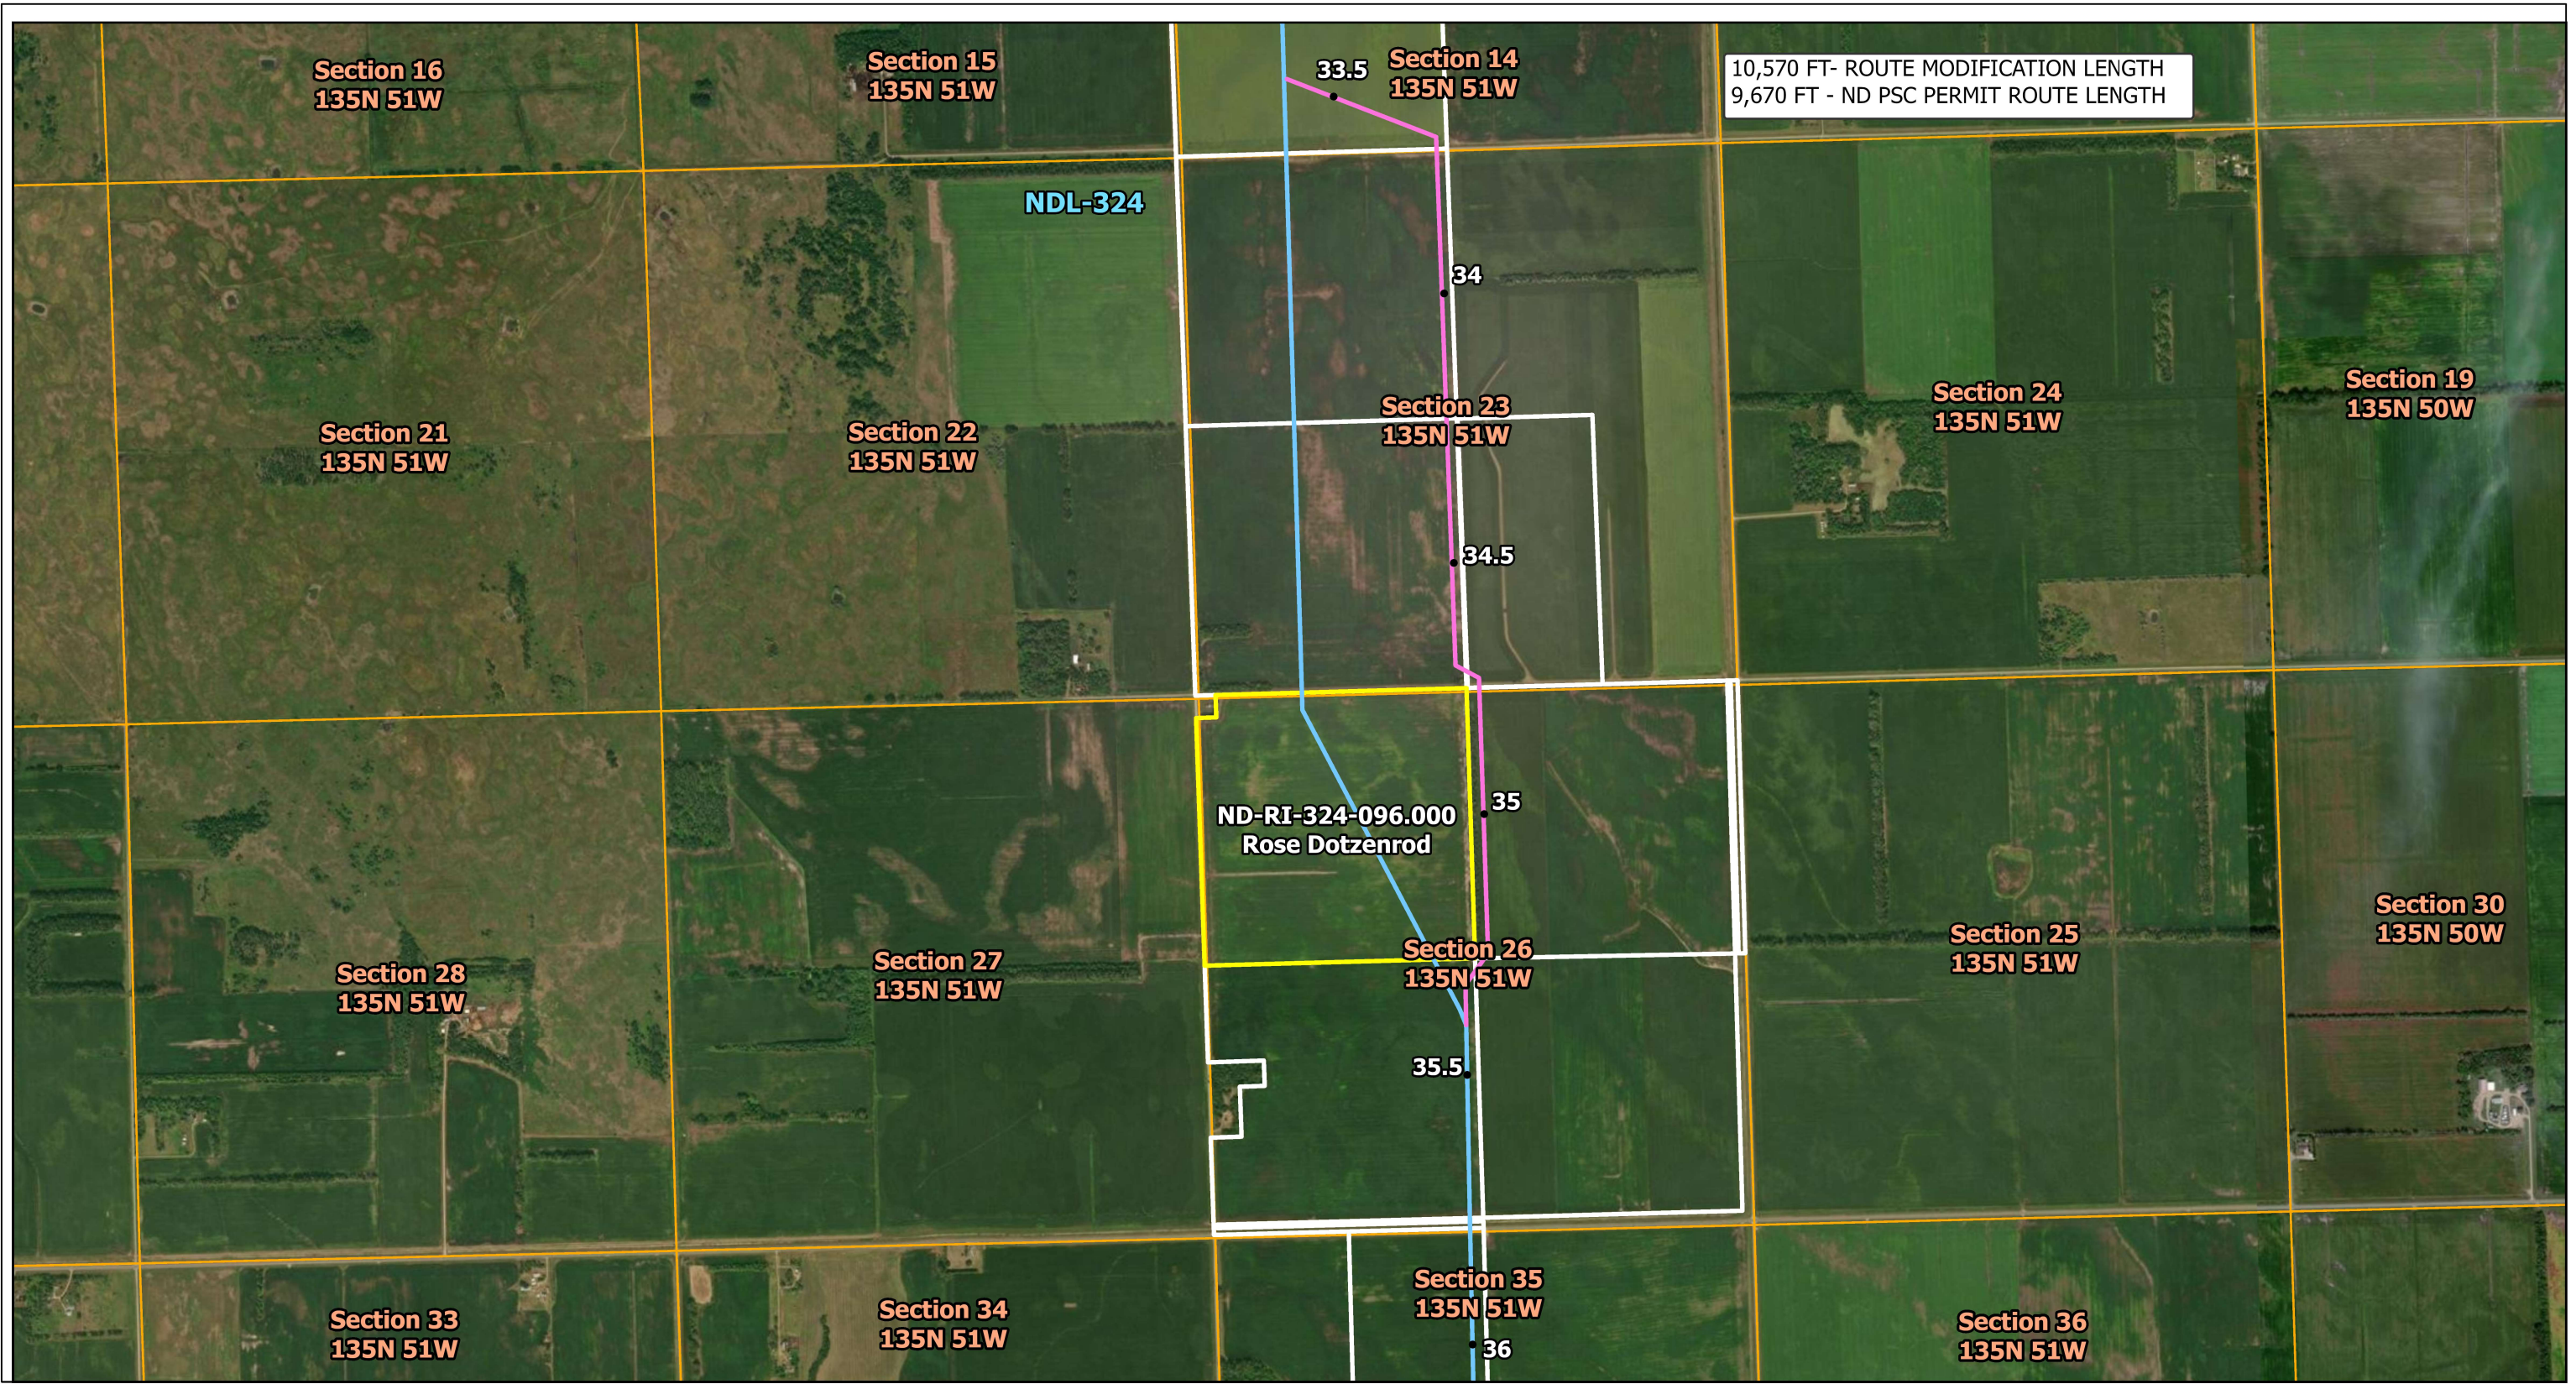


LO ROUTE
MODIFICATION 2
NORTH DAKOTA

Date: 08/16/2023

- | | |
|-----------------------------|----------------------|
| • Mileposts | Landowner Intervenor |
| Proposed Route Modification | Online Properties |
| ND PSC Permit Route | PLSS Boundaries |



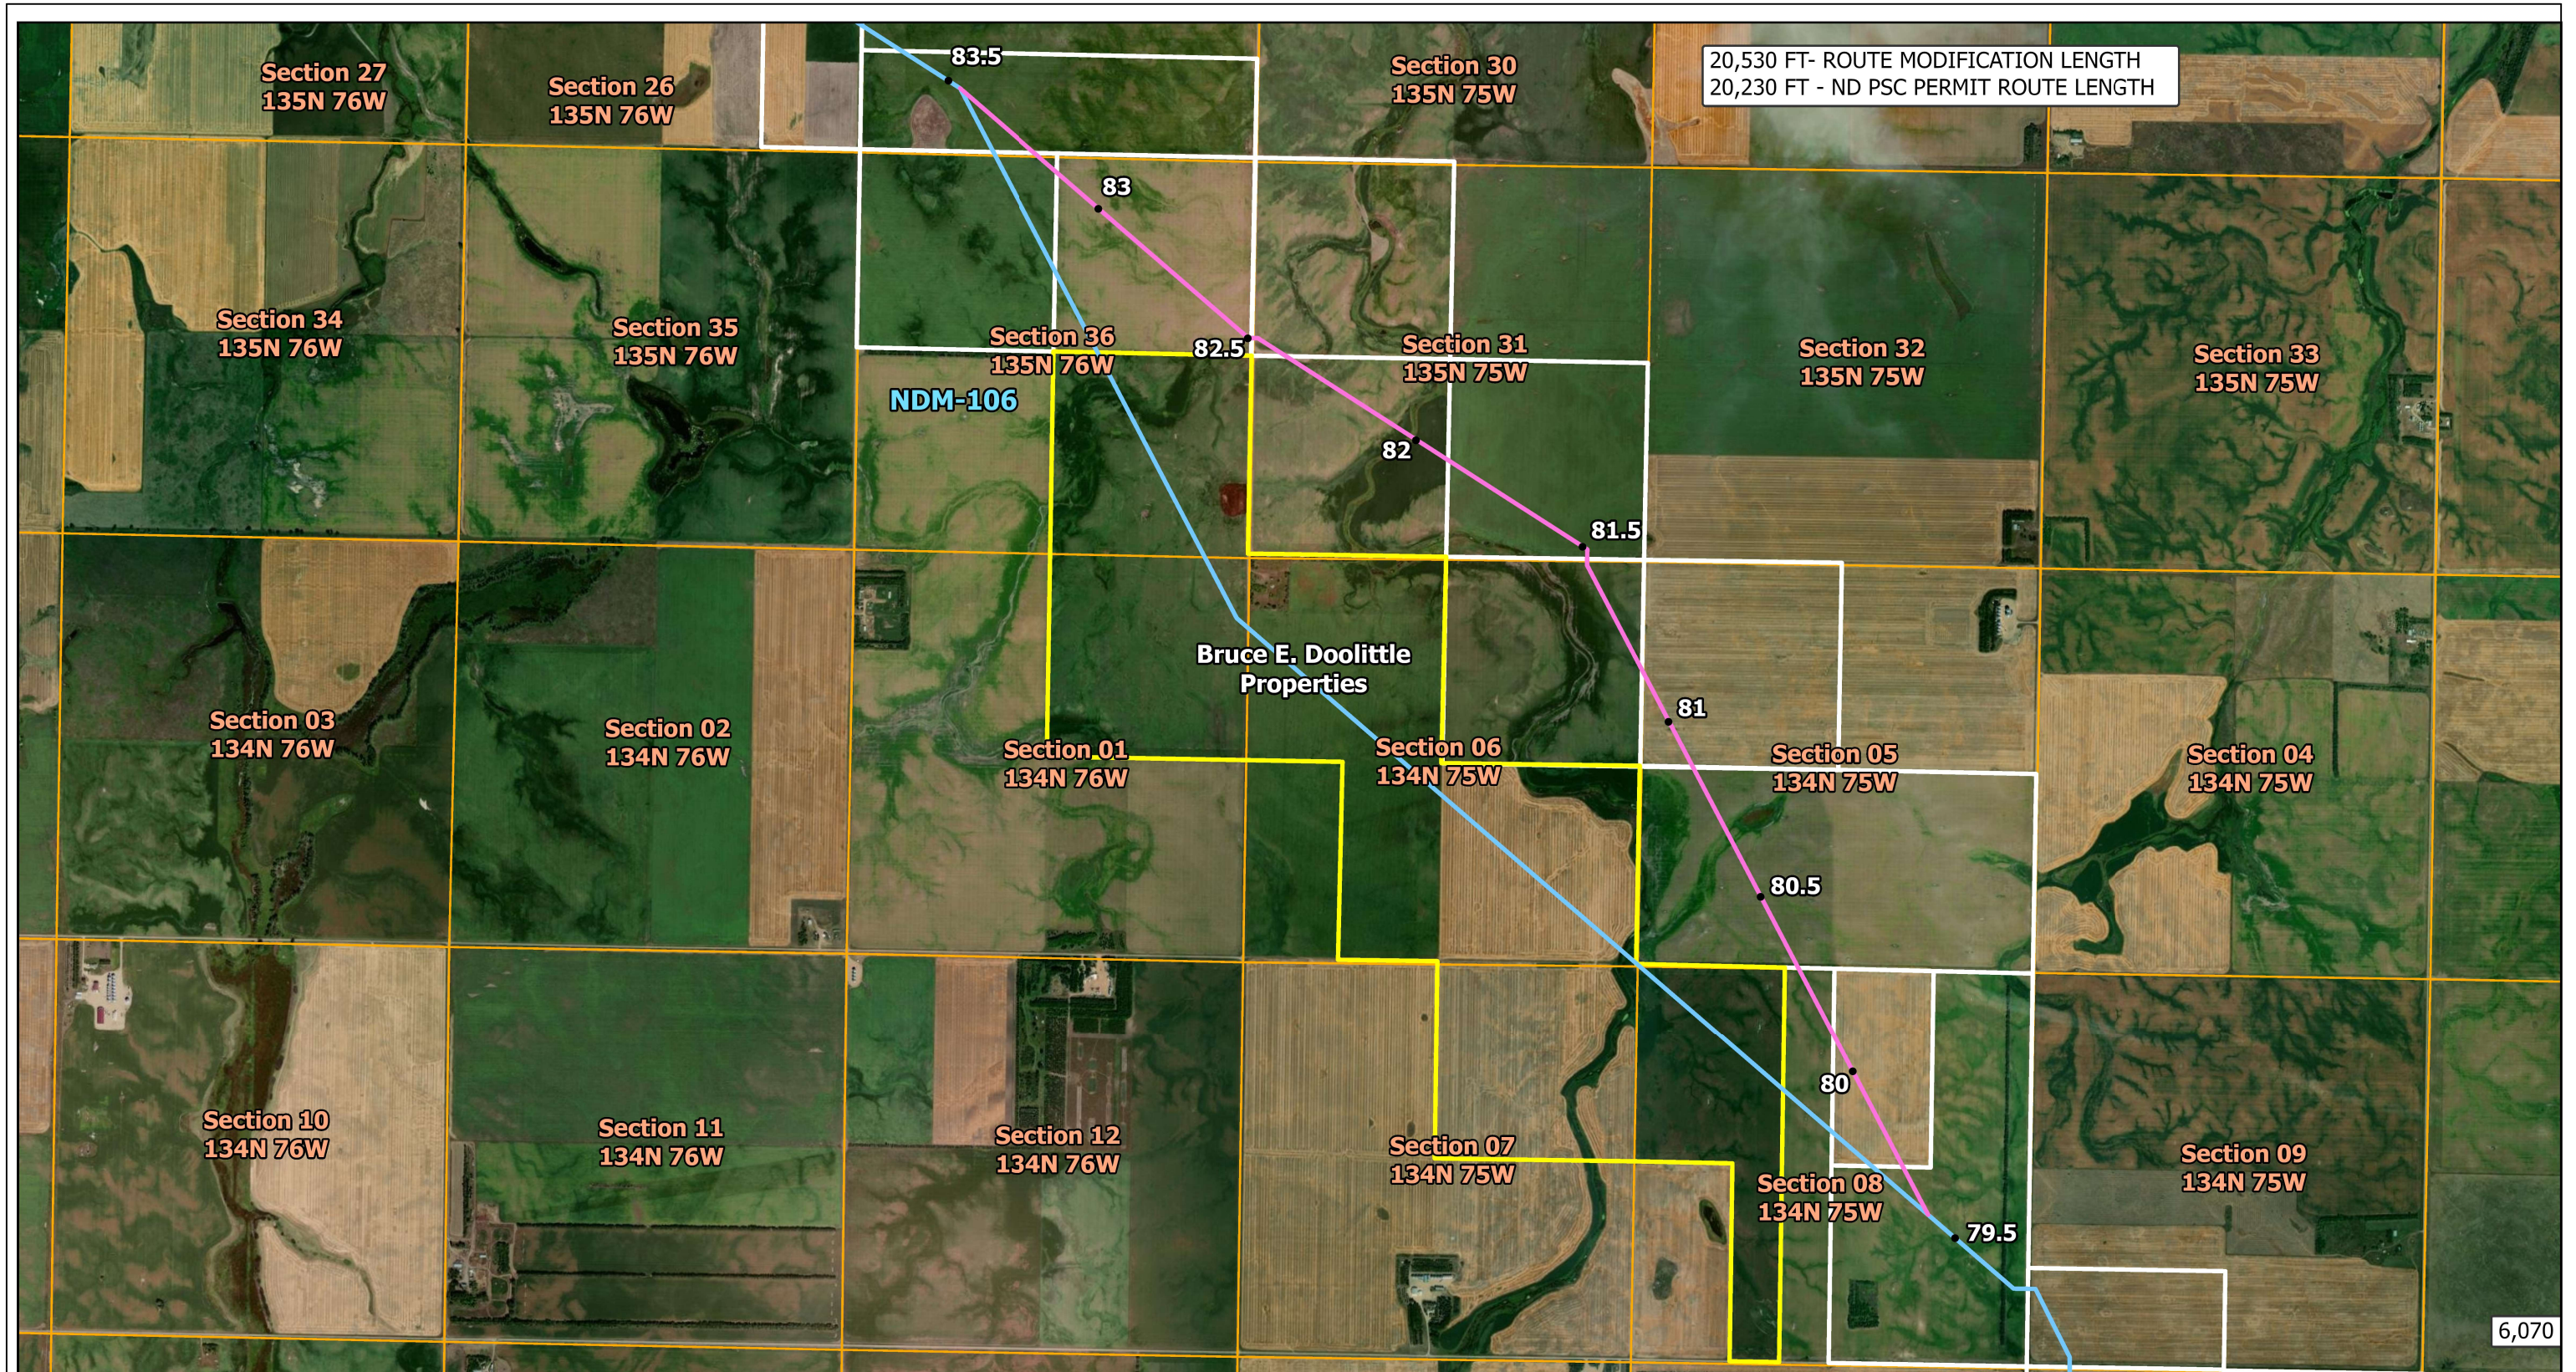

LO ROUTE
MODIFICATION 3
NORTH DAKOTA

Date: 08/16/2023

- Mileposts
- Proposed Route Modification
- ND PSC Permit Route
- Landowner Intervenor
- Online Properties
- PLSS Boundaries




SUMMIT
CARBON
SOLUTIONS

N



0 0.35 0.7 1.4 Miles

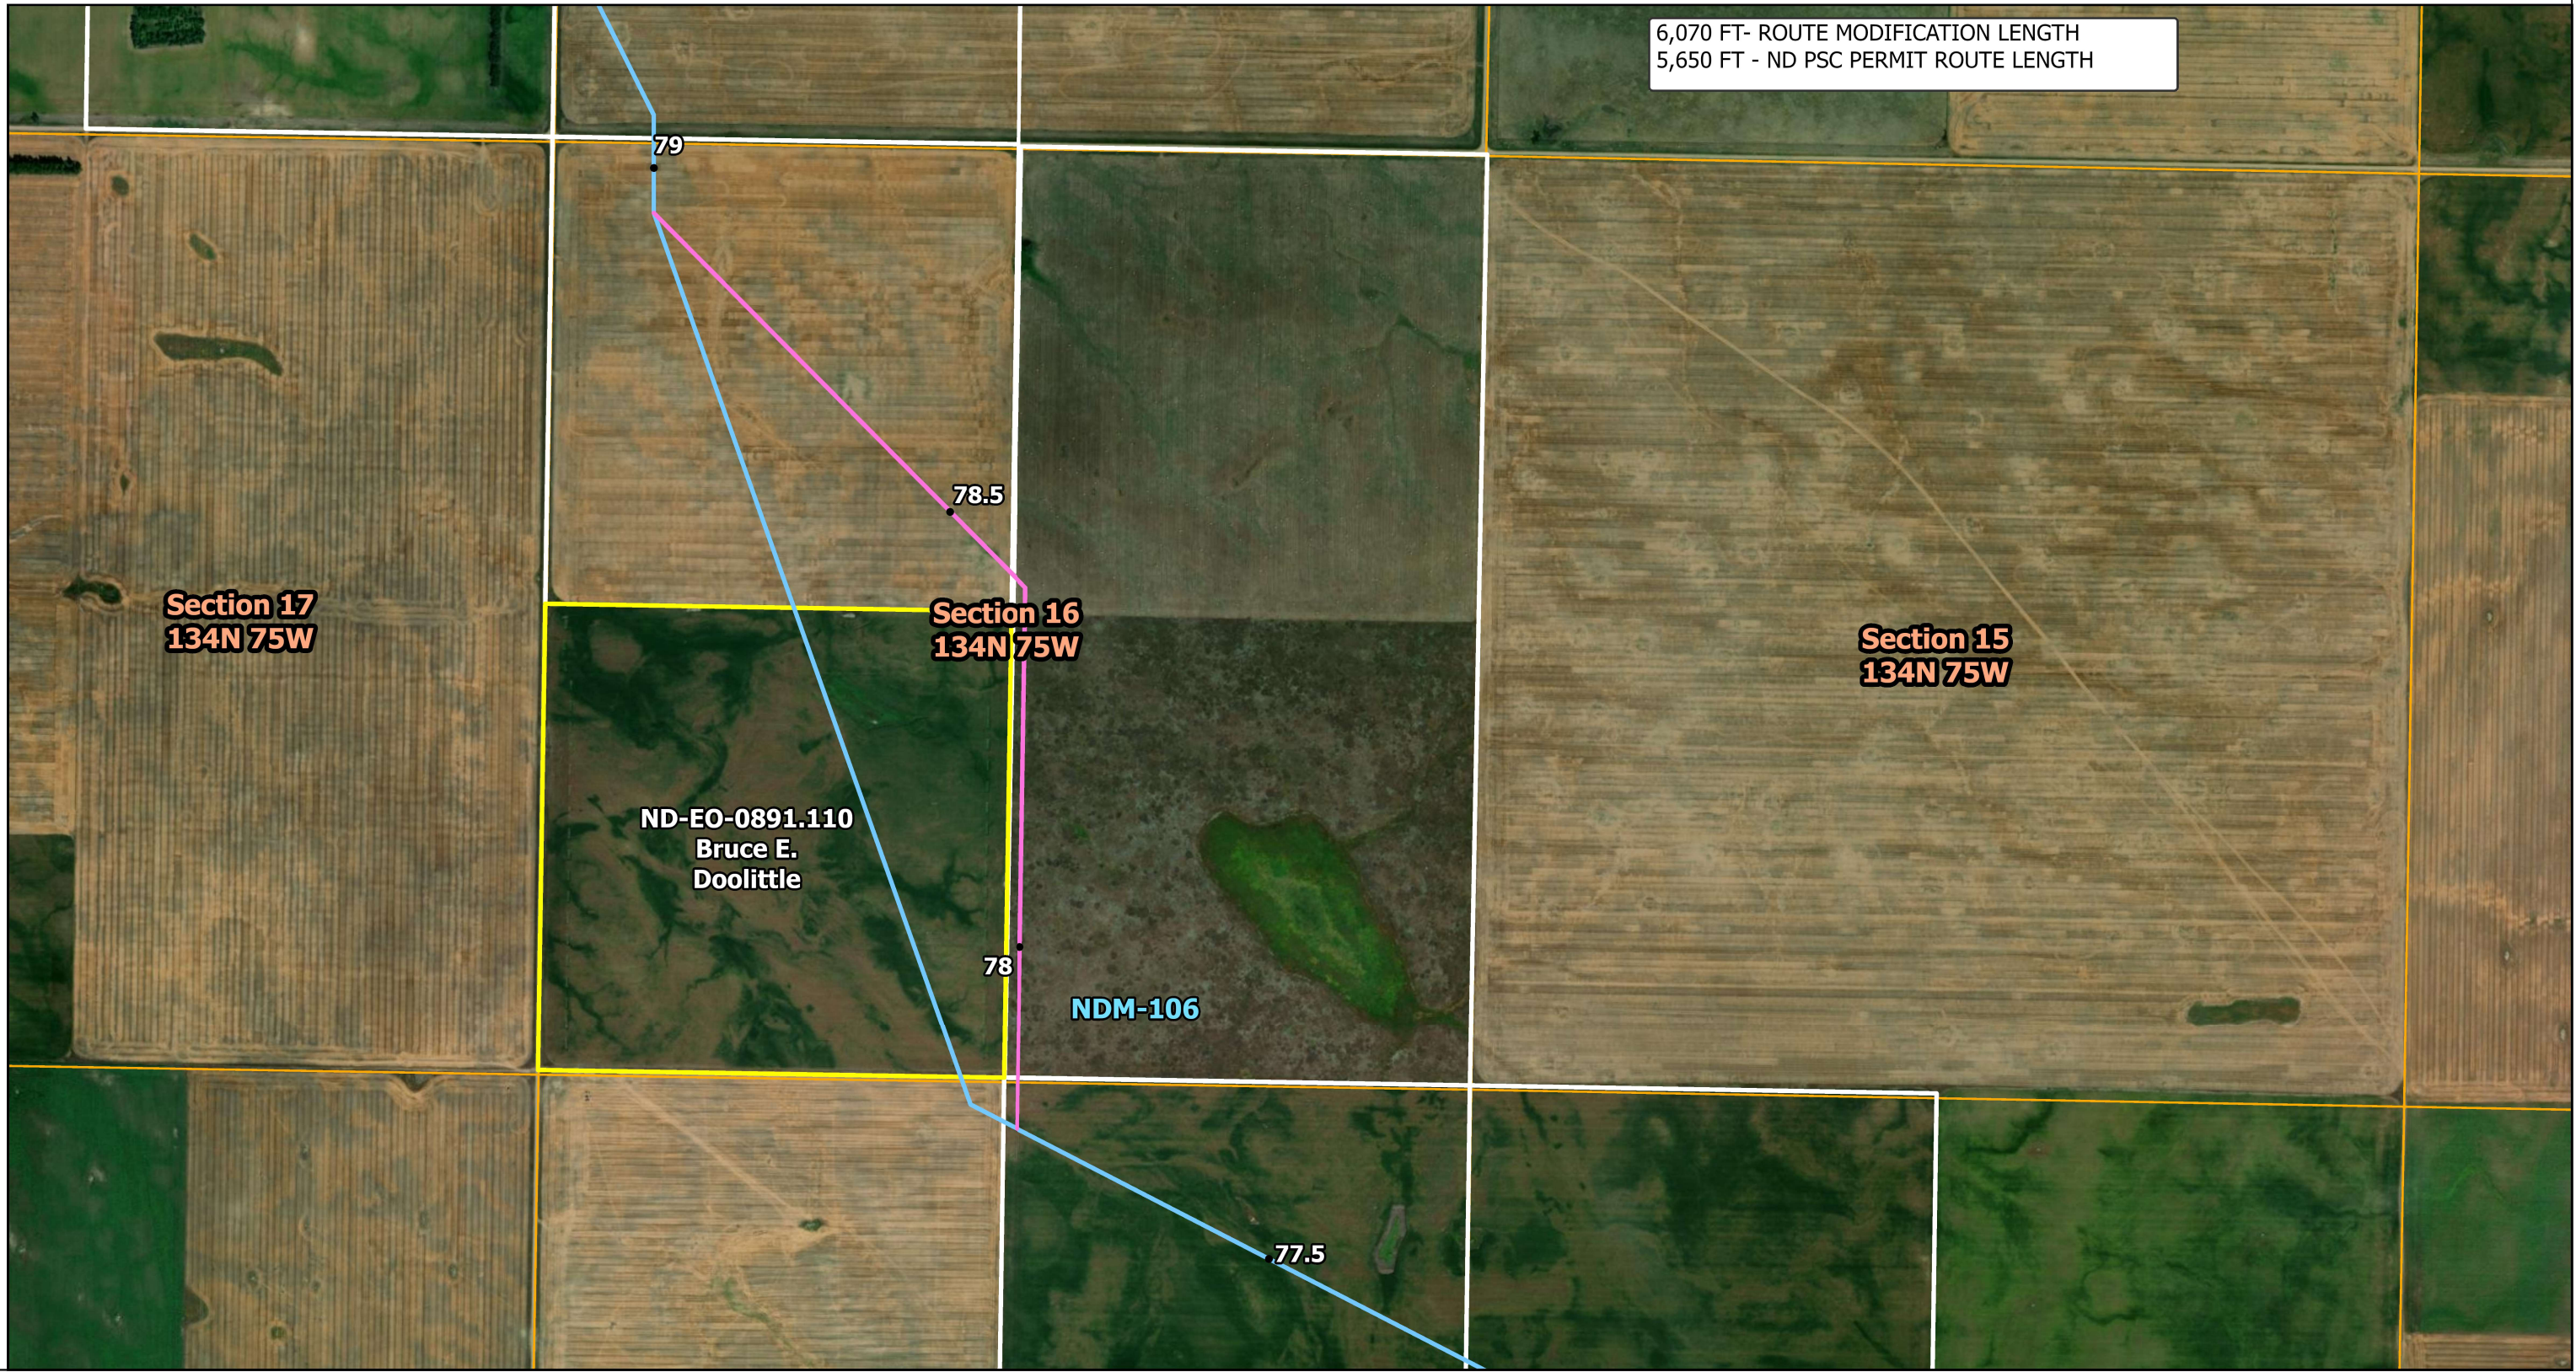


LO ROUTE
MODIFICATION 4
NORTH DAKOTA


Date: 08/16/2023

- | | |
|---|--|
| • Mileposts |  Landowner Intervenor |
|  Proposed Route Modification |  Online Properties |
|  ND PSC Permit Route |  PLSS Boundaries |



SUMMIT
CARBON
SOLUTIONS

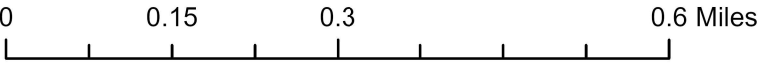

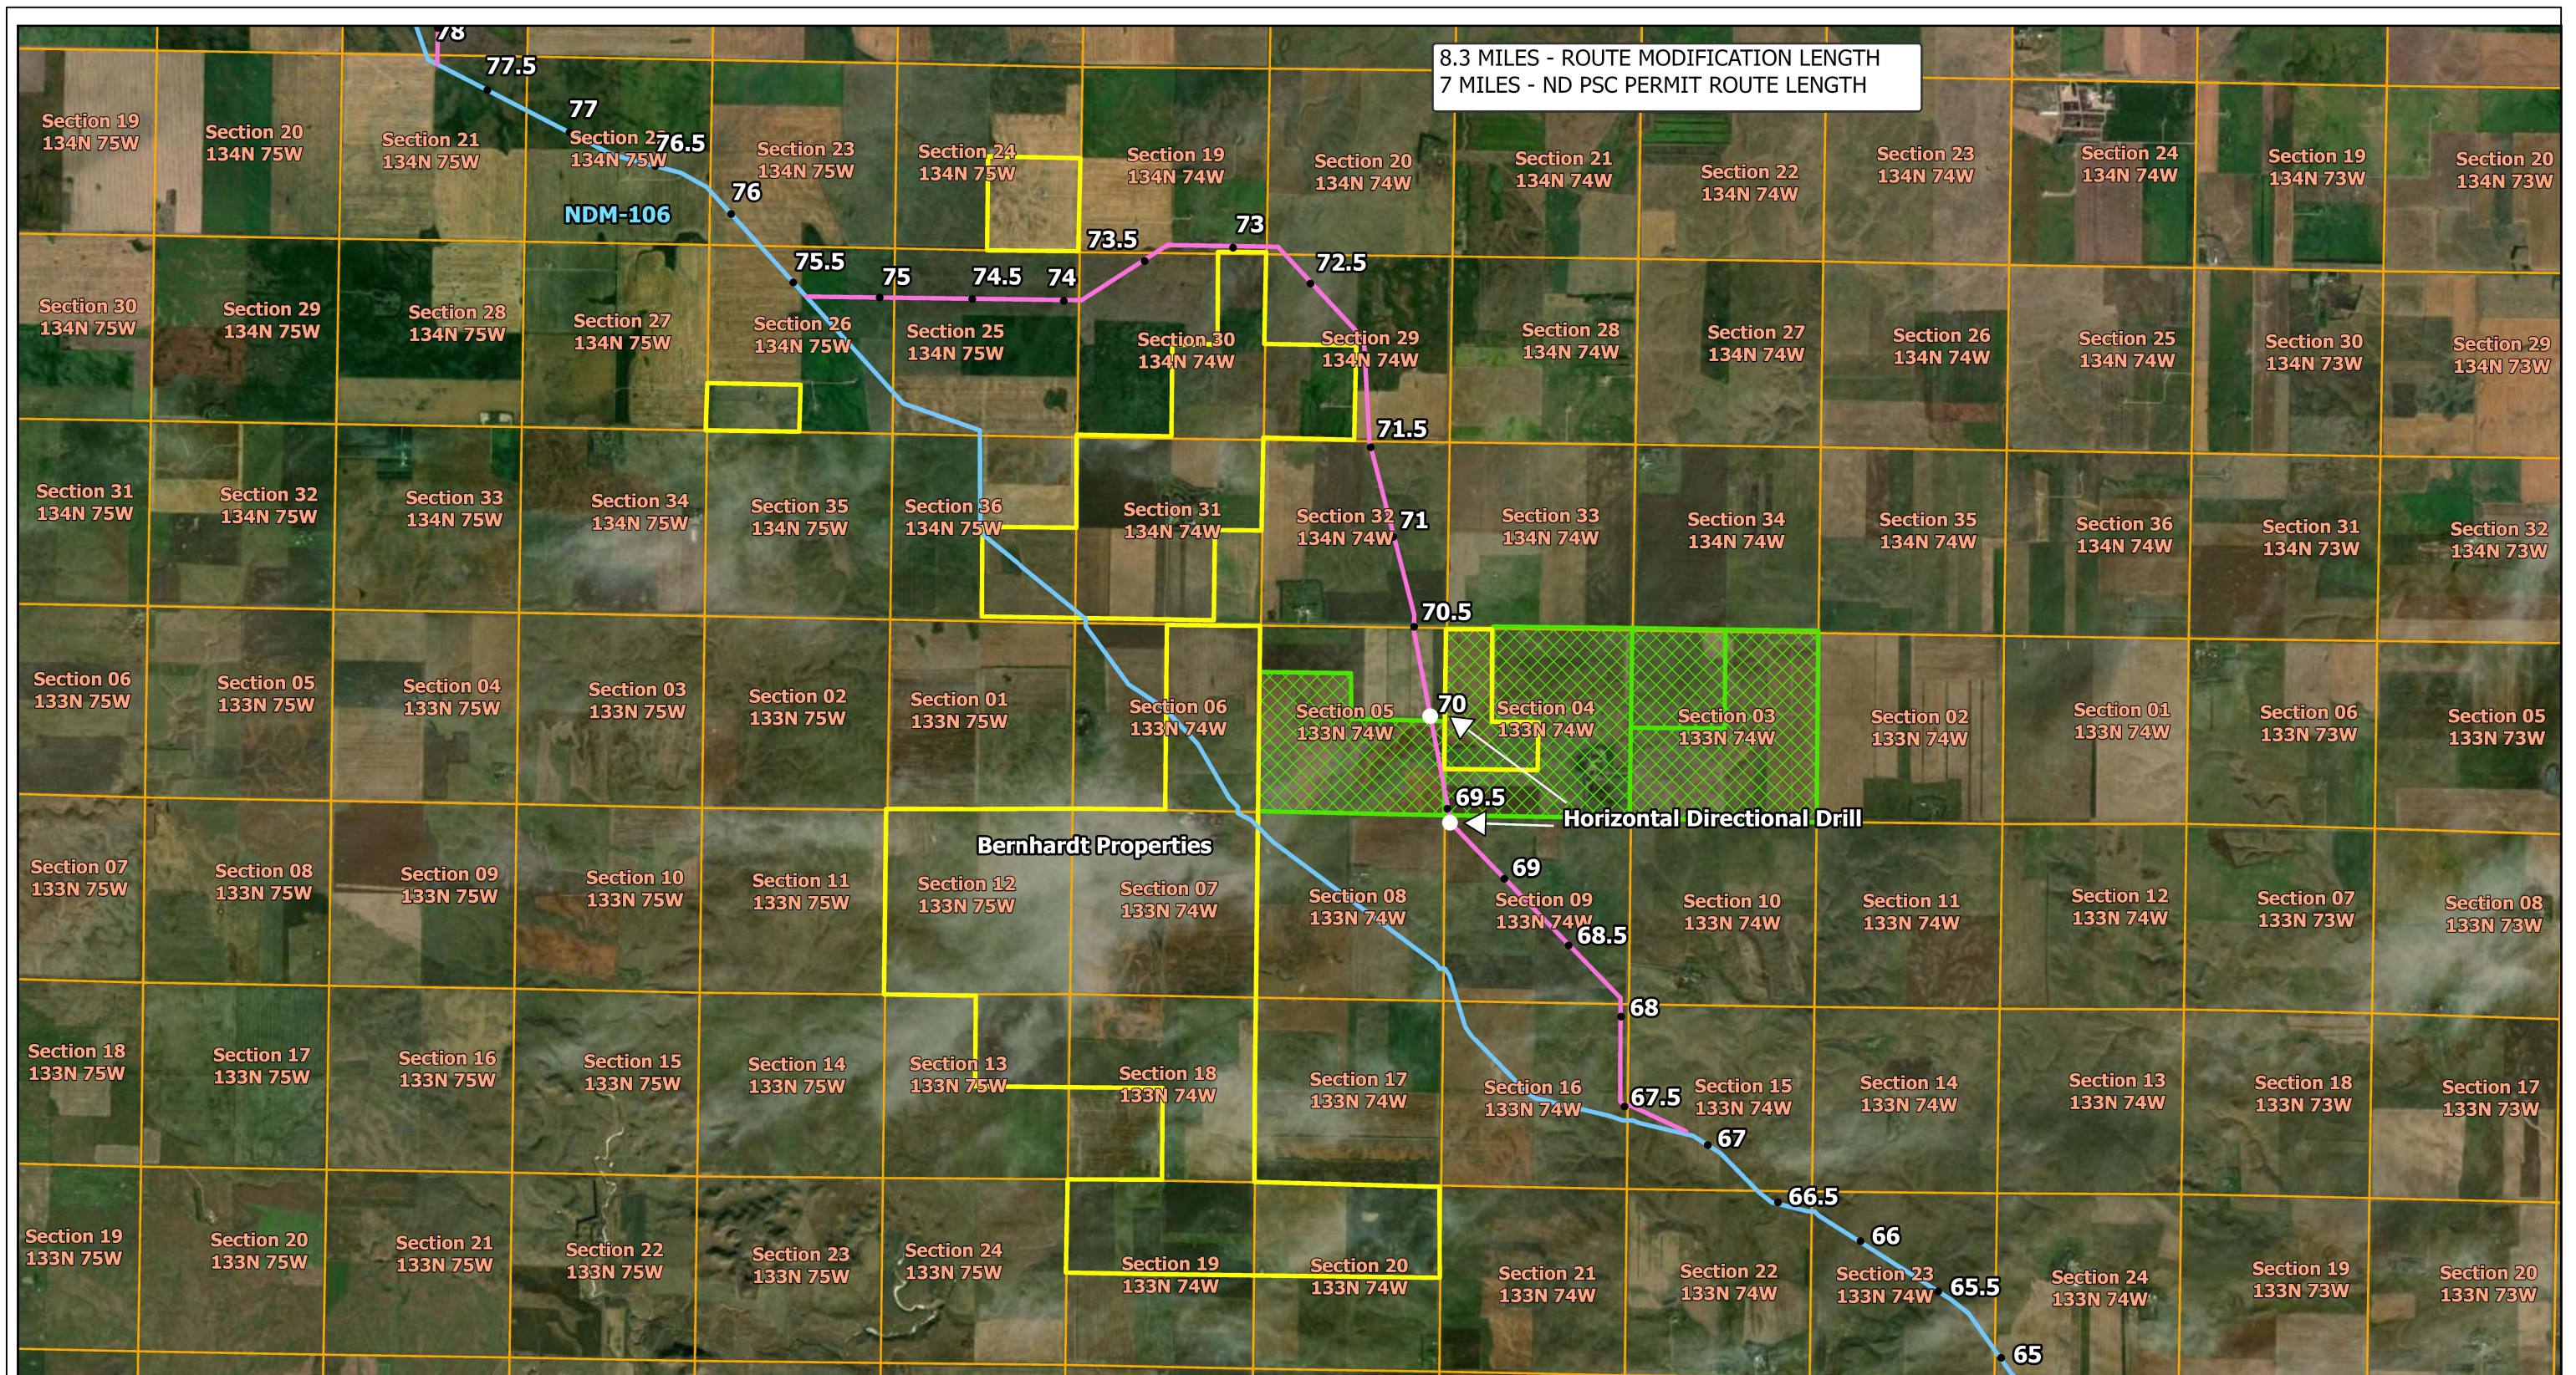

8.3 MILES - ROUTE MODIFICATION LENGTH
7 MILES - ND PSC PERMIT ROUTE LENGTH

Bernhardt Properties

Horizontal Directional Drill

LO ROUTE MODIFICATION 5 NORTH DAKOTA

Date: 08/16/2023

- Mileposts
- HDD Entry/Exit
- Proposed Route Modification
- ND PSC Permit Route
- Landowner Intervenor
- Emmons County Waterfowl Production Area
- PLSS Boundaries



SUMMIT
CARBON
SOLUTIONS

