



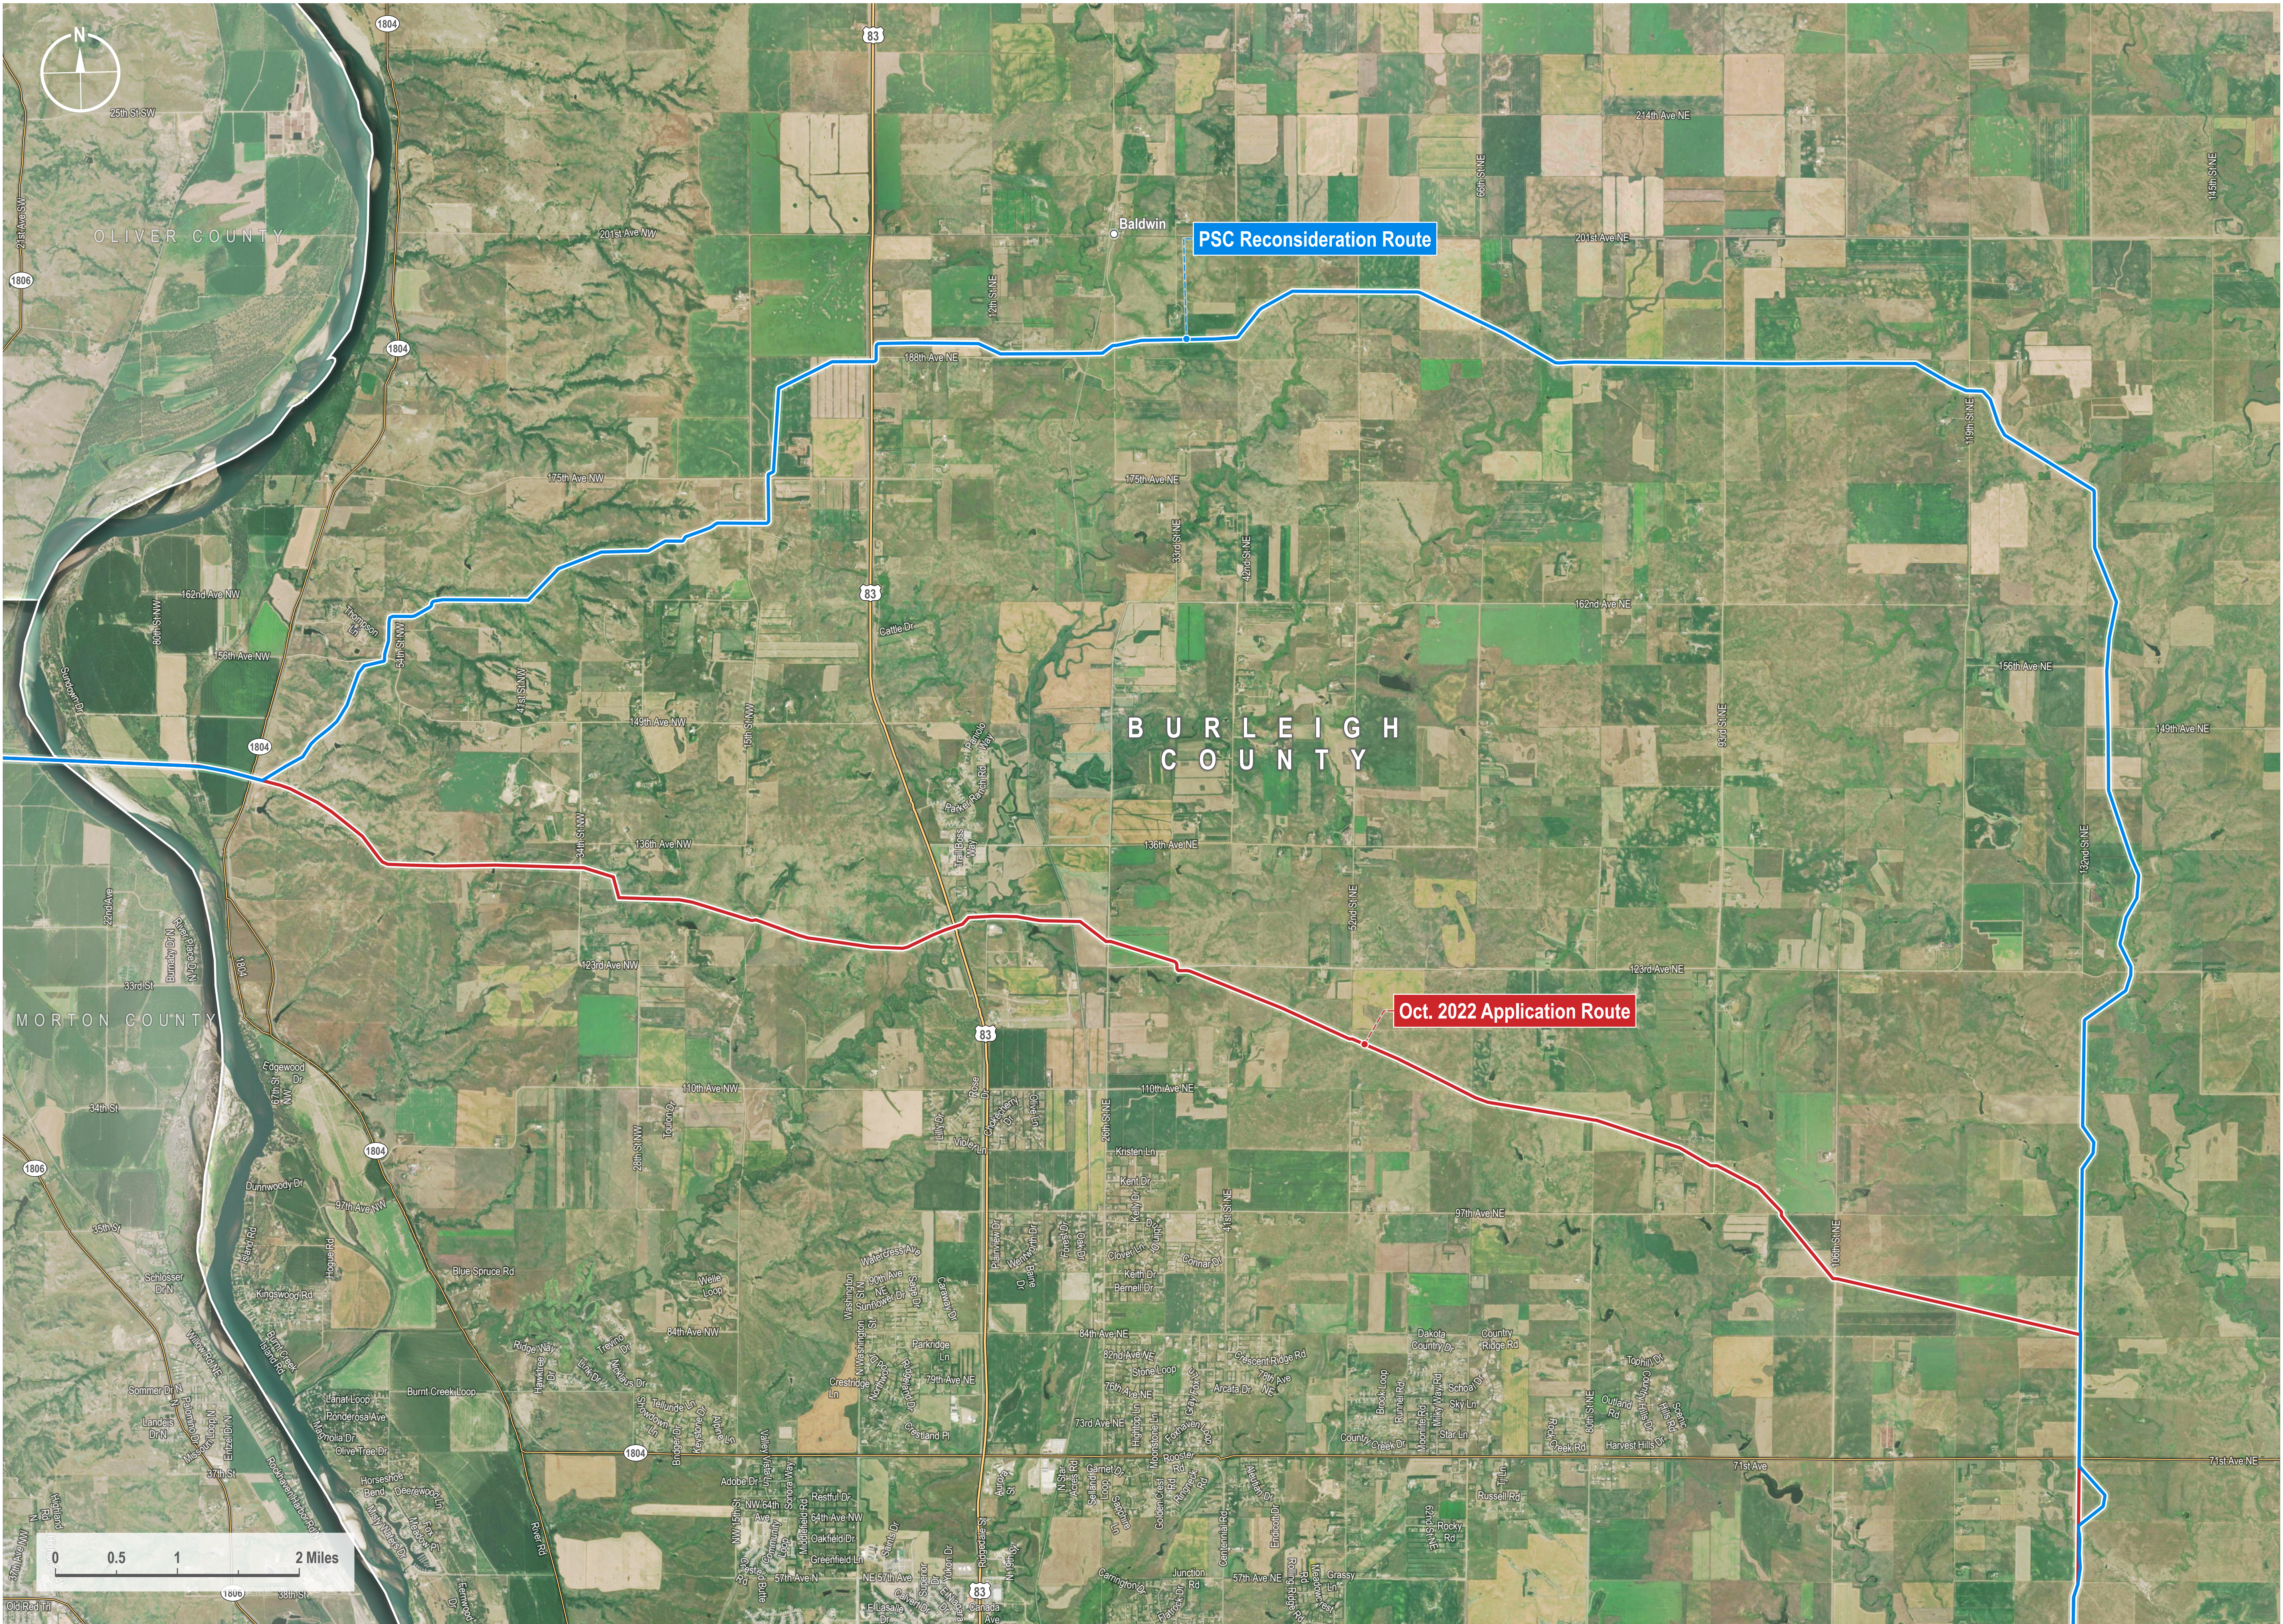

VICINITY MAP

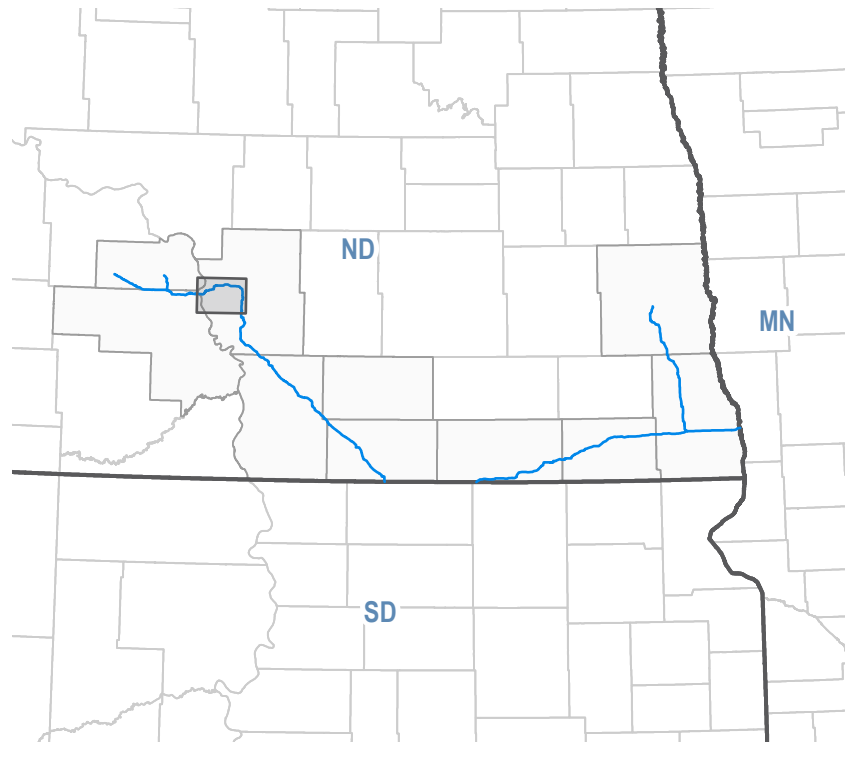

LEGEND

- PSC Reconsideration Route
- October 2022 Application Route

REVISIONS

Date: 2024-04-16 Revised by: PD Checked by: JZ
0 - Issued for Use
Issued drawing for use in NDPSR meetings.

Date: Revised by: Checked by:

Date: Revised by: Checked by:

PREPARED BY

Summit Carbon Solutions
2321 North Loop Drive, Suite 221
Ames, Iowa 50010
United States of America
www.summitcarbonsolutions.com




BISMARCK REROUTE


Drawing Title:
**Summit Carbon Solutions Project
NDPSR Proposed Routes
(Bismarck Reroute)**

Scale: 1 : 40,000 1 inch equals 0.63 miles	Projection: Transverse Mercator NAD 1983 UTM Zone 14N
Sheet: 1 1 of 1	Drawing Number: 1001-06-033-Bismarck Revision 0

SUMMIT CARBON SOLUTIONS PROJECT - NDPSC PROPOSED ROUTES - BURLEIGH COUNTY

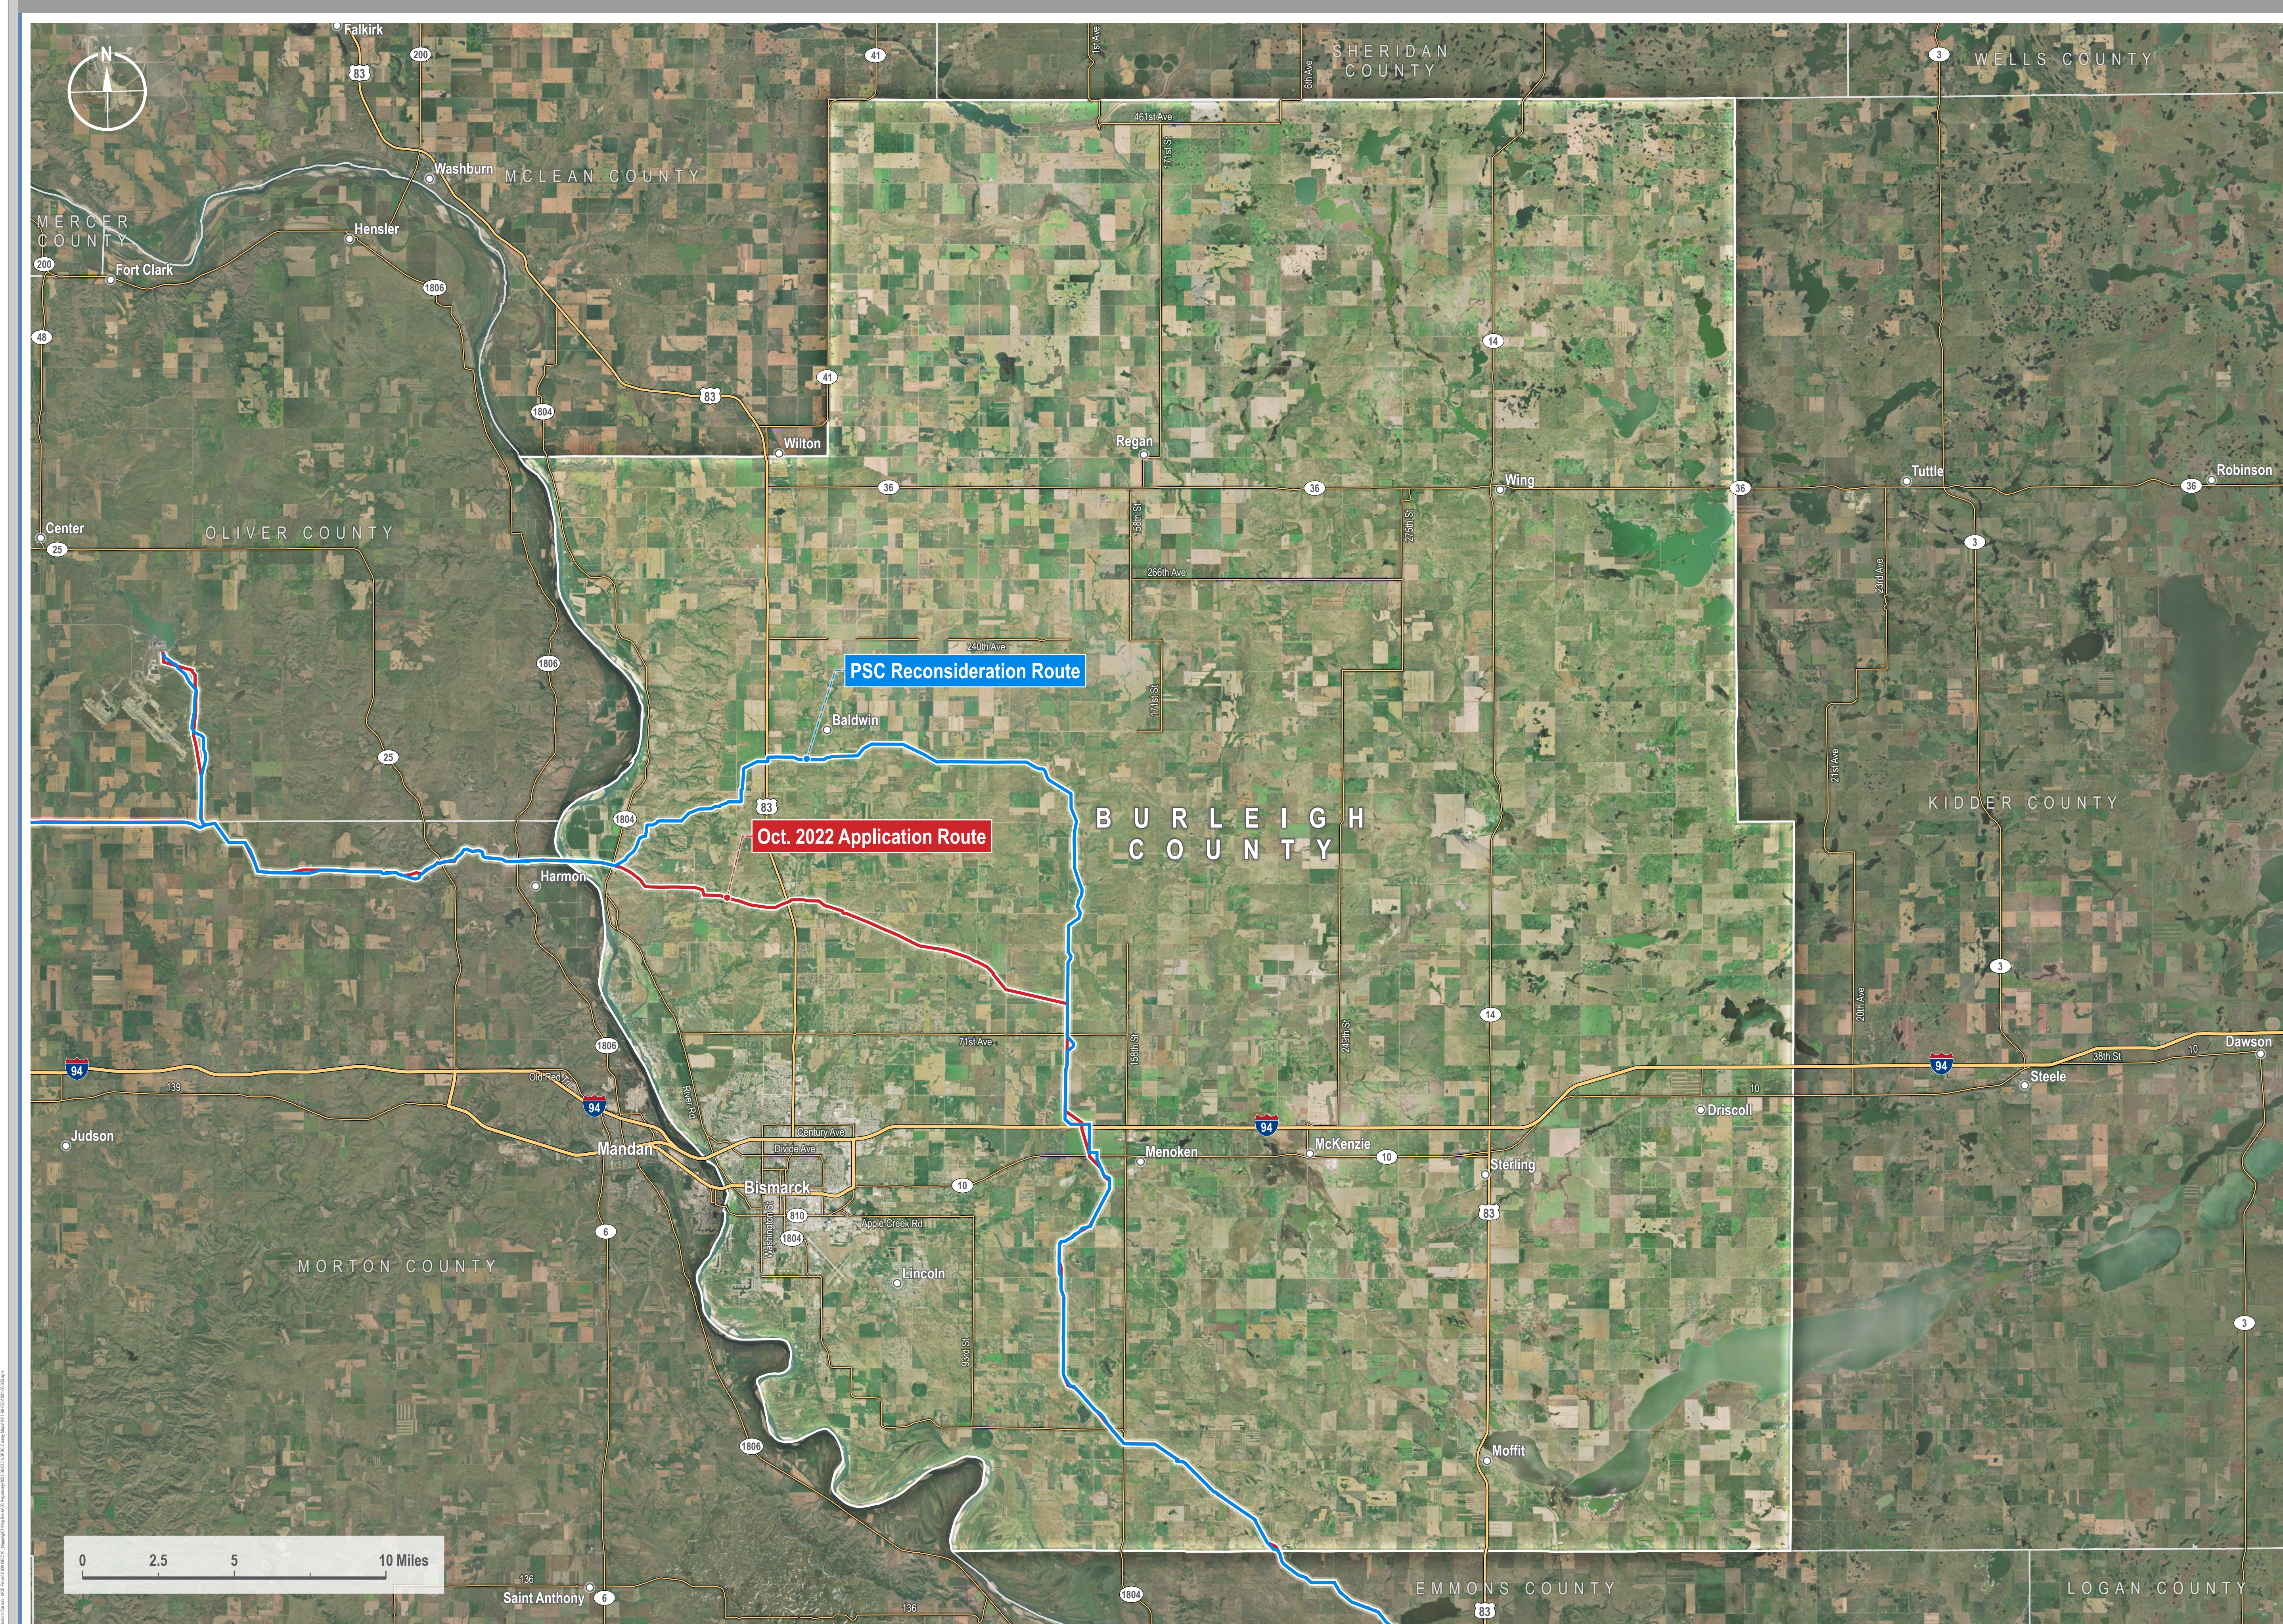

VICINITY MAP

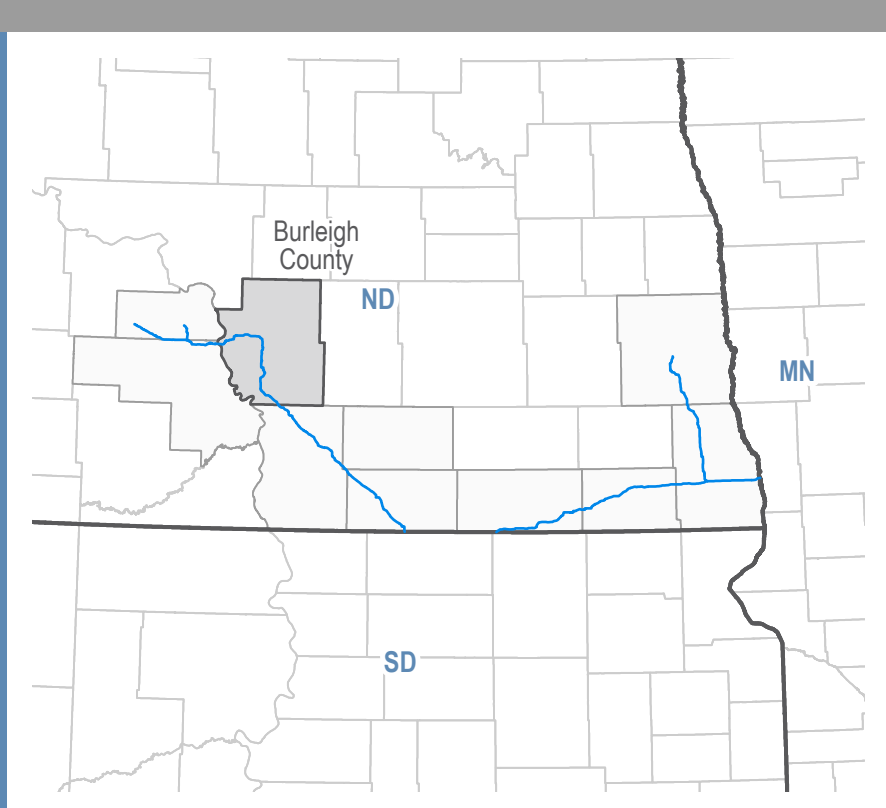

LEGEND

- PSC Reconsideration Route
— October 2022 Application Route

REVISIONS

Date: 2024-04-16 Revised by: PD Checked by: JZ

0 - Issued for Use

Issued drawing for use in NDPSC meetings.

Issued drawing for use in NDPSC meetings.

Date: _____ Revised by: _____ Checked by: _____

Date: _____ Revised by: _____ Checked by: _____

PREPARED BY

Summit Carbon Solutions

2321 North Loop Drive, Suite 221
Ames, Iowa 50010
United States of America

www.summitcarbonsolutions.com



The logo for Summit Carbon Solutions features a stylized blue icon on the left, composed of geometric shapes forming a mountain-like structure. To the right of the icon, the words "SUMMIT CARBON" are written in a large, bold, sans-serif font, with "SOLUTIONS" in a smaller, all-caps font directly beneath it.



SUMMIT CARBON
SOLUTIONS

BURLEIGH COUNTY

Drawing Title:

Summit Carbon Solutions Project
NDPSC Proposed Routes

(Burleigh County)


Scale: 1 : 159,000 1 inch equals 2.51 miles	Projection: Transverse Mercator NAD 1983 UTM Zone 14N
--	--

Projection:
Transverse Mercator
NAD 1983 UTM Zone 14N

Sheet: **3**
3 of 10

Drawing Number: **1001-06-033**
Revision 0

Drawing Number:
1001-06-033
Revision 0

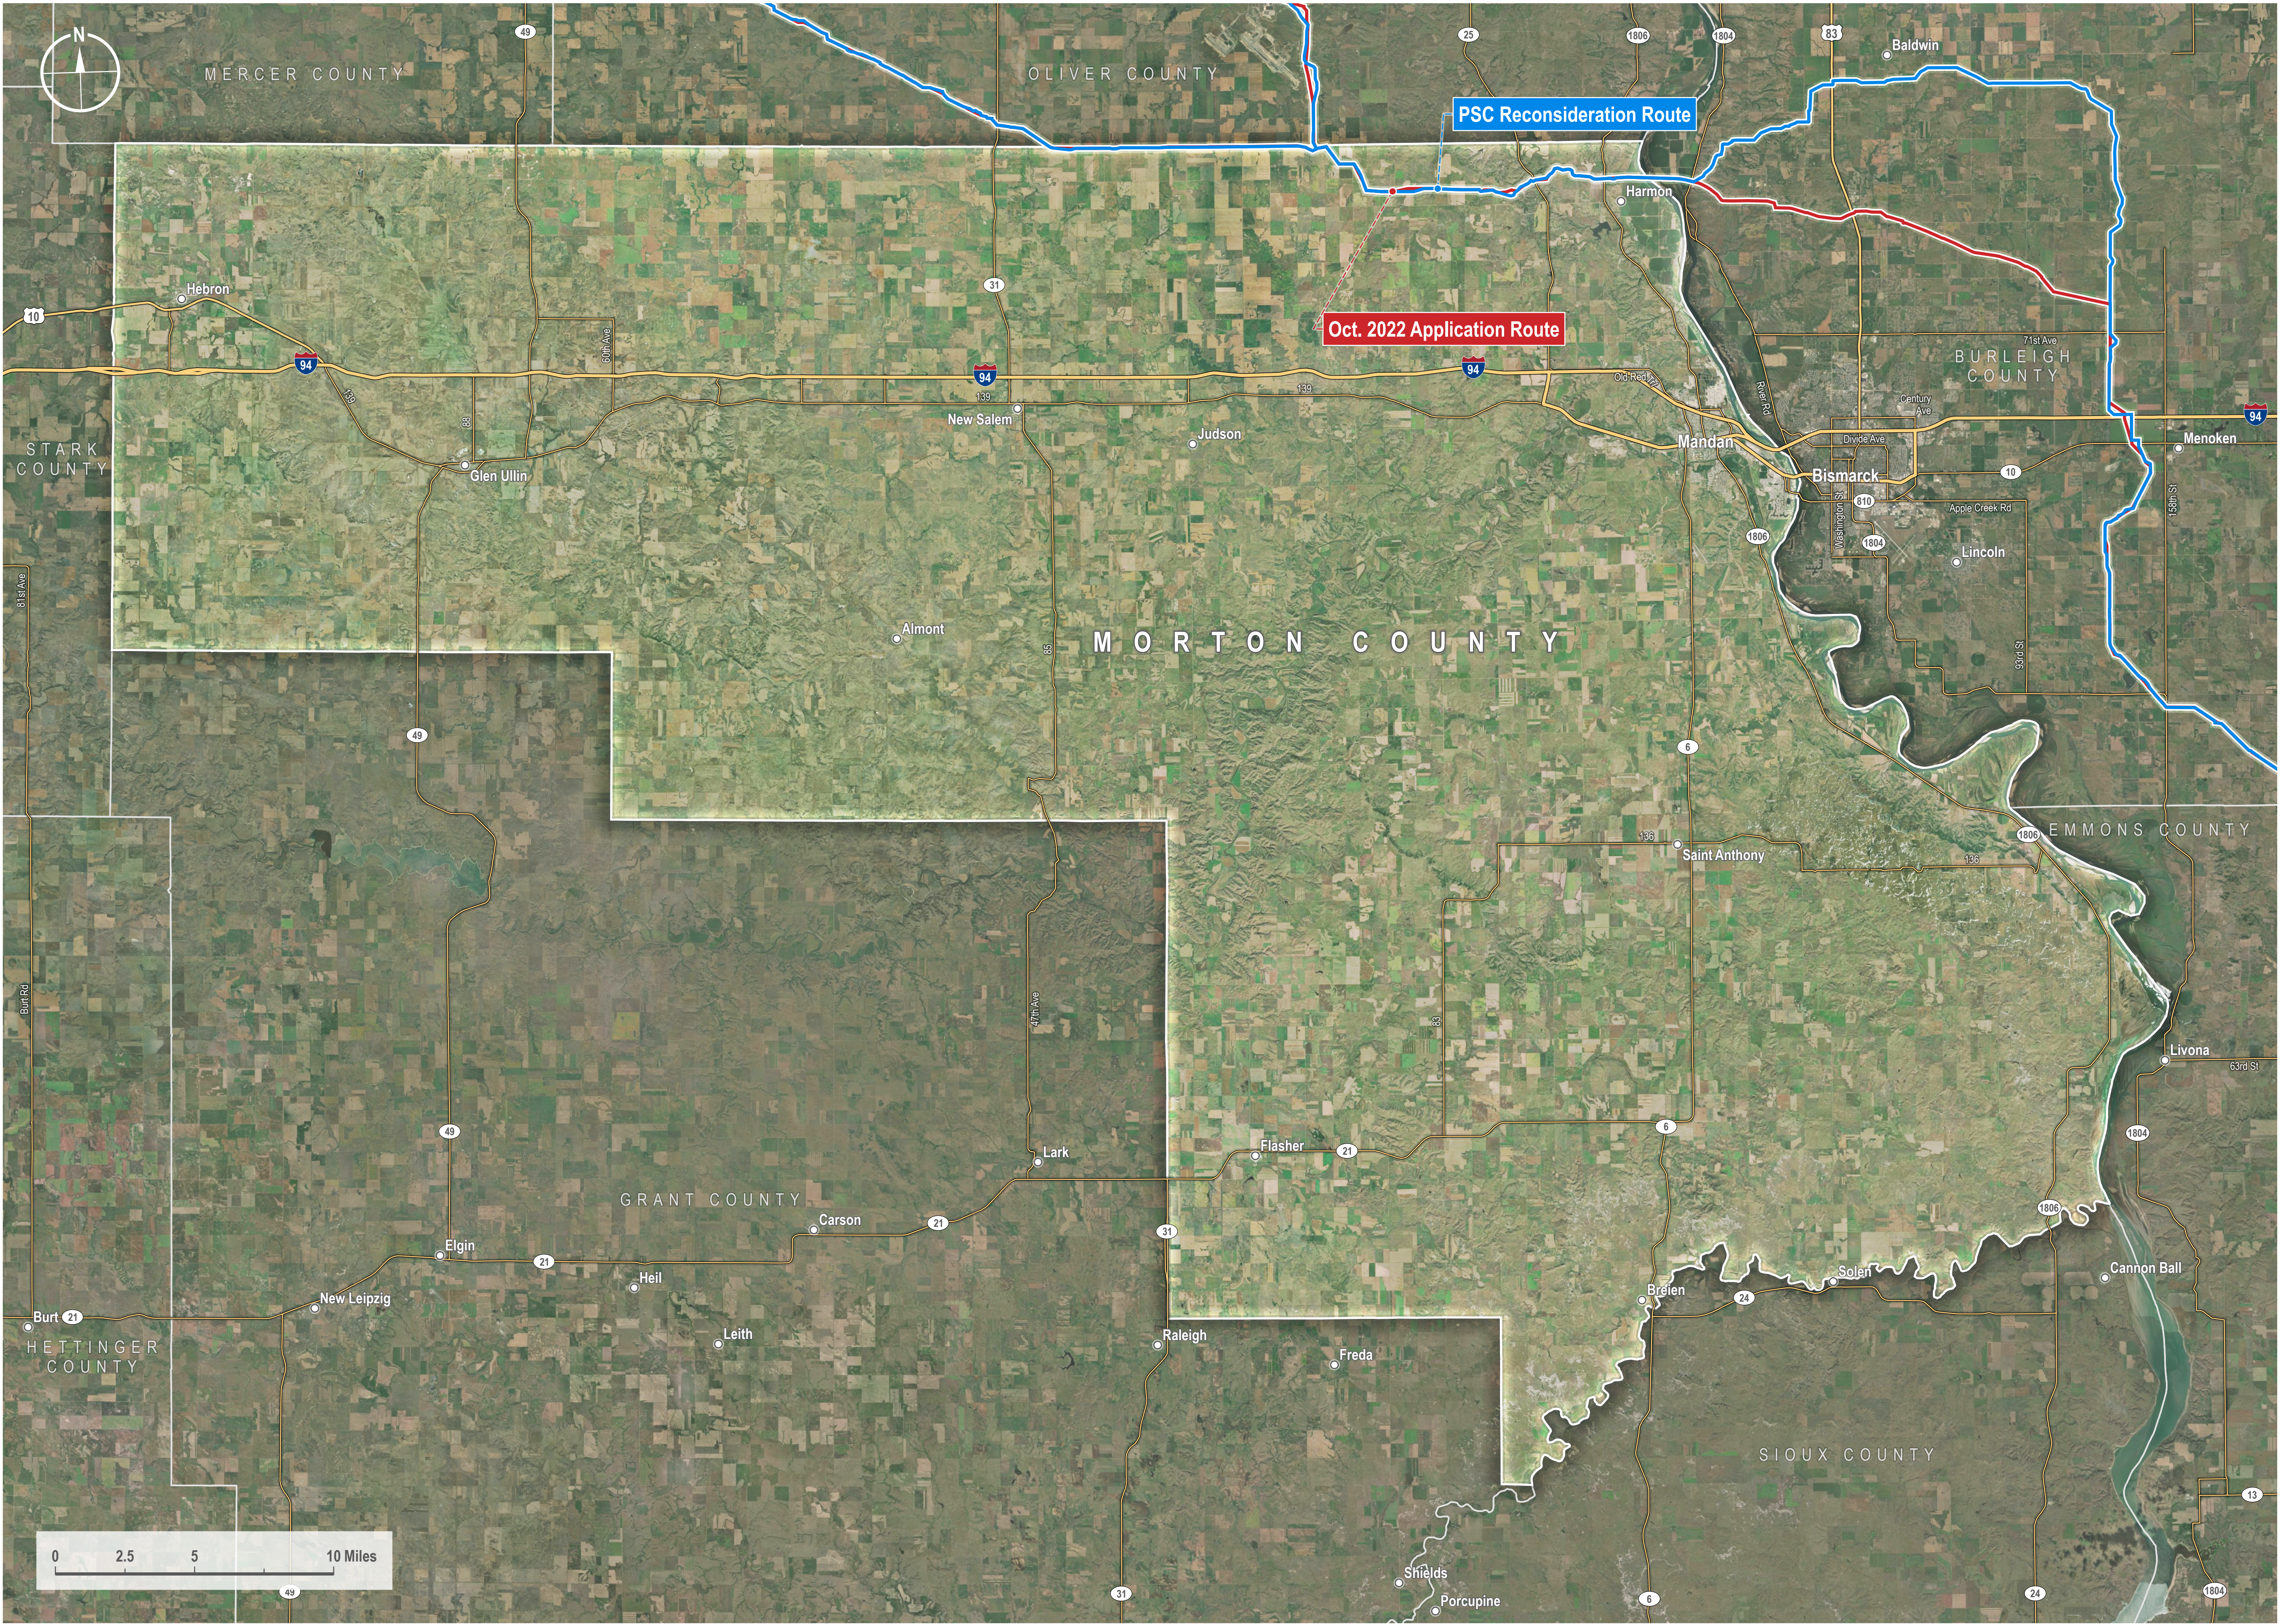

VICINITY MAP

LEGEND

PSC Reconsideration Route

October 2022 Application Route

REVISIONS

Date:

2024-04-16

Revised by:

PD

Checked by:

JZ

0 - Issued for Use

Issued drawing for use in NDPSC meetings.

Date:

Revised by:

Checked by:

Date:

Revised by:

Checked by:

PREPARED BY

Summit Carbon Solutions

2321 North Loop Drive, Suite 221
Ames, Iowa 50010
United States of America
www.summitcarbonsolutions.com

MORTON COUNTY

Drawing Title:

Summit Carbon Solutions Project
NDPSC Proposed Routes

(Morton County)

Scale:

1 : 175,000
1 inch equals 2.76 miles

Projection:

Transverse Mercator
NAD 1983 UTM Zone 14N

Sheet:

2
2 of 10

Drawing Number:

1001-06-033
Revision 0



VICINITY MAP

LEGEND

REVISIONS

PREPARED BY


OLIVER COUNTY

Scale:
1 : 99,000
1 inch equals 1.56 miles

Projection:
Transverse Mercator
NAD 1983 UTM Zone 14N

Sheet:
1
1 of 10

Drawing Number:
1001-06-033
Revision 0

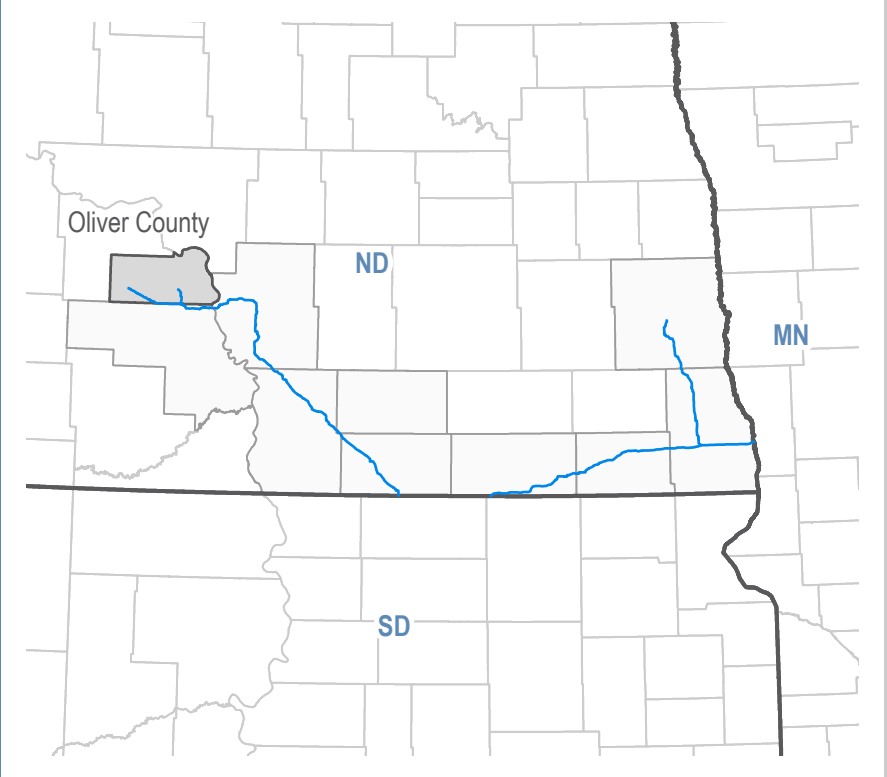

LEGEND

PSC Reconsideration Route

October 2022 Application Route

REVISIONS		
Date: 2024-04-16	Revised by: PD	Checked by: JZ
0 - Issued for Use		
Issued drawing for use in NDPSC meetings.		
Date:	Revised by:	Checked by:
Date:	Revised by:	Checked by:

PREPARED BY

Summit Carbon Solutions

2321 North Loop Drive, Suite 221
Ames, Iowa 50010
United States of America
www.summitcarbonsolutions.com




SUMMIT CARBON
SOLUTIONS

OLIVER COUNTY

Drawing Title:

Summit Carbon Solutions Project
NDPSC Proposed Routes
(Oliver County)

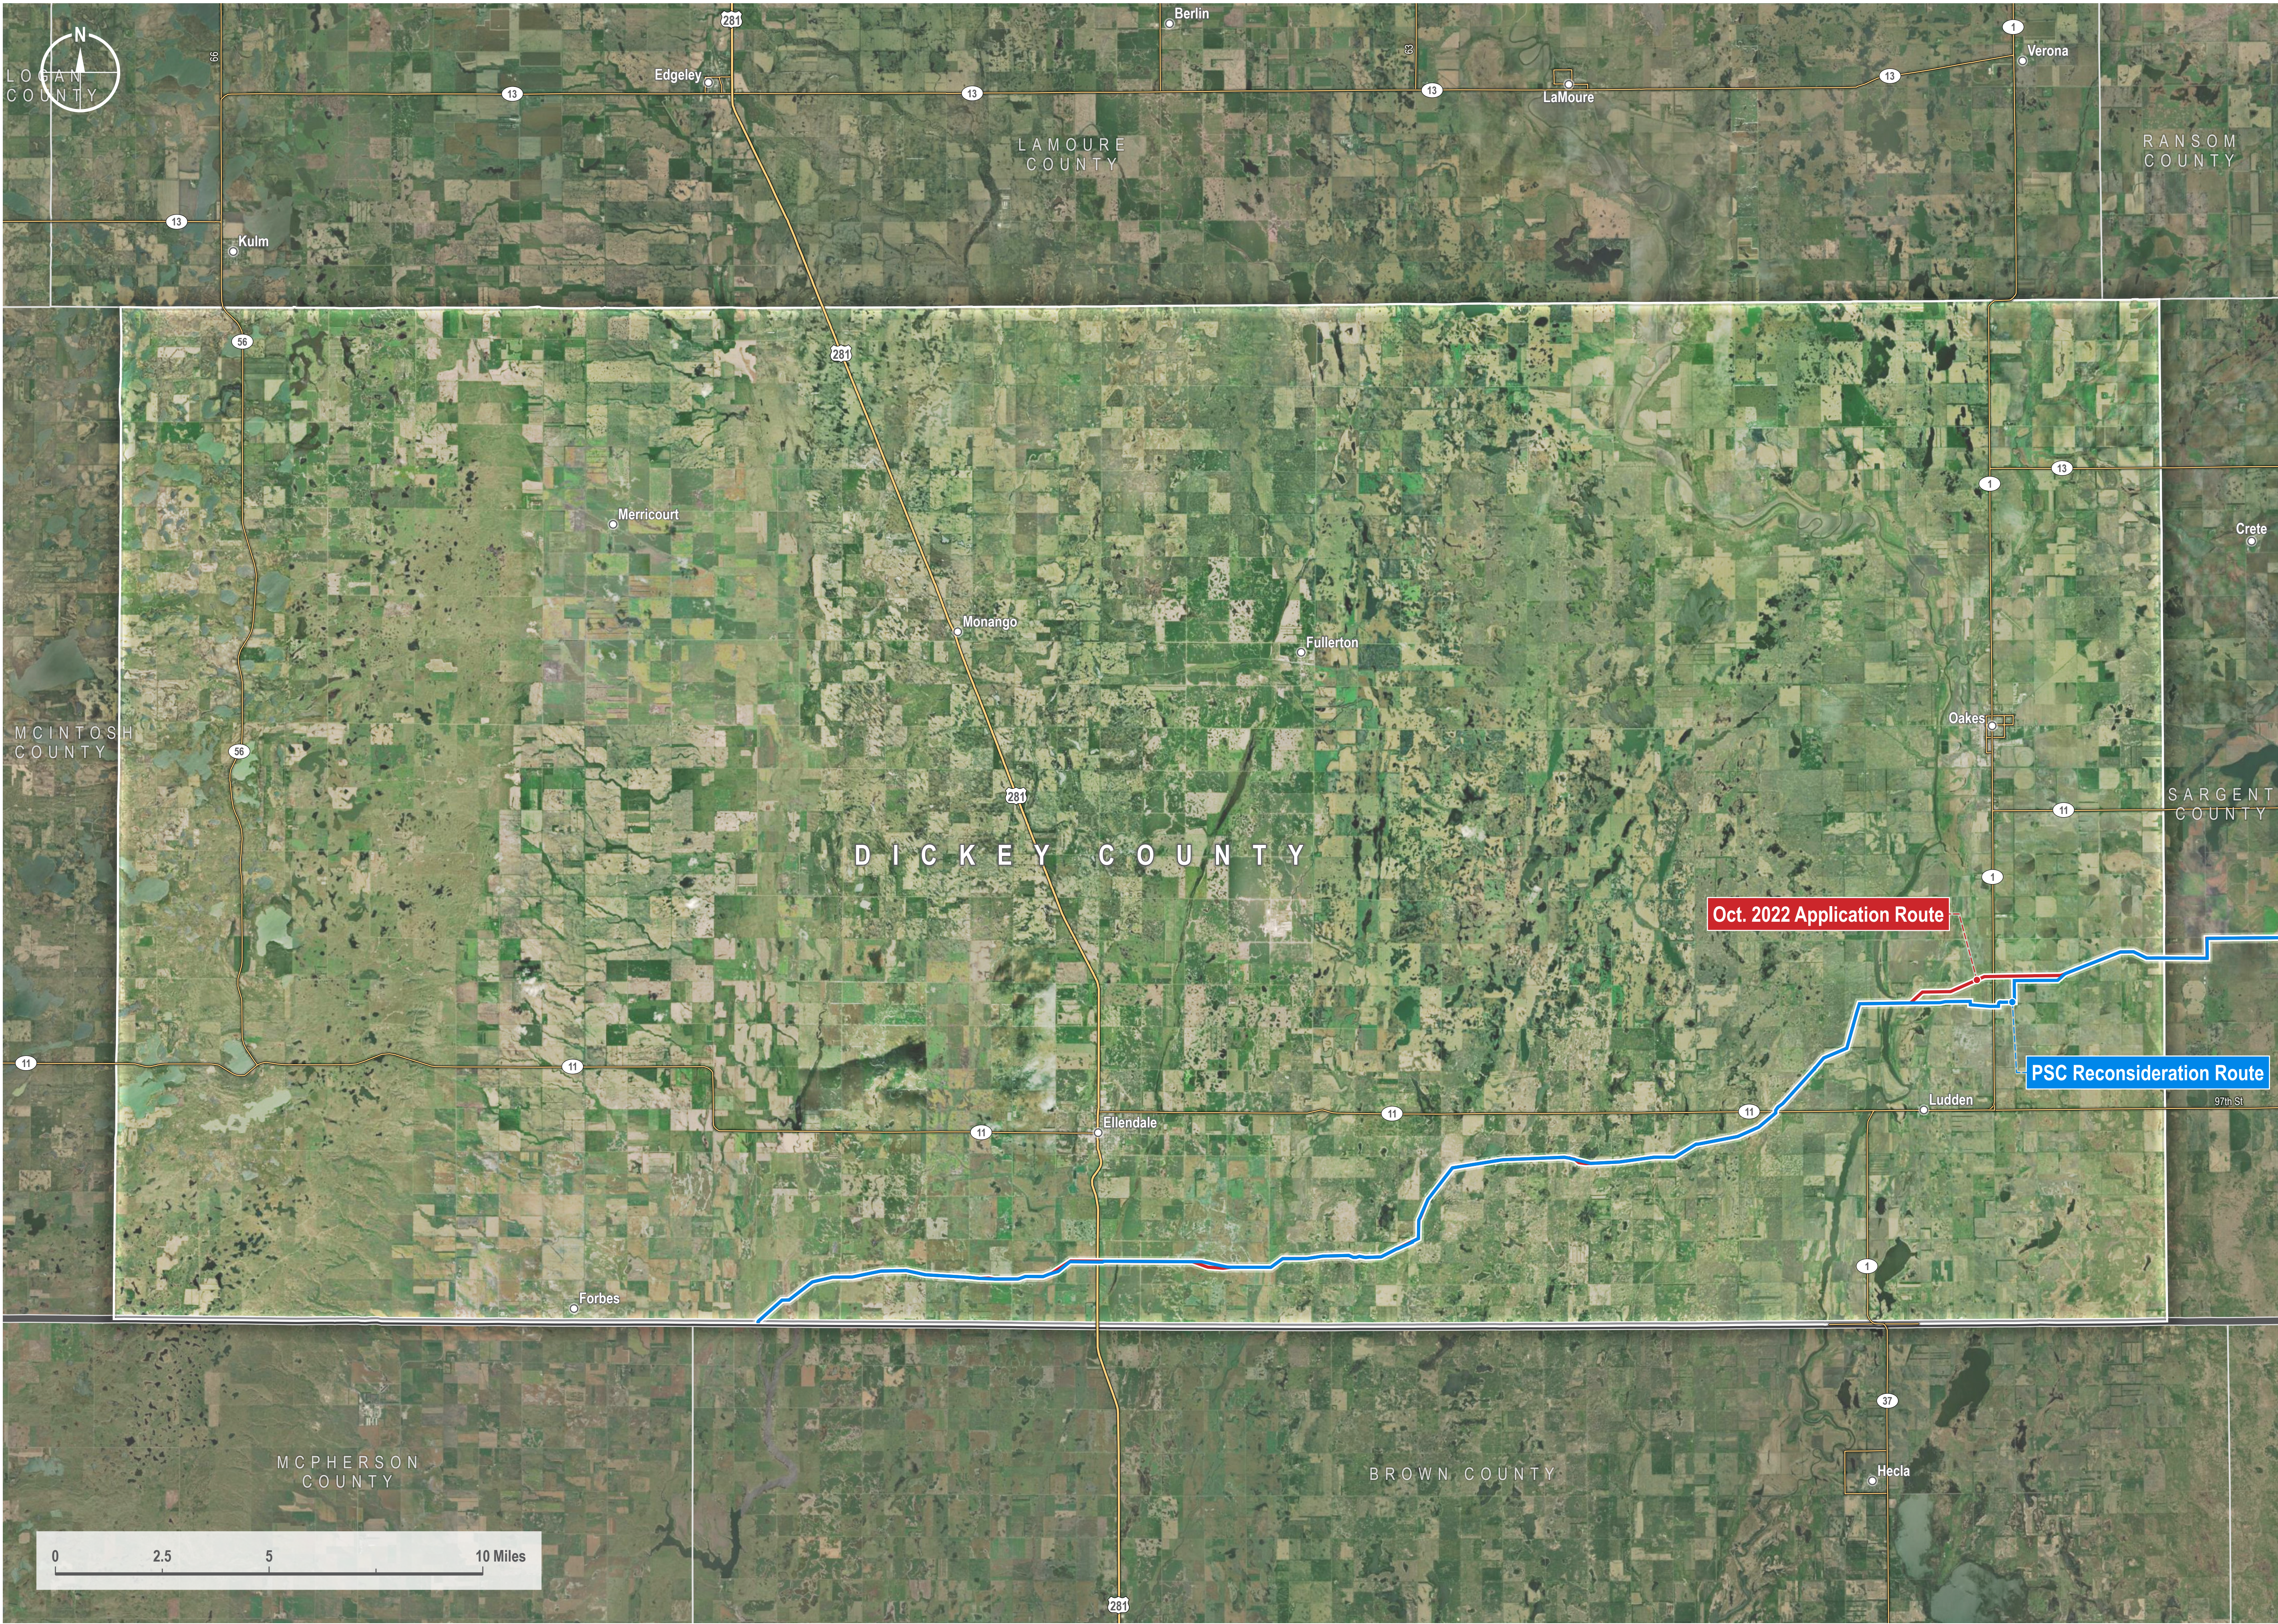

VICINITY MAP

LEGEND

— PSC Reconsideration Route

— October 2022 Application Route

REVISIONS

Date:	2024-04-16	Revised by:	PD	Checked by:	JZ
0 - Issued for Use					
Issued drawing for use in NDPSC meetings.					
Date:		Revised by:		Checked by:	
Date:		Revised by:		Checked by:	

PREPARED BY

Summit Carbon Solutions

2321 North Loop Drive, Suite 221
Ames, Iowa 50010
United States of America

www.summitcarbonsolutions.com


DICKEY COUNTY

Drawing Title:


**Summit Carbon Solutions Project
NDPSC Proposed Routes**

(Dickey County)

Scale: 1 : 114,000 1 inch equals 1.8 miles	Projection: Transverse Mercator NAD 1983 UTM Zone 14N
Sheet: 7 7 of 10	Drawing Number: 1001-06-033 Revision 0

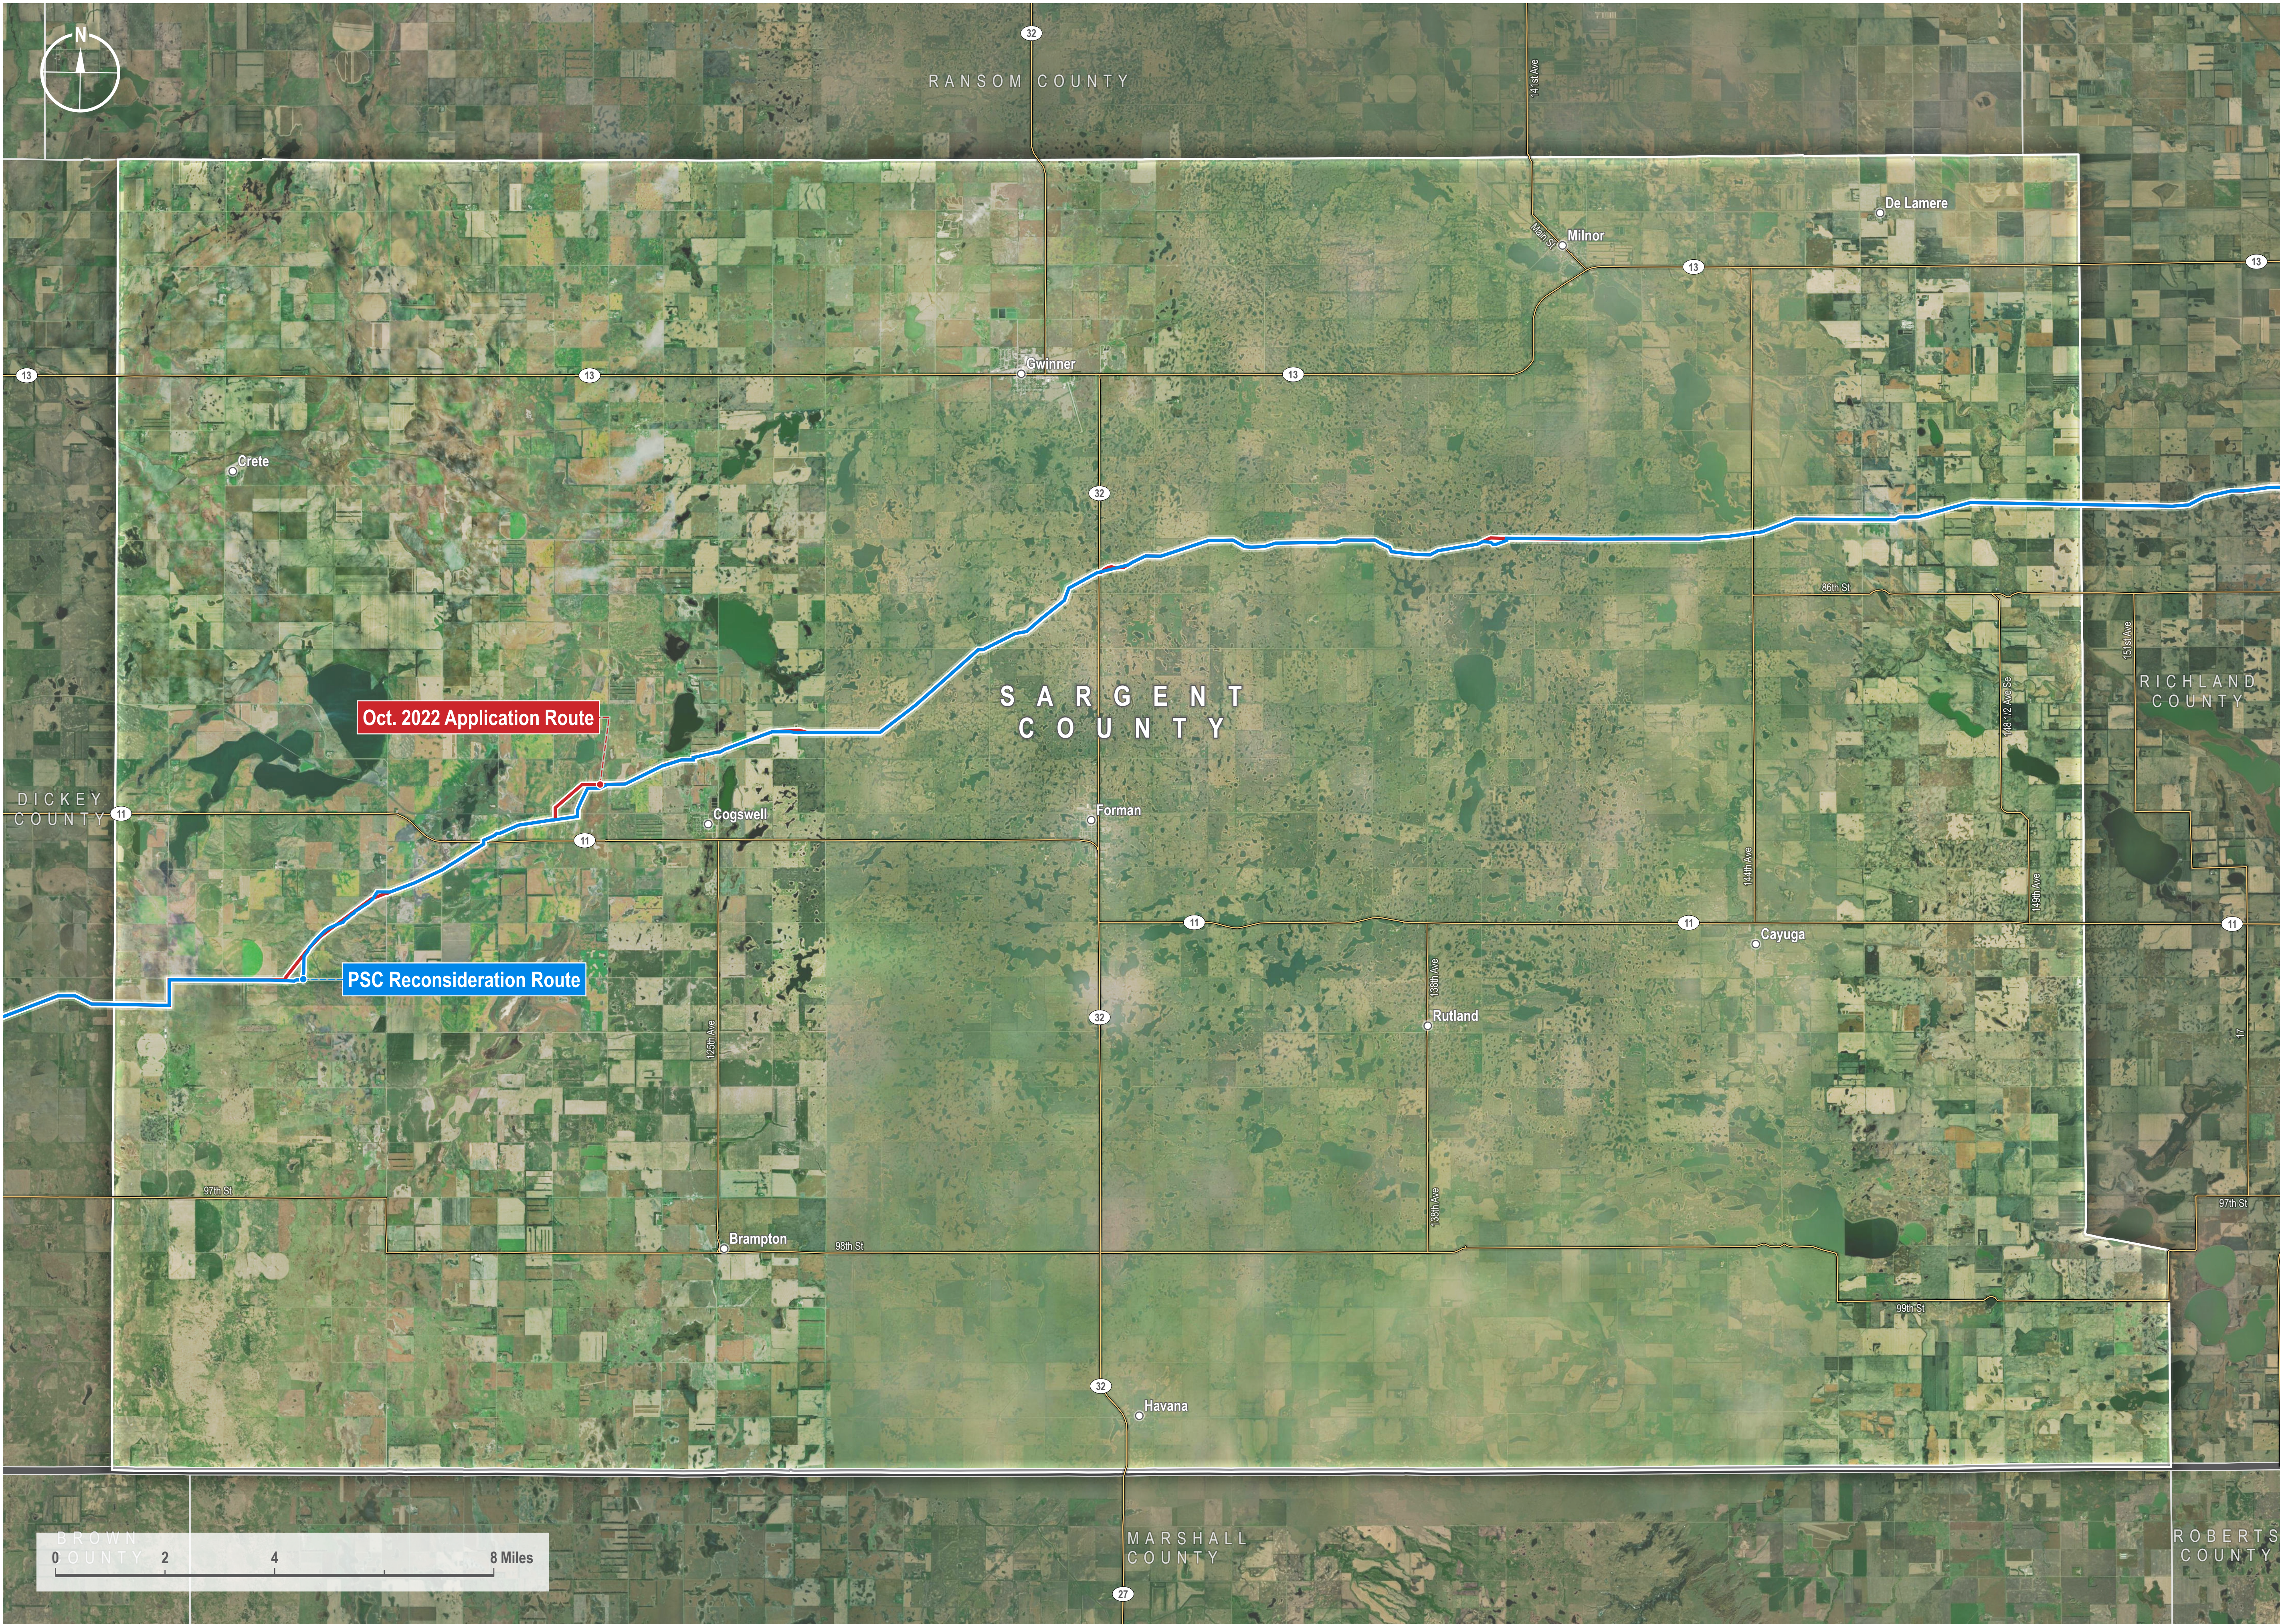

VICINITY MAP

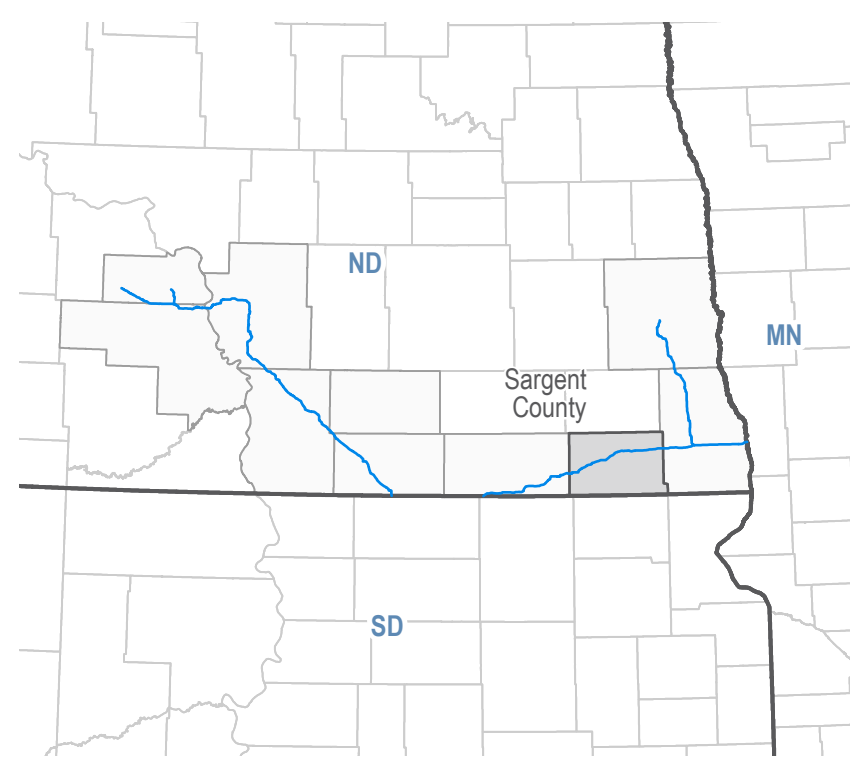

LEGEND

- PSC Reconsideration Route
- October 2022 Application Route

REVISIONS

Date:	2024-04-16	Revised by:	PD	Checked by:	JZ
0 - Issued for Use					
Issued drawing for use in NDPSC meetings.					
Date:		Revised by:		Checked by:	
Date:		Revised by:		Checked by:	

PREPARED BY

Summit Carbon Solutions

2321 North Loop Drive, Suite 221
Ames, Iowa 50010
United States of America
www.summitcarbonsolutions.com




SARGENT COUNTY

Drawing Title:


**Summit Carbon Solutions Project
NDPSC Proposed Routes
(Sargent County)**

Scale: 1 : 89,000 1 inch equals 1.4 miles	Projection: Transverse Mercator NAD 1983 UTM Zone 14N
Sheet: 8 8 of 10	Drawing Number: 1001-06-033 Revision 0

SUMMIT CARBON SOLUTIONS PROJECT - NDPSC PROPOSED ROUTES - CASS COUNTY

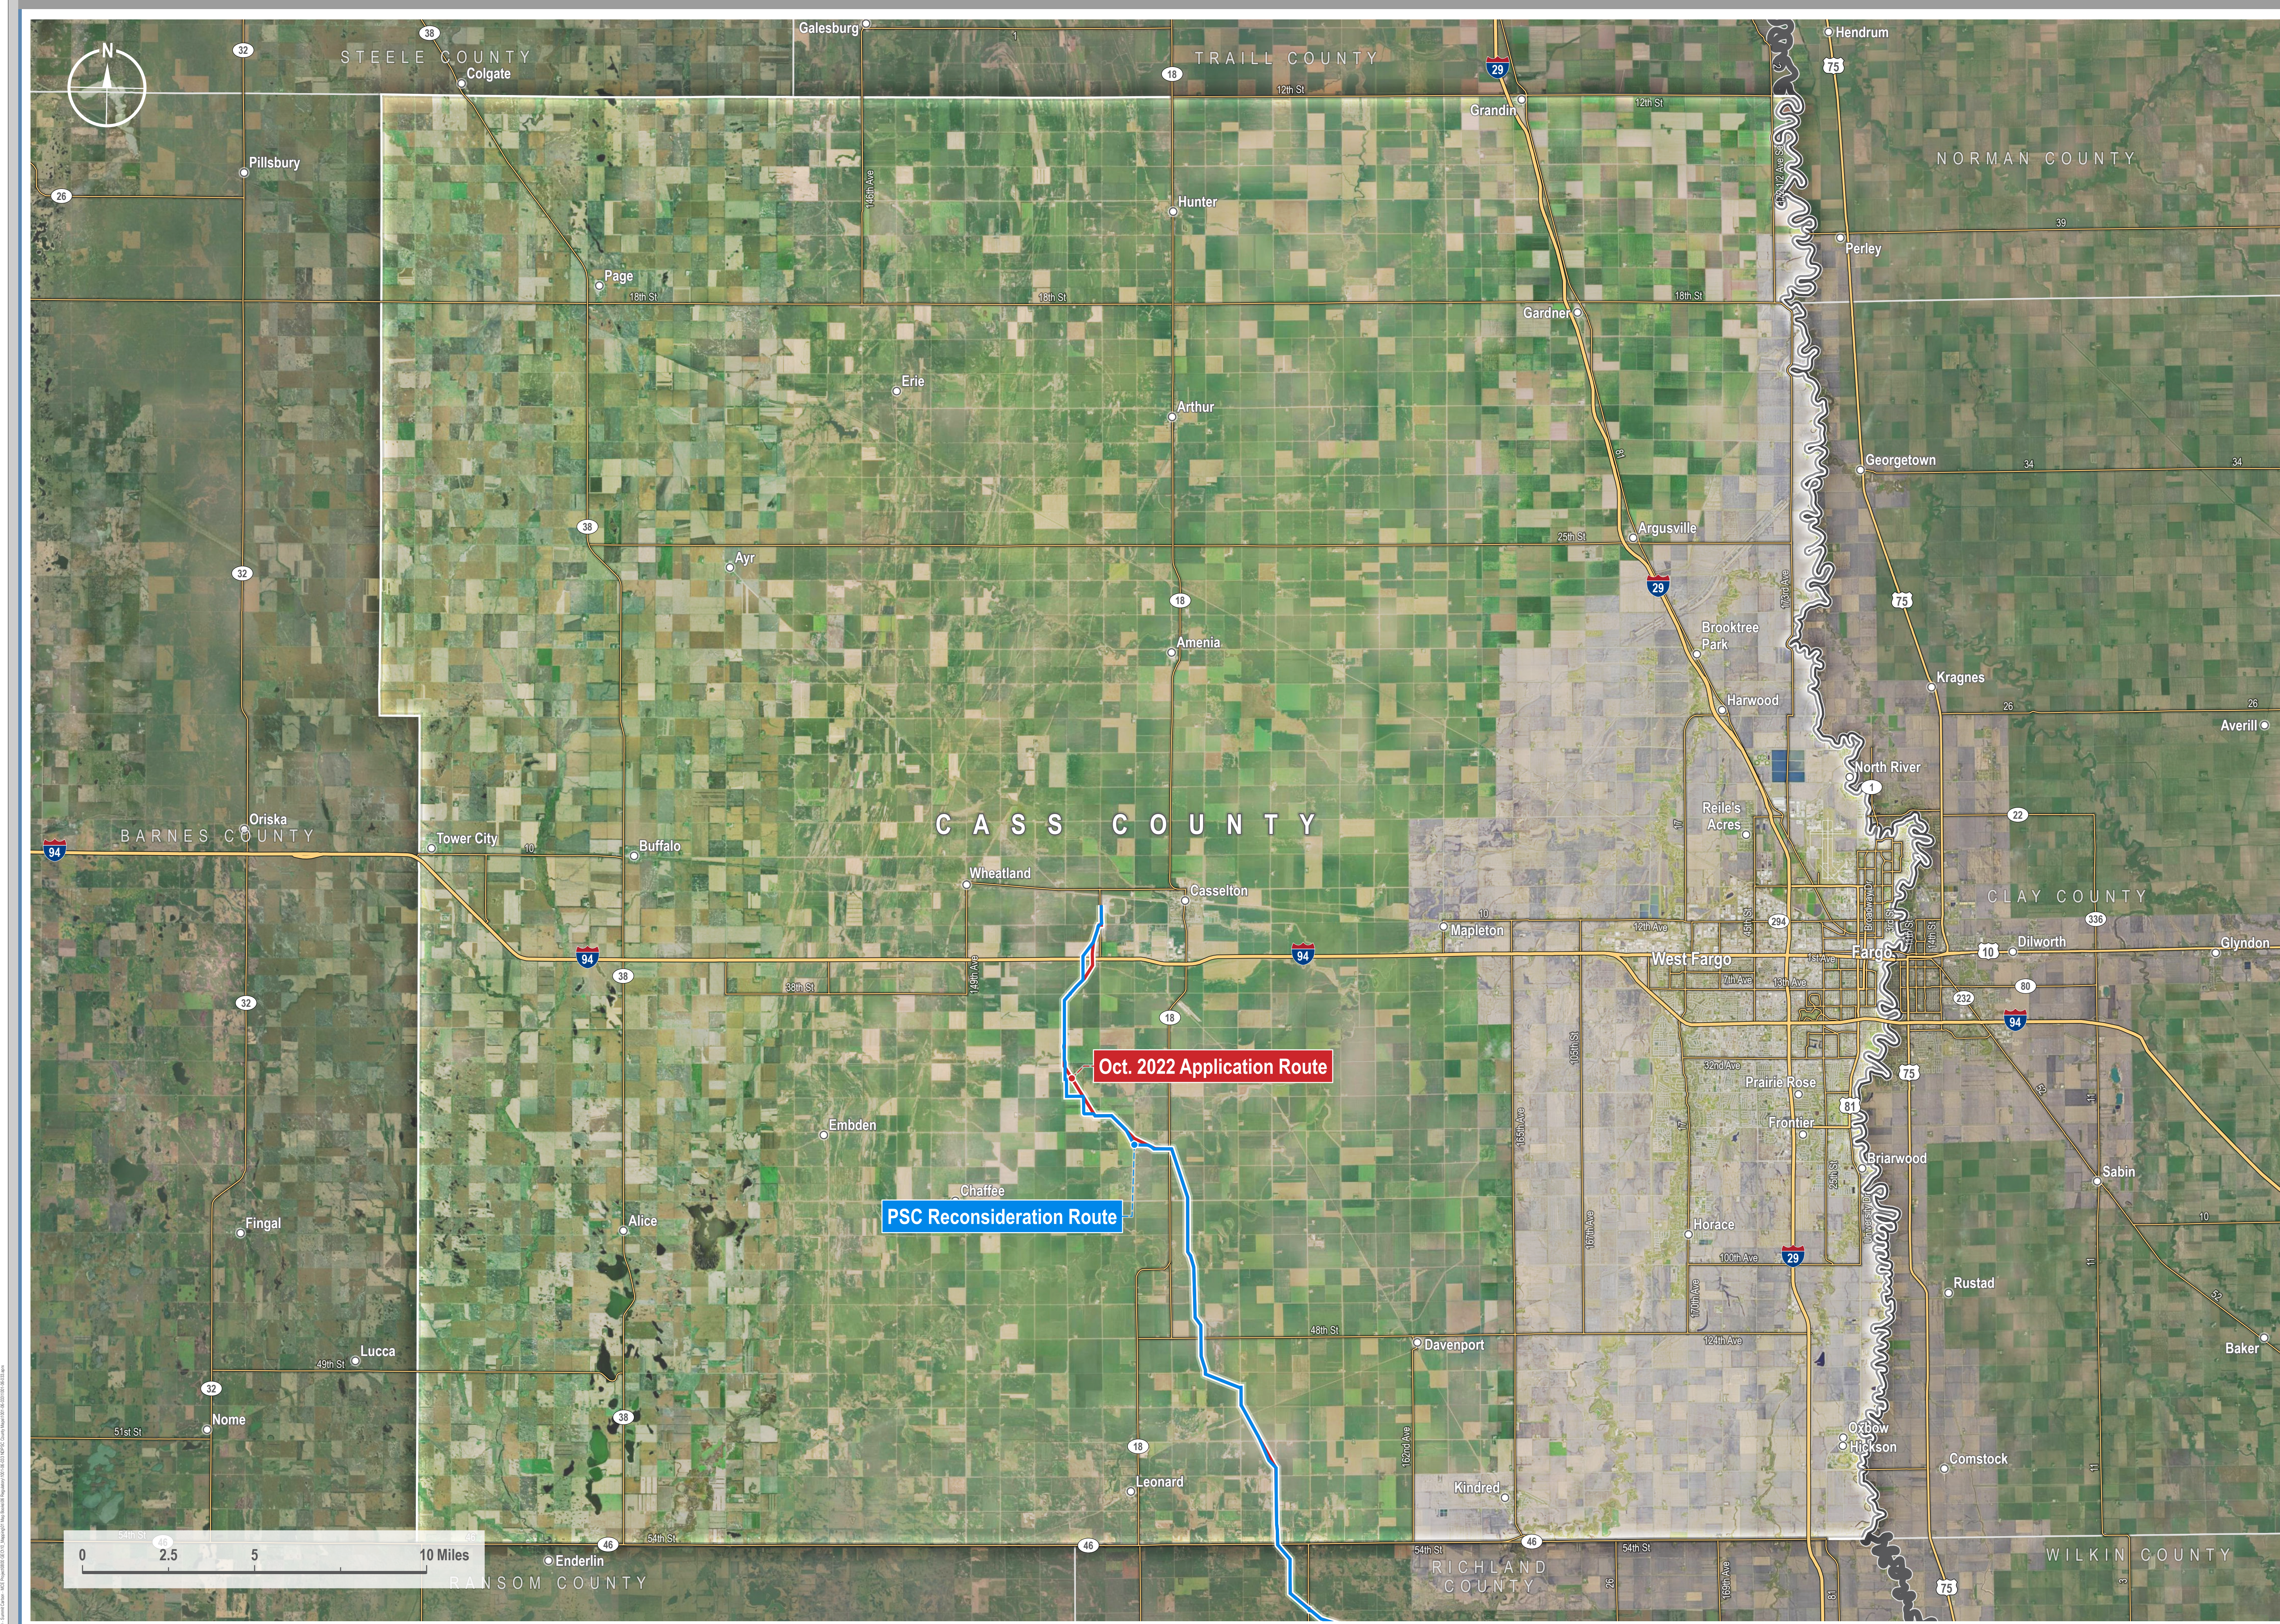

VICINITY MAP

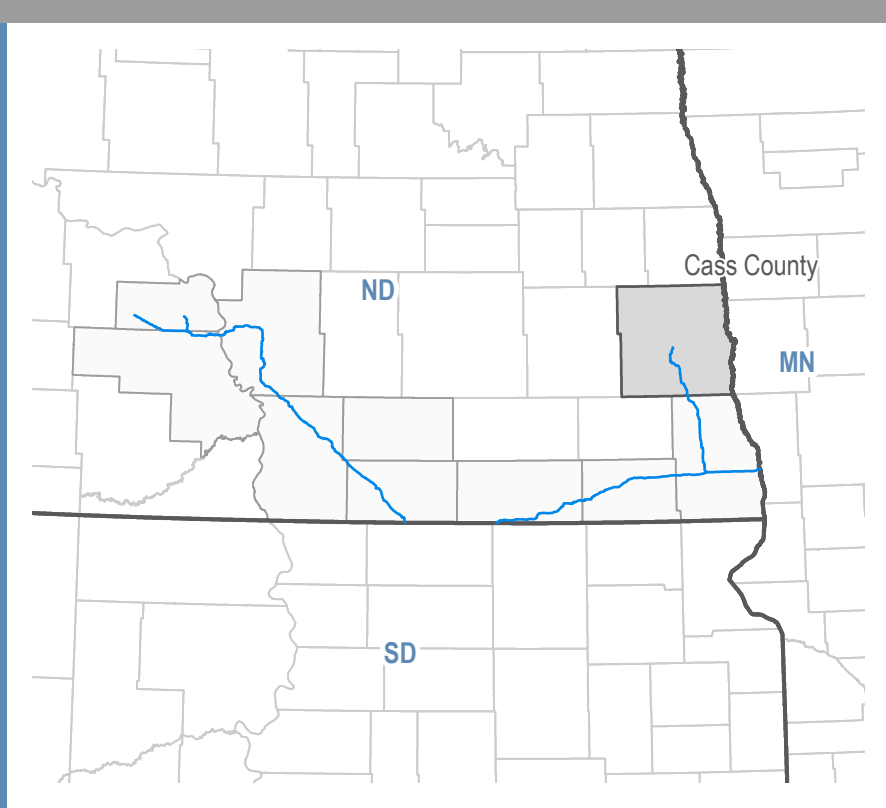

LEGEND

- PSC Reconsideration Route
— October 2022 Application Route

REVISIONS

Date: 2024-04-16 Revised by: PD Checked by: JZ

Issued drawing for use in NDPSC meetings.

Date: Revised by: Checked by:

Date: Revised by: Checked by:

PREPARED BY



CASS COUNTY


(Cass County)

Scale:
1 : 140,000
1 inch equals 2.21 miles


Projection:
Transverse Mercator
NAD 1983 UTM Zone 14N

Sheet:
10
10 of 10

Drawing Number:
1001-06-033
Revision 0

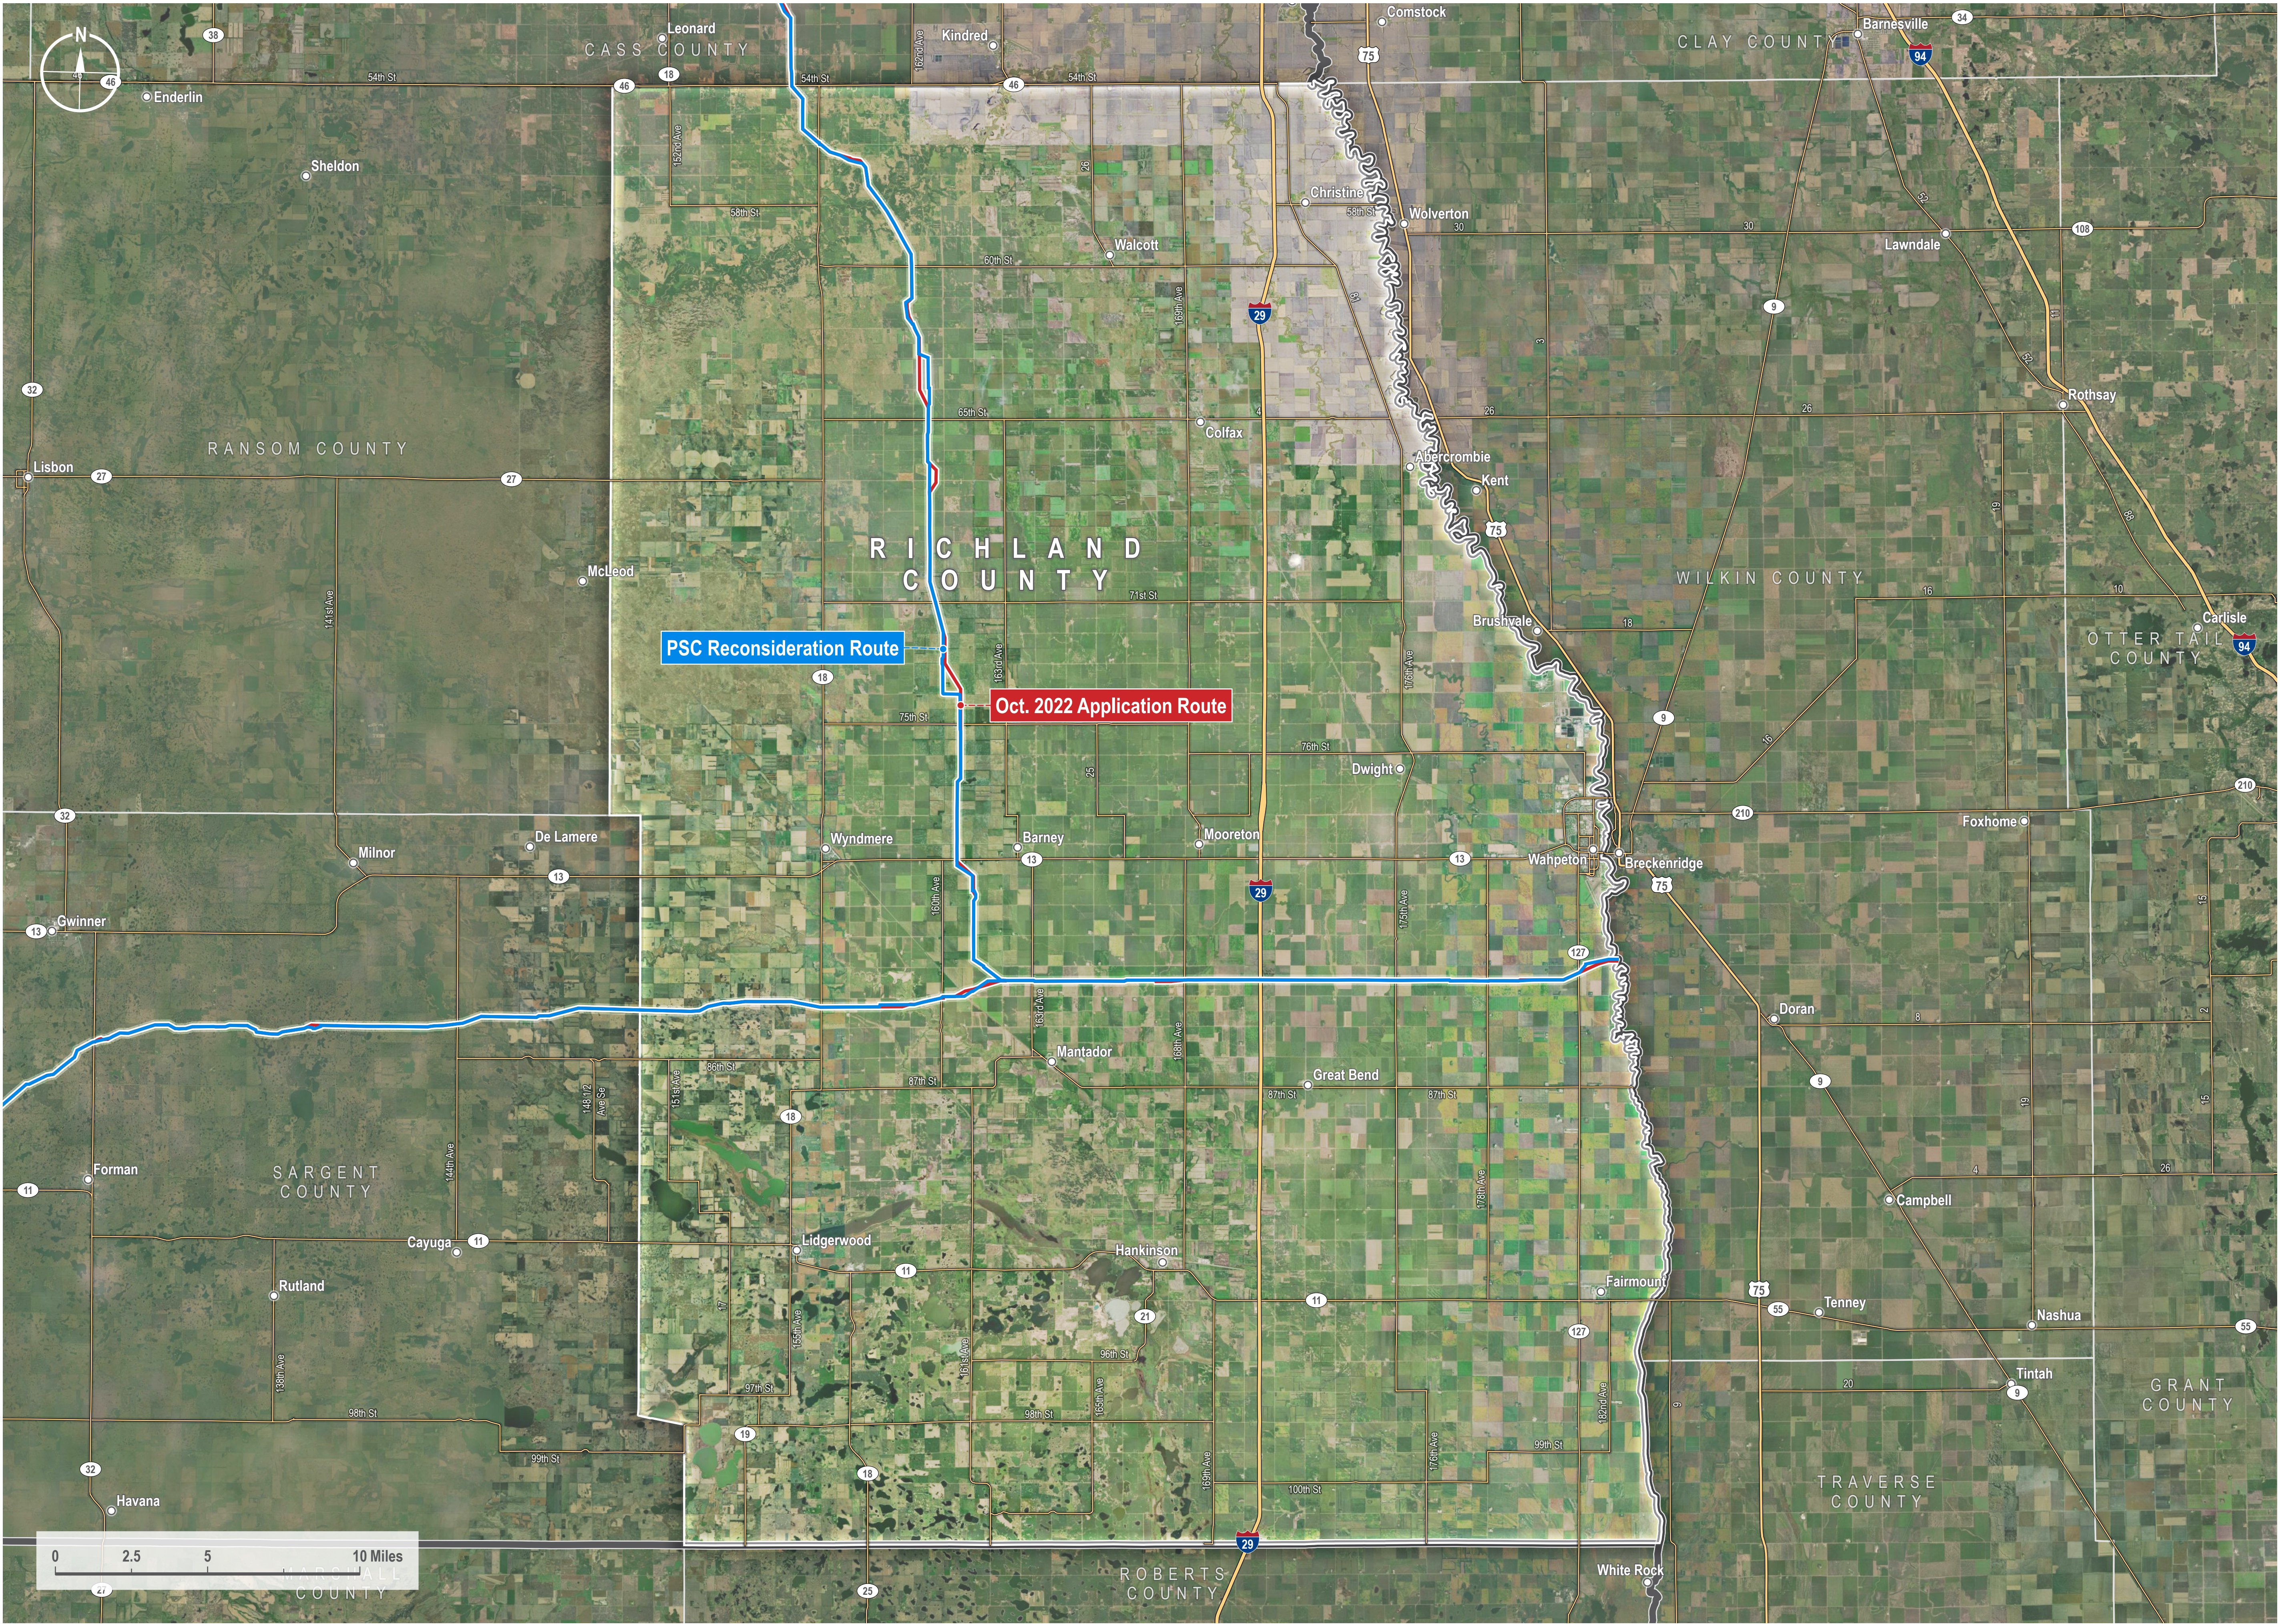

VICINITY MAP

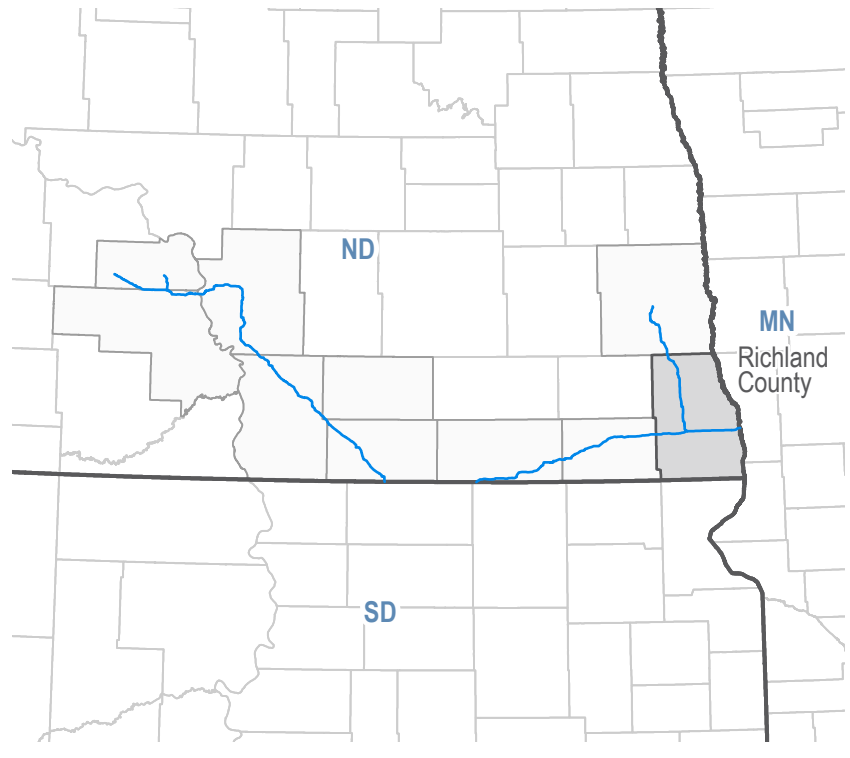

LEGEND

- PSC Reconsideration Route
- October 2022 Application Route

REVISIONS

Date: 2024-04-16 Revised by: PD Checked by: JZ

0 - Issued for Use
Issued drawing for use in NDPSC meetings.

Date: Revised by: Checked by:

Date: Revised by: Checked by:

PREPARED BY

Summit Carbon Solutions
2321 North Loop Drive, Suite 221
Ames, Iowa 50010
United States of America
www.summitcarbonsolutions.com



RICHLAND COUNTY

Drawing Title:
**Summit Carbon Solutions Project
NDPSC Proposed Routes
(Richland County)**

Scale:
1 : 160,000
1 inch equals 2.53 miles

Projection:
Transverse Mercator
NAD 1983 UTM Zone 14N

Sheet:
9
9 of 10

Drawing Number:
1001-06-033
Revision 0



VICINITY MAP

LEGEND

— PSC Reconsideration Route

— October 2022 Application Route

REVISIONS

Date:	2024-04-16	Revised by:	PD	Checked by:	JZ
0 - Issued for Use					
Issued drawing for use in NDPSC meetings.					
Date:		Revised by:		Checked by:	
Date:		Revised by:		Checked by:	

PREPARED BY

Summit Carbon Solutions

2321 North Loop Drive, Suite 221
Ames, Iowa 50010
United States of America

www.summitcarbonsolutions.com




EMMONS COUNTY

Drawing Title:


**Summit Carbon Solutions Project
NDPSC Proposed Routes
(Emmons County)**

Scale: 1 : 159,000 1 inch equals 2.51 miles	Projection: Transverse Mercator NAD 1983 UTM Zone 14N
Sheet: 4 4 of 10	Drawing Number: 1001-06-033 Revision 0

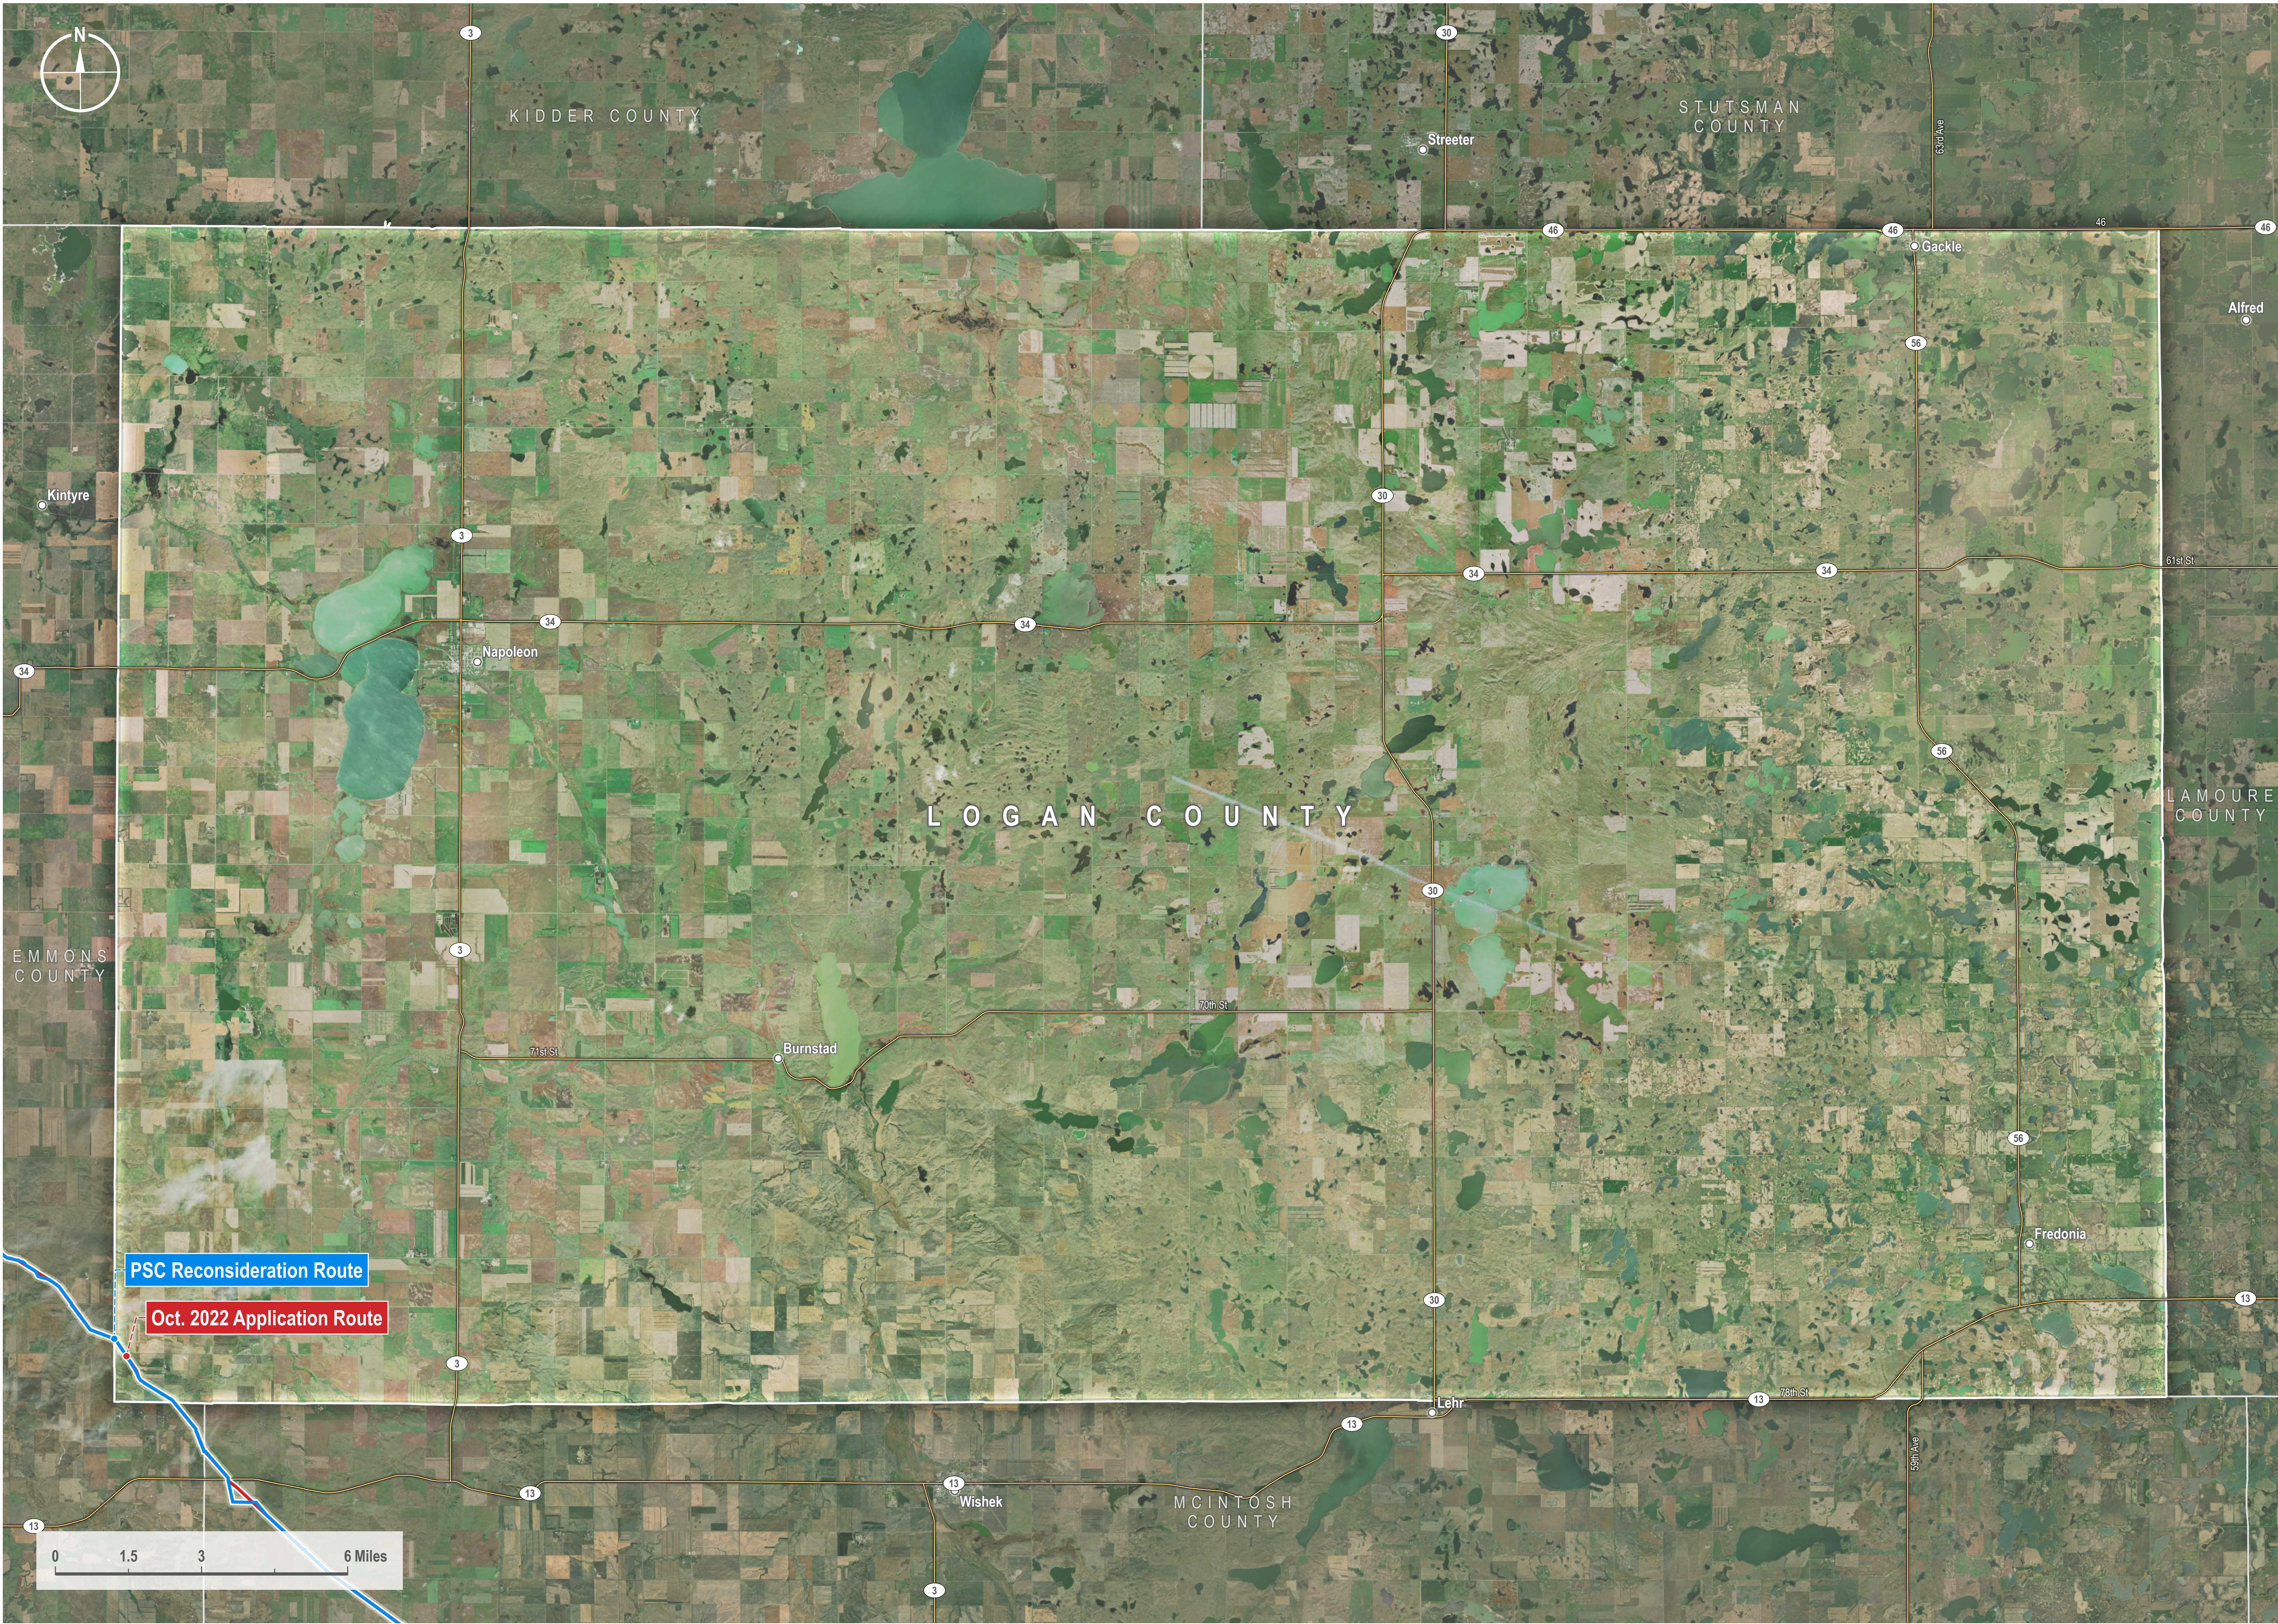

Disclaimer:

VICINITY MAP

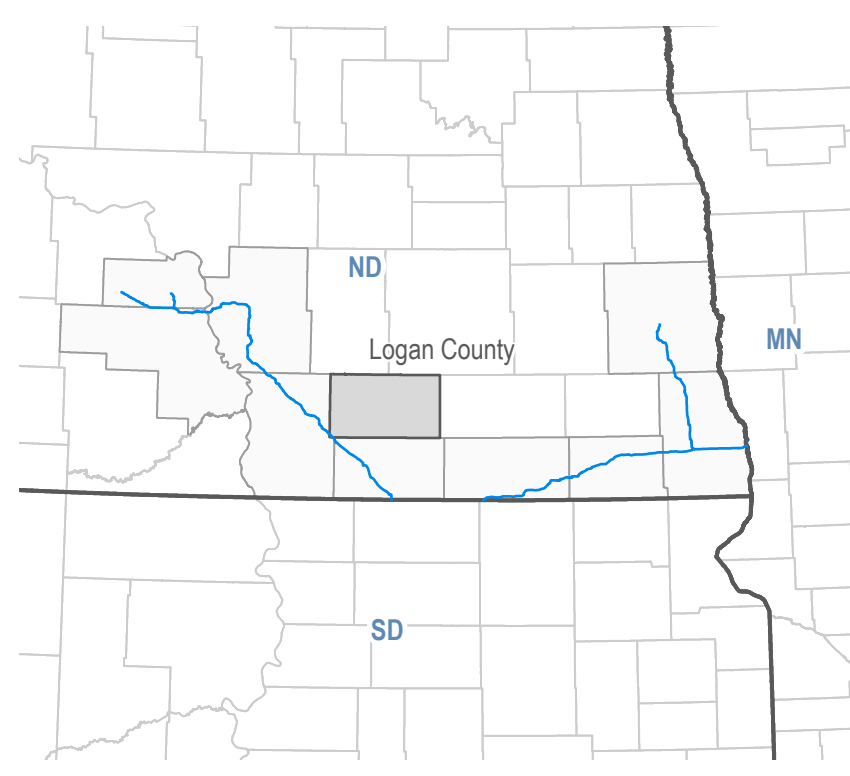

LEGEND

- PSC Reconsideration Route
- October 2022 Application Route

REVISIONS

Date: 2024-04-16 Revised by: PD Checked by: JZ

0 - Issued for Use
Issued drawing for use in NDPSC meetings.

Date: Revised by: Checked by:

Date: Revised by: Checked by:

PREPARED BY

Summit Carbon Solutions

2321 North Loop Drive, Suite 221
Ames, Iowa 50010
United States of America

www.summitcarbonsolutions.com



LOGAN COUNTY

Drawing Title:

Summit Carbon Solutions Project
NDPSC Proposed Routes


(Logan County)

Scale:
1 : 100,000
1 inch equals 1.58 miles

Sheet:
5
5 of 10

Projection:
Transverse Mercator
NAD 1983 UTM Zone 14N

Drawing Number:
1001-06-033
Revision 0

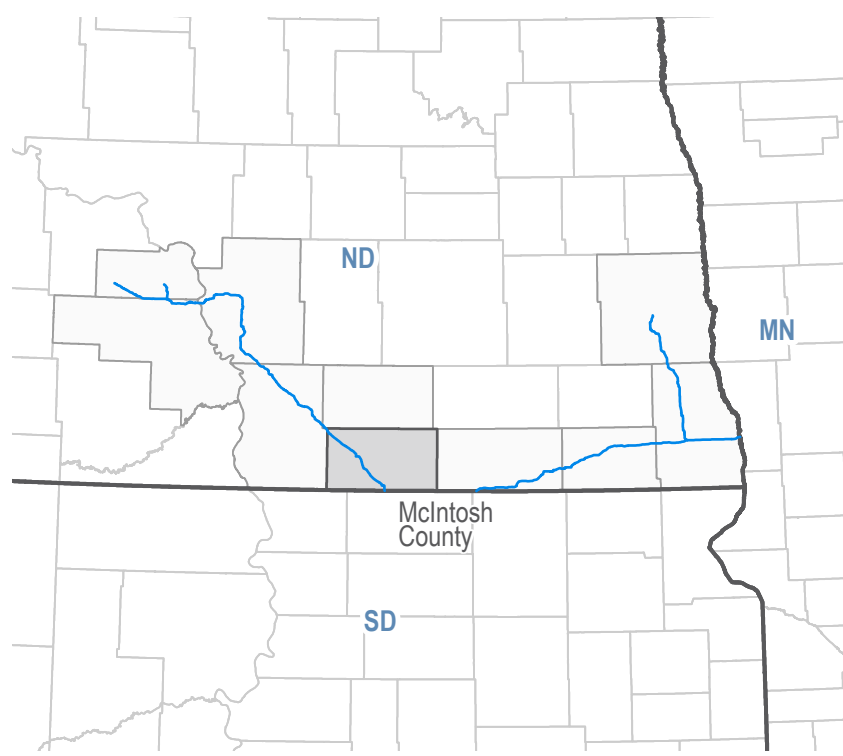

— PSC Reconsideration Route
— October 2022 Application Route

Date: 2024-04-16 Revised by: PD Checked by: JZ

0 - Issued for Use

Issued drawing for use in NDPSC meetings.

Date: Revised by: Checked by:

Date: Revised by: Checked by:

Summit Carbon Solutions

2321 North Loop Drive, Suite 221
Ames, Iowa 50010
United States of America



www.summitcarbonsolutions.com

Drawing Title:

Summit Carbon Solutions Project NDPSC Proposed Routes

(McIntosh County)

Scale:
1 : 100,000
1 inch equals 1.58 miles

Projection: **Transverse Mercator**
NAD 1983 UTM Zone 14N

Sheet:

6
6 of 10

Drawing Number:

1001-06-033
Revision 0