




LO ROUTE  
MODIFICATION 3  
NORTH DAKOTA

Date: 08/16/2023

- Mileposts
- Proposed Route Modification
- ND PSC Permit Route
- Landowner Intervenor
- Online Properties
- PLSS Boundaries

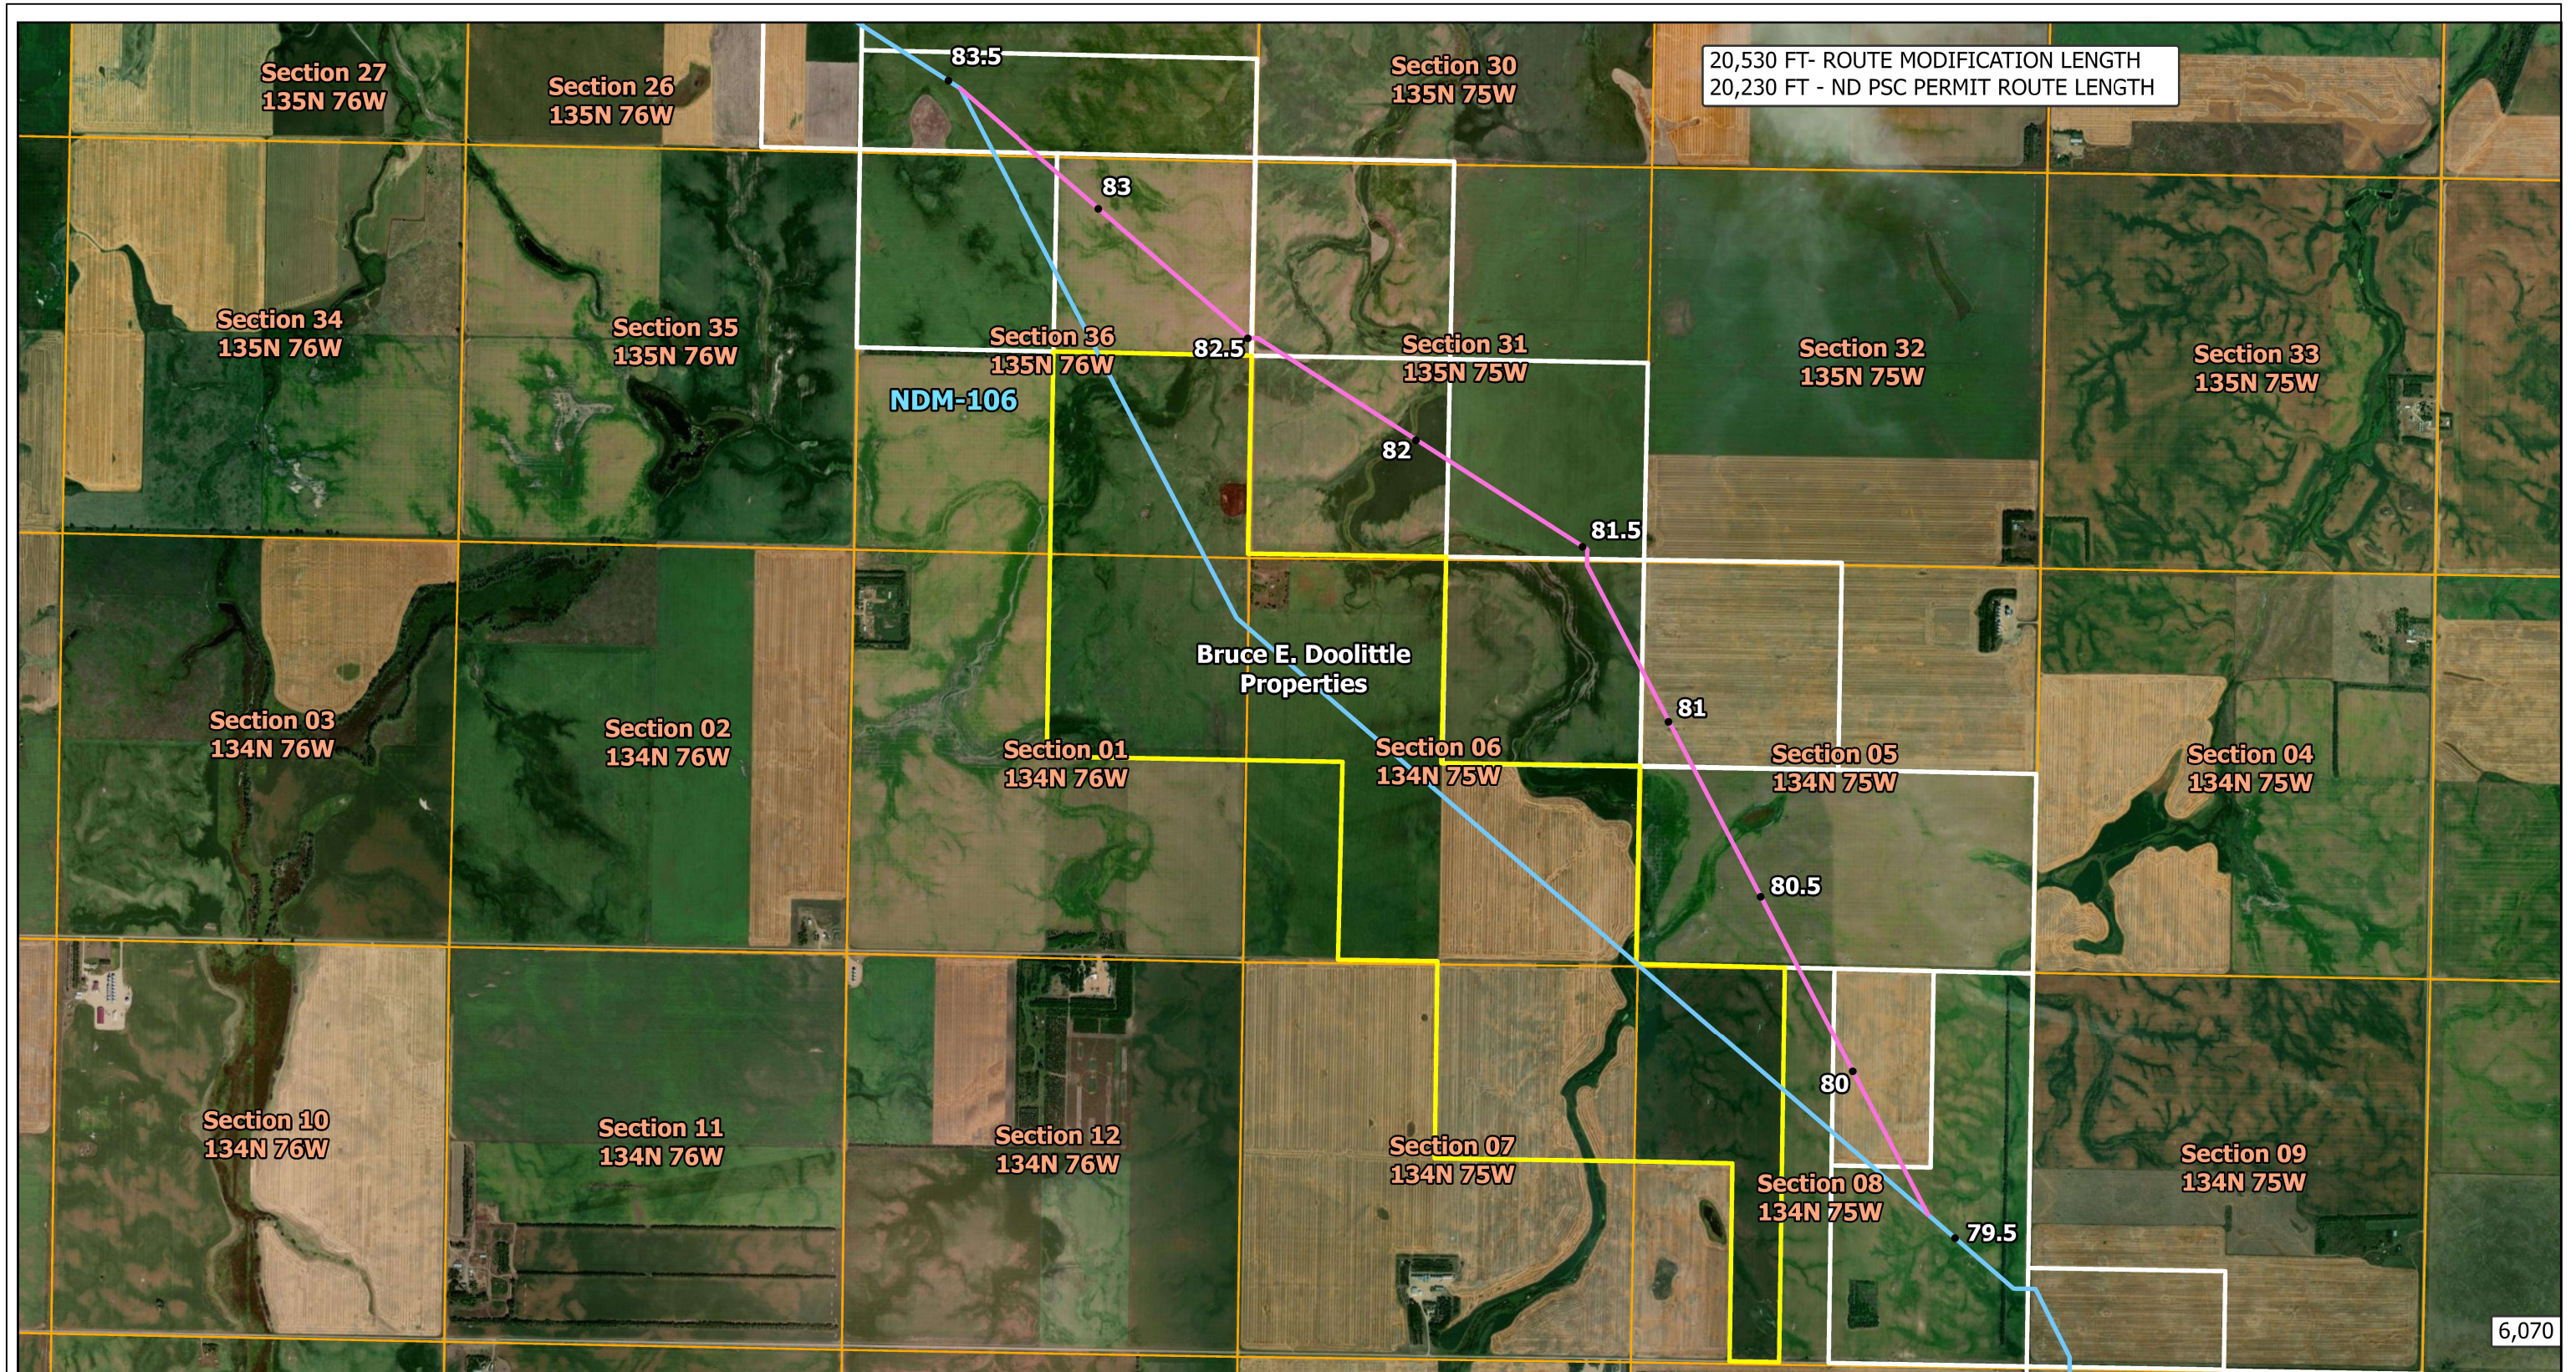

SUMMIT  
CARBON  
SOLUTIONS


N



0 0.35 0.7 1.4 Miles

LO #21 – 5/24/24  
PU-22-391



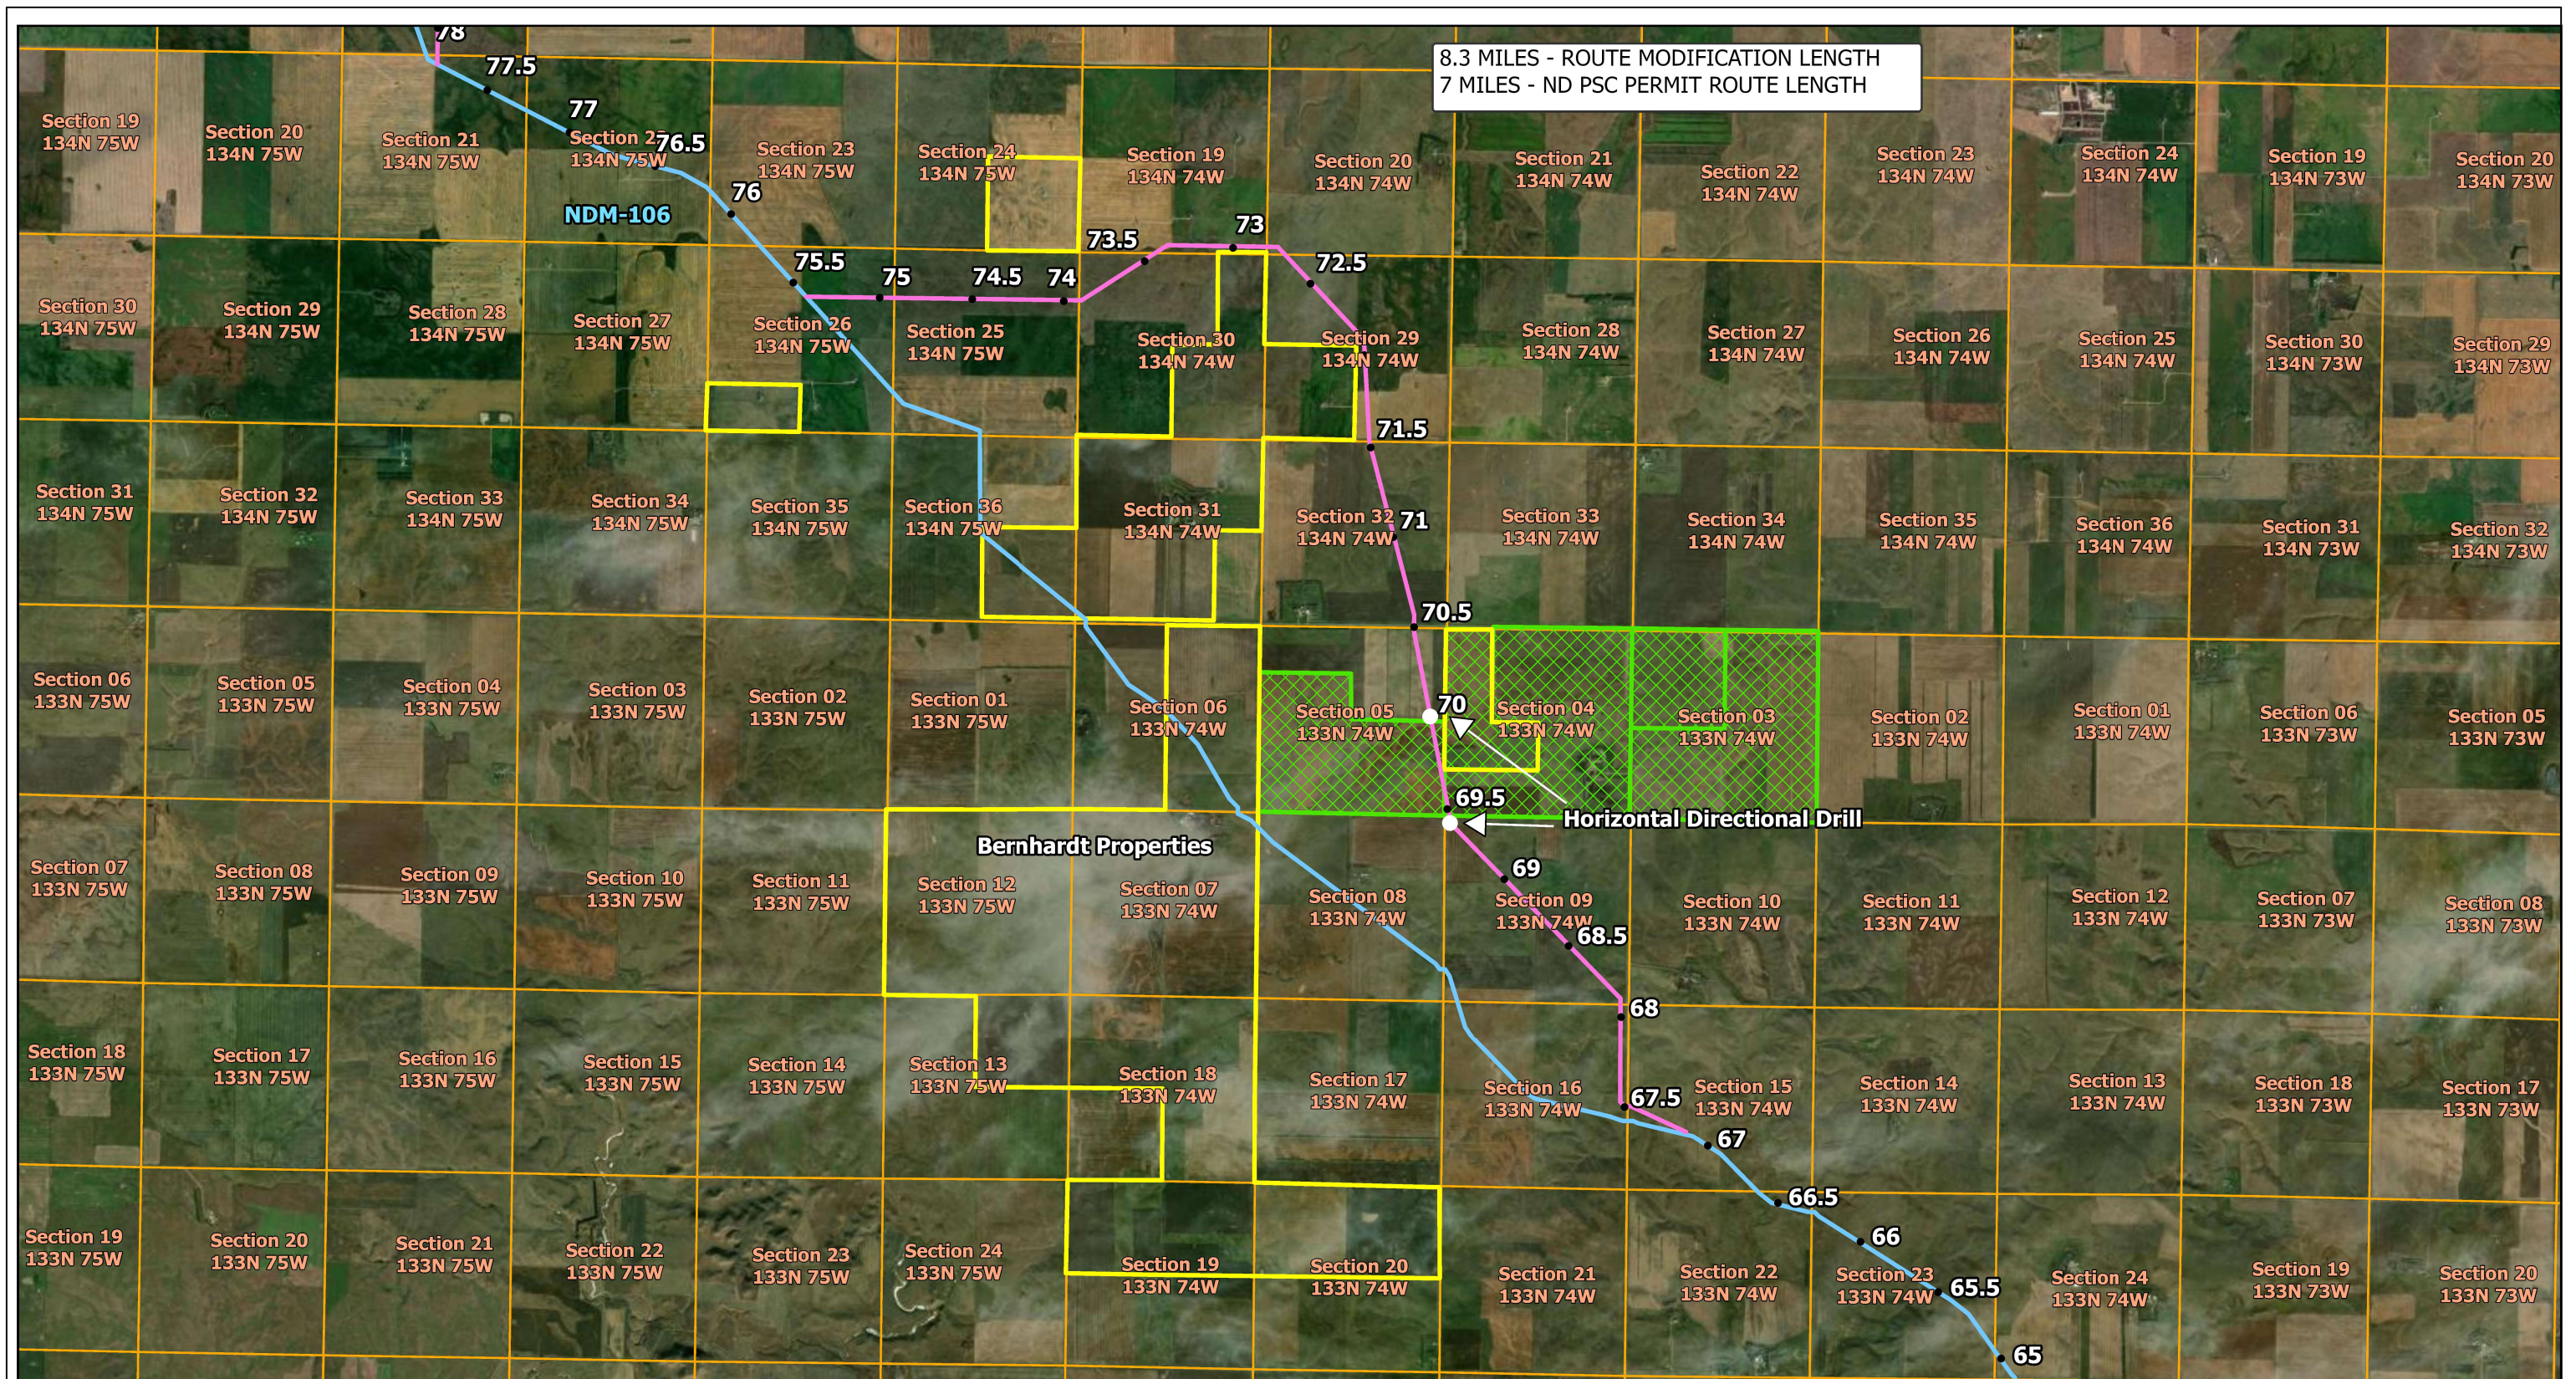

# LO ROUTE MODIFICATION 5 NORTH DAKOTA

Date: 08/16/2023

- Mileposts
- HDD Entry/Exit
- Proposed Route Modification
- ND PSC Permit Route

- Landowner Intervenor
- Emmons County Waterfowl Production Area
- PLSS Boundaries



SUMMIT  
CARBON  
SOLUTIONS

N



0 0.75 1.5 3 Miles