

April 23, 2024

Lawrence Bender
Frederikson & Byron, P.A.
1133 College Drive, Ste. 1000
Bismarck, Nd 58501-1215

RE: C02 Pipeline – APH Farms
SCS Proposed Route Descript.: Township 140 North, Range 83 West
Sections 10 and 11
Morton County, North Dakota


Mr. Bender:

I have been trying to have a dialogue with you and your client for many months now and your client, Summit, has failed to engage in any meaningful way. Additionally, we have not heard from you – ever – as to working on re-routes around our client's land nor have you addressed their opposition to your proposed hazardous pipeline. Given you have had over a year to do this and you have not contacted us at all in this regard, we are at a loss how to proceed other than vigorously opposing your client's applications.

In any event, enclosed with this letter you will find our client's ongoing attempts to reach a palpable resolution to this controversy. The enclosed maps reroute the pipeline to avoid APH Farms ("APH") farmland and reroutes the pipeline to avoid the farmland adjacent to APH, which is rented by APH. However, if we continue to not hear from you and your client continues to refuse to engage on this matter, we will have to proceed to request denial of your client's Application for Certificate of Corridor Compatibility and its Application for Route Permit.


We are providing this information to you in the hope that Summit will start to show at least a minimum good-faith effort to engage with us to address the adverse effects upon landowners who do not want any part of this proposed hazardous pipeline. We respectfully request we hear from you soon.

Respectfully,

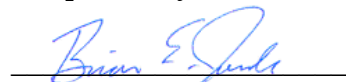

Brian E. Jorde
bjorde@dominalaw.com

Enclosures

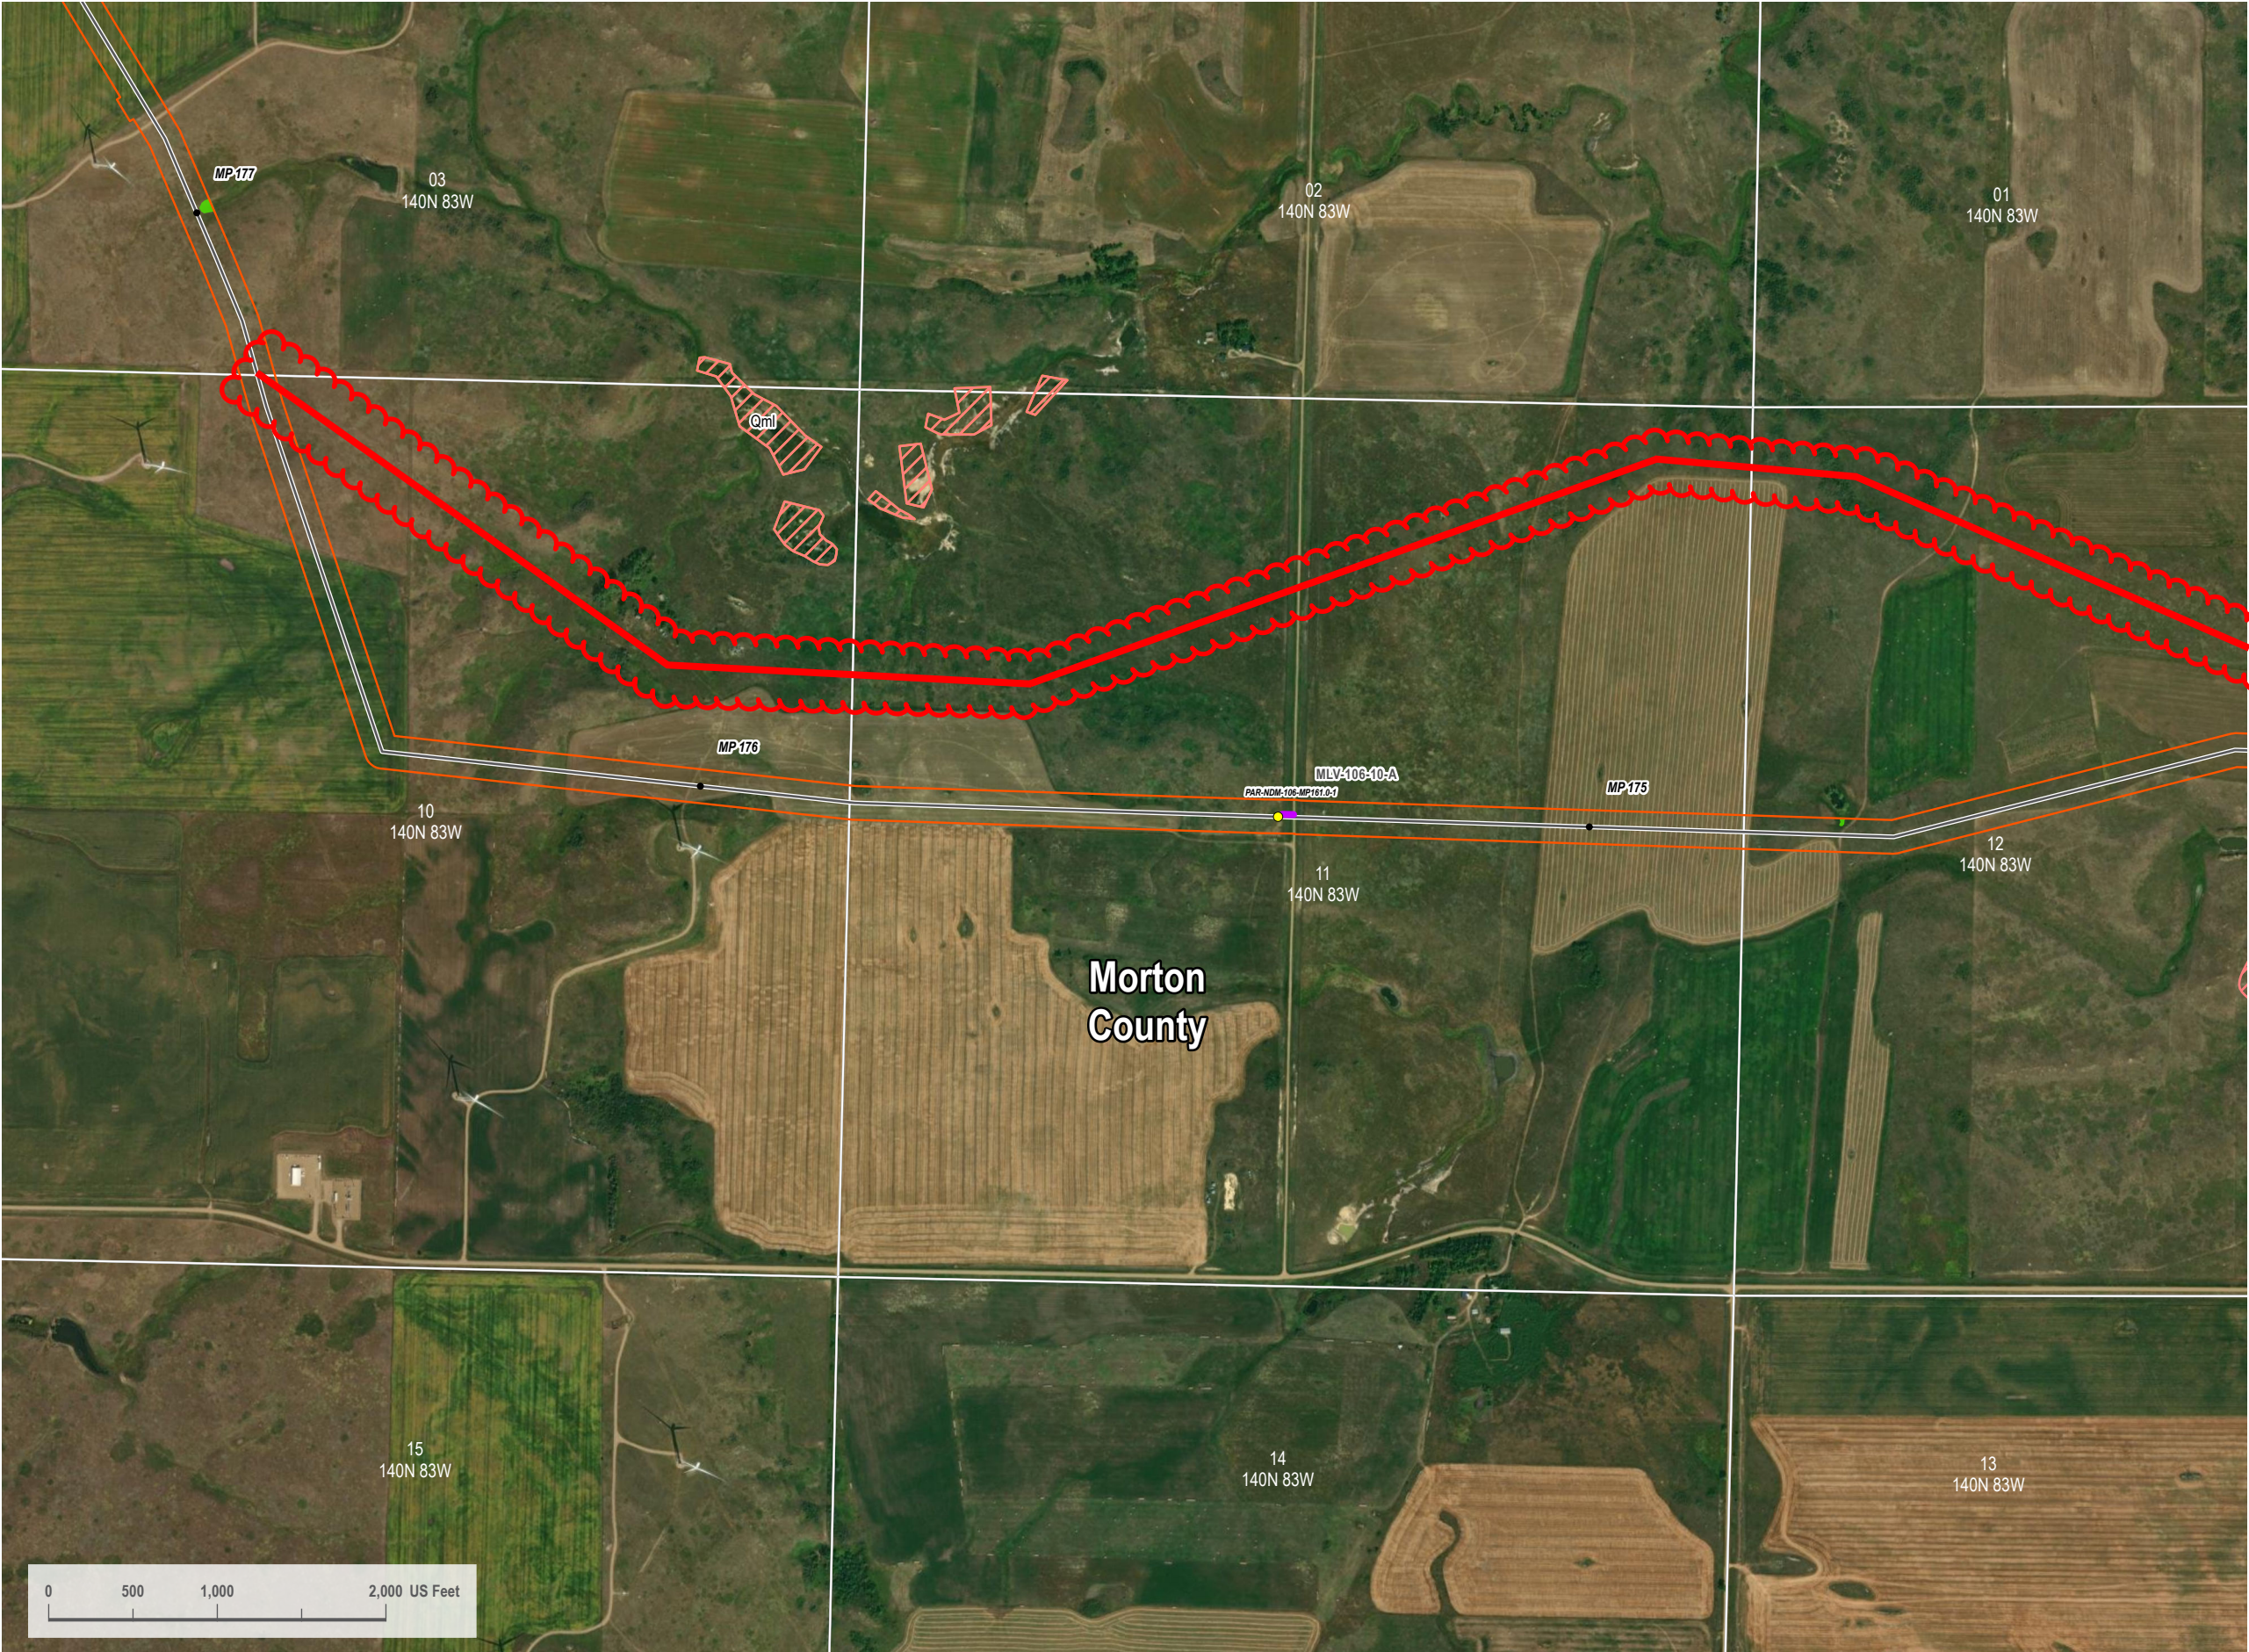


VICINITY MAP



LEGEND

- Centerline Mileposts
- Mainline Valve Location
- Proposed Route
- Section Line
- Access Road
- Landslide Deposit (Avoidance)
- Pump Station
- Avoidance Area
- Open Water
- PEM Wetland
- 200-foot Siting Corridor

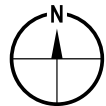

REVISIONS

Date:	2024-01-28	Revised by:	CW	Checked by:	RC
A - Issued for Review					
Date:		Revised by:		Checked by:	
Date:		Revised by:		Checked by:	

PREPARED BY


Summit Carbon Solutions
2321 North Loop Drive, Suite 221
Ames, Iowa 50010
United States of America
www.summitcarbonsolutions.com



SUMMIT CARBON
SOLUTIONS

PROJECT INFORMATION

Figure Title: ND PSC - Aerial Map Book - NDM-106	
Figure Number: Map Book 1	
Scale: 1 : 12,000 1 inch equals 1,000 feet	Projection: Transverse Mercator NAD 1983 UTM Zone 14N
Sheet: 61 61 of 149	Drawing Number: 1001-01-004 Revision A

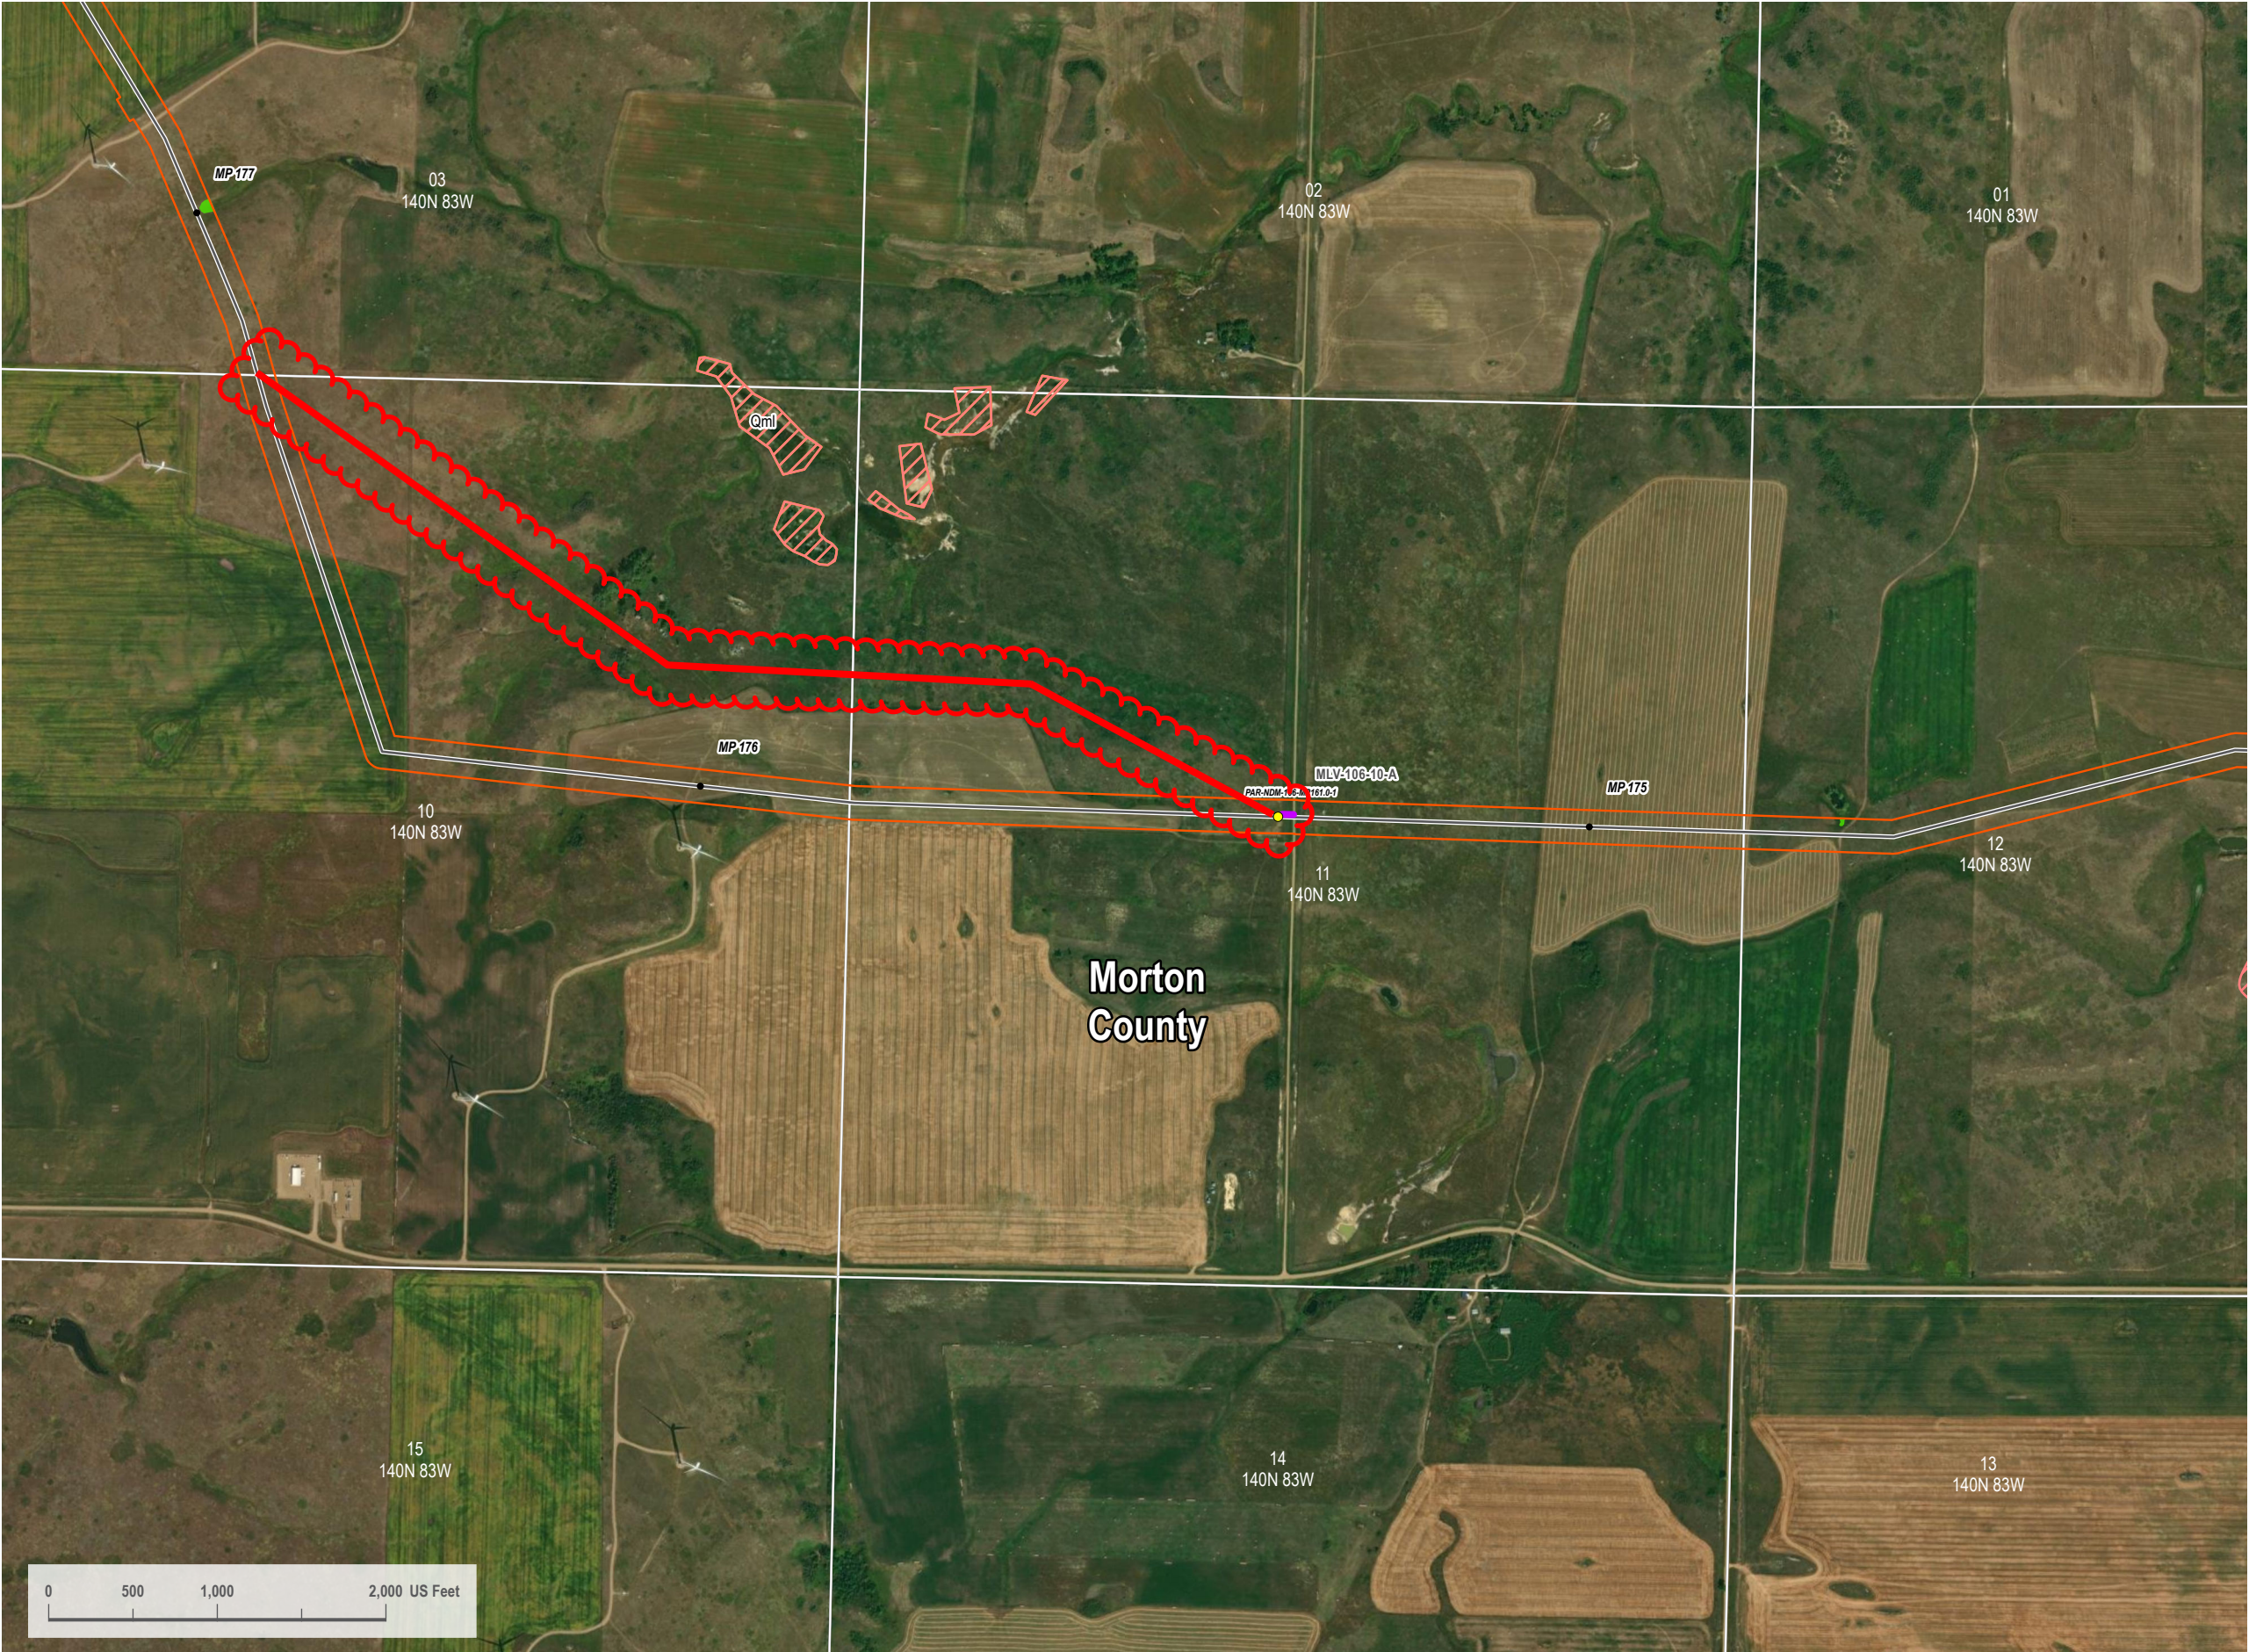

VICINITY MAP



LEGEND

- Centerline Mileposts
- Mainline Valve Location
- Proposed Route
- Section Line
- Access Road
- Landside Deposit (Avoidance)
- Pump Station
- Avoidance Area
- Open Water
- PEM Wetland
- 200-foot Siting Corridor



REVISIONS

Date: 2024-01-28 Revised by: CW Checked by: RC
A - Issued for Review

Date: Revised by: Checked by:

Date: Revised by: Checked by:

PREPARED BY

Summit Carbon Solutions
2321 North Loop Drive, Suite 221
Ames, Iowa 50010
United States of America
www.summitcarbonsolutions.com



PROJECT INFORMATION

Figure Title:
ND PSC - Aerial Map Book - NDM-106

Figure Number:
Map Book 1

Scale:
1 : 12,000
1 inch equals 1,000 feet

Projection:
Transverse Mercator
NAD 1983 UTM Zone 14N

Sheet:
61
61 of 149

Drawing Number:
1001-01-004
Revision A