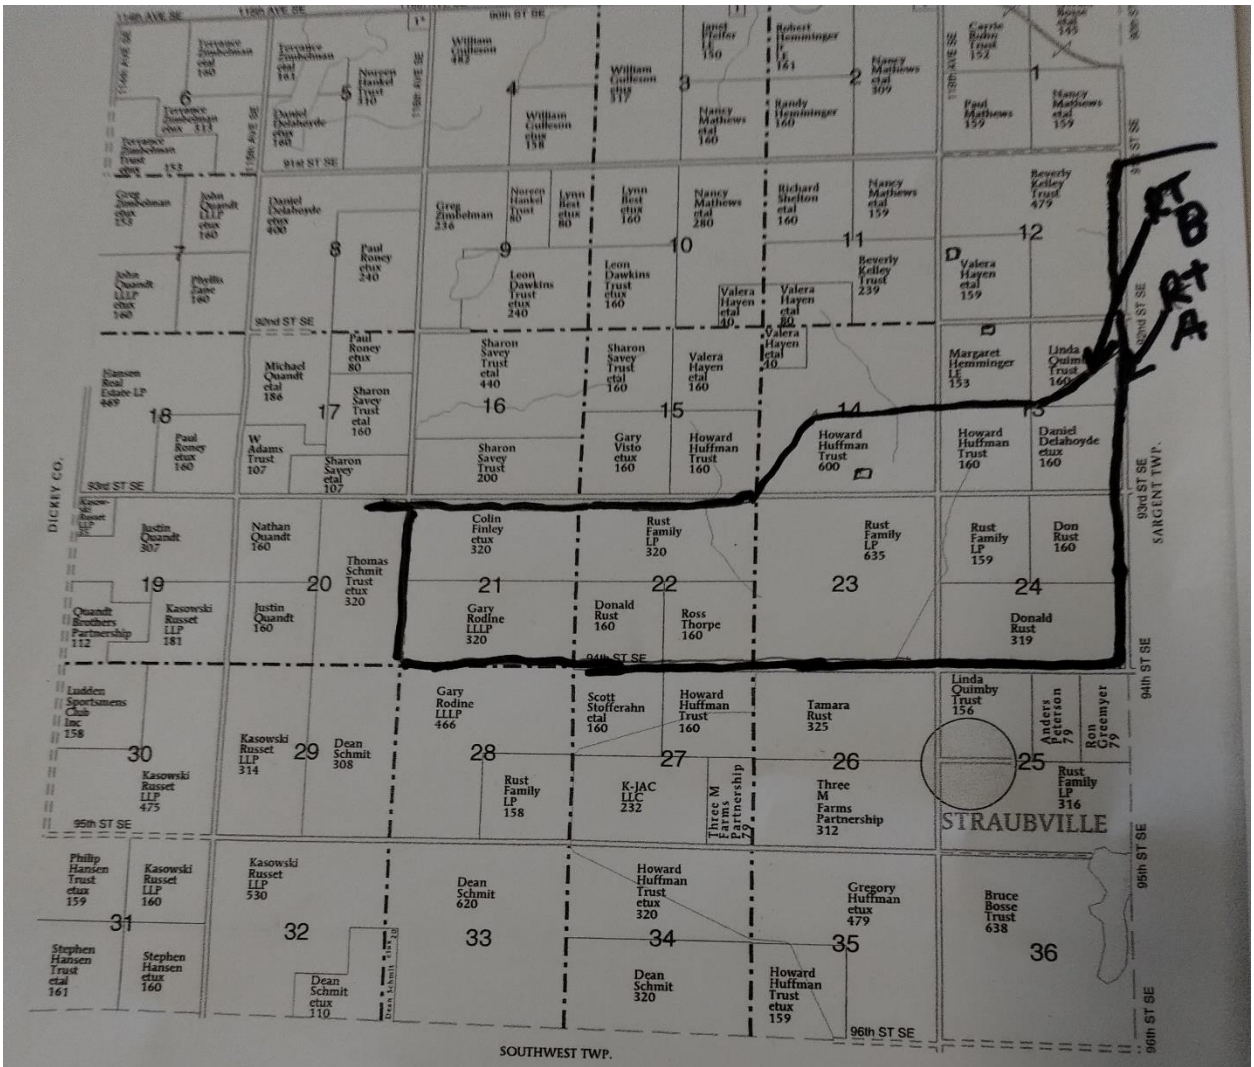


Talked to Township Supervisor – Route A or Route B keeps the line approximately ½ mile from any residence. Either one would work.

TOWNSHIP
ON 2
ETAL 10
ON 3
6
ON 5
ETUX 10

Publishers, LTD. | SARGENT CO., ND

30

LO #54
PU-22-391