


EXHIBIT C
(cont'd)

APH Farms

Section 10-T140N-R83W

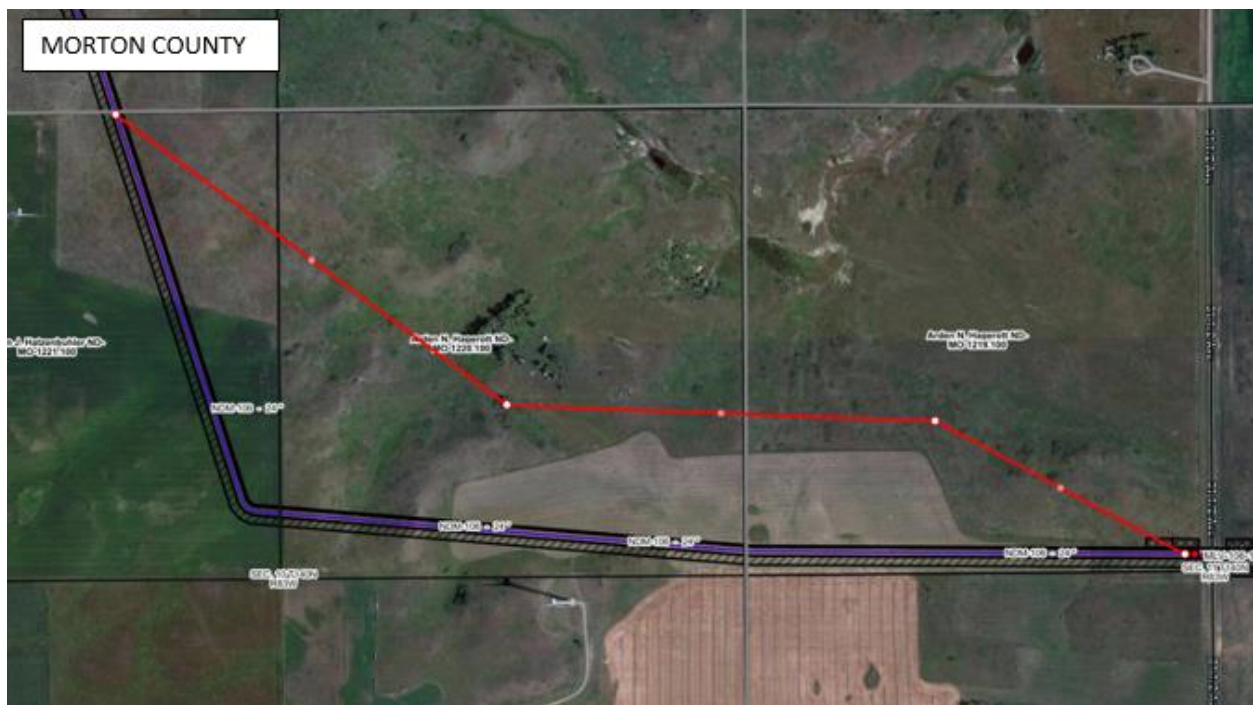

LO #56
PU-22-391