





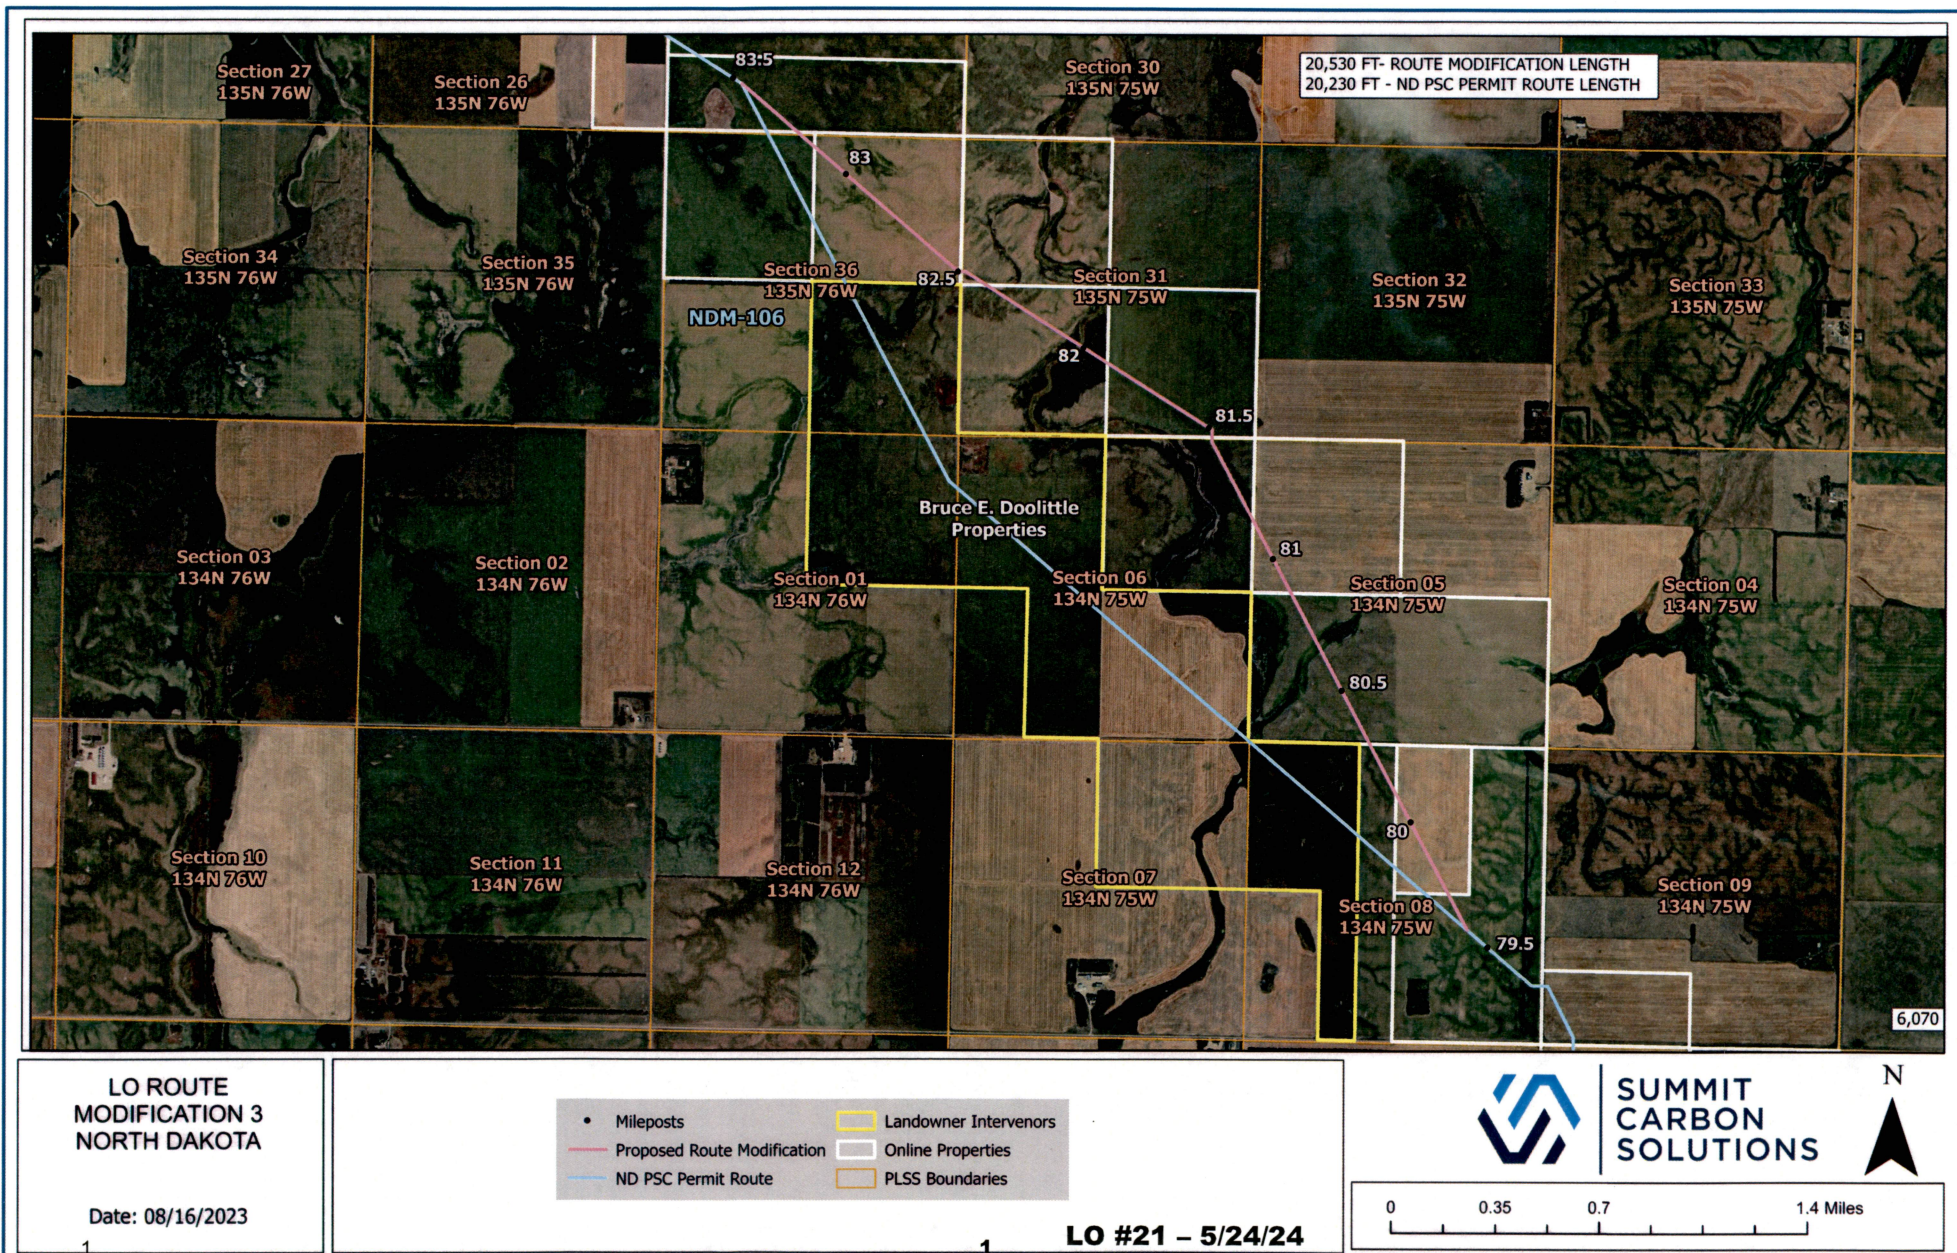

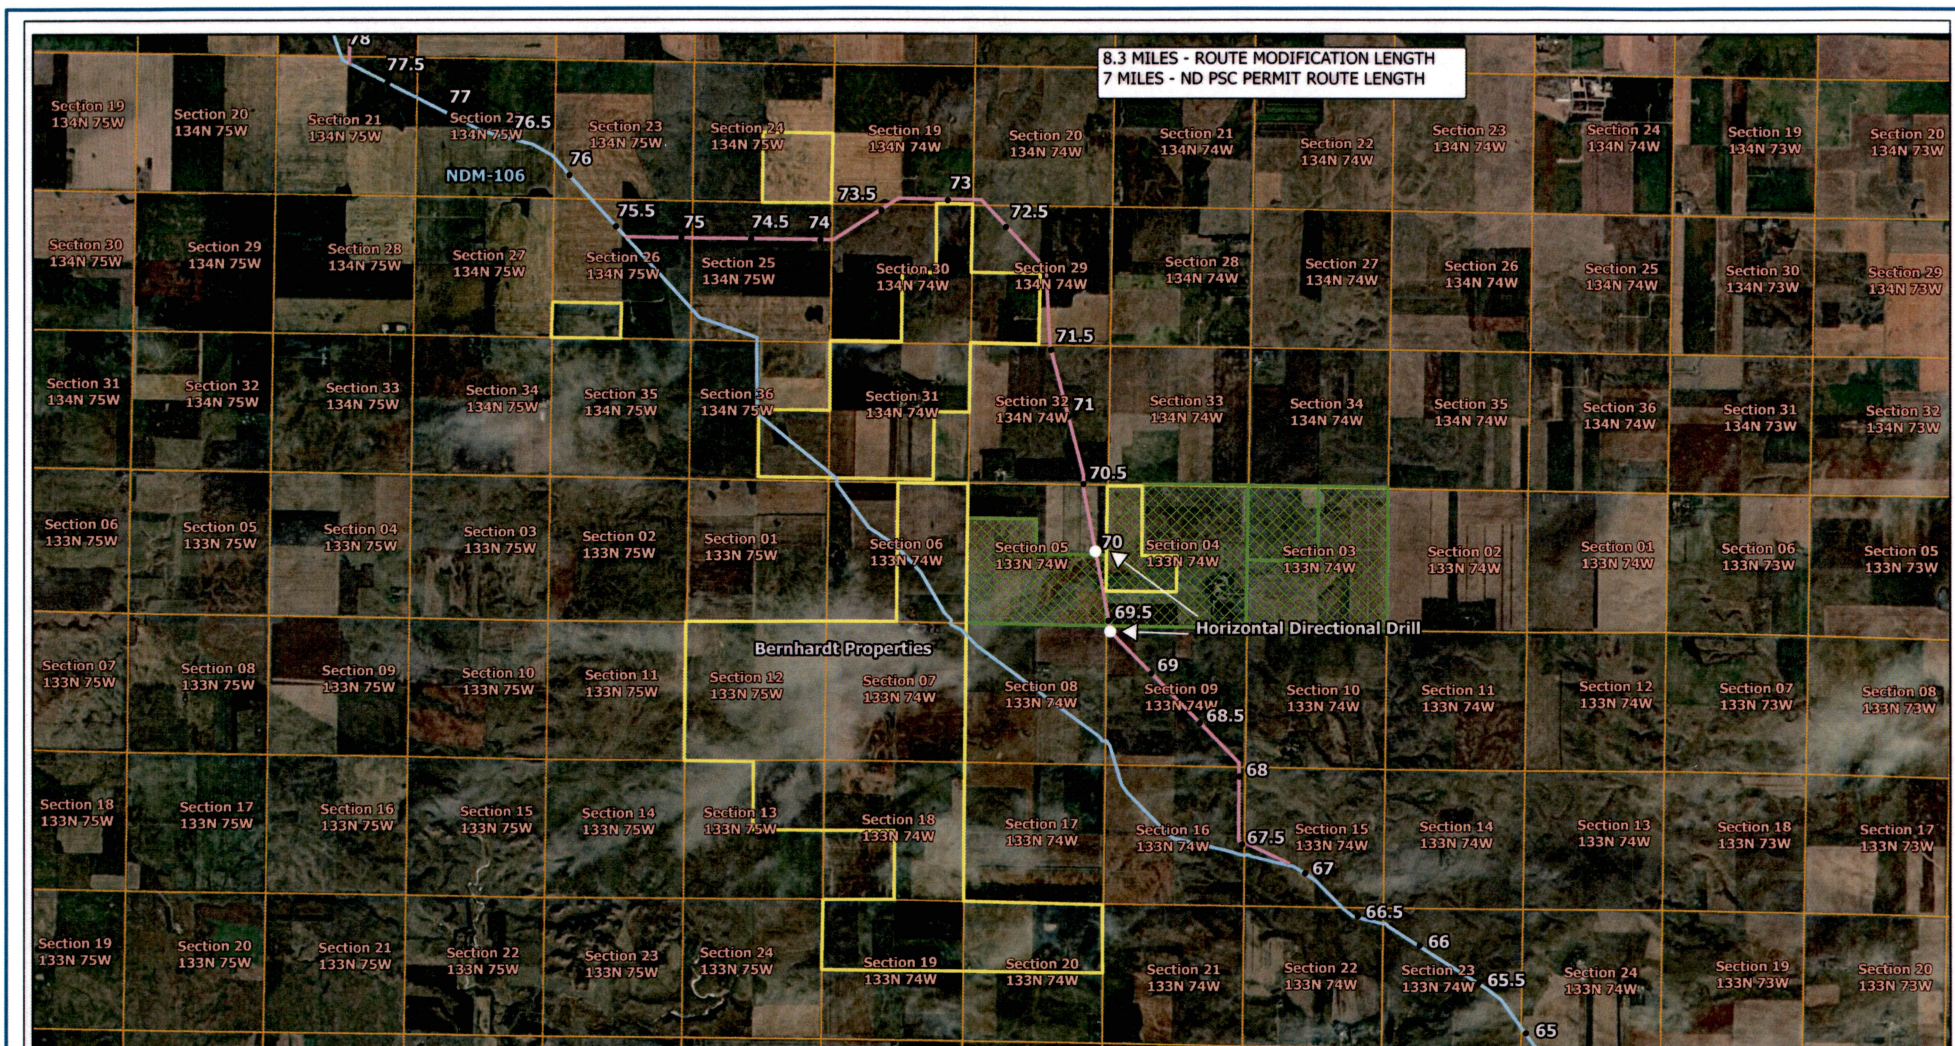

# LO ROUTE MODIFICATION 5 NORTH DAKOTA

Date: 08/16/2023

2

- Mileposts
- HDD Entry/Exit
- Proposed Route Modification
- ND PSC Permit Route
- Landowner Intervenor
- Emmons County Waterfowl Production Area
- PLSS Boundaries



SUMMIT  
CARBON  
SOLUTIONS

N



0 0.75 1.5 3 Miles

2