

April 23, 2024

Lawrence Bender  
Frederikson & Byron, P.A.  
1133 College Drive, Ste. 1000  
Bismarck, Nd 58501-1215

**RE: C02 Pipeline – APH Farms**  
**SCS Proposed Route Descript.: Township 140 North, Range 83 West**  
**Sections 10 and 11**  
**Morton County, North Dakota**


Mr. Bender:

I have been trying to have a dialogue with you and your client for many months now and your client, Summit, has failed to engage in any meaningful way. Additionally, we have not heard from you – ever – as to working on re-routes around our client's land nor have you addressed their opposition to your proposed hazardous pipeline. Given you have had over a year to do this and you have not contacted us at all in this regard, we are at a loss how to proceed other than vigorously opposing your client's applications.

In any event, enclosed with this letter you will find our client's ongoing attempts to reach a palpable resolution to this controversy. The enclosed maps reroute the pipeline to avoid APH Farms ("APH") farmland and reroutes the pipeline to avoid the farmland adjacent to APH, which is rented by APH. However, if we continue to not hear from you and your client continues to refuse to engage on this matter, we will have to proceed to request denial of your client's Application for Certificate of Corridor Compatibility and its Application for Route Permit.

We are providing this information to you in the hope that Summit will start to show at least a minimum good-faith effort to engage with us to address the adverse effects upon landowners who do not want any part of this proposed hazardous pipeline. We respectfully request we hear from you soon.


Respectfully,

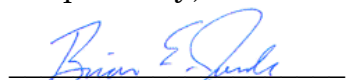

Brian E. Jorde  
[bjorde@dominalaw.com](mailto:bjorde@dominalaw.com)

Enclosures

707 PU-22-391 Filed 07/01/2024 Pages: 3  
LO Exhibit LO-37 - Jorde Letter (APH Farms)  
Dated 04/23/24 (Dkt. #589)  
Knoll Leibel, LLP, on behalf of the Intervenor

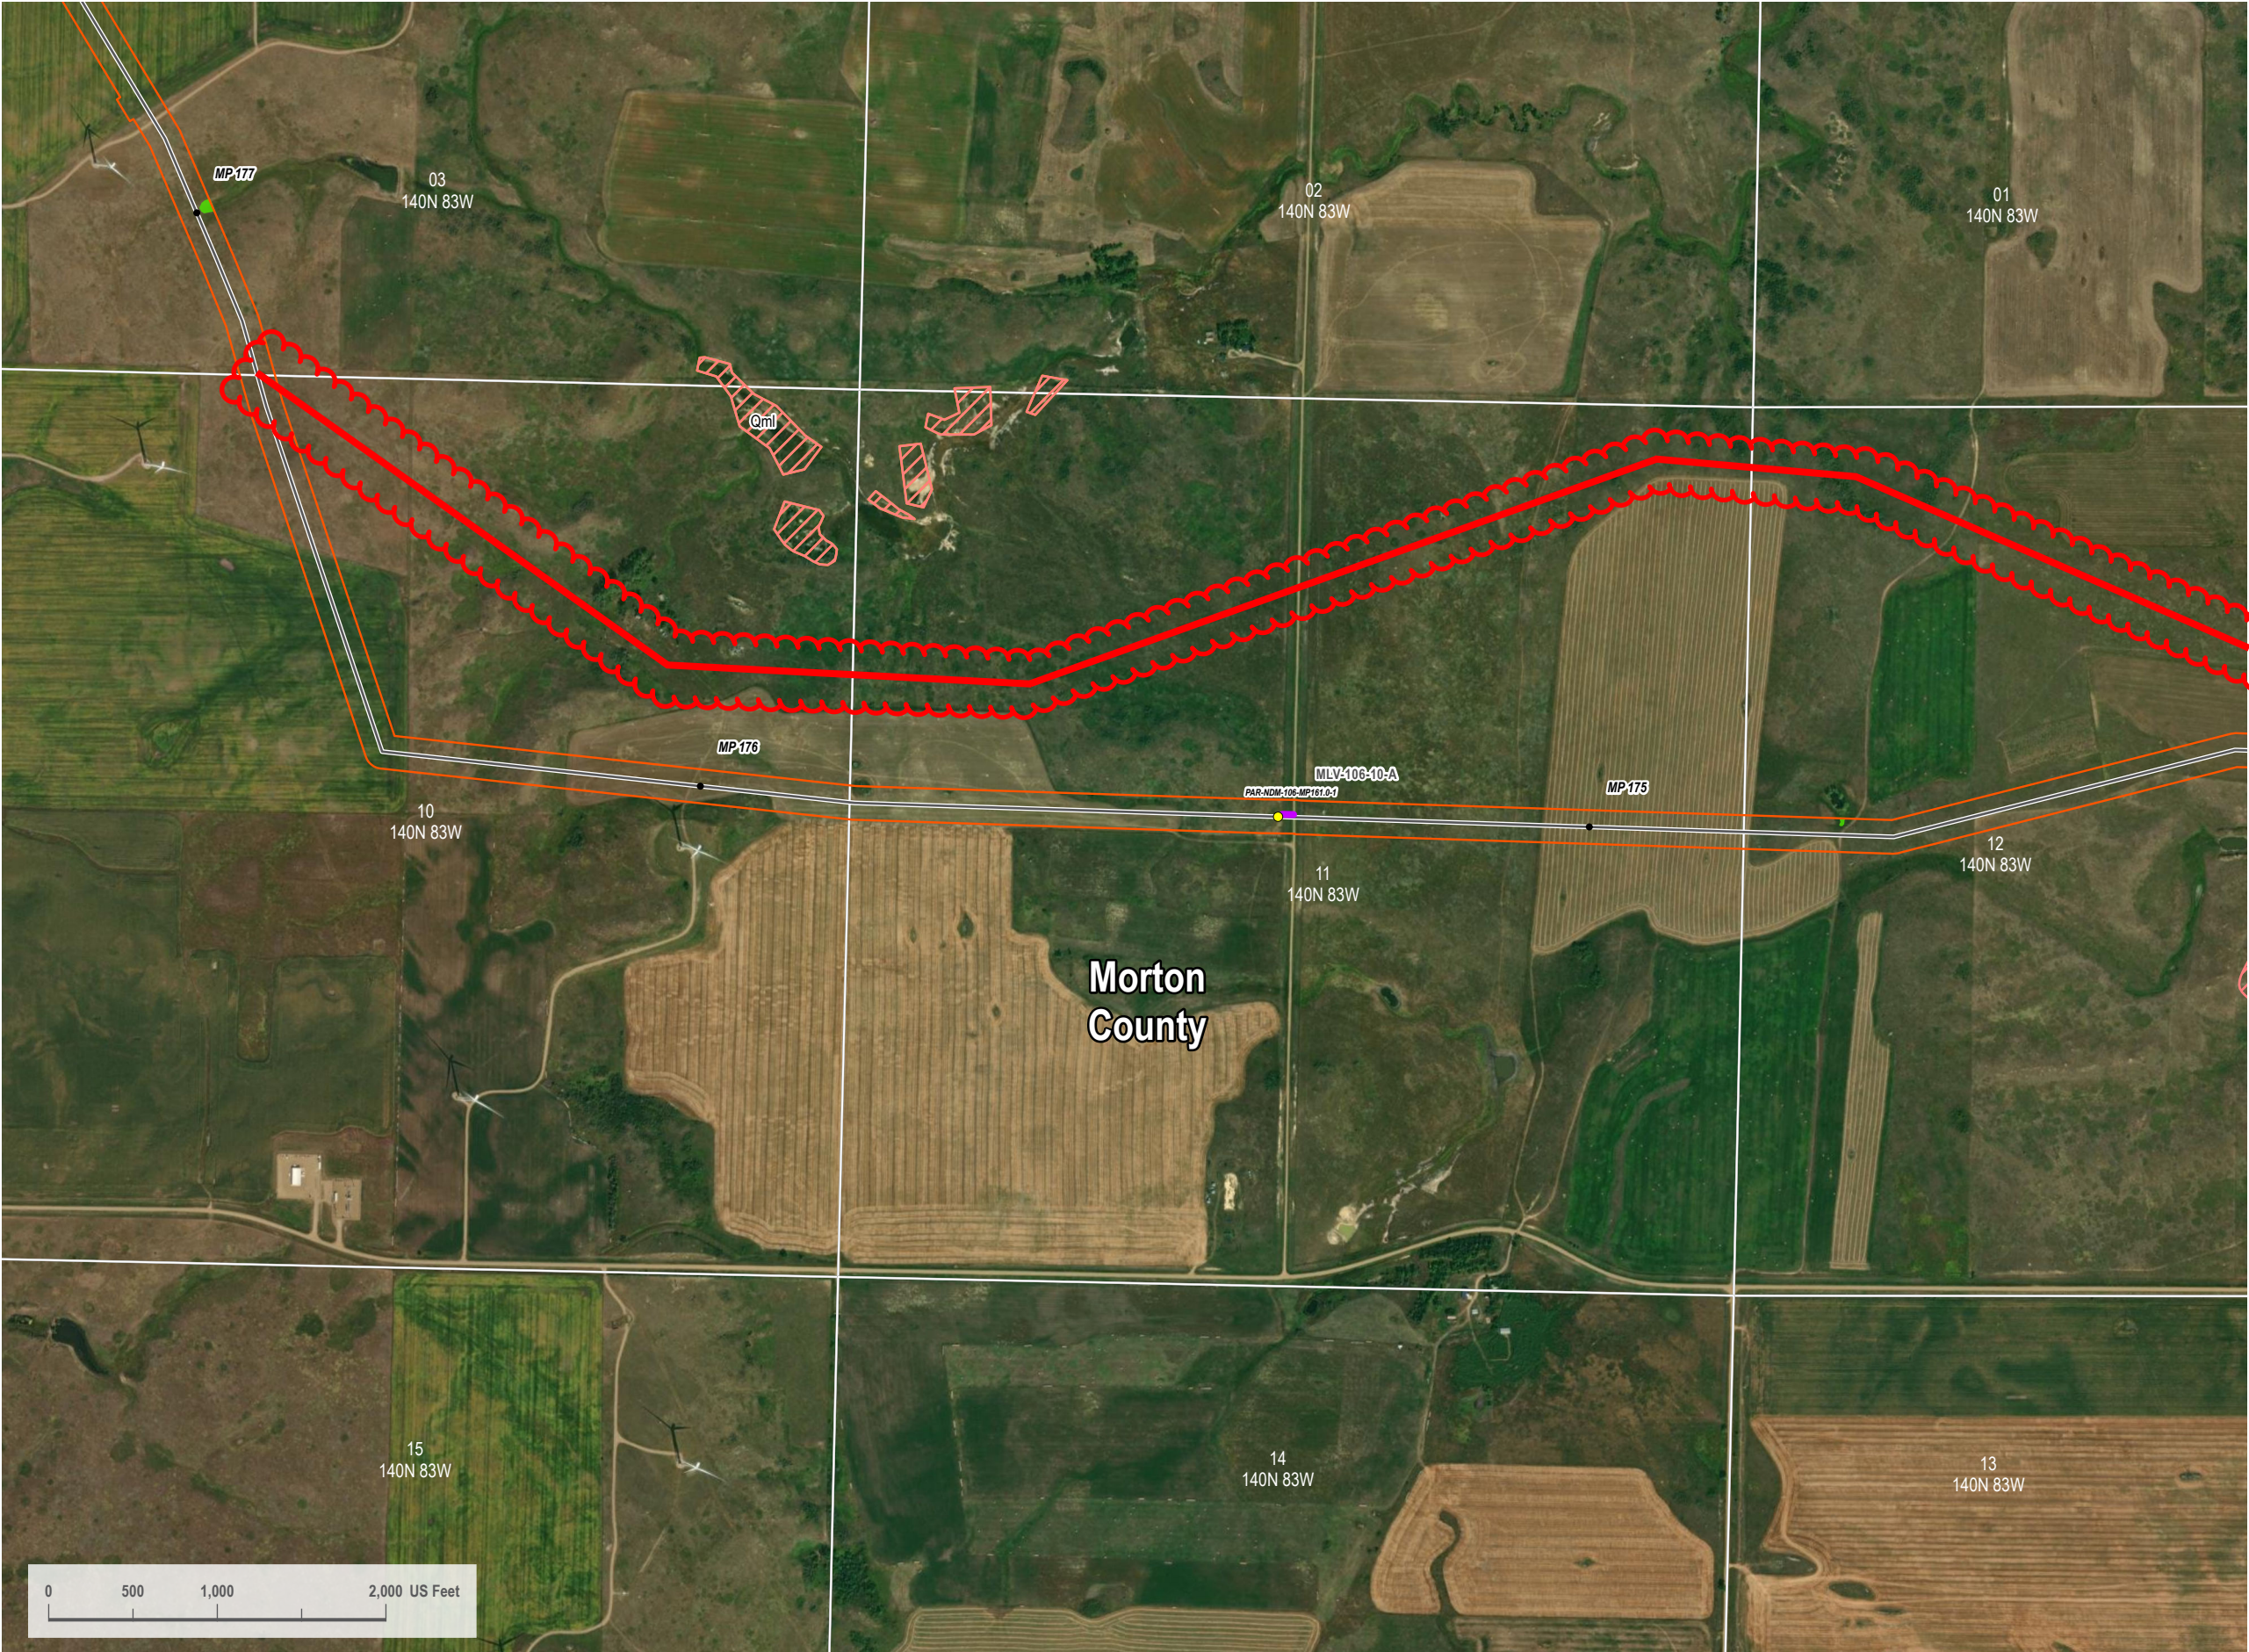


VICINITY MAP



LEGEND

- Centerline Mileposts
- Mainline Valve Location
- Proposed Route
- Section Line
- Access Road
- Landslide Deposit (Avoidance)
- Pump Station
- Avoidance Area
- Open Water
- PEM Wetland
- 200-foot Siting Corridor

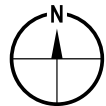

REVISIONS

Date:	2024-01-28	Revised by:	CW	Checked by:	RC
A - Issued for Review					
Date:		Revised by:		Checked by:	
Date:		Revised by:		Checked by:	

PREPARED BY


**Summit Carbon Solutions**  
2321 North Loop Drive, Suite 221  
Ames, Iowa 50010  
United States of America  
[www.summitcarbonsolutions.com](http://www.summitcarbonsolutions.com)



**SUMMIT CARBON**  
SOLUTIONS

PROJECT INFORMATION

Figure Title: <b>ND PSC - Aerial Map Book - NDM-106</b>	
Figure Number: <b>Map Book 1</b>	
Scale: <b>1 : 12,000</b> 1 inch equals 1,000 feet	Projection: <b>Transverse Mercator</b> NAD 1983 UTM Zone 14N
Sheet: <b>61</b> 61 of 149	Drawing Number: <b>1001-01-004</b> Revision A

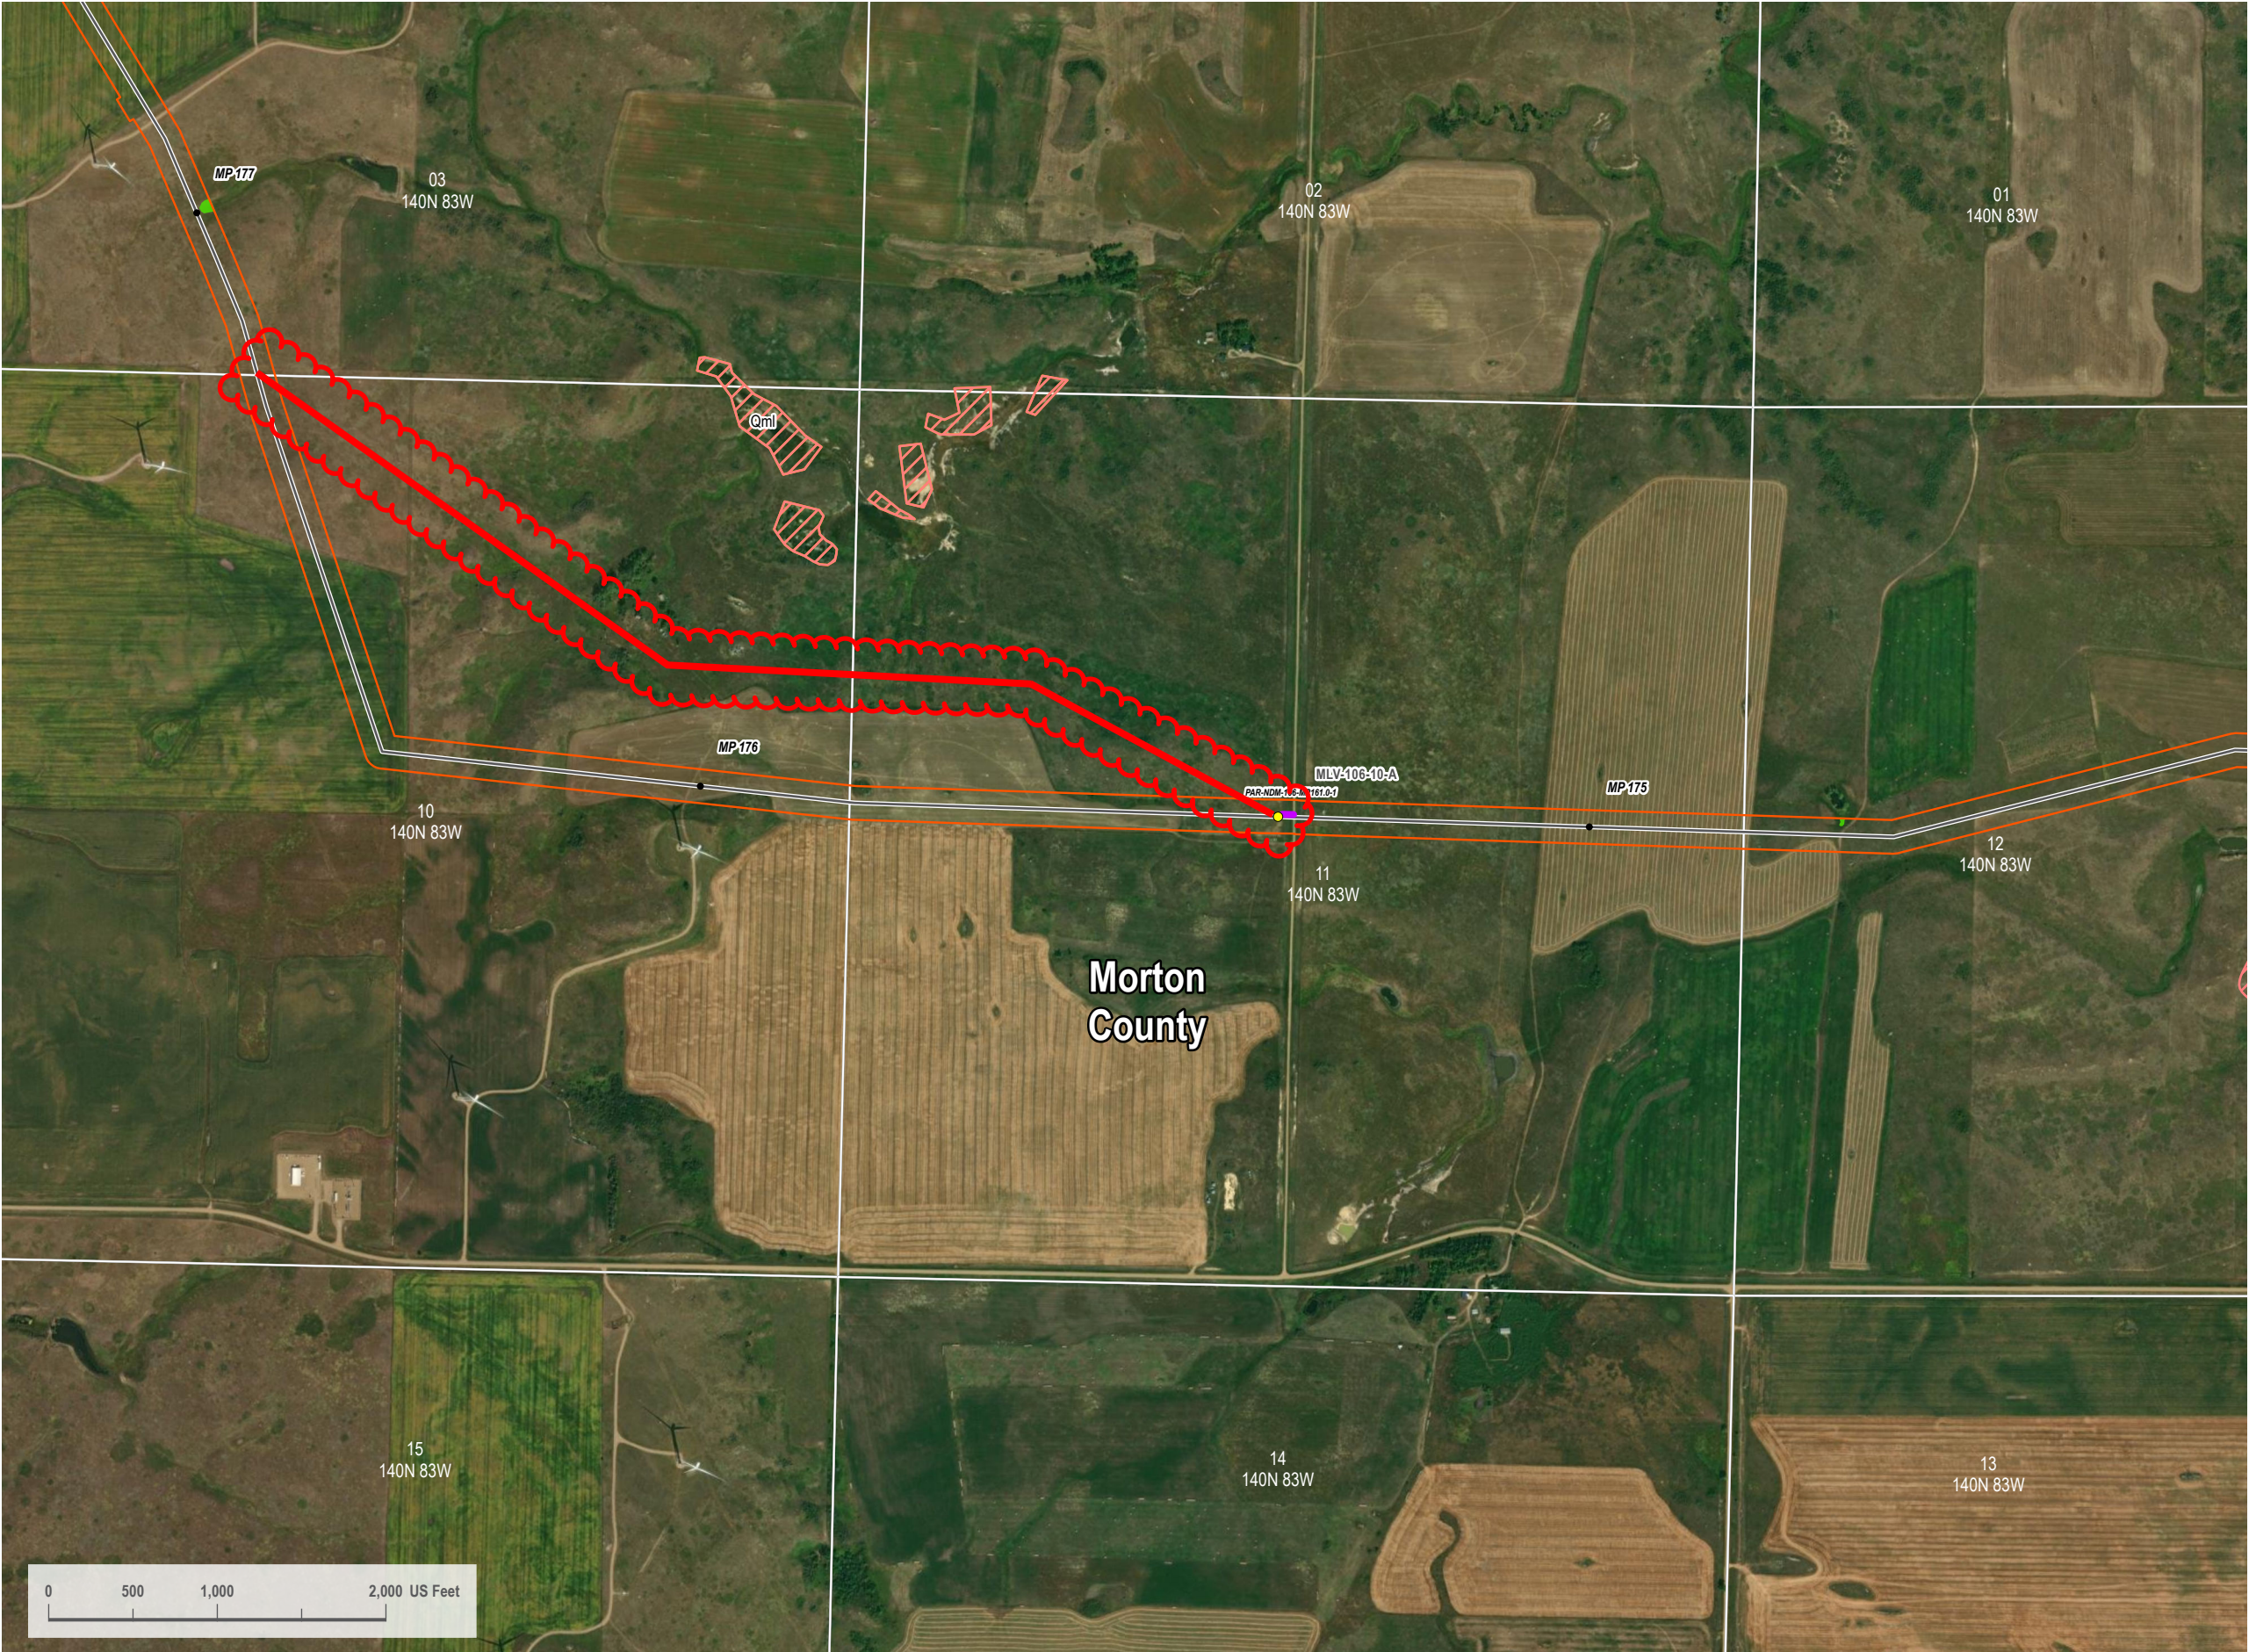


VICINITY MAP



LEGEND

- Centerline Mileposts
- Mainline Valve Location
- Proposed Route
- Section Line
- Access Road
- Landslide Deposit (Avoidance)
- Pump Station
- Avoidance Area
- Open Water
- PEM Wetland
- 200-foot Siting Corridor

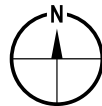

REVISIONS

Date:	2024-01-28	Revised by:	CW	Checked by:	RC
A - Issued for Review					
Date:		Revised by:		Checked by:	
Date:		Revised by:		Checked by:	

PREPARED BY

**Summit Carbon Solutions**  
2321 North Loop Drive, Suite 221  
Ames, Iowa 50010  
United States of America  
[www.summitcarbonsolutions.com](http://www.summitcarbonsolutions.com)



**SUMMIT CARBON**  
SOLUTIONS

PROJECT INFORMATION

Figure Title: <b>ND PSC - Aerial Map Book - NDM-106</b>	
Figure Number: <b>Map Book 1</b>	
Scale: <b>1 : 12,000</b> 1 inch equals 1,000 feet	Projection: <b>Transverse Mercator</b> NAD 1983 UTM Zone 14N
Sheet: <b>61</b> 61 of 149	Drawing Number: <b>1001-01-004</b> Revision A