

April 24, 2023

Via Electronic Mail and Hand Delivery

Mr. Steve Kahl
North Dakota Public Service Commission
600 E. Boulevard, Dept. 408
Bismarck, ND 58505-0480
ndpsc@nd.gov


**RE: ONEOK Rockies Midstream, L.L.C.
Demicks Lake Gas Plant
McKenzie County
Our File No. 072530-000009**

Dear Mr. Kahl:

Enclosed for filing please find five copies of the Certification Relating to N.D.C.C. § 49-22.1-01(3)(a) in the captioned matter.

Please feel free to contact me if you have any questions. Thank you.

Sincerely,

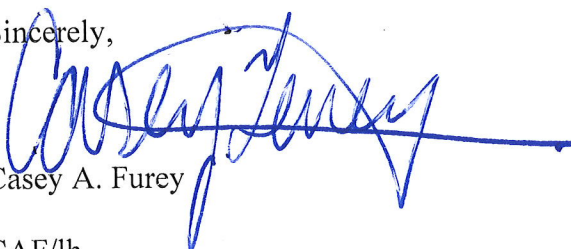

Casey A. Furey

CAF/lh
Enc.

cc: Wade C. Mann (via email)
Michael Dailey (via email)

1 PU-23-164 Filed 04/24/2023 Pages: 4
Certification Relating to N.D.C.C. § 49-22.1-01(3)(a)
ONEOK Rockies Midstream, L.L.C.
Casey Furey, Crowley Fleck, PLLP

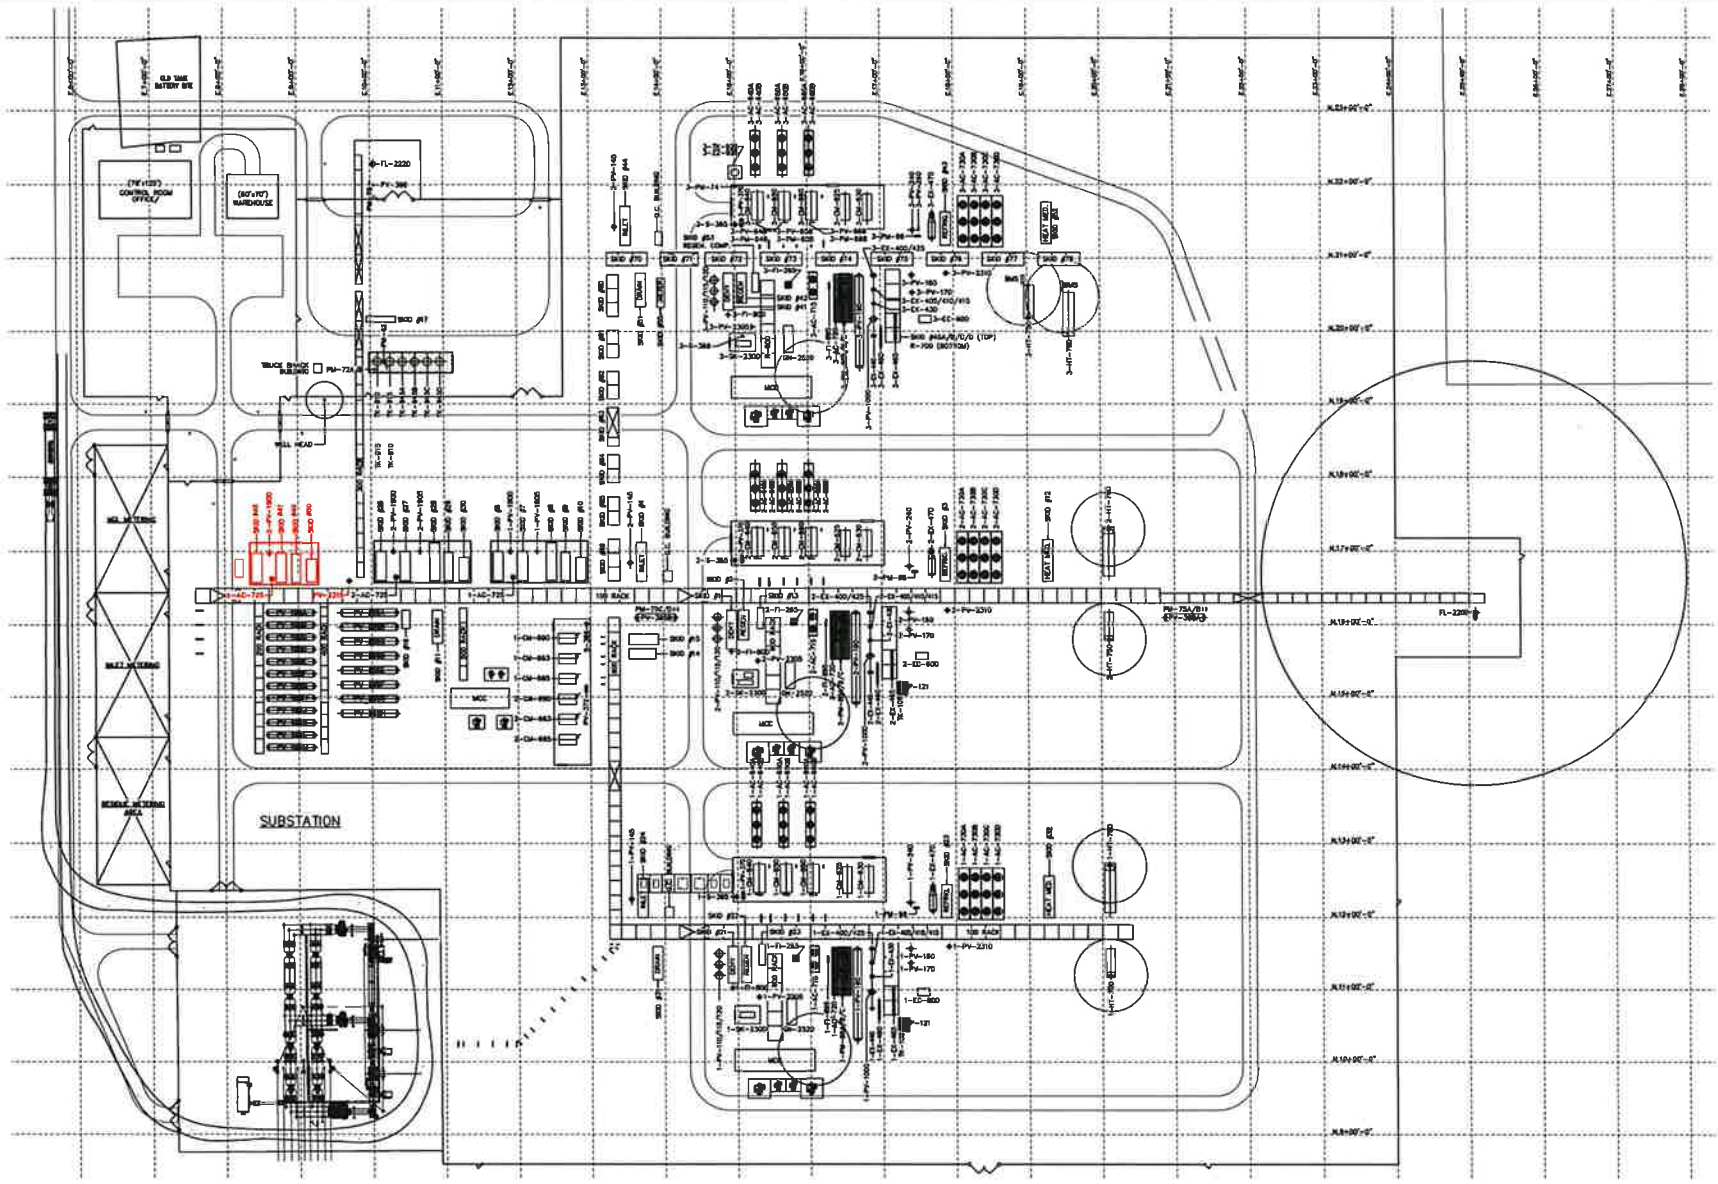


EXHIBIT
A

— INDICATES CONTAINMENT



REFERENCE DRAWINGS		No.	REVISION	BY	DATE	CHK.
NUMBER	TITLE	9	ISSUED FOR CONSTRUCTION - OPS JOB #19000	MSU	02/20/03	JC

ONEOK
DEMICKS LAKE CRYO

MCKENZIE COUNTY, ND

SCALE: 1" = 80' (CHECK BY: **MSU**)

PLANT PLAN
DEMICKS LAKE CRYO PLANT - 7061/18028/19050

DATE: 11/20/03
PROJECT NO: 19050

19050-PP-301

REV: 0