



EXHIBIT A

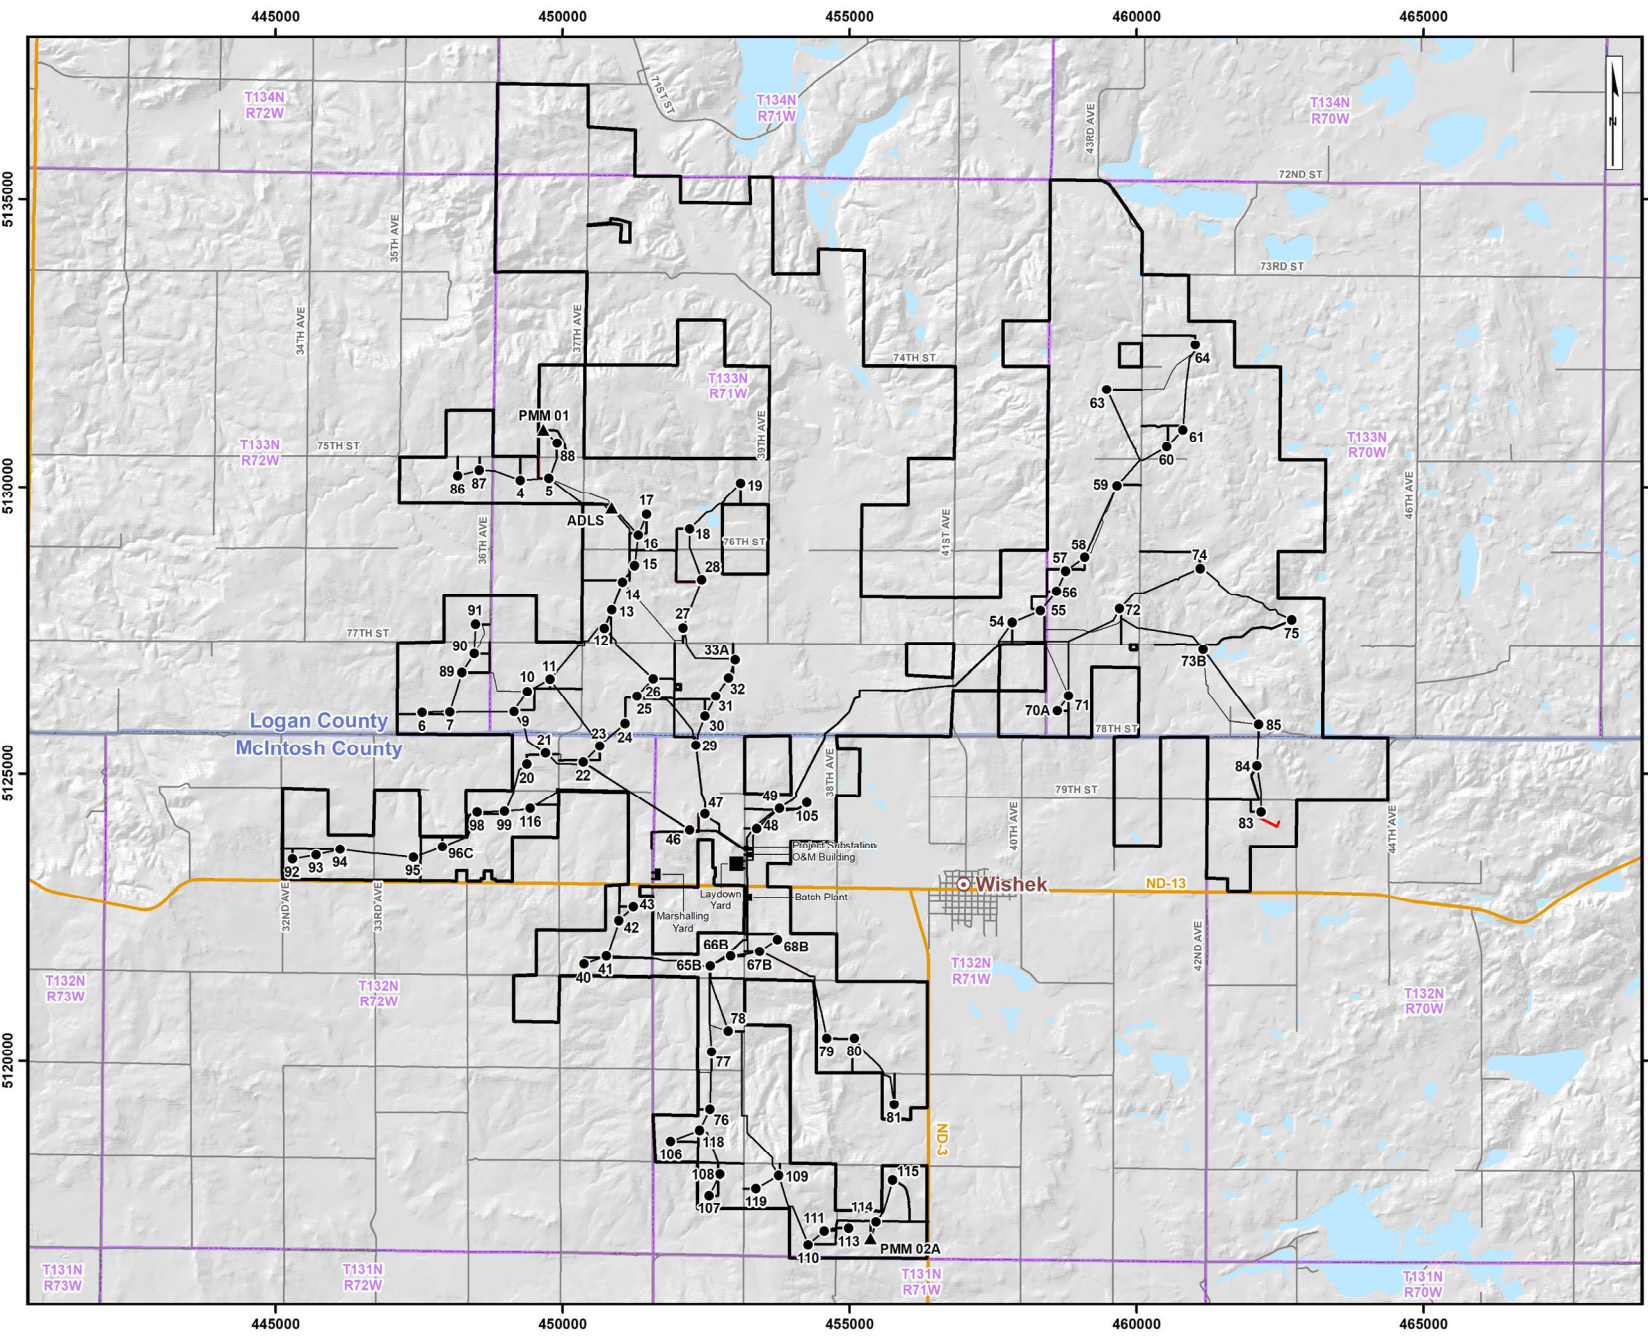

Legend

- Current Layout (May 2025)
- Previous Layout (April 2025)
- Current Project Area
- County
- Township (PLSS)
- State Road
- County/Township Road

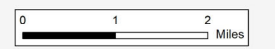

Badger Wind, LLC

**Figure 2:
COMPARISON FIGURE**

10455420-250529-PV
May 29, 2025
Projection: NAD83 UTM14
Sources: ESRI, USGS