

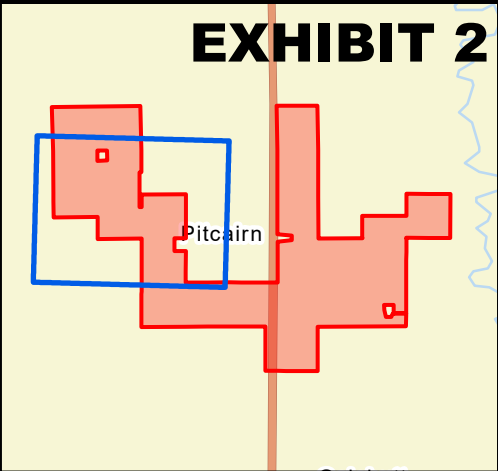


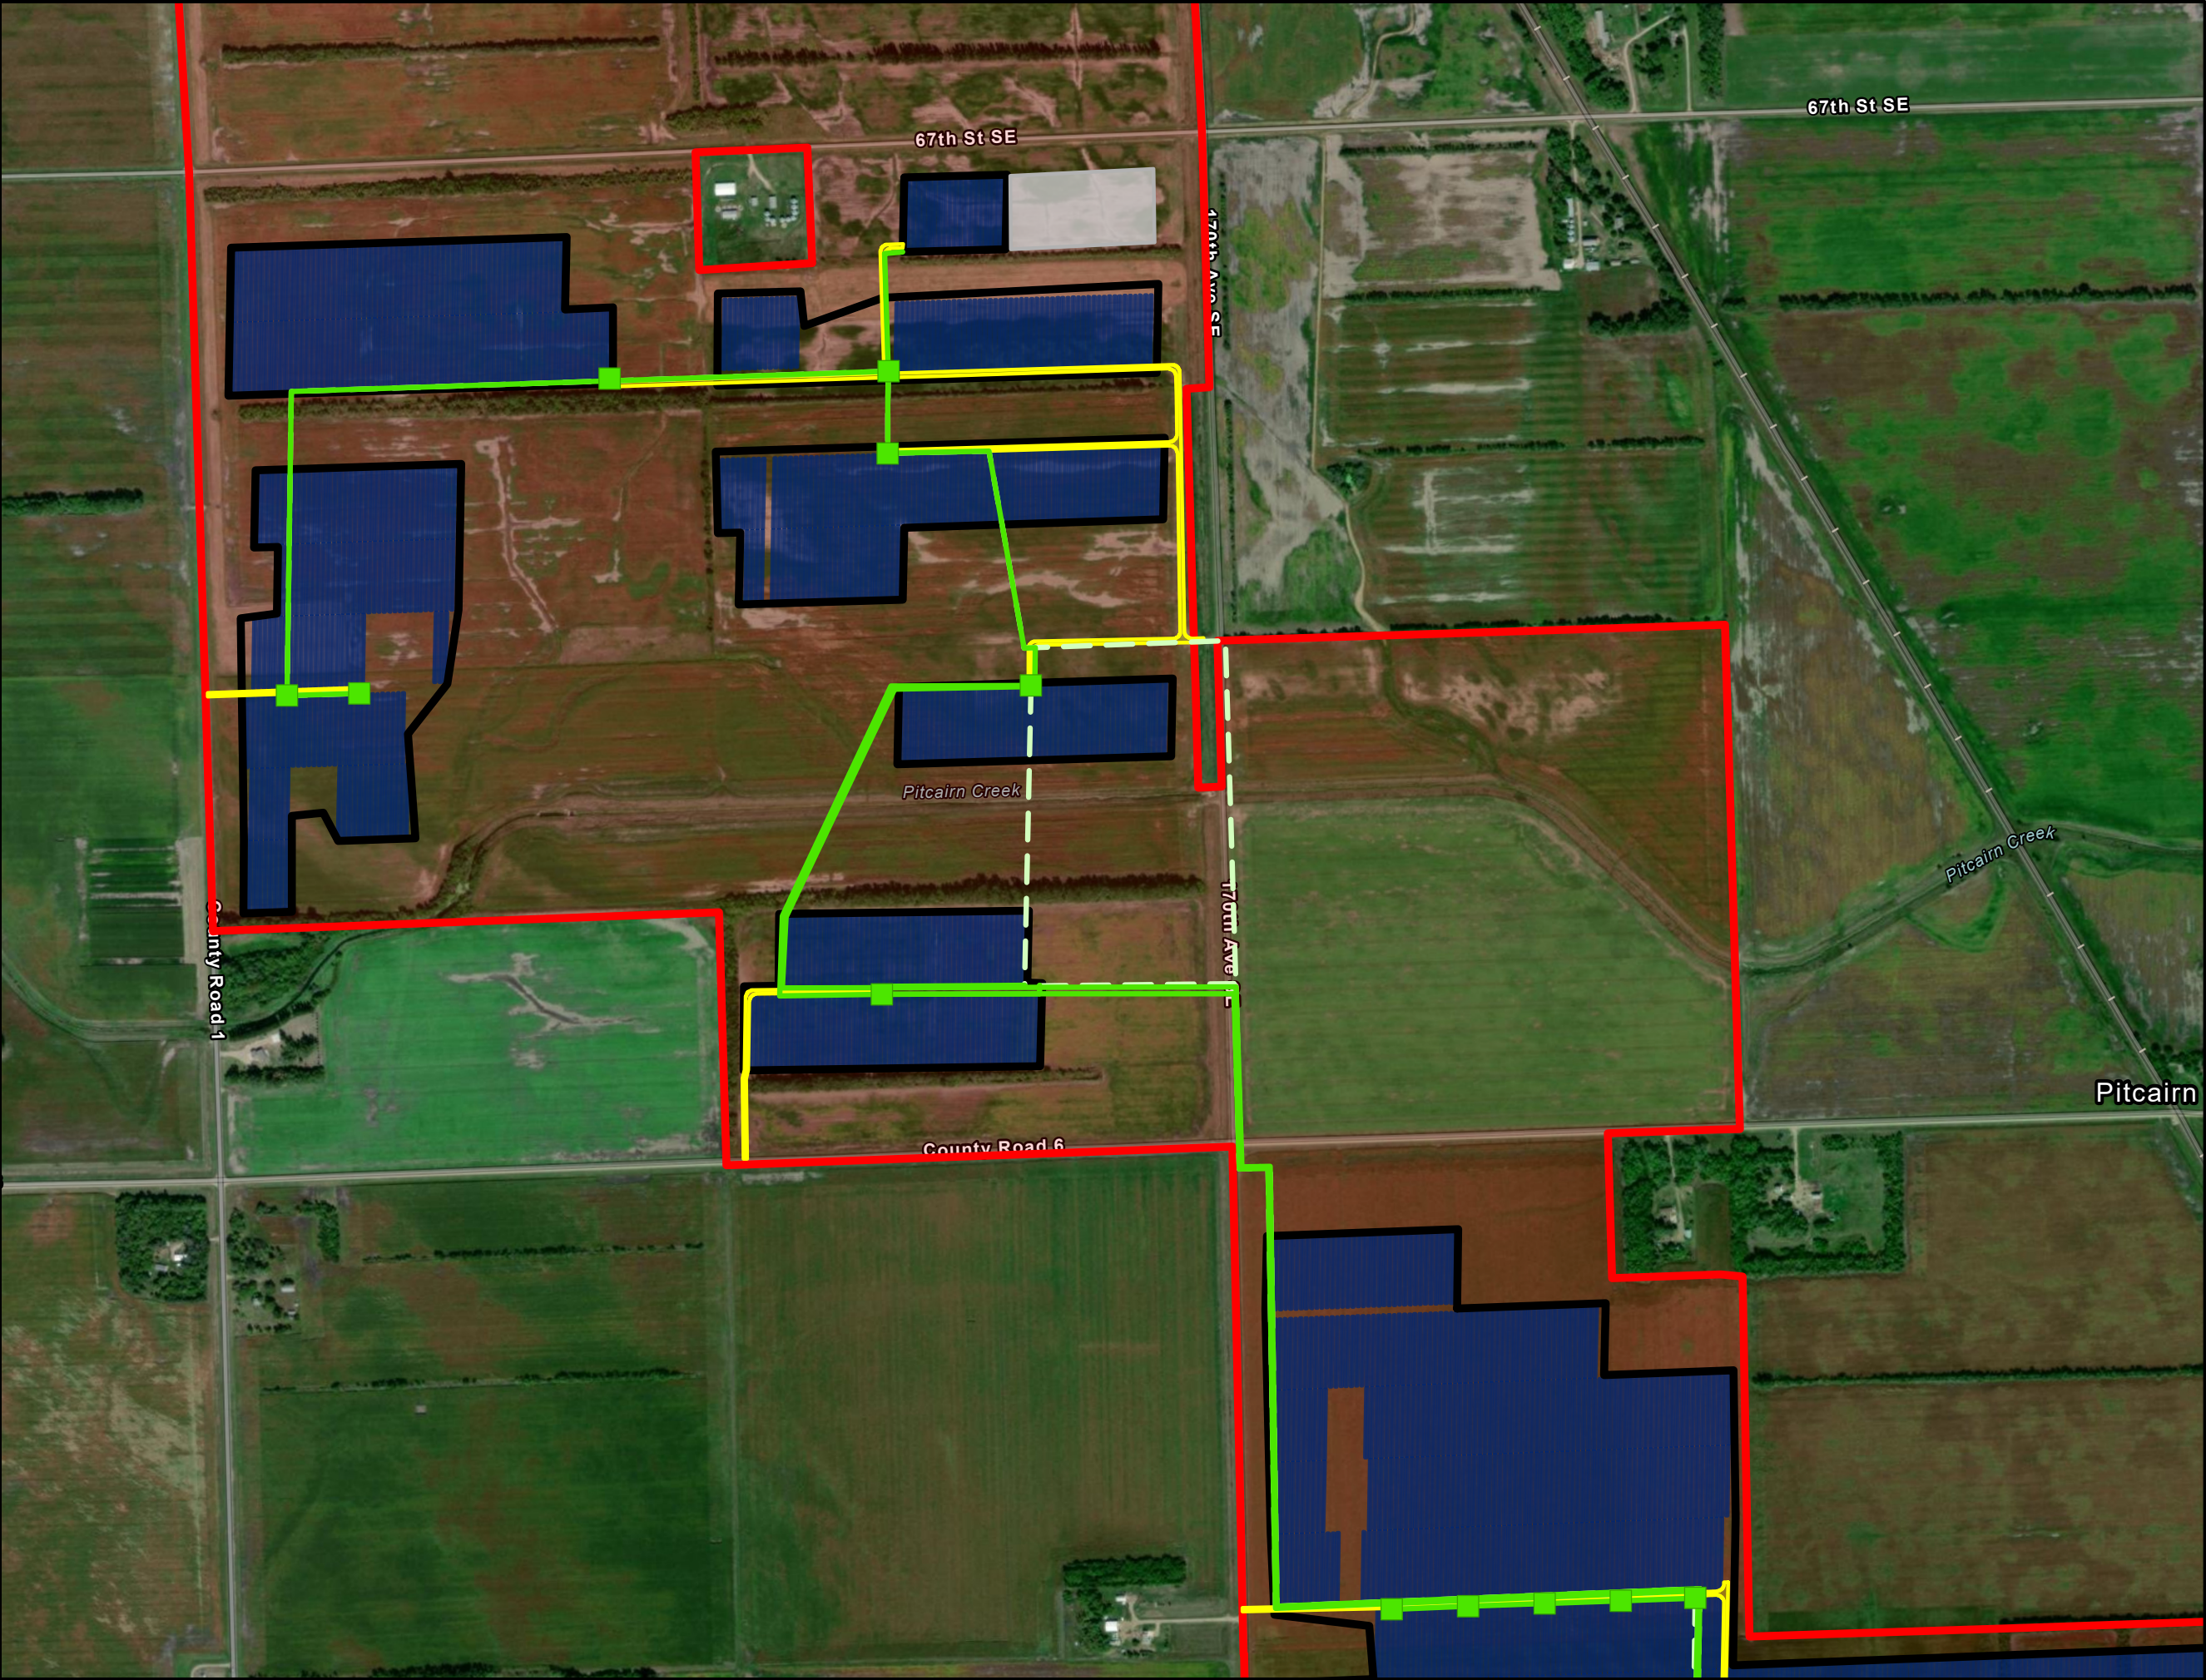

- Project Area and Project Facilities**
- Project Area
 - PV Panels
 - Fence
 - Access Road
 - Current Electrical Collection Cable
 - Former Electrical Collection Cable
 - Inverter
 - Temporary Laydown Area

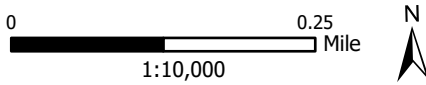

Project Update Figure

Flickertail Solar Project
Richland County, North Dakota

FLICKERTAIL
SOLAR PROJECT