

November 6, 2025

Mr. Steve Kahl
Executive Secretary/Director of Administration
North Dakota Public Service Commission
600 East Boulevard: Department 408
Bismarck, ND 58505-0480

Re: Case No. PU-24-361
Basin Electric Power Cooperative
Leland Olds Station to Tande 345-kV Transmission Line Project

Dear Mr. Kahl:

In accordance with item 38 of the Certification Relating to Order Provisions, please accept this Structure Relocation request for Basin Electric Power Cooperative's (Basin Electric) Leland Olds Station to Tande 345-kV Transmission Line Project (PU-24-361). Two structures are being relocated due to engineering and design reasons. Both structure relocations are within the established corridor, as reflected in the Certificate of Corridor Compatibility Number 237. Please see the table below and attached figures showing the adjusted structure locations.

Structure Number	Location	Relocation	Reason for Relocation
436-152	T147N, R82W, S11	5'	Engineering/Design
436-165	T148N, R82W, S35	40'	Engineering/Design

A notarized Certification that Basin Electric Power Cooperative will comply with the Commissioner's order, law and rules designating the corridor and route is attached.

If you have any questions or require additional information for this submittal, please contact me at rking@becpc.com or 701-557-5558.

Sincerely,



Ryan King
Environmental Coordinator

Attachments: Certification of Applicant

CERTIFICATION OF APPLICANT – TRANSMISSION FACILITY SITING

Case No. PU-24-361

BASIN ELECTRIC POWER COOPERATIVE

I, Ryan King, Environmental Coordinator, a duly authorized agent of Basin Electric Power Cooperative that has authority to bind the company in these matters, do hereby certify under oath:

1. That the relocation of the structures on the Leland Olds Station to Tande Transmission Line (PU-24-361) will not affect any known exclusion or avoidance areas as defined under the North Dakota Administrative Code § 69-06-08-02(1) and (2).
2. That Basin Electric Power Cooperative will comply with all applicable conditions and protections in North Dakota siting laws and rules and the Commission's previously issued order, law and rules designating the corridor and route.


Dates at Bismarck, North Dakota this 6th day of November, 2025.



Ryan King
Environmental Coordinator

STATE OF NORTH DAKOTA)
)ss.
COUNTY OF BURLEIGH)


This instrument was acknowledged before me this 6th day of Nov, 2025 by Ryan King on behalf of Basin Electric Power Cooperative.

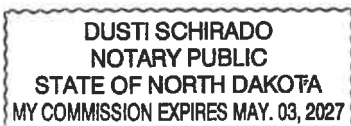


Notary Public

Leland Olds-to-Tande 345kV Transmission Project

Update Structure Location: 436-152

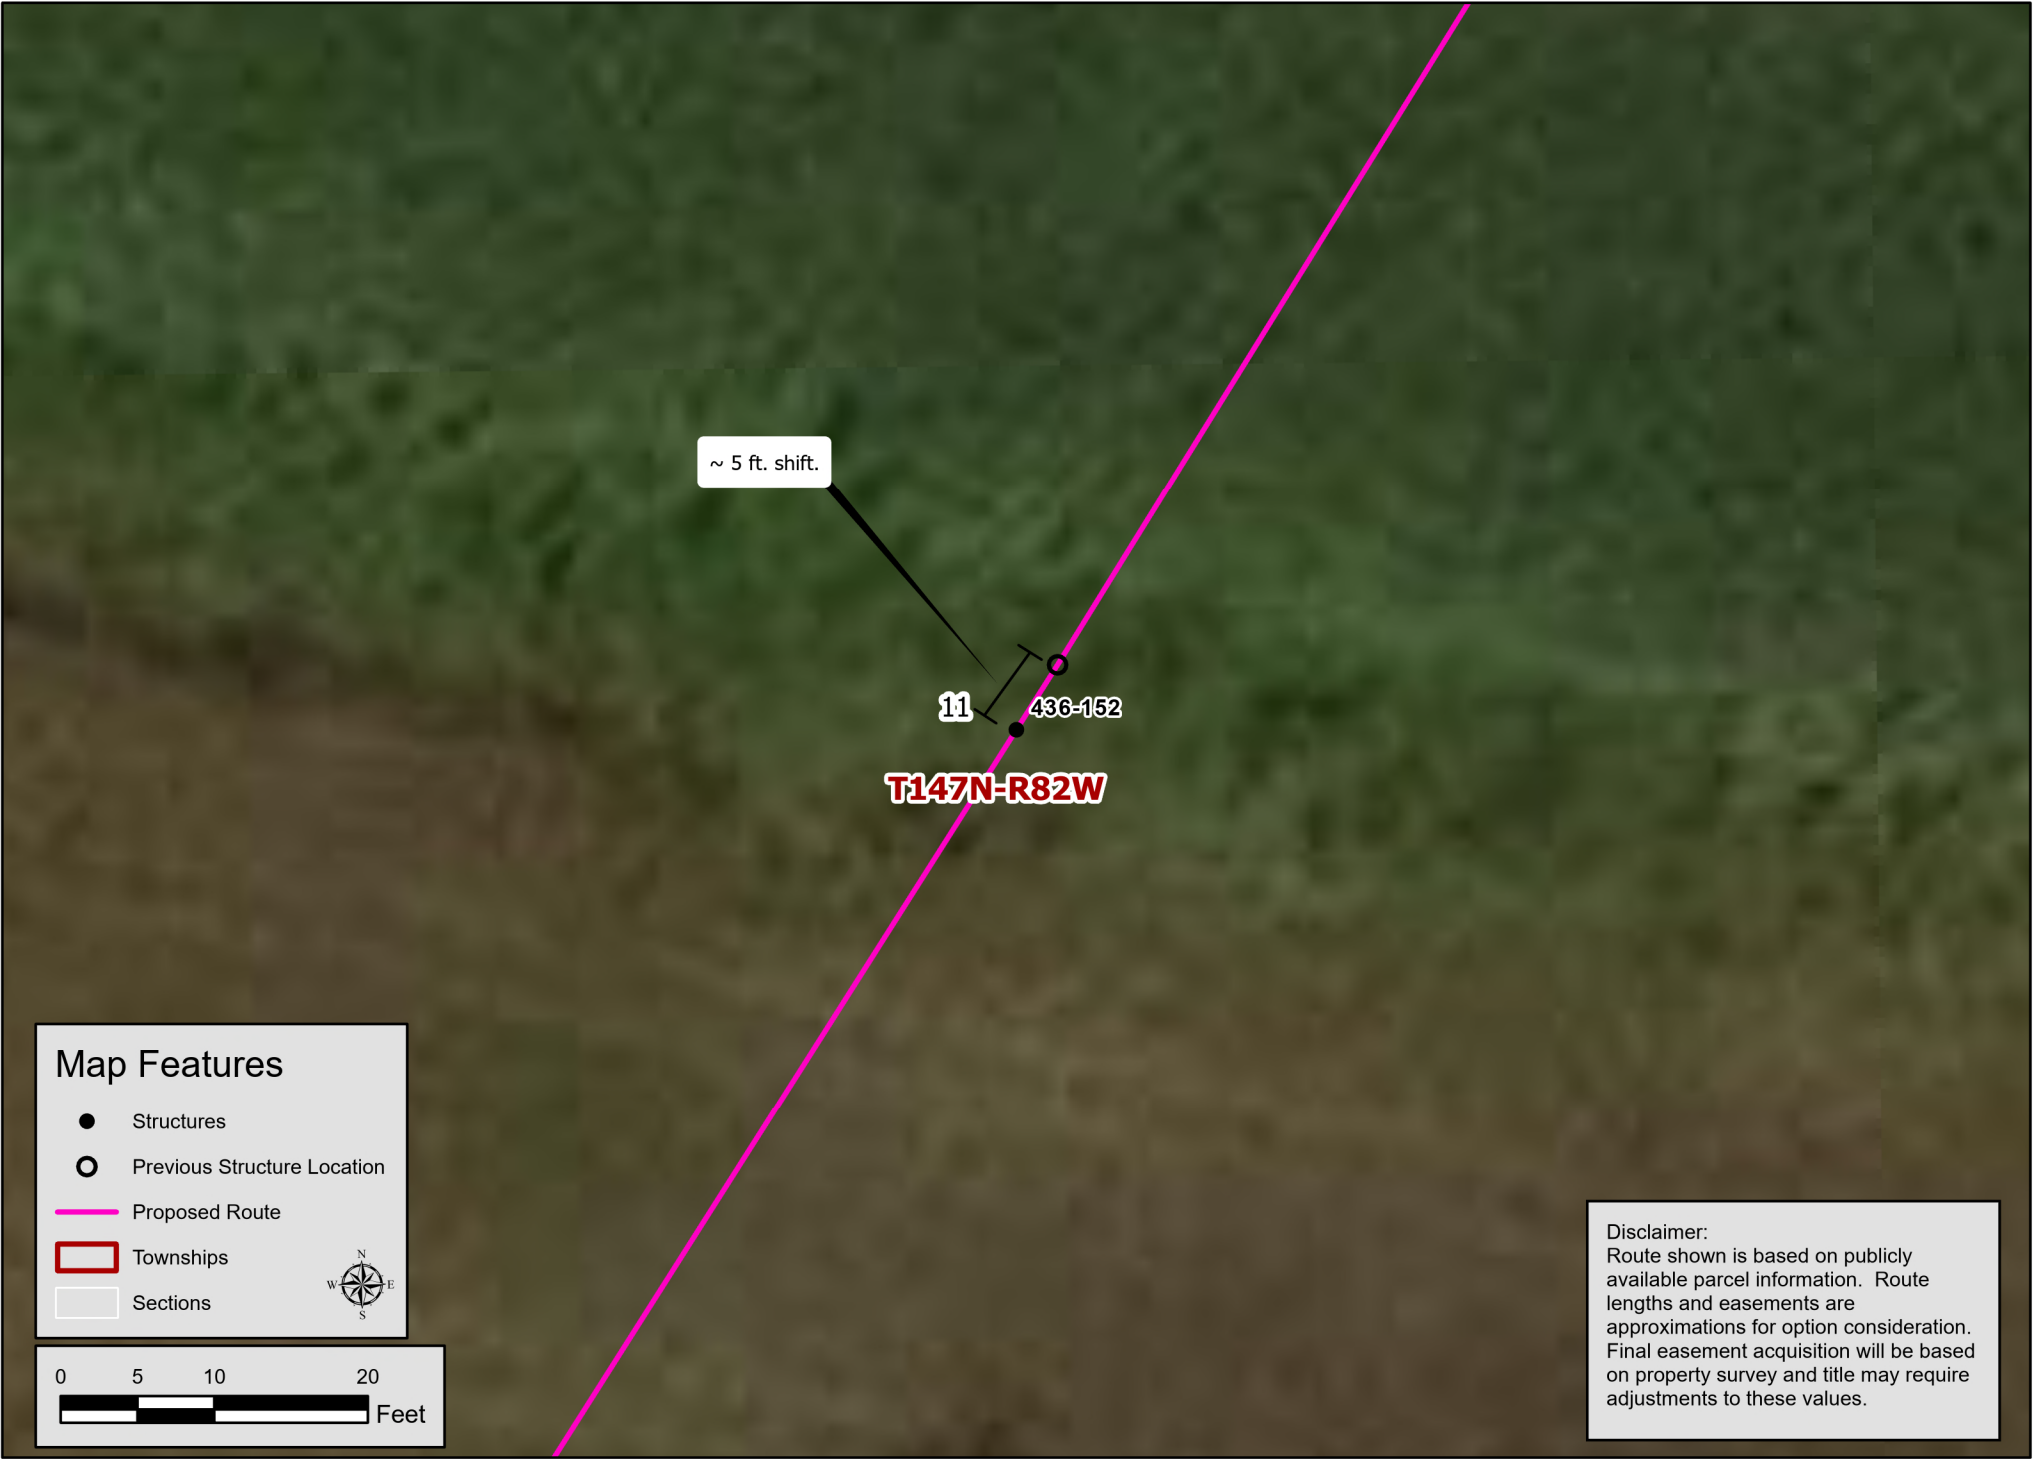

Leland Olds-to-Tande 345kV Transmission Project

Update Structure Location: 436-165

