



Updated Exhibit 3.5.3; PMT Beulah Mine

From Noel, Jesse <jnoel@westmoreland.com>

Date Wed 5/21/2025 12:42 PM

To Emmer, Jonathan W. <jemmer@nd.gov>; Nixon, Shawn <snixon@nd.gov>

Cc Kuzara, David <DKuzara@westmoreland.com>; Ore, Juris <jore@westmoreland.com>; Briggs, Todd <TBriggs@westmoreland.com>

 2 attachments (8 MB)

Exhibit 3.5.3 R36_WWC_MAY_21_2025.dwg; Exhibit 3.5.3 R36_WWC_MAY_21_2025.pdf;

<p>***** CAUTION: This email originated from an outside source. Do not click links or open attachments unless you know they are safe. *****</p>
--

Jonathan,

Based on Shawn's concerns with the originally submitted PMT (R36), the updated version is attached to this email. The slopes on the PMT are not as steep as the originally submitted PMT. Also, the new PMT is similar to the approved PMT (R35), with better ties into the County Road. As we discussed earlier, I think it would be beneficial to meet in the field and discuss any questions you may have with the new design. Please feel free to contact me with any questions or concerns.

Thanks,

 **Westmoreland Mining LLC**


Jesse Noel, P.E.

Director, Environmental & Regulatory Affairs

1601 Lewis Ave., Suite 112 | Billings, MT 59102


Direct: (406) 226-2255 | Mobile: (406) 740-0242

Email: jnoel@westmoreland.com | Website: www.westmoreland.com

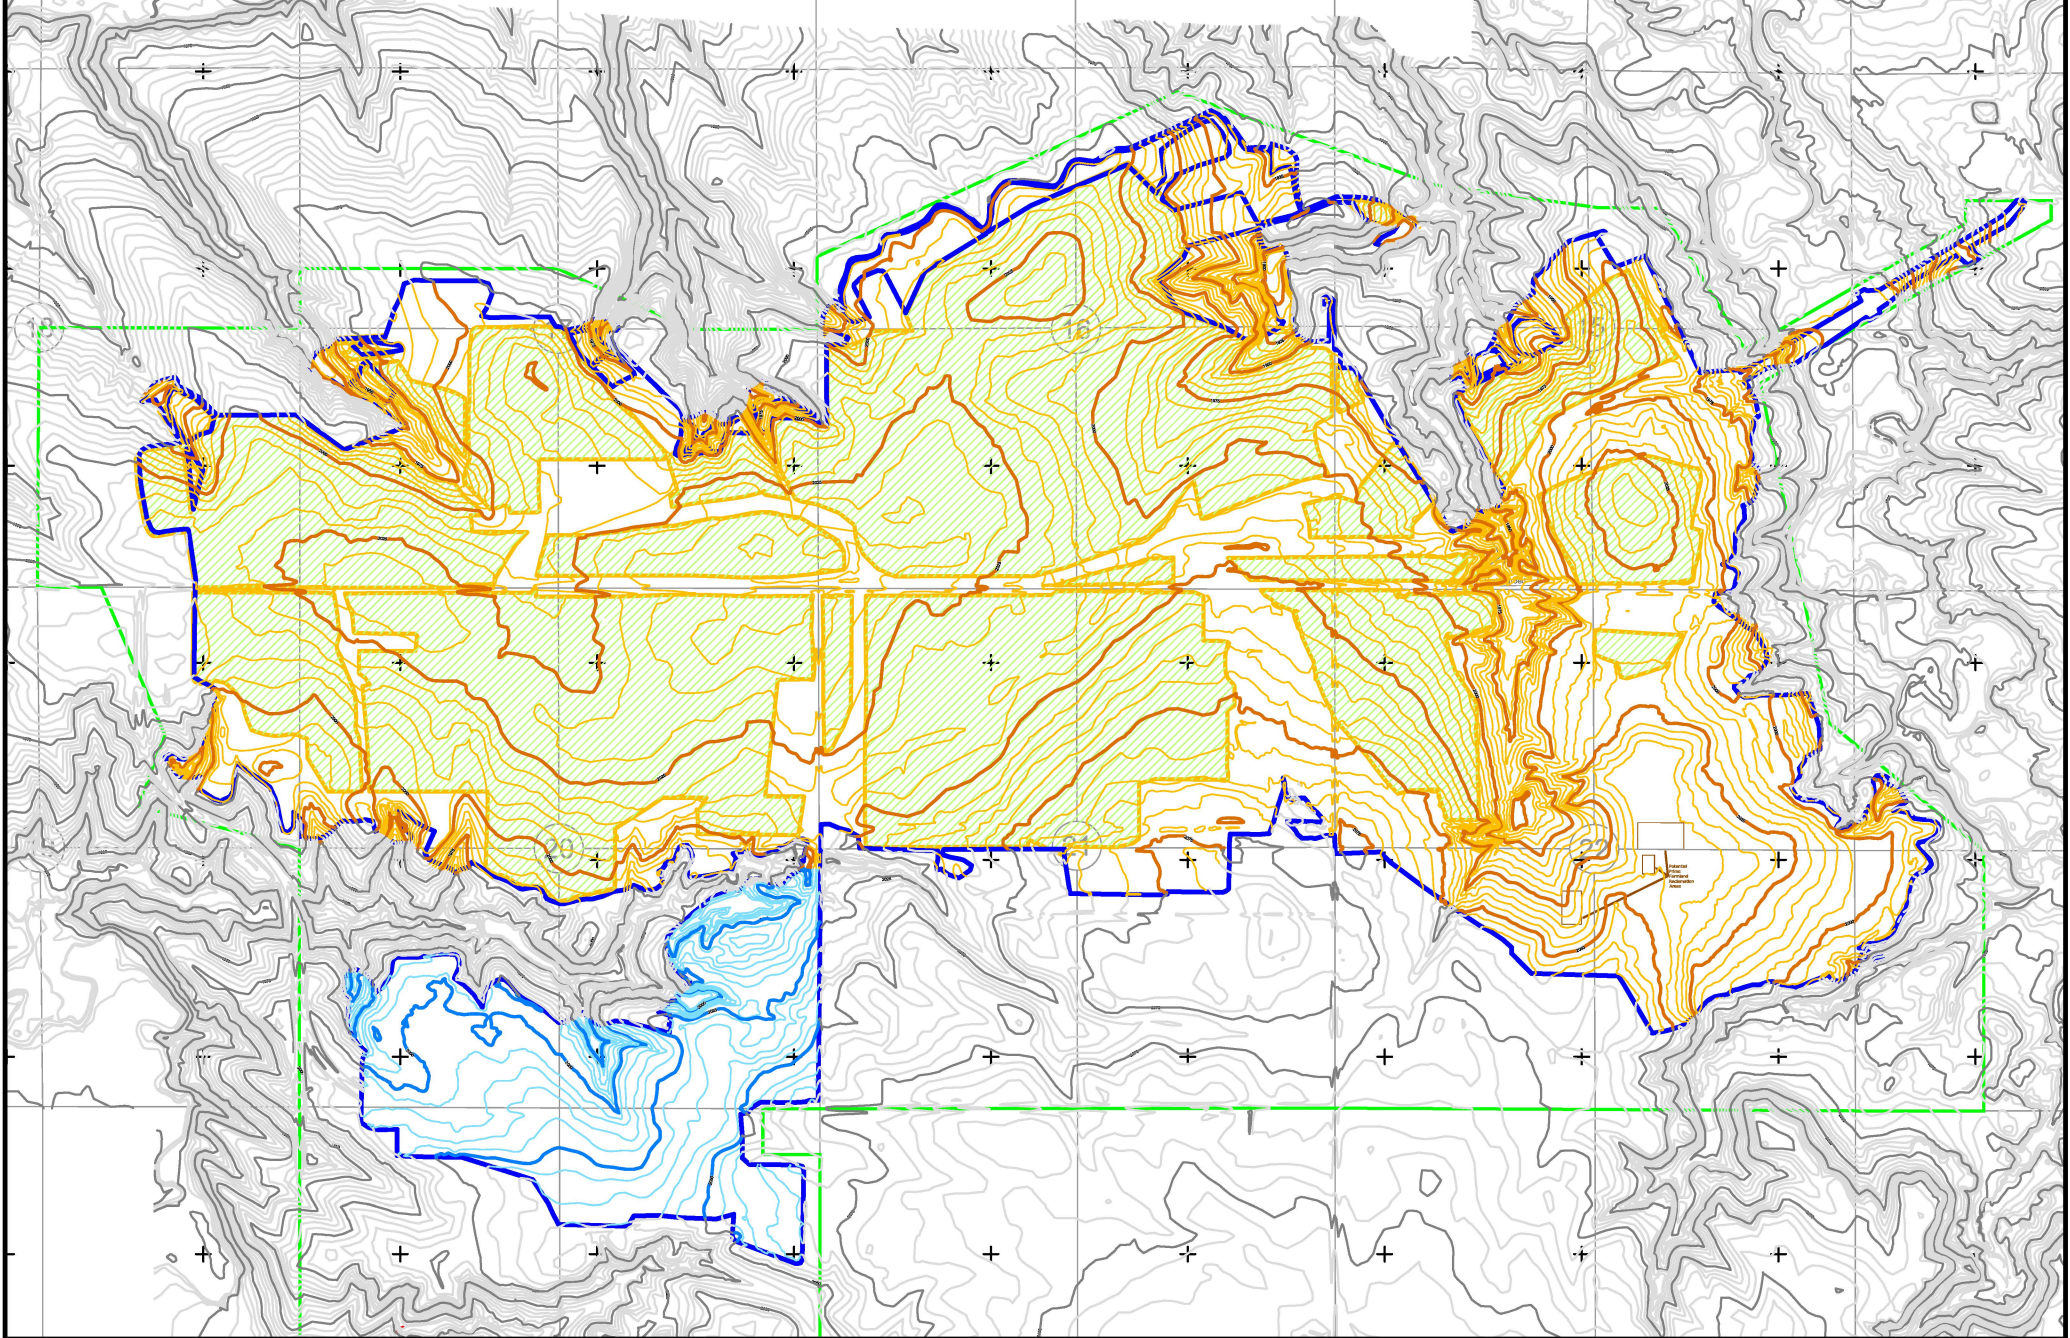

- LEGEND**
- Proposed Fence Perennial Reclamation Area
 - LINE OF NEAR APPROXIMATE BOUNDARY
 - PROPOSED INDEX CONTOUR
 - PROPOSED INTERMEDIATE CONTOUR
 - PROPOSED INDEX CONTOUR ARE
 - PROPOSED INTERMEDIATE CONTOUR ARE
 - INDEX CONTOUR
 - INTERMEDIATE CONTOUR
 - FIELD APPROVED FINAL BOUNDARY

T. 143 N., R. 66 W.
 MERCER COUNTY
 NORTH DAKOTA

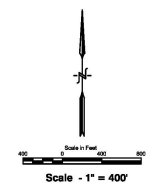

DATE	Revision
05/21/25	WVC Revision 36
06/23/21	J. Noel Revision 32
04/30/21	J. Noel Revision 32
01/31/17	C. Oswald Revision 31
08/15/16	J. Frolich Revision 30
04/02/14	J. Osborn Revision 27
10/26/12	B. Lee Revision 27
08/23/10	B. Lee Revision 23

MINE: Beulah, ND
 AREA: KR5B-8603

POST MINING TOPOGRAPHY (PMT) EXHIBIT 3.5.3

DATE	Name
12/12/04	Jo Frolich
2003	Frolich, Martinez Corp.