


**Remaining Class III
Cultural Resource Survey Areas**

Figure 6.7-1

JETx
Jamestown to Ellendale

- Remaining Class III Cultural Resource Survey Areas
- - - Updated Route
- Route as Filed (August 2025)
- Project Substations
- Study Area
- PLSS Sections

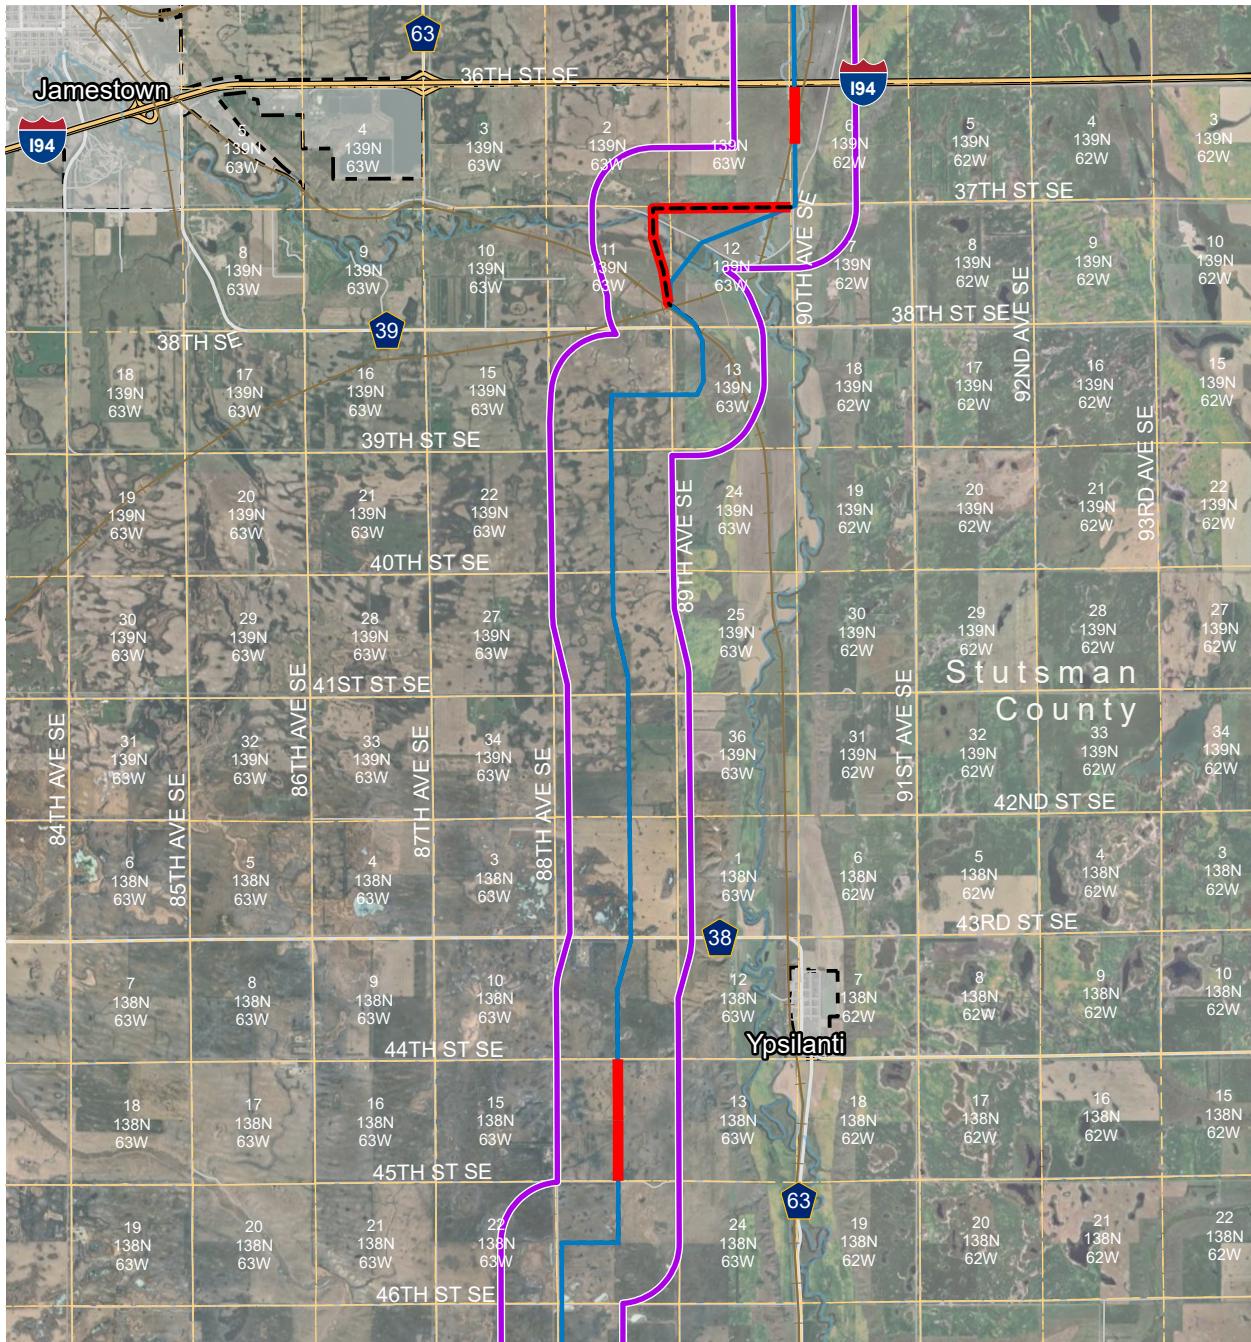


**Remaining Class III
Cultural Resource Survey Areas**
Figure 6.7-1



JETx
Jamestown to Ellendale

- Remaining Class III Cultural Resource Survey Areas
- Updated Route
- Route as Filed (August 2025)
- Study Area
- PLSS Sections

Updated Page 2 of 7

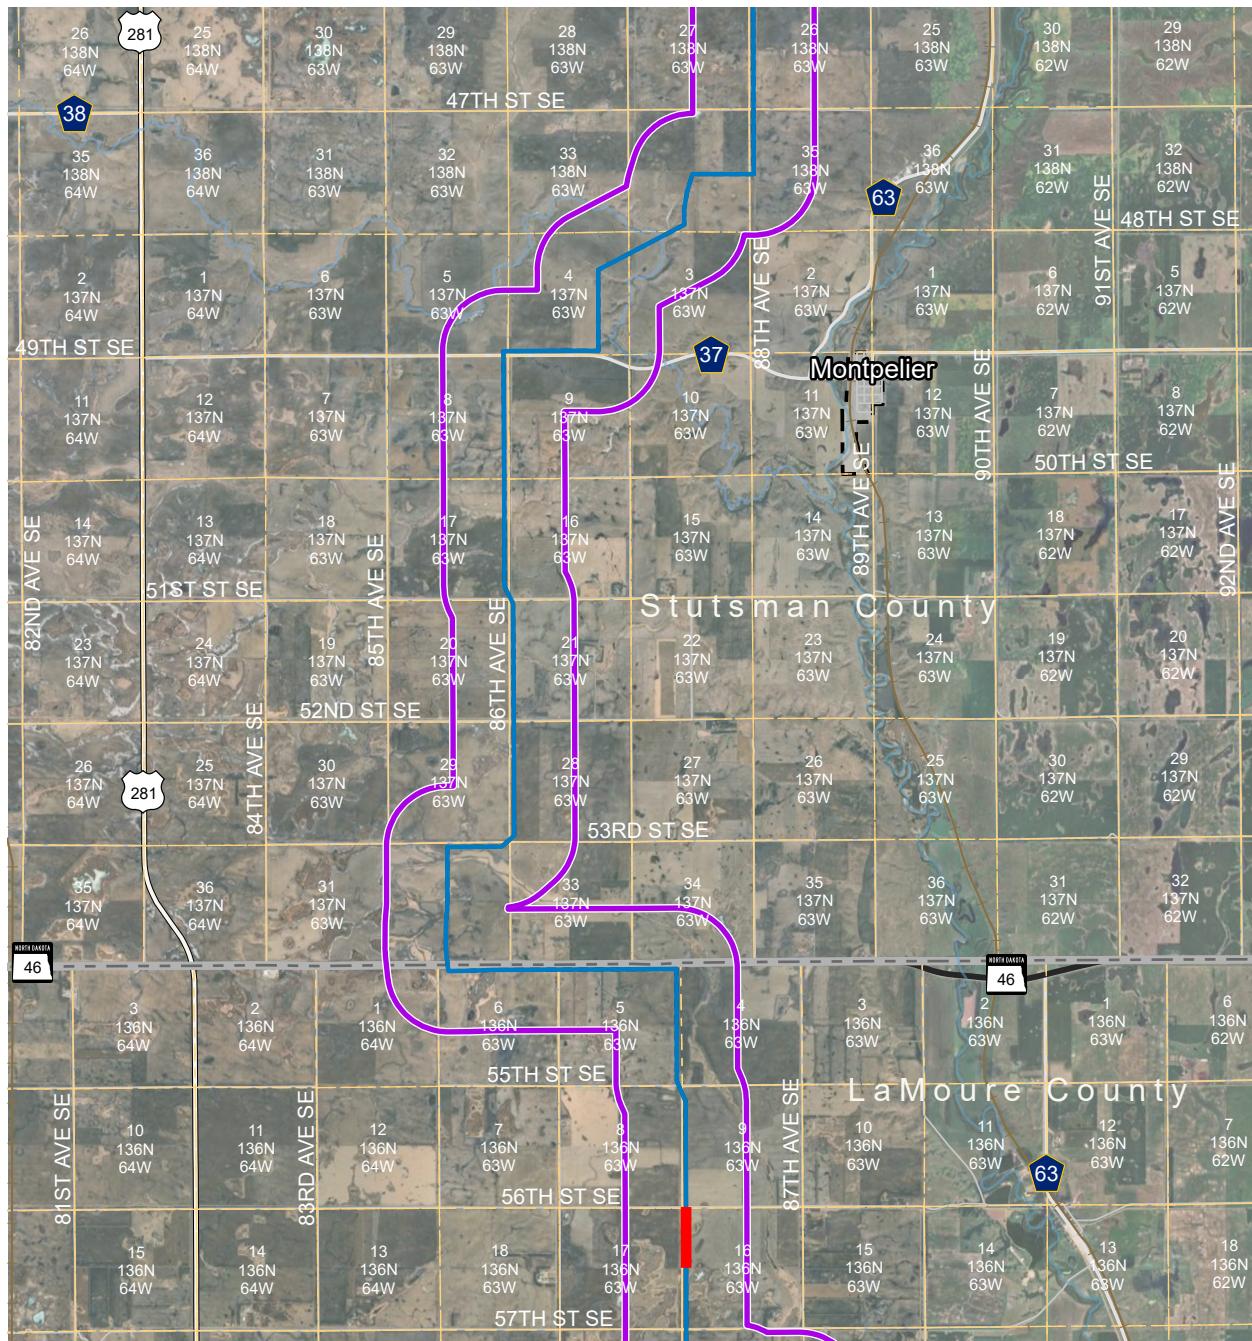


**Remaining Class III
Cultural Resource Survey Areas**

Figure 6.7-1



JETx
Jamestown to Ellendale

- Remaining Class III Cultural Resource Survey Areas
- - - Updated Route
- Route as Filed (August 2025)
- Study Area
- PLSS Sections

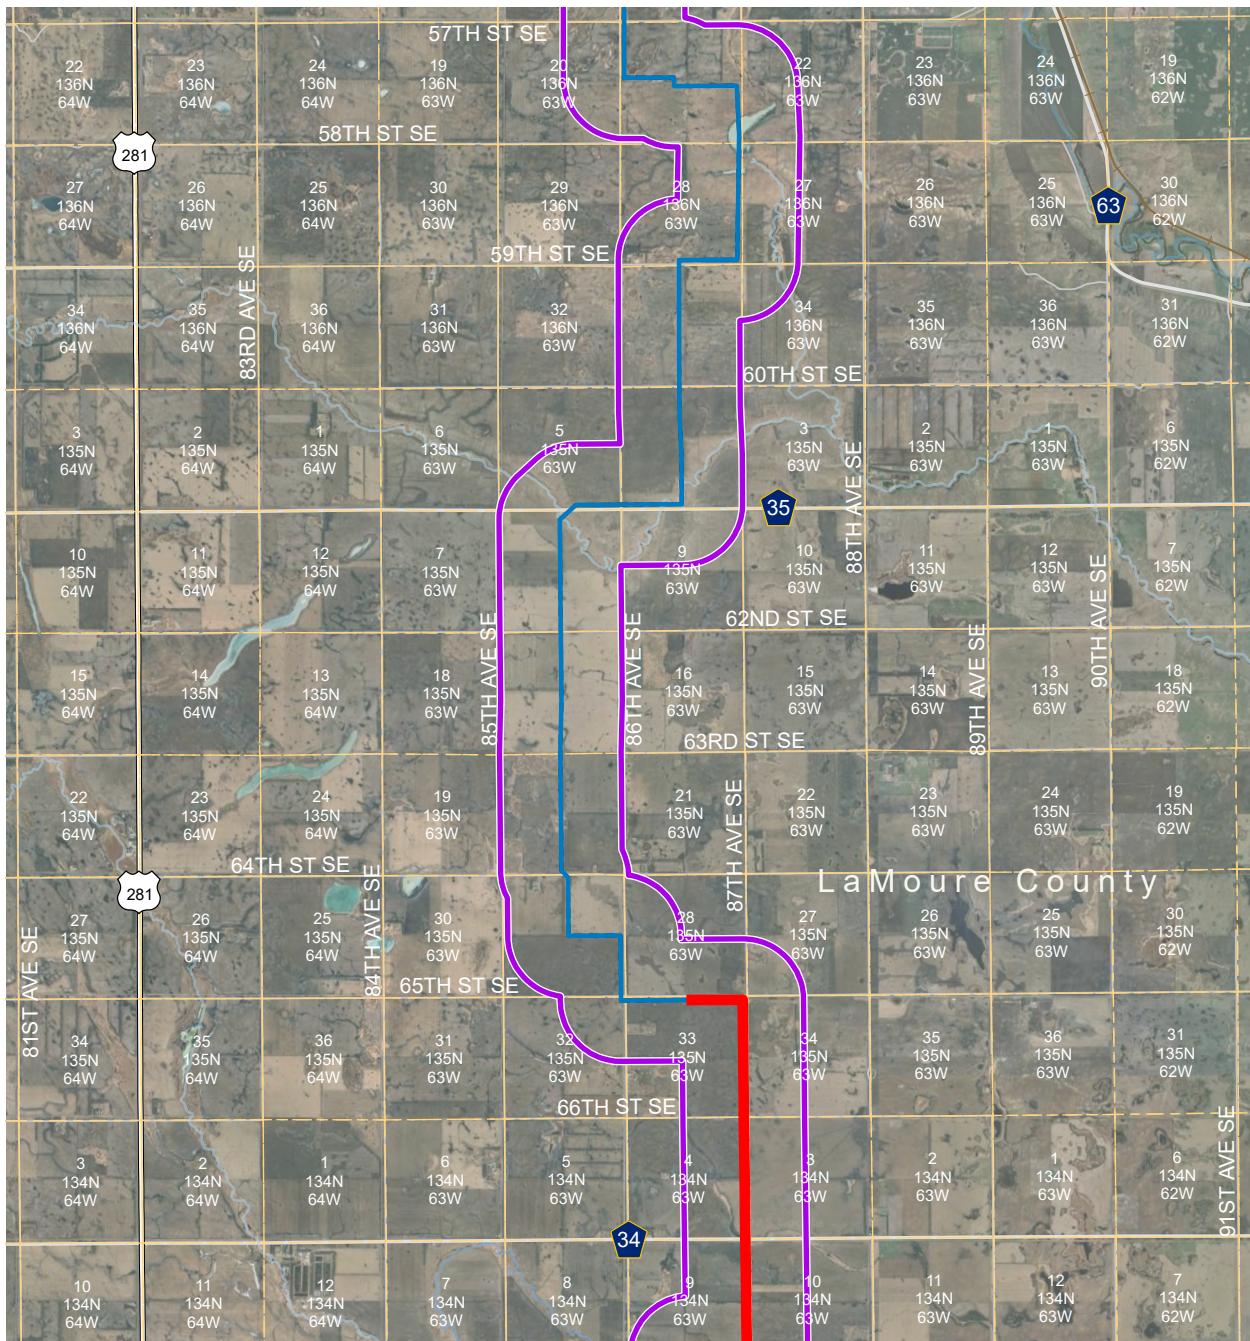


JETx
Jamestown to Ellendale

**Remaining Class III
Cultural Resource Survey Areas**
Figure 6.7-1

- Remaining Class III Cultural Resource Survey Areas
- - - Updated Route
- Route as Filed (August 2025)
- Study Area
- PLSS Sections



Updated Page 4 of 7

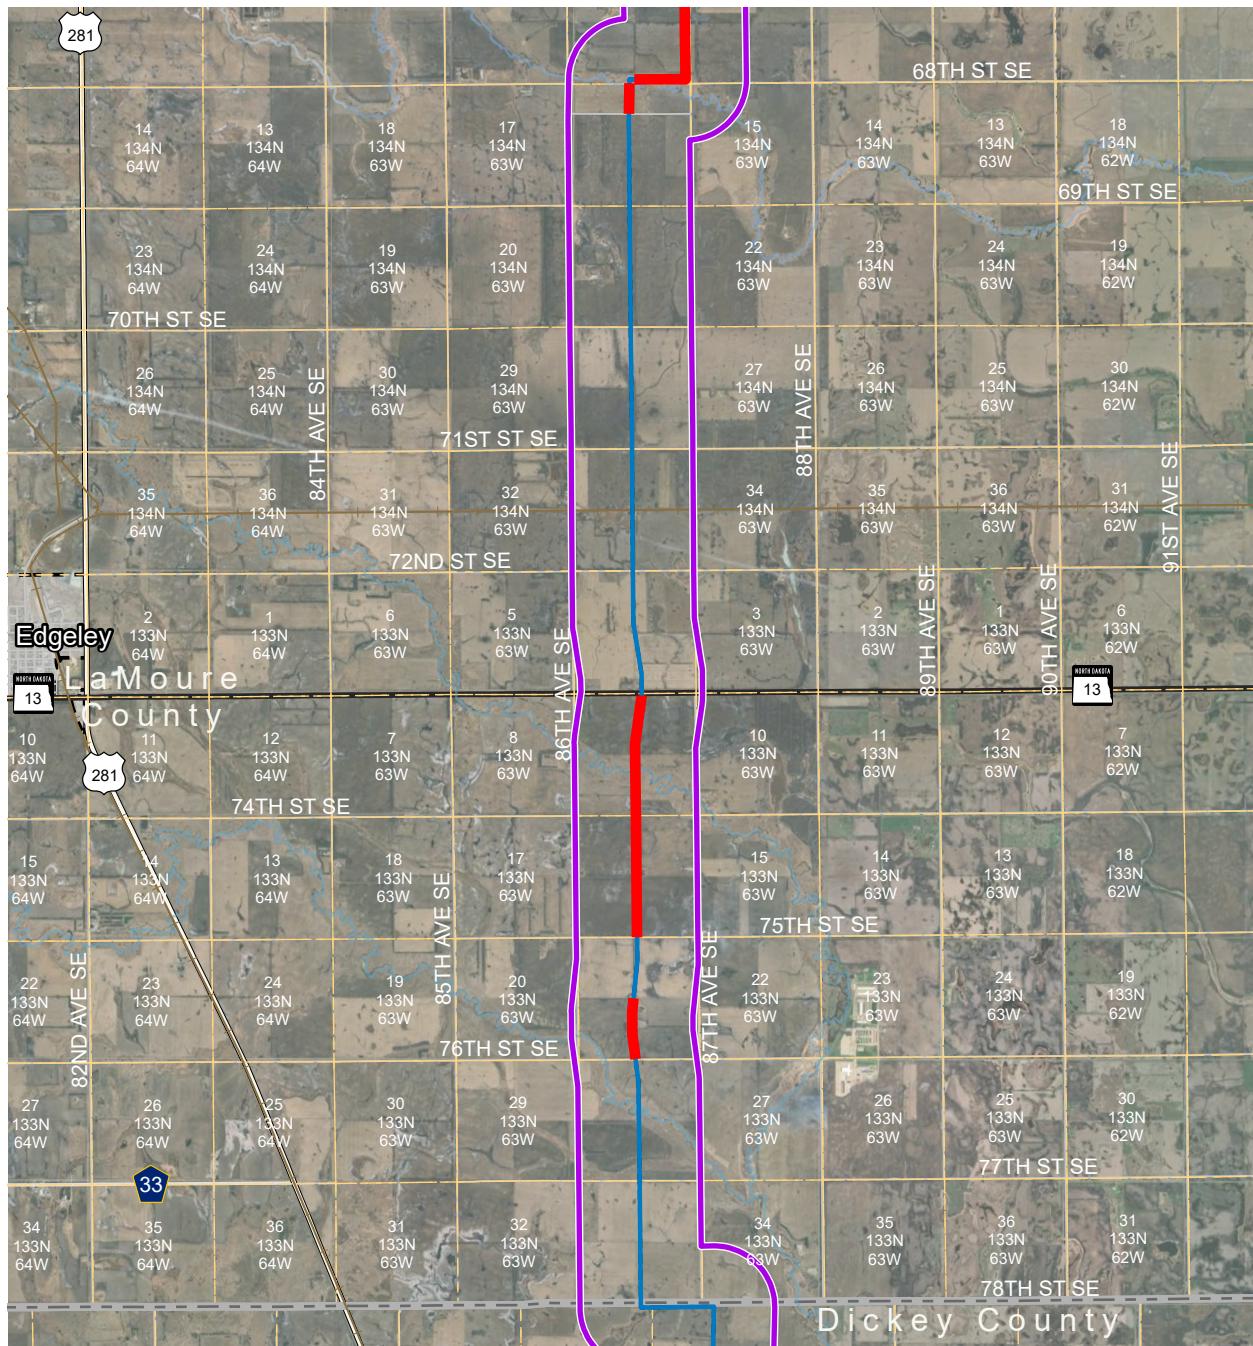

**Remaining Class III
Cultural Resource Survey Areas**


Figure 6.7-1



JETx
Jamestown to Ellendale

- Remaining Class III Cultural Resource Survey Areas
- - - Updated Route
- Route as Filed (August 2025)
- Study Area
- PLSS Sections

Updated Page 5 of 7

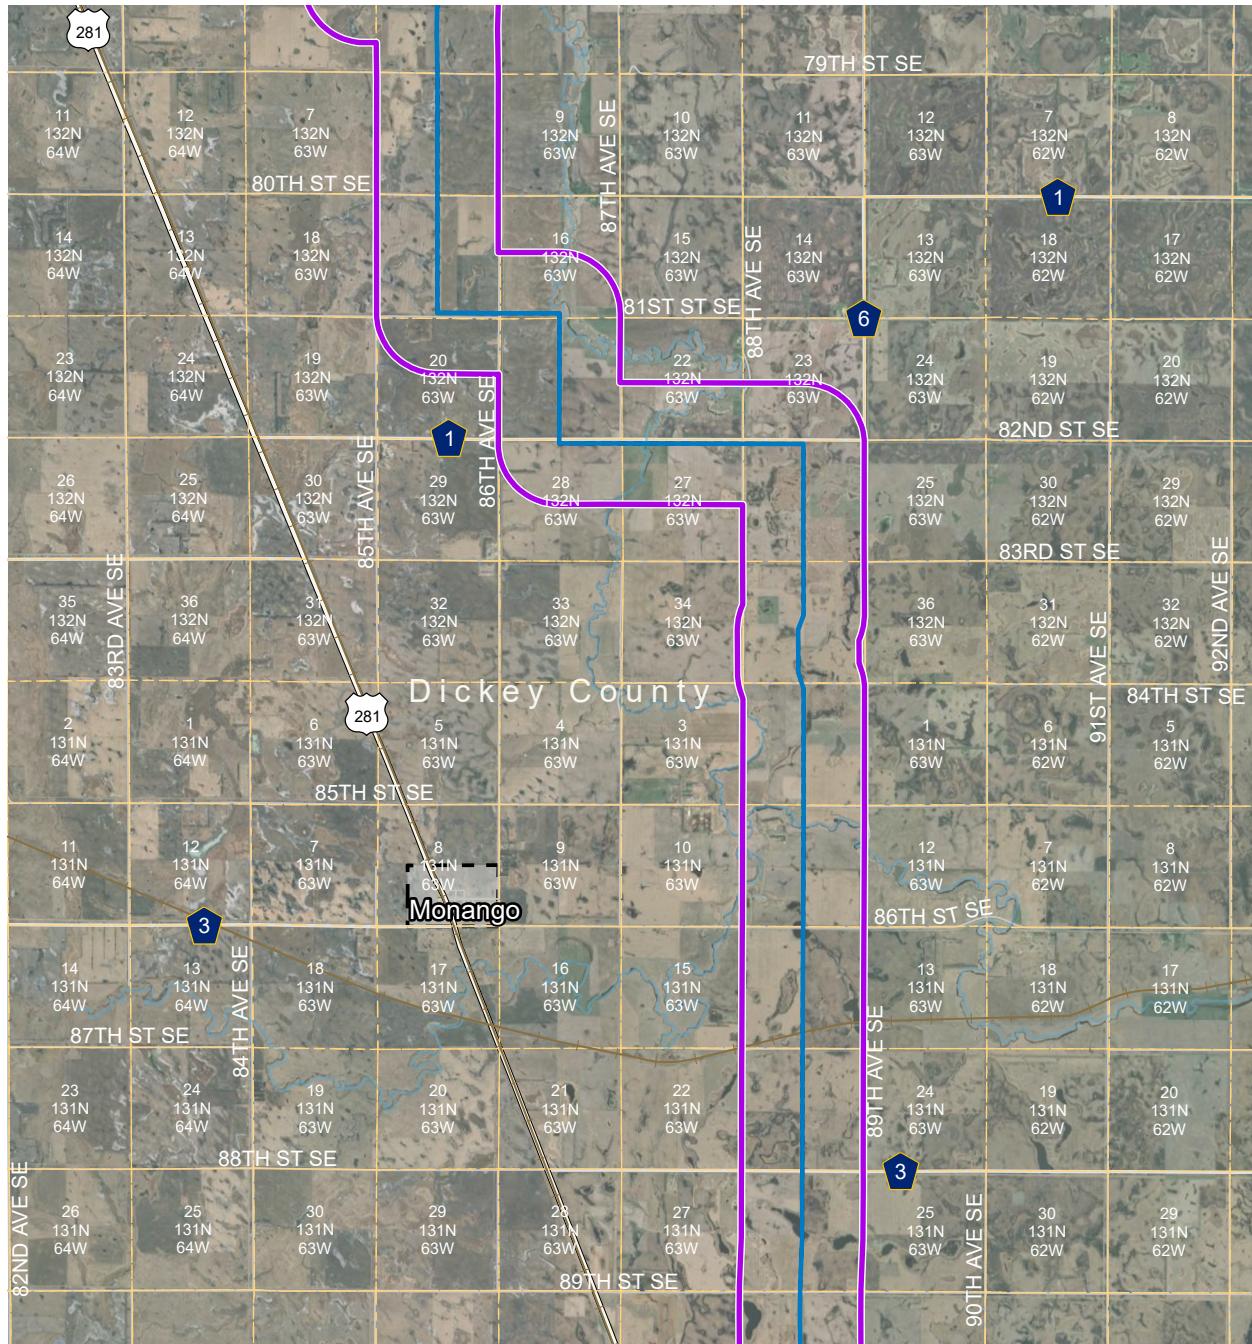


JETx
Jamestown to Ellendale



Remaining Class III Cultural Resource Survey Areas

Figure 6.7-1

- Remaining Class III Cultural Resource Survey Areas
- Updated Route
- Route as Filed (August 2025)
- Study Area
- PLSS Sections

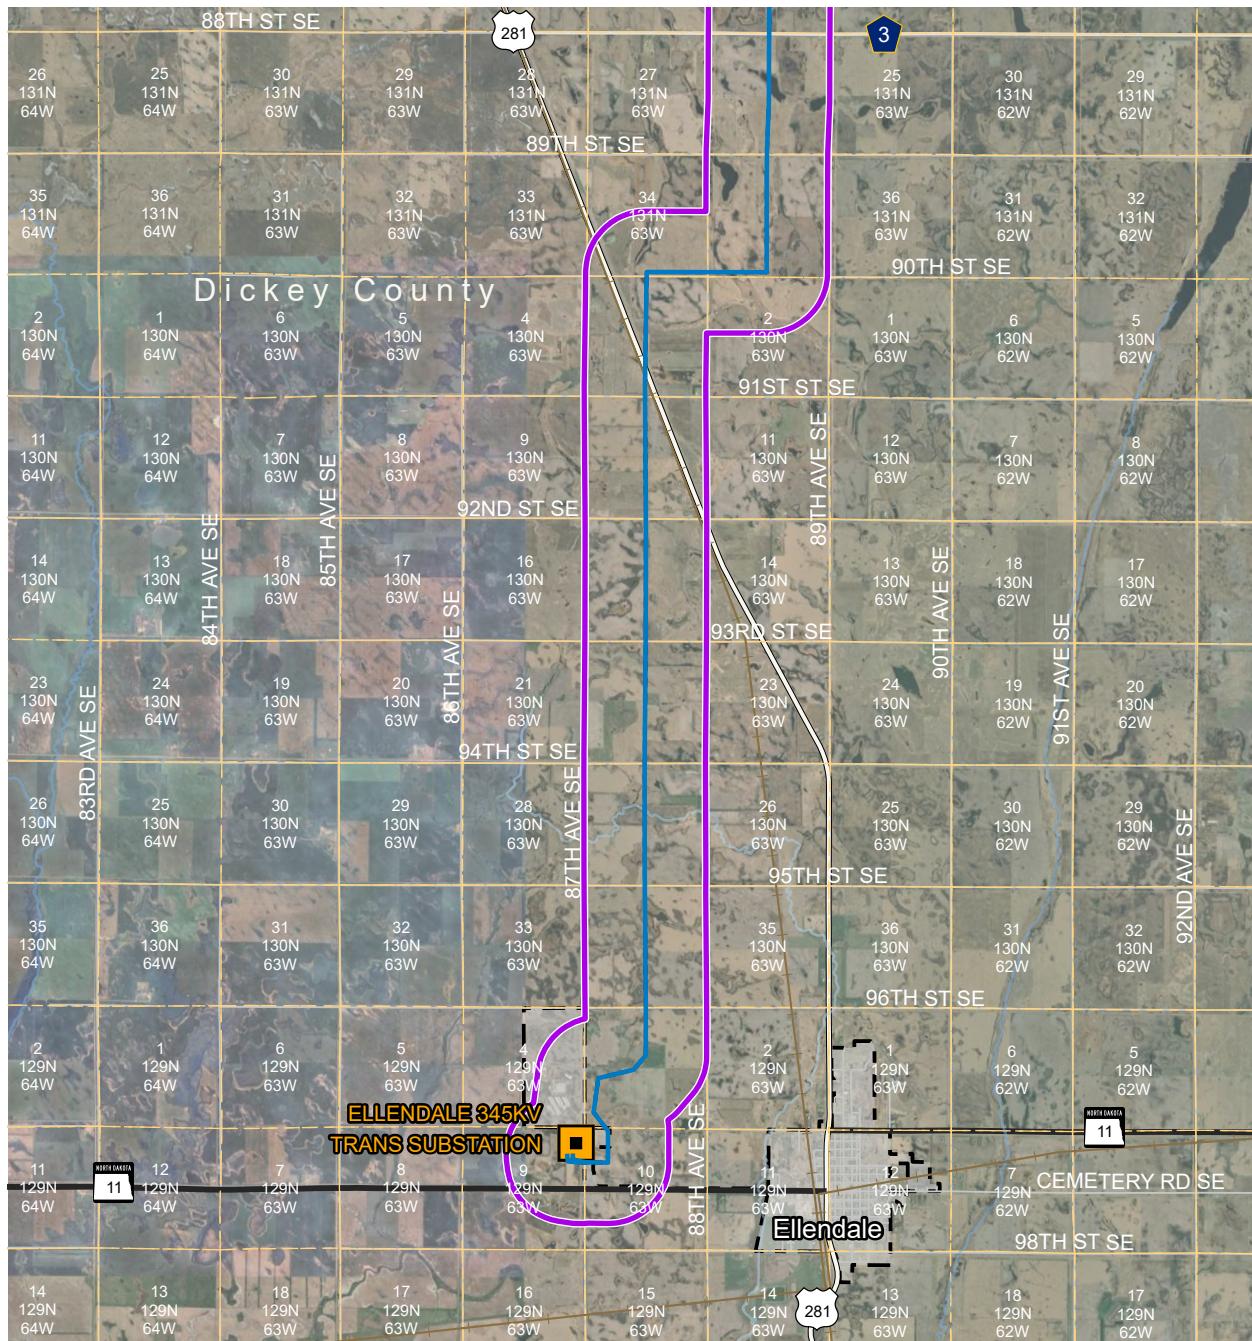

JETx
Innovations to Efficiently

- Remaining Class III Cultural Resource Survey Areas
- Updated Route
- Route as Filed (August 2025)
- Project Substations
- Study Area
- PLSS Sections

Page 7 of 7

Remaining Class III Cultural Resource Survey Areas

Figure 6.7-1

0 1.5 Miles