


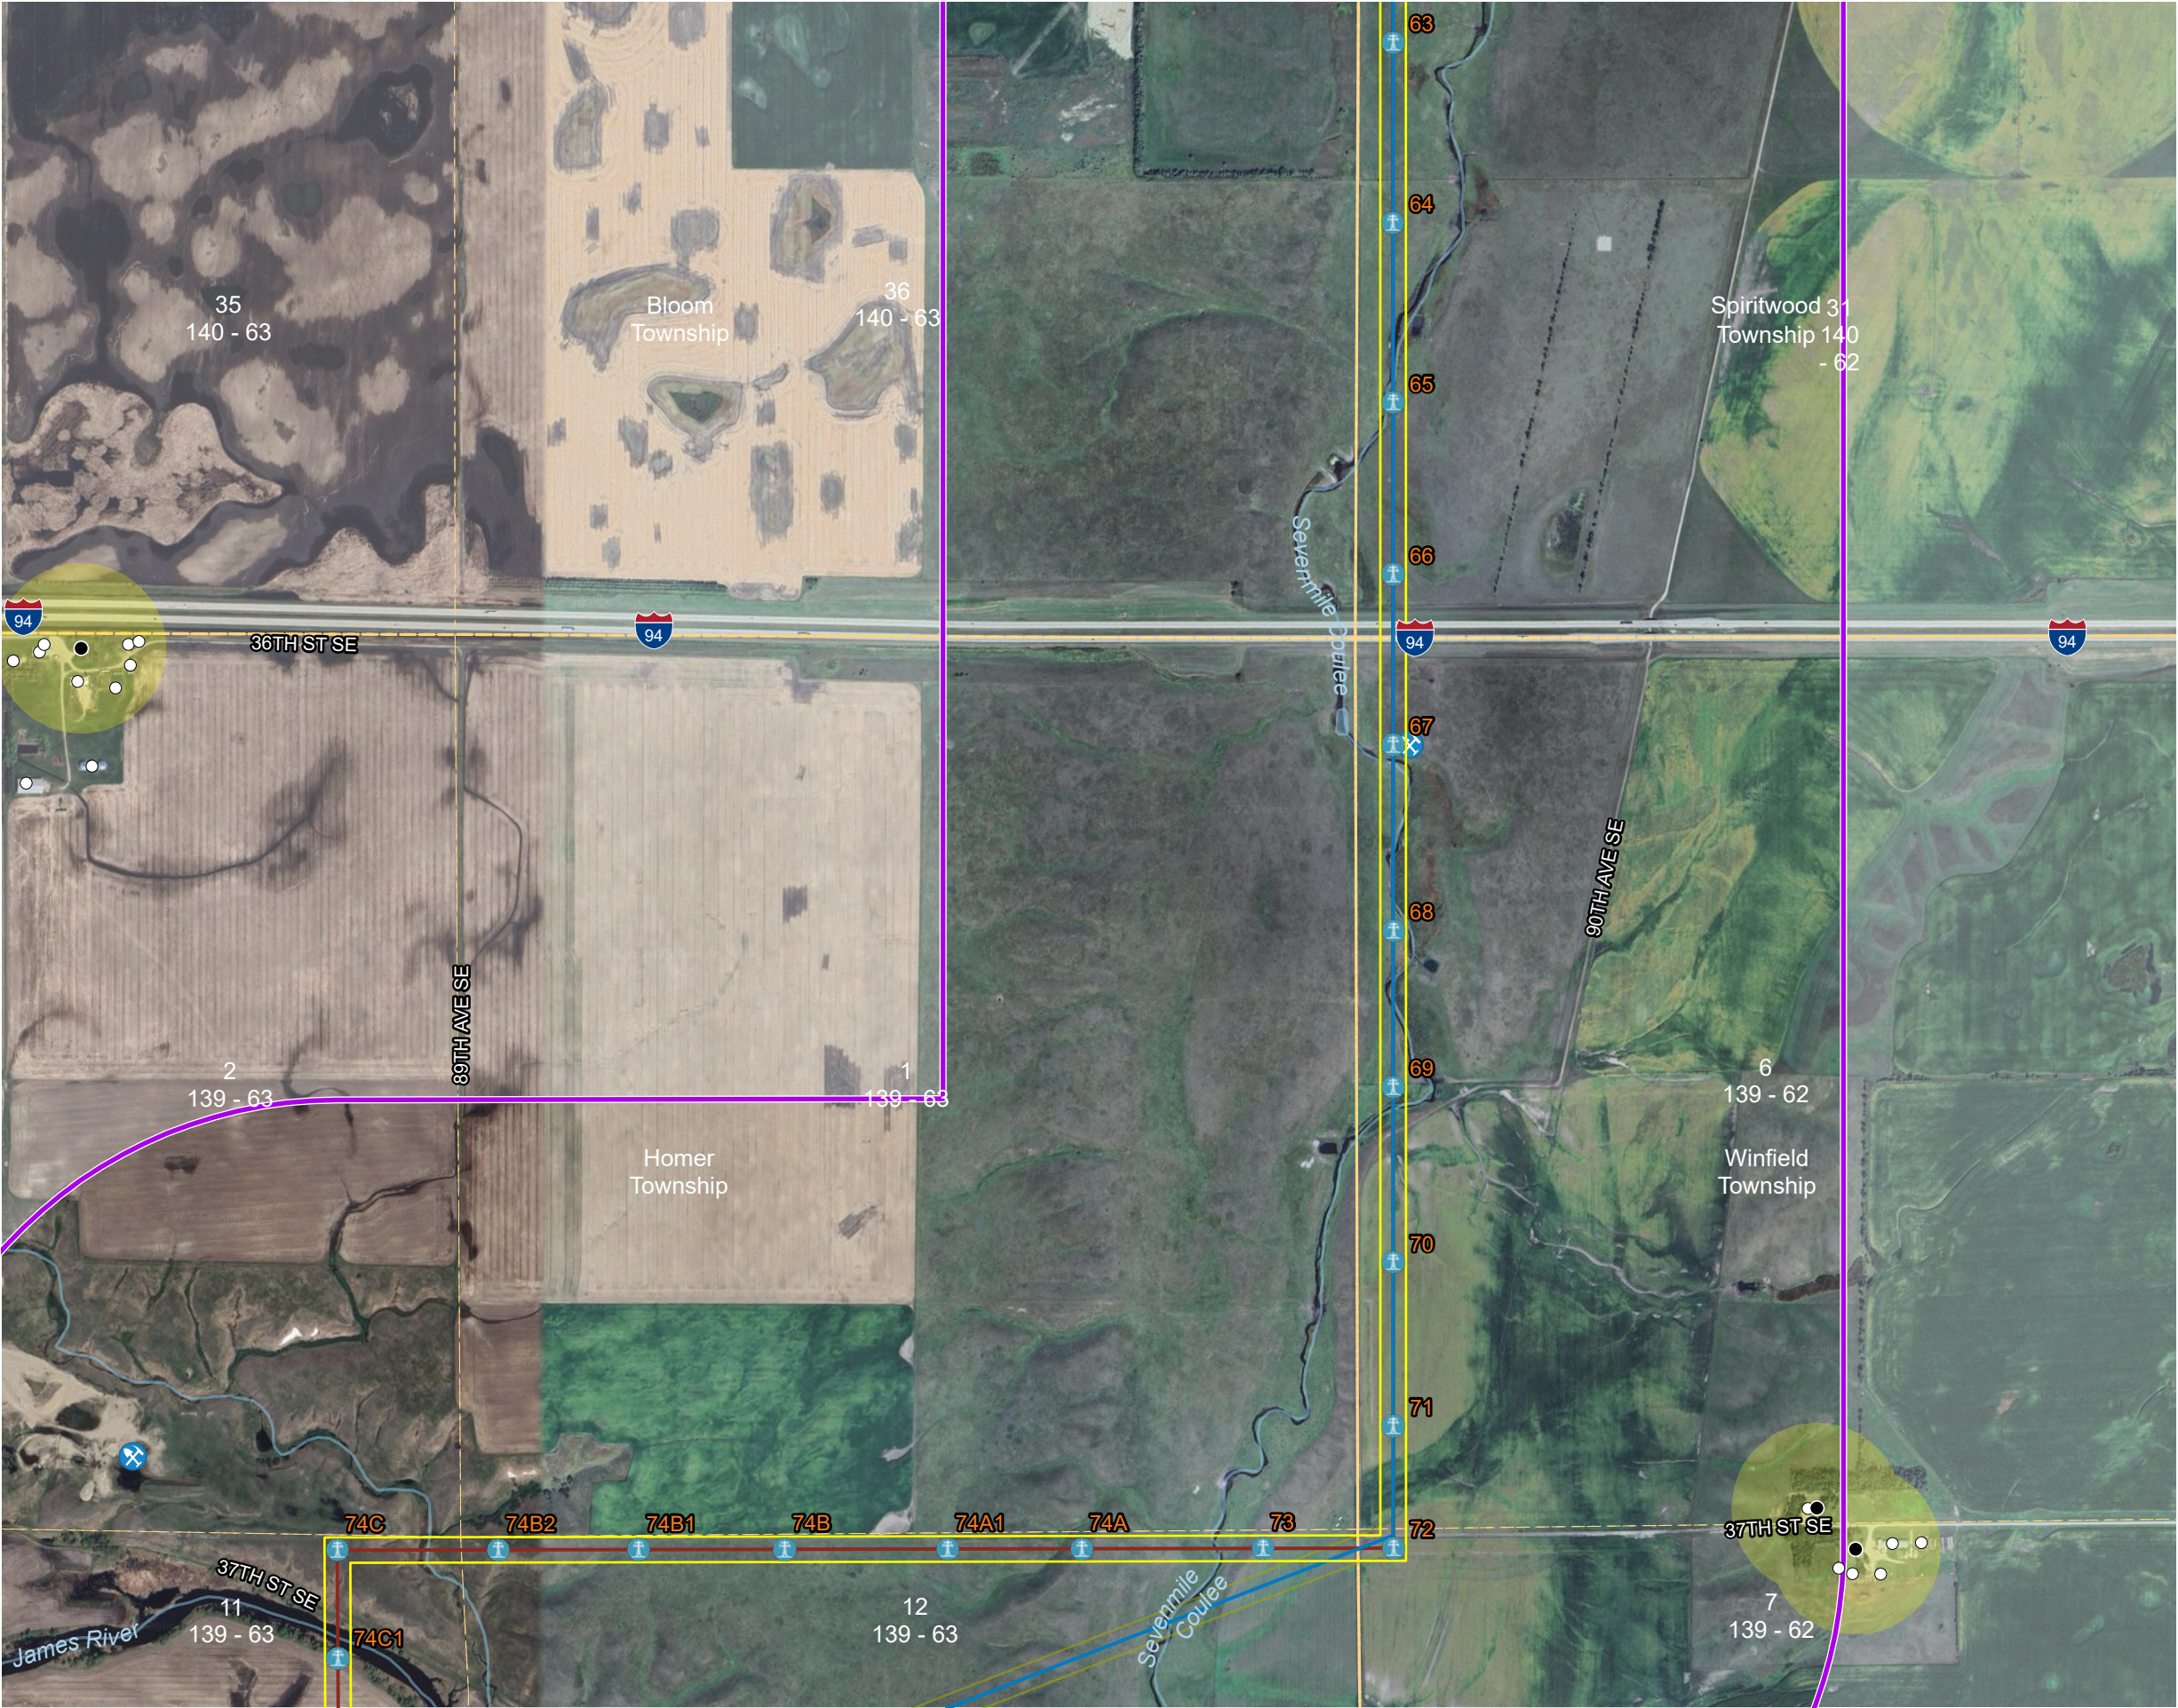

Project Site Details


Figure 1.2-2


- Updated Route
- Route
- Updated Corridor
- Corridor
- Study Area
- National Hydrography Dataset (NHD)
- Occupied Residence
- Building/Unoccupied
- Aggregate Sand and Gravel Pit
- County Boundaries
- PLSS Townships
- PLSS Sections

Exclusion and Avoidance Areas

- 500' Home Buffer

0 2,000 Feet
Scale: 1:12,000

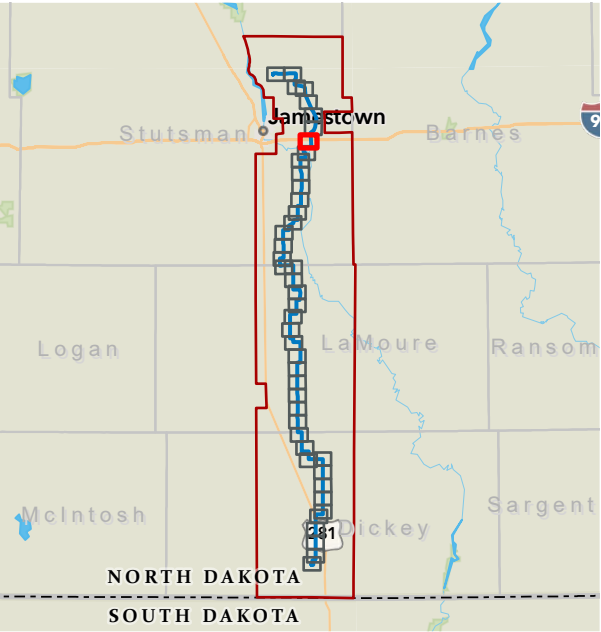

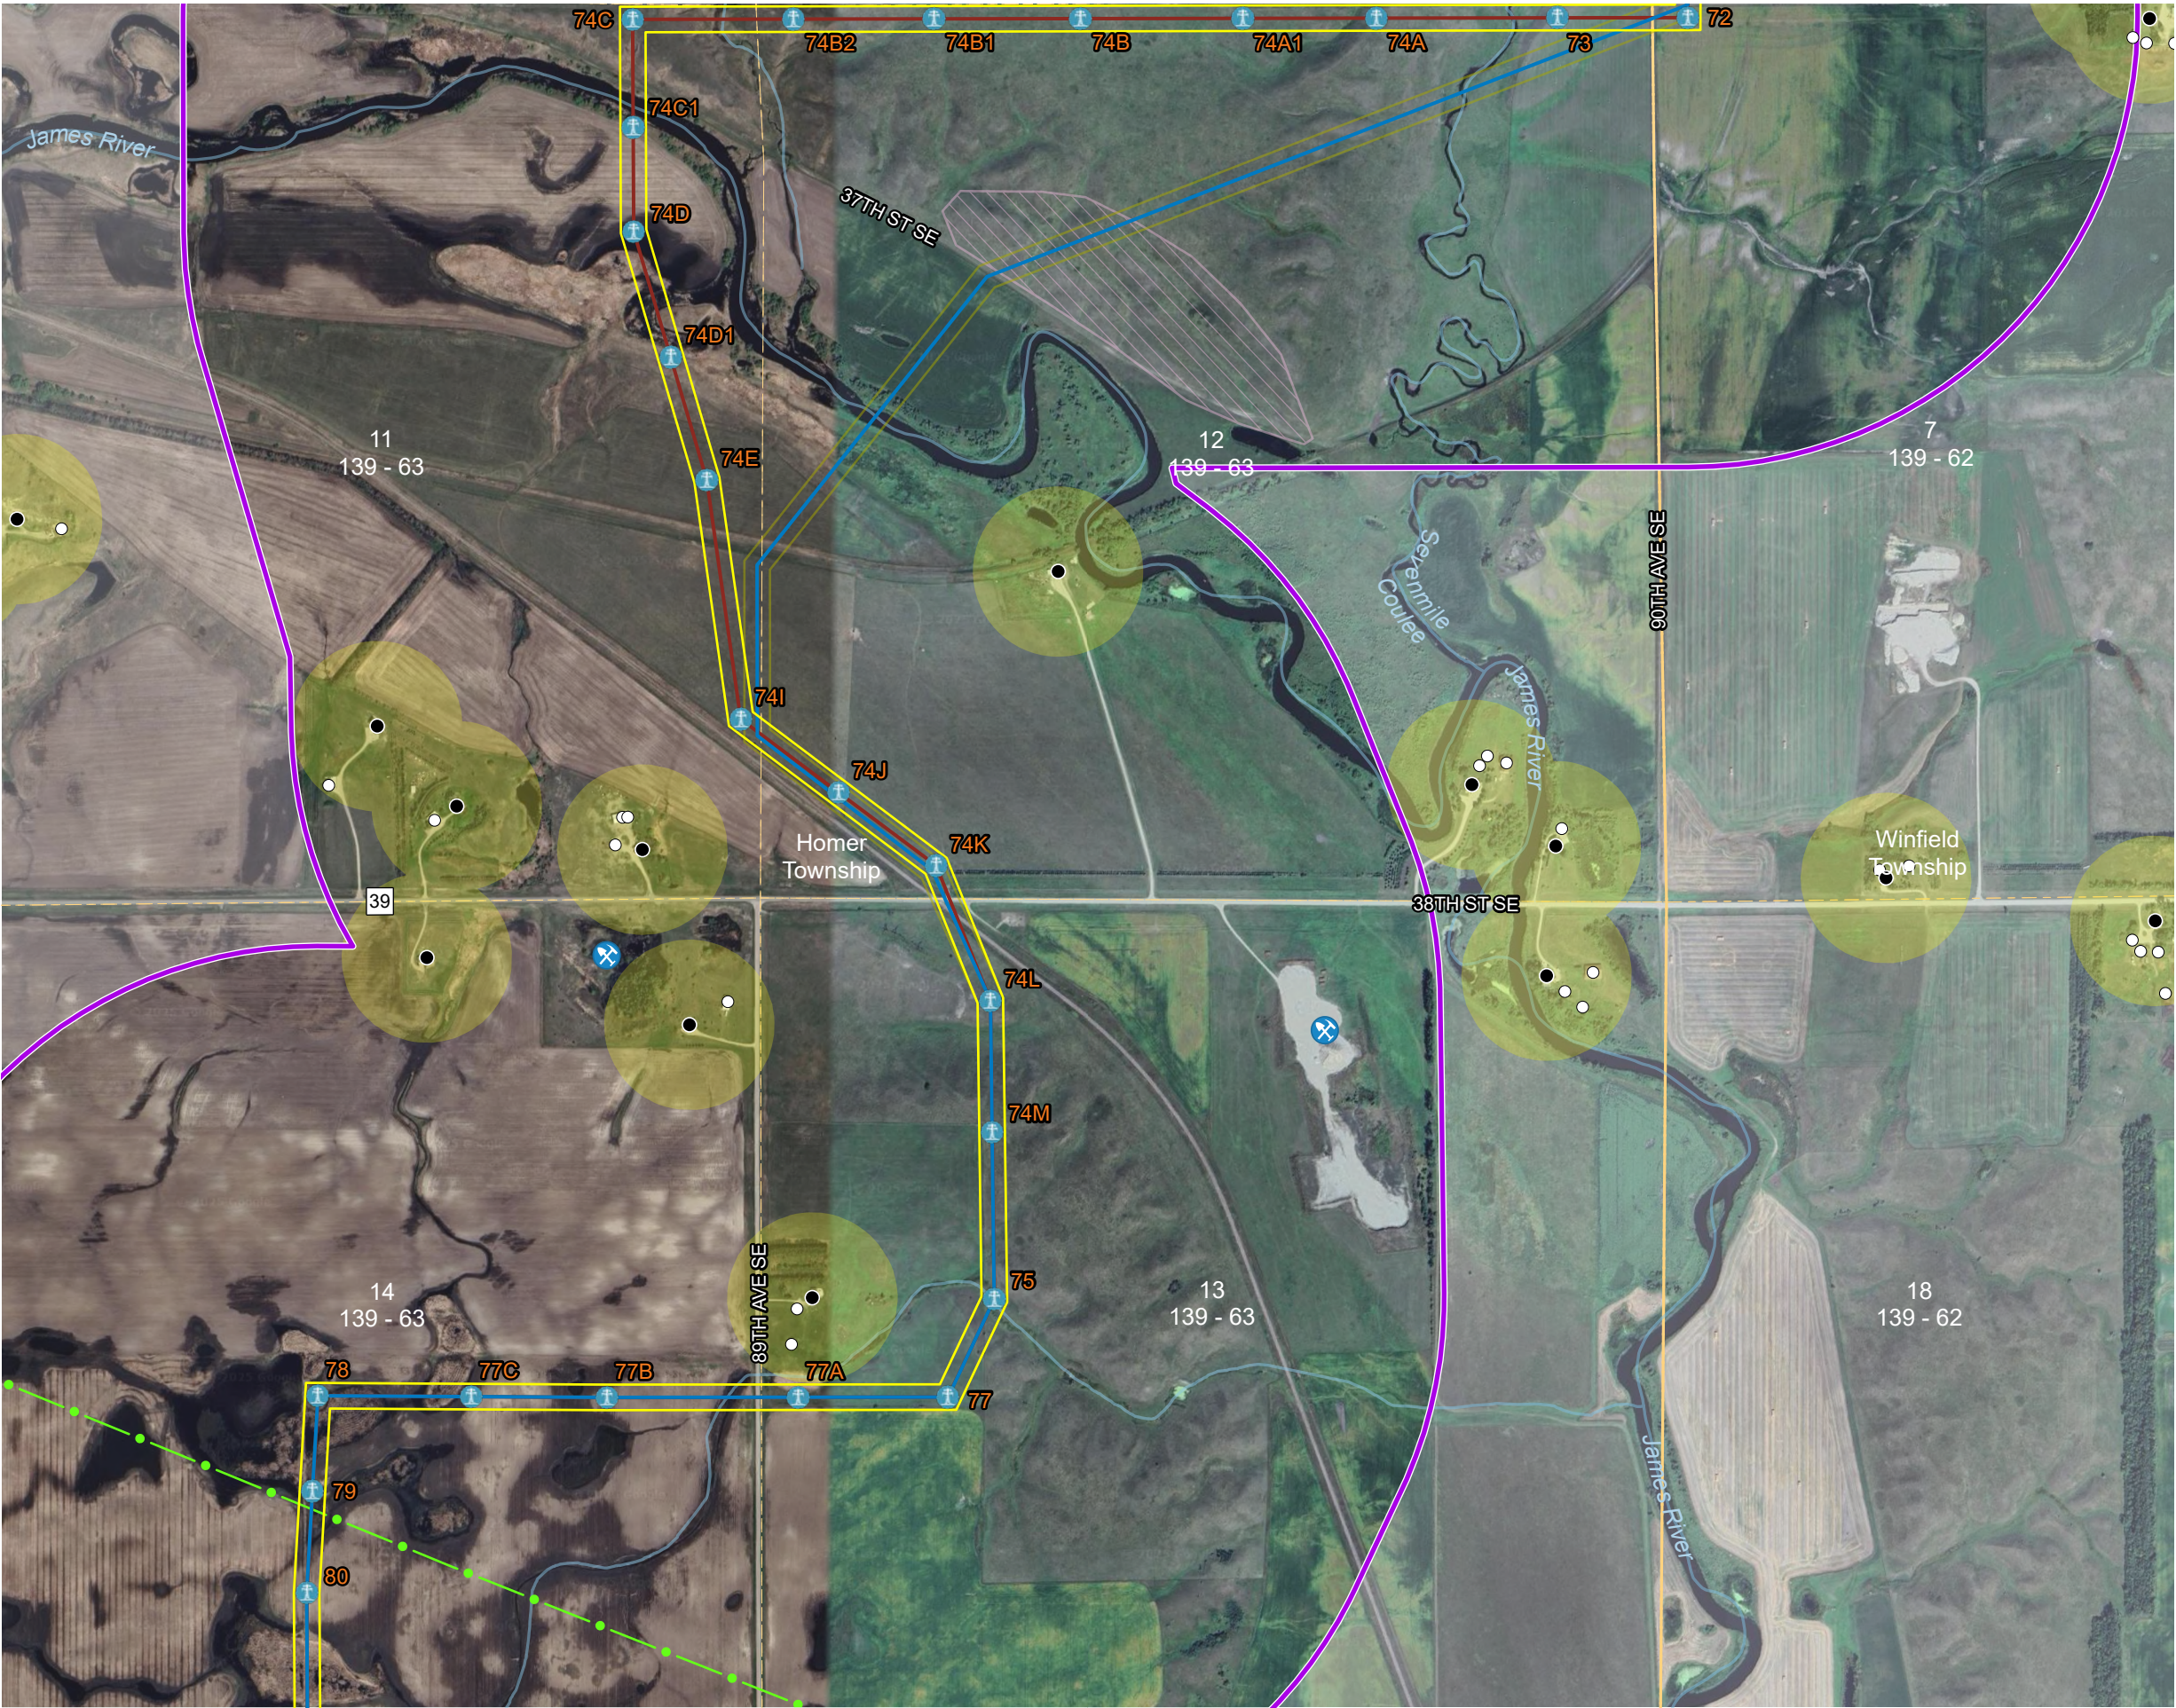

Project Site Details

Figure 1.2-2

- Updated Route
- Route
- Updated Corridor
- Corridor
- Study Area
- National Hydrography Dataset (NHD)
- Occupied Residence
- Building/Unoccupied
- Existing High Voltage Transmission Line (HVTL)
- Aggregate Sand and Gravel Pit
- County Boundaries
- PLSS Townships
- PLSS Sections
- Exclusion and Avoidance Areas
 - 500' Home Buffer
 - Historic Landslide Deposits

