



- Remaining Class III Cultural Resource Survey Areas
- Updated Route
- Route as Filed (August 2025)
- Project Substations
- Study Area
- PLSS Sections

**Remaining Class III  
Cultural Resource Survey Areas  
Figure 6.7-1**


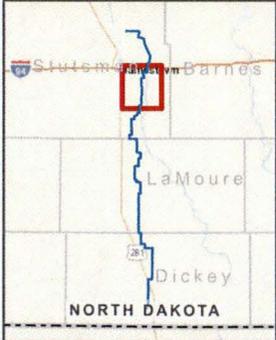


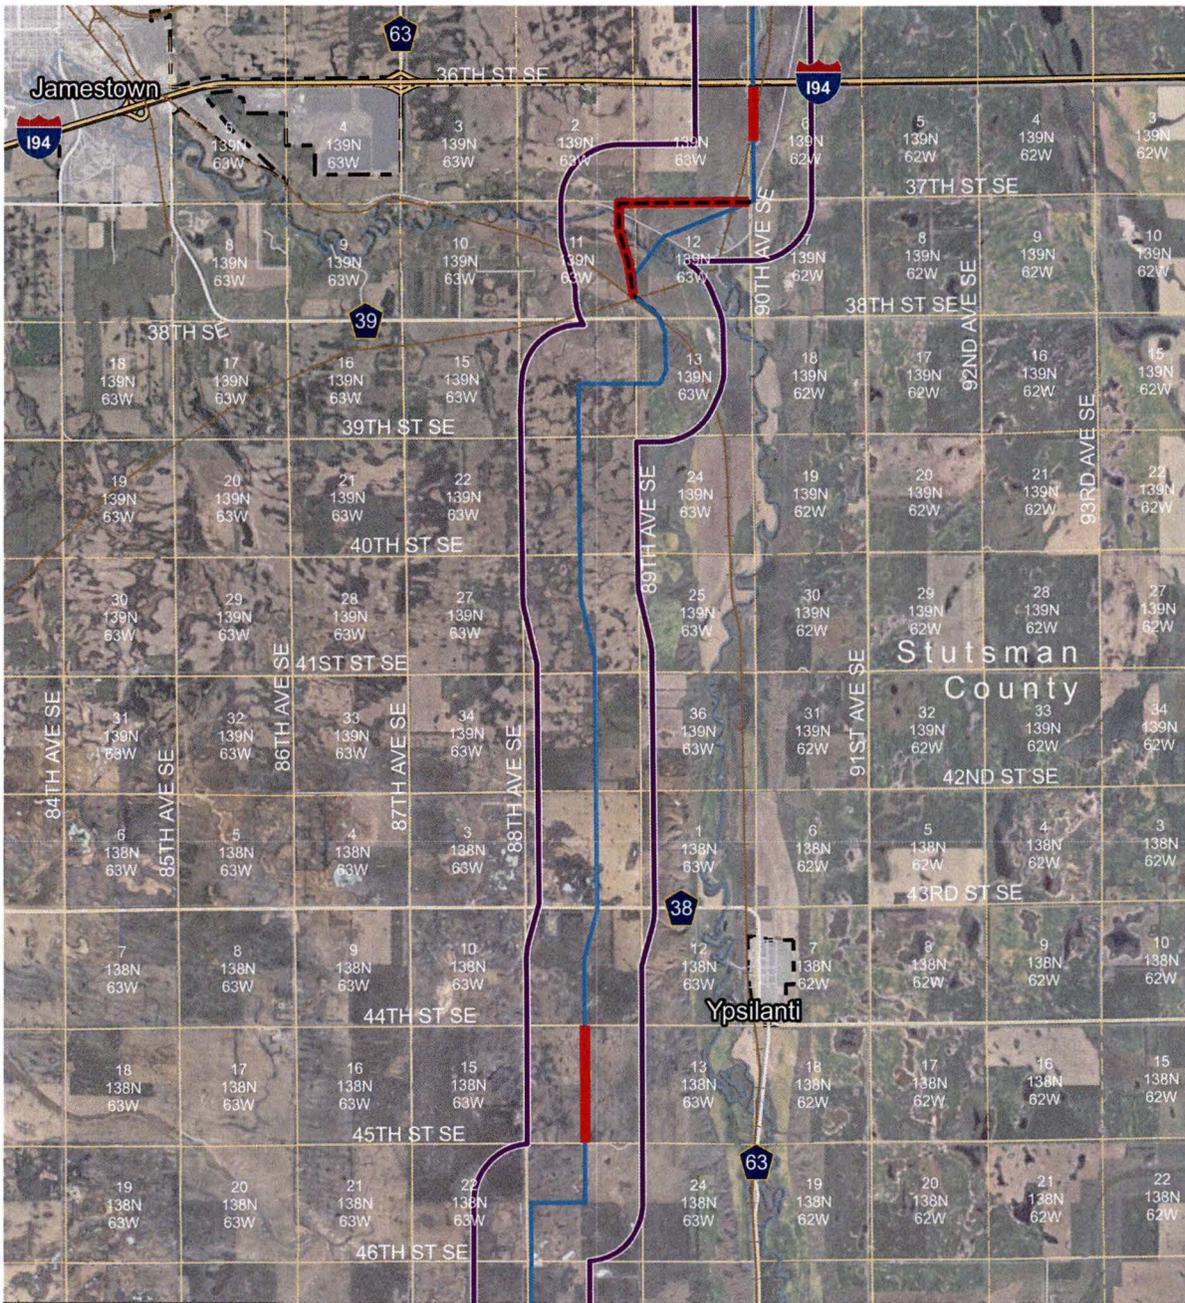

- Remaining Class III Cultural Resource Survey Areas
- Updated Route
- Route as Filed (August 2025)
- Study Area
- PLSS Sections

**Remaining Class III Cultural Resource Survey Areas**  
Figure 6.7-1




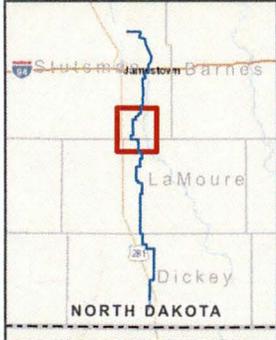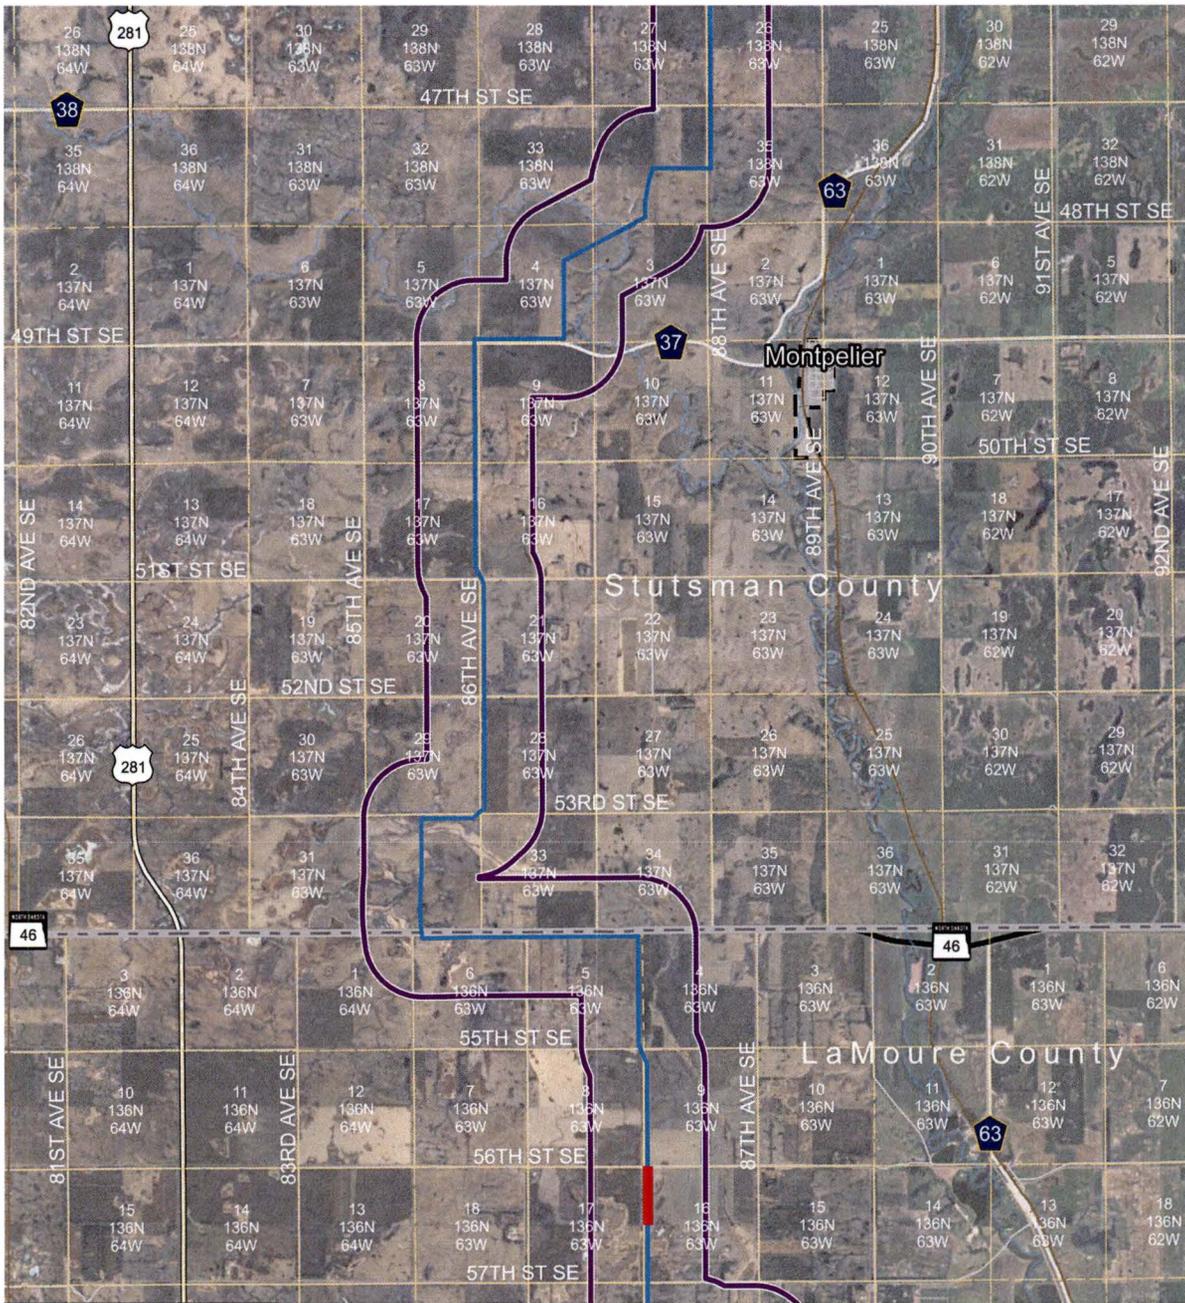

- Remaining Class III Cultural Resource Survey Areas
- Updated Route
- Route as Filed (August 2025)
- Study Area
- PLSS Sections

**Remaining Class III Cultural Resource Survey Areas**  
Figure 6.7-1



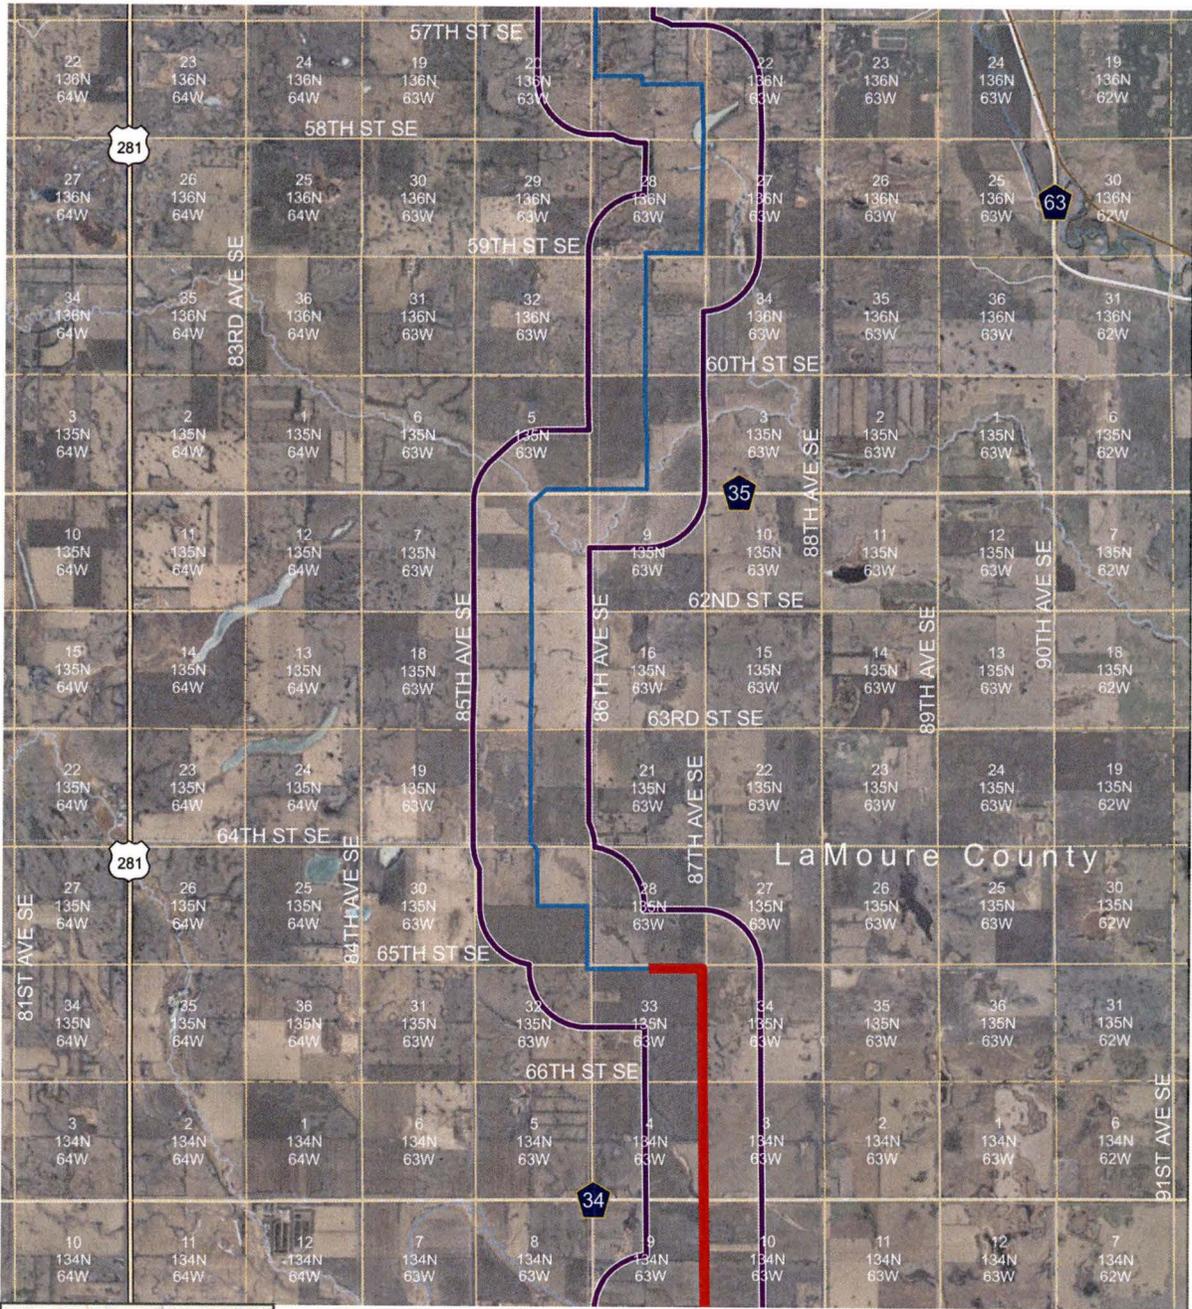


- █ Remaining Class III Cultural Resource Survey Areas
- - - Updated Route
- Route as Filed (August 2025)
- Study Area
- PLSS Sections

**Updated** Page 4 of 7

**Remaining Class III Cultural Resource Survey Areas**  
Figure 6.7-1




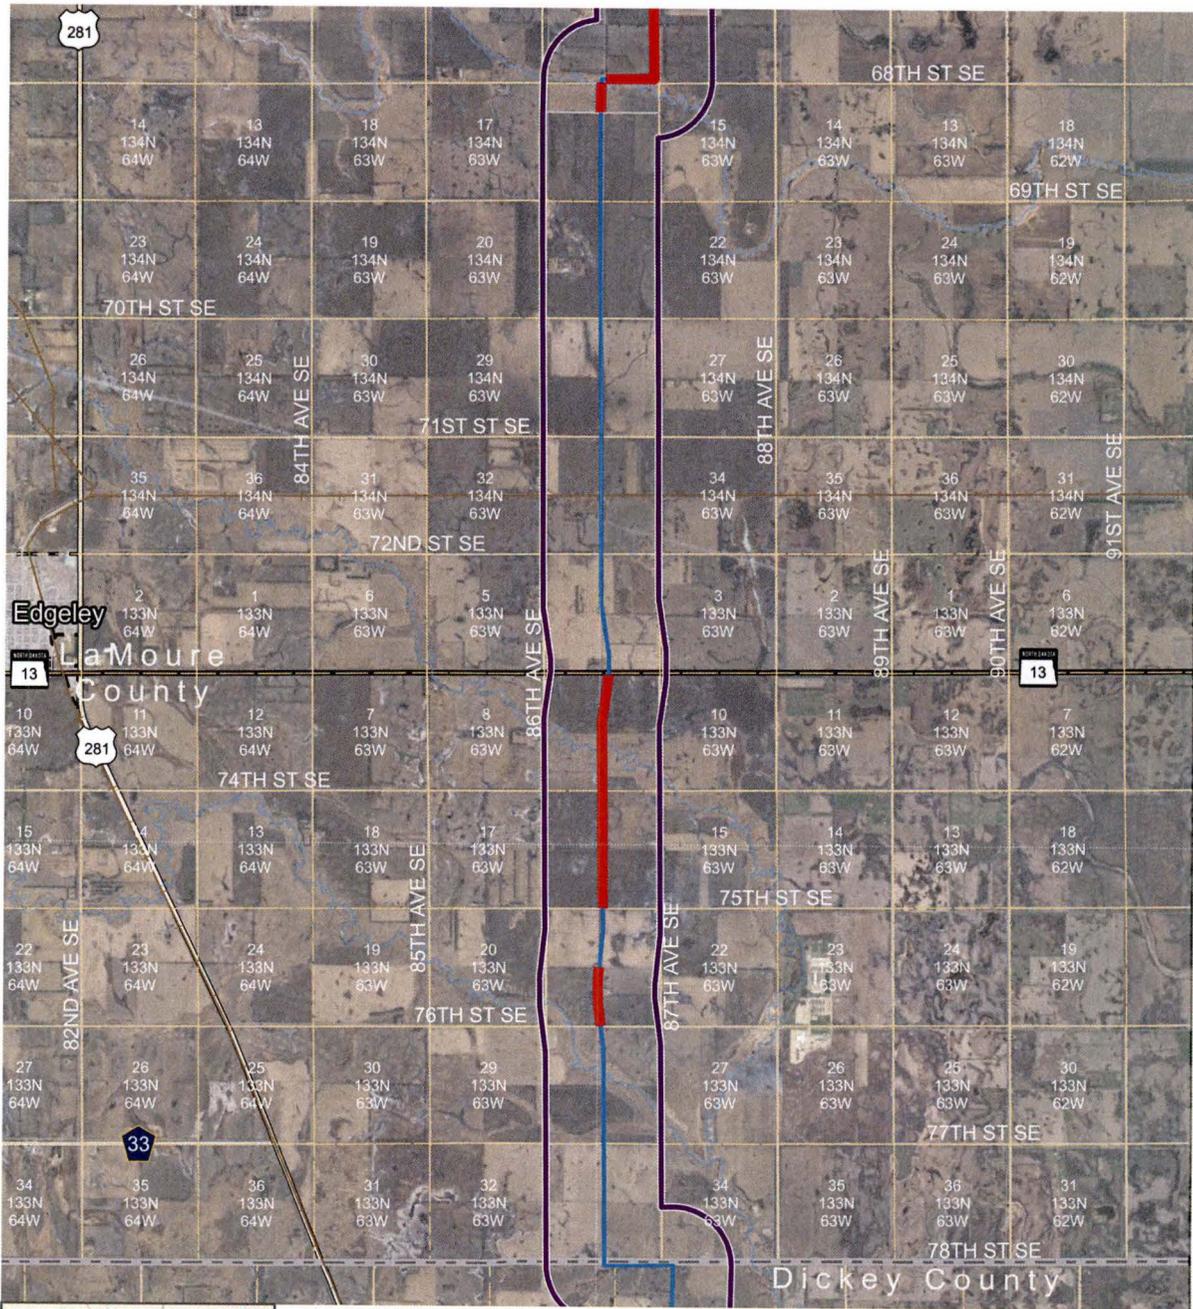


- Remaining Class III Cultural Resource Survey Areas
- - - Updated Route
- Route as Filed (August 2025)
- Study Area
- PLSS Sections

**Updated** Page 5 of 7


**Remaining Class III Cultural Resource Survey Areas**  
Figure 6.7-1




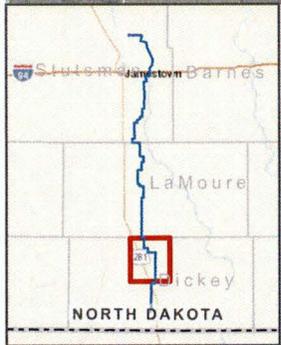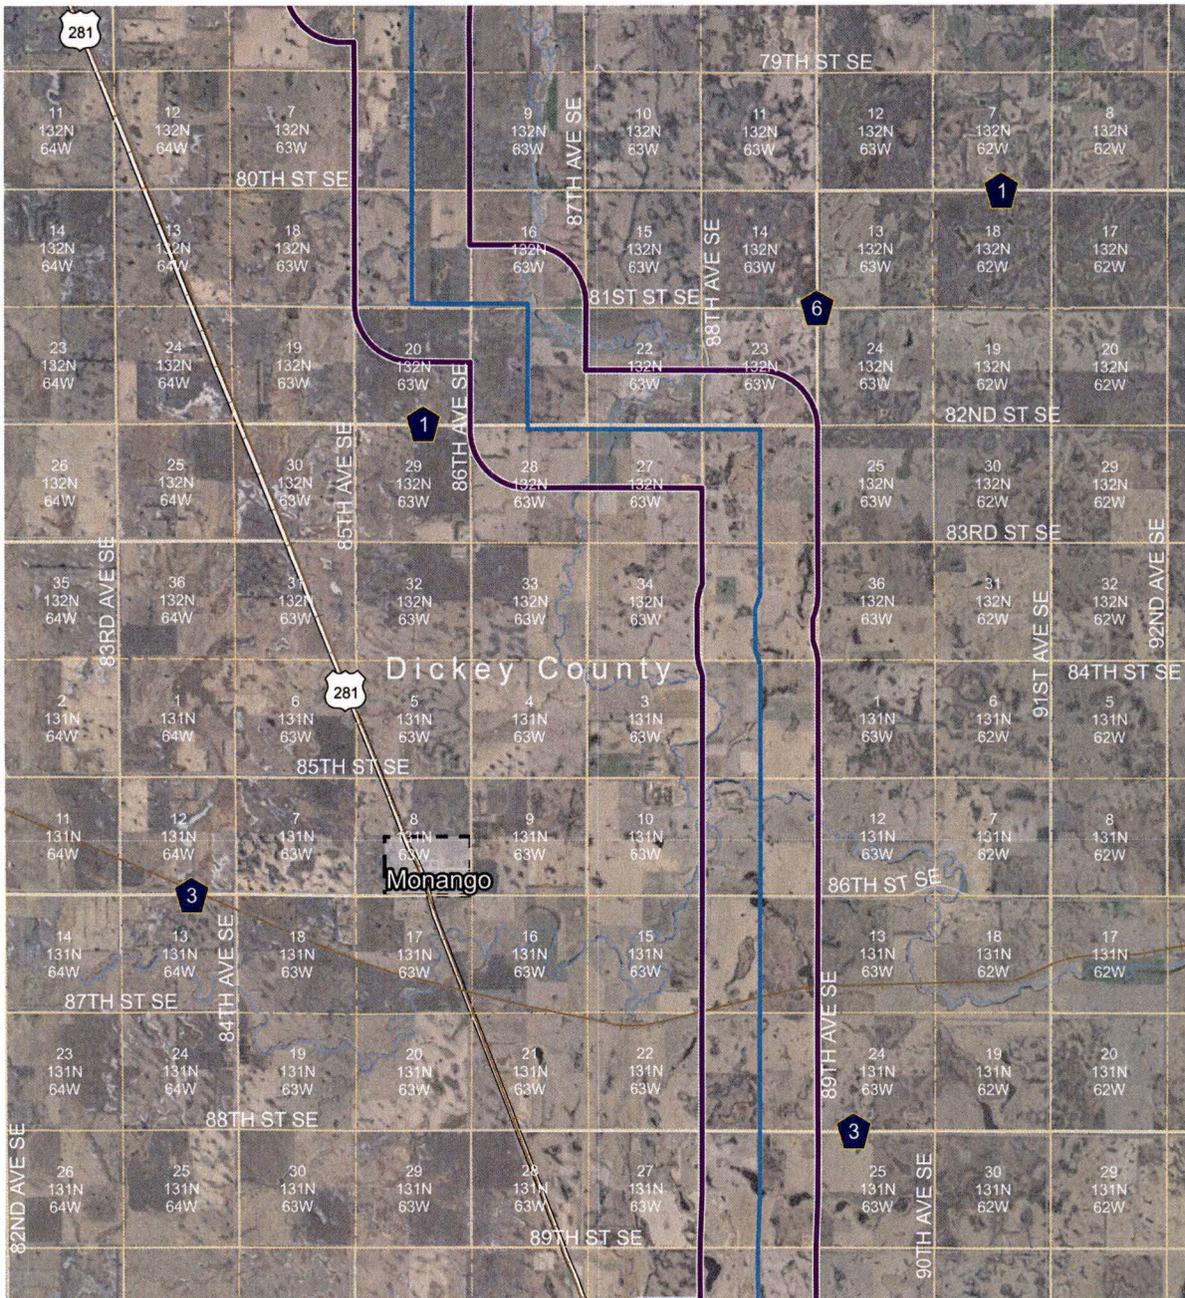

- Remaining Class III Cultural Resource Survey Areas
- Updated Route
- Route as Filed (August 2025)
- Study Area
- PLSS Sections

**Remaining Class III Cultural Resource Survey Areas**  
Figure 6.7-1

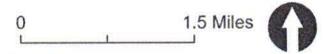

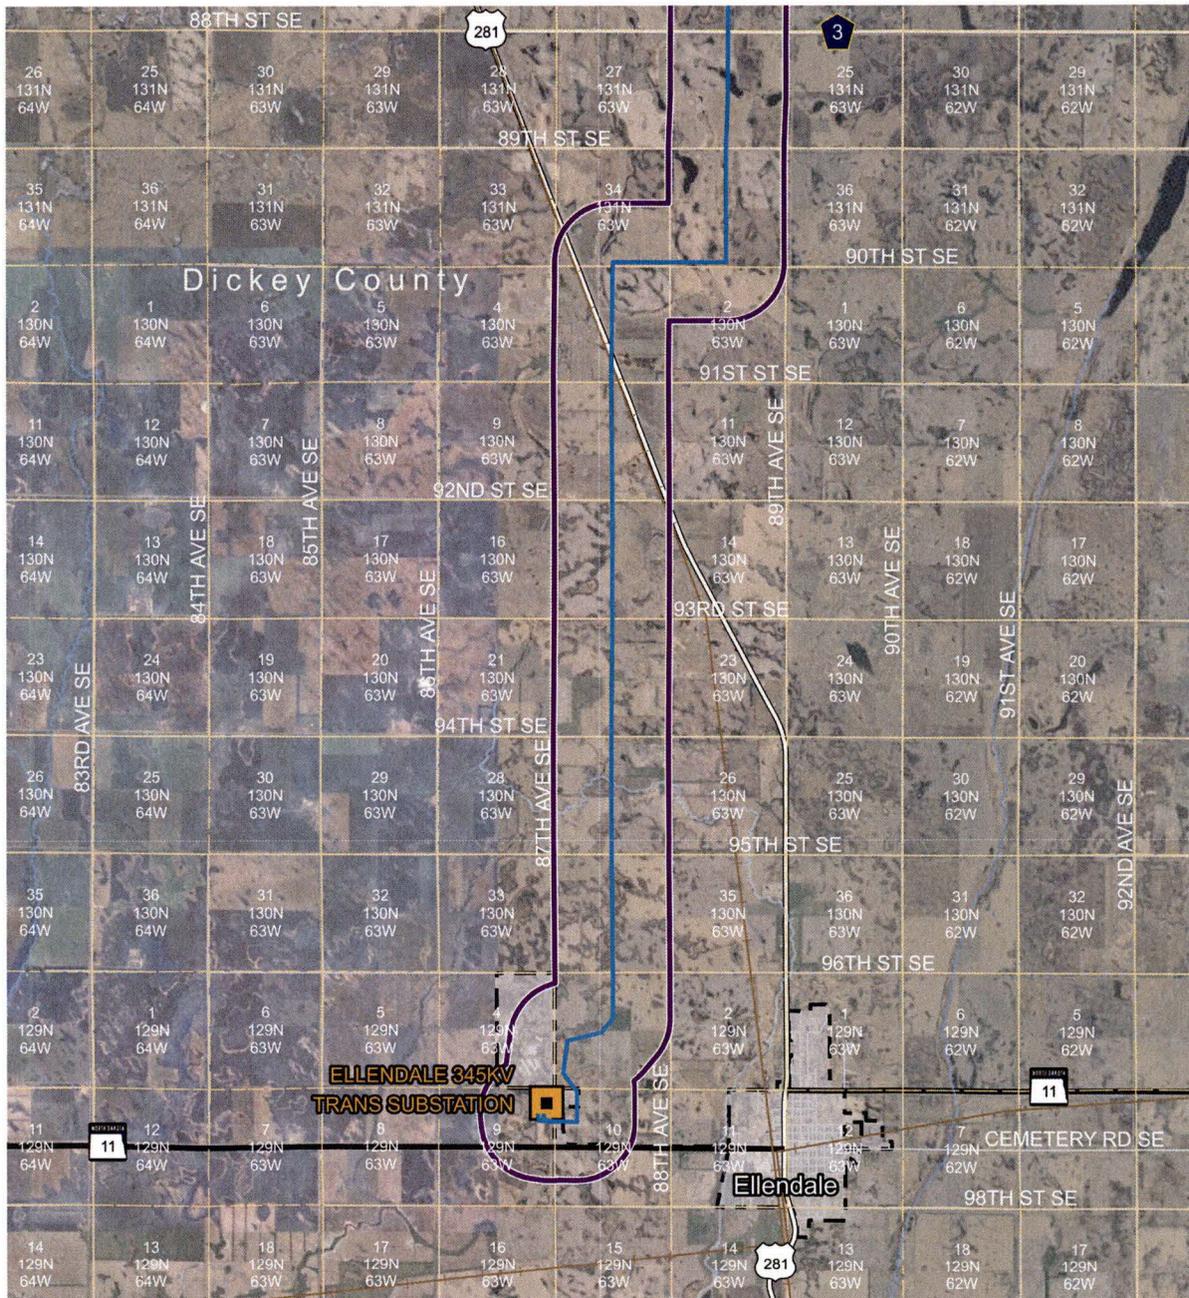

- Remaining Class III Cultural Resource Survey Areas
- - - Updated Route
- Route as Filed (August 2025)
- Project Substations
- Study Area
- PLSS Sections

**Remaining Class III Cultural Resource Survey Areas**  
**Figure 6.7-1**

