


**EXHIBIT  
12**


**Project Site Details**

Figure 1.2-2



- Updated Route
  - Route
  - Updated Corridor
  - Corridor
  - Study Area
  - National Hydrography Dataset (NHD)
  - Occupied Residence
  - Building/Unoccupied
  - Aggregate Sand and Gravel Pit
  - County Boundaries
  - PLSS Townships
  - PLSS Sections
- Exclusion and Avoidance Areas**
- 500' Home Buffer

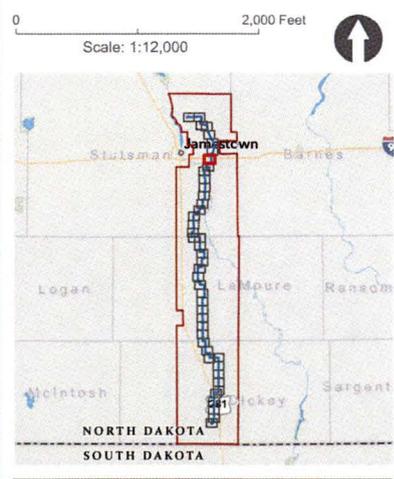

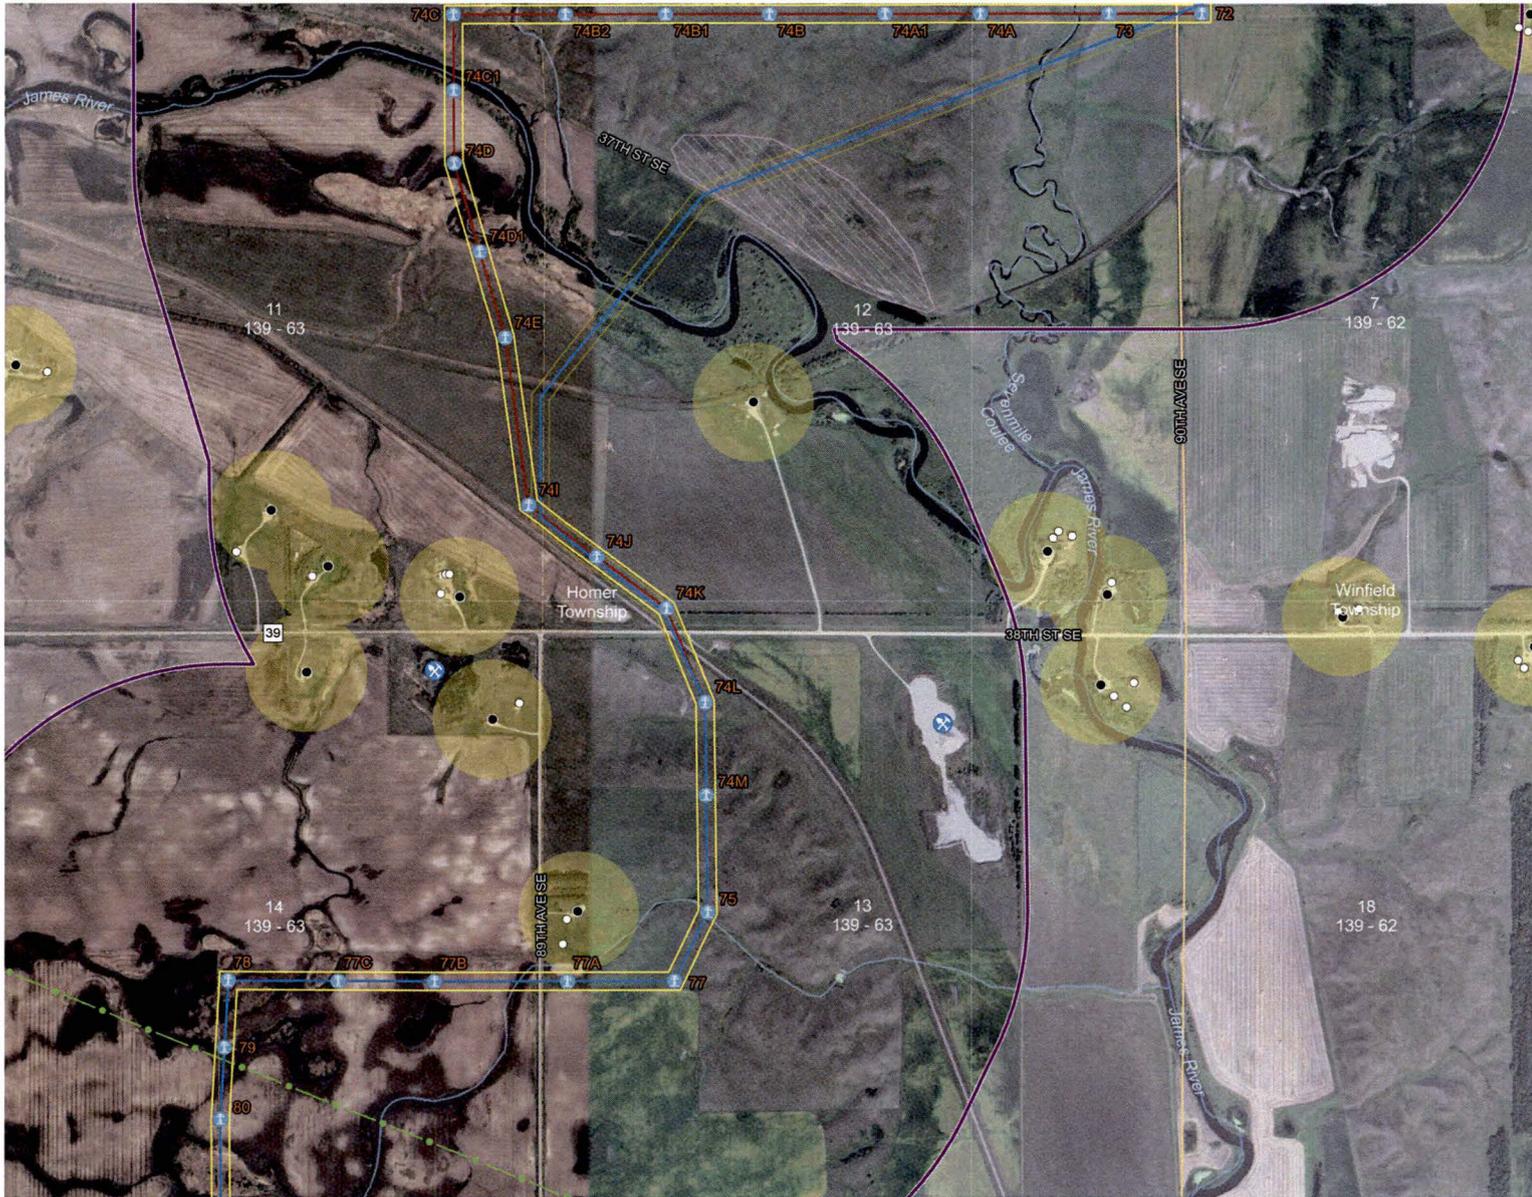

## Project Site Details

Figure 1.2-2

- Updated Route
  - Route
  - Updated Corridor
  - Corridor
  - Study Area
  - National Hydrography Dataset (NHD)
  - Occupied Residence
  - Building/Unoccupied
  - Existing High Voltage Transmission Line (HVTL)
  - Aggregate Sand and Gravel Pit
  - County Boundaries
  - PLSS Townships
  - PLSS Sections
- Exclusion and Avoidance Areas**
- 500' Home Buffer
  - Historic Landslide Deposits

