

September 30, 2026

Mr. Brian Johnson
Executive Director
North Dakota Public Service Commission
600 East Boulevard: Department 408
Bismarck, ND 58505-0480

Re: Case No. PU-25-284
Basin Electric Power Cooperative
Tande to Saskatchewan 230-kV Transmission Line Project

Dear Mr. Johnson:

In accordance with item 38 of the Certification Relating to Order Provisions, please accept this Structure Relocation request for Basin Electric Power Cooperative's (Basin Electric) Tande to Saskatchewan 230-kV Transmission Line Project (PU-25-284); thirty-six structures are being relocated, and one structure is being added. All structure relocations are within the established corridor, as reflected in the Certificate of Corridor Compatibility Number 247. All landowner easements have been adjusted accordingly and have been signed and received. Additionally, a reroute is being proposed, which will be applied for with an amended application submitted at a later date. Those structures are not included in this request.

Due to the structure addition (386-049), current structure numbers from 386-049 to 386-235 will increase by 1. 386-050 is now 386-051, 386-051 is now 386-052, etc. The reroute will include six new structures (386-236 to 386-241). Structure numbers from 386-236 to the end of the line (386-334) will increase by seven. 386-236 is now 386-243, 386-237 is now 386-244, etc. Please see the table below and attached figures showing the adjusted structure locations and numbers.

Previous Structure Number	New Structure Number	Location	Relocation (ft)	Reason for Relocation
386-031	386-031	T158N, R94W, S32	50	Engineering/Design
386-032	386-032	T158N, R94W, S32	76	Engineering/Design
	386-049	T158N, R94W, S17	New Structure	Engineering/Design
386-050	386-051	T158N, R94W, S17	100	Engineering/Design
386-051	386-052	T158N, R94W, S17	40	Engineering/Design
386-057	386-058	T158N, R94W, S8	20	Engineering/Design
386-084	386-085	T159N, R94W, S19	30	Engineering/Design
386-085	386-086	T159N, R94W, S18	30	Engineering/Design
386-098	386-099	T159N, R94W, S6	30	Engineering/Design
386-099	386-100	T159N, R94W, S6	20	Engineering/Design
386-100	386-101	T159N, R94W, S6	40	Engineering/Design

Previous Structure Number	New Structure Number	Location	Relocation (ft)	Reason for Relocation
386-101	386-102	T160N, R94W, S30	10	Engineering/Design
386-110	386-111	T160N, R95W, S25	100	Engineering/Design
386-114	386-115	T160N, R95W, S30	38	Engineering/Design
386-146	386-147	T160N, R95W, S30	20	Engineering/Design
386-152	386-153	T160N, R95W, S18	69	Engineering/Design
386-165	386-166	T160N, R95W, S6	30	Engineering/Design
386-179	386-180	T161N, R95W, S21	20	Engineering/Design
386-225	386-226	T161N, R96W, S2	90	Engineering/Design
386-236	386-243	T162N, R96W, S26	275	Engineering/Design
386-237	386-244	T162N, R96W, S26	205	Engineering/Design
386-238	386-245	T162N, R96W, S23	46	Engineering/Design
386-253	386-260	T162N, R96W, S11	71	Engineering/Design
386-254	386-261	T162N, R96W, S11	71	Landowner Request
386-255	386-262	T162N, R96W, S11	310	Landowner Request
386-256	386-263	T162N, R96W, S11	40	Landowner Request
386-299	386-306	T163N, R96W, S17	20	Engineering/Design
386-303	386-310	T163N, R96W, S8	30	Engineering/Design
386-304	386-311	T163N, R96W, S8	70	Engineering/Design
386-305	386-312	T163N, R96W, S5	40	Engineering/Design

A notarized Certification that Basin Electric Power Cooperative will comply with the Commissioner's order, law and rules designating the corridor and route is attached. If you have any questions or require additional information for this submittal, please contact me at rking@bepc.com or 701-557-5558.

Sincerely,



Ryan King
Environmental Coordinator

Attachments: Certification of Applicant



CERTIFICATION OF APPLICANT – TRANSMISSION FACILITY SITING

Case No. PU-25-284

BASIN ELECTRIC POWER COOPERATIVE

I, Bobby Nasset, Manager, Civil & Transmission Line Engineering, a duly authorized agent of Basin Electric Power Cooperative that has authority to bind the company in these matters, do hereby certify under oath:


1. That the relocation of the structures on the Tande to Saskatchewan 230kV Transmission Line (PU-25-284) will not affect any known exclusion or avoidance areas as defined under the North Dakota Administrative Code § 69-06-08-02(1) and (2).
2. That Basin Electric Power Cooperative will comply with all applicable conditions and protections in North Dakota siting laws and rules and the Commission's previously issued order, law and rules designating the corridor and route.

Dates at Bismarck, North Dakota this 30th day of September, 2026.

Bobby Nasset
Manager, Civil & Transmission Line Engineering

STATE OF NORTH DAKOTA)
)ss.
COUNTY OF BURLEIGH)

This instrument was acknowledged before me this 30th day of September, 2026 by Bobby Nasset on behalf of Basin Electric Power Cooperative.

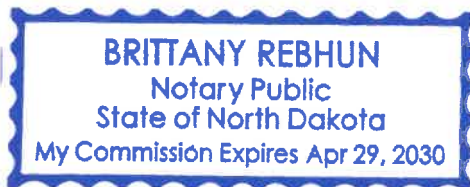

Notary Public

Tande-to-Saskatchewan 230-kV Transmission Project

Update Structure Location: 386-031



**BASIN ELECTRIC
POWER COOPERATIVE**
A Touchstone Energy® Cooperative

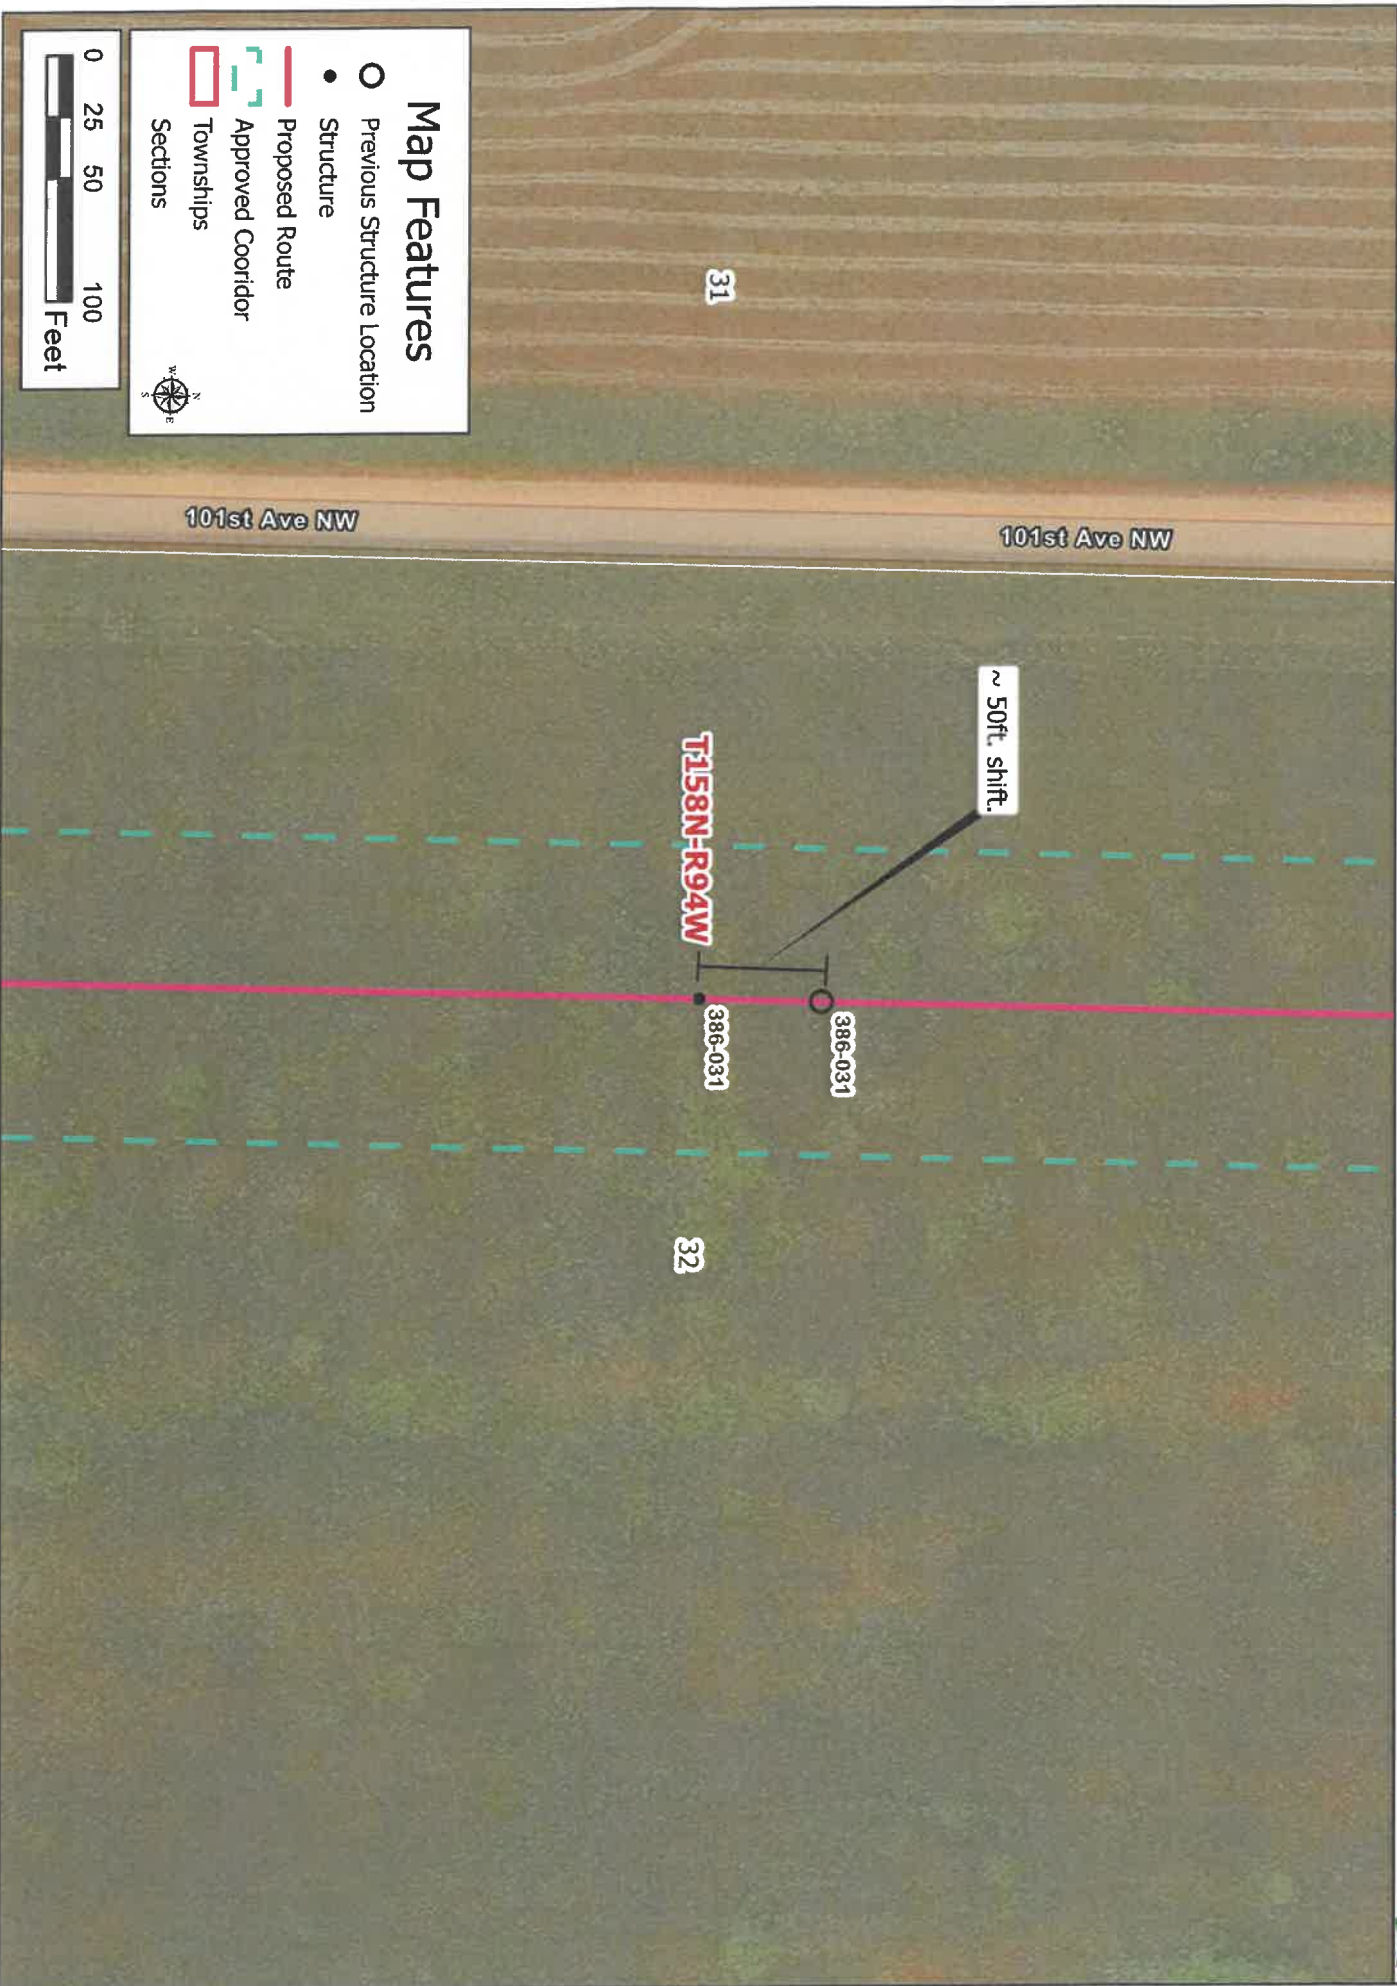


Tande-to-Saskatchewan 230-kV Transmission Project

Update Structure Location: 386-032



**BASIN ELECTRIC
POWER COOPERATIVE**
A Touchstone Energy® Cooperative

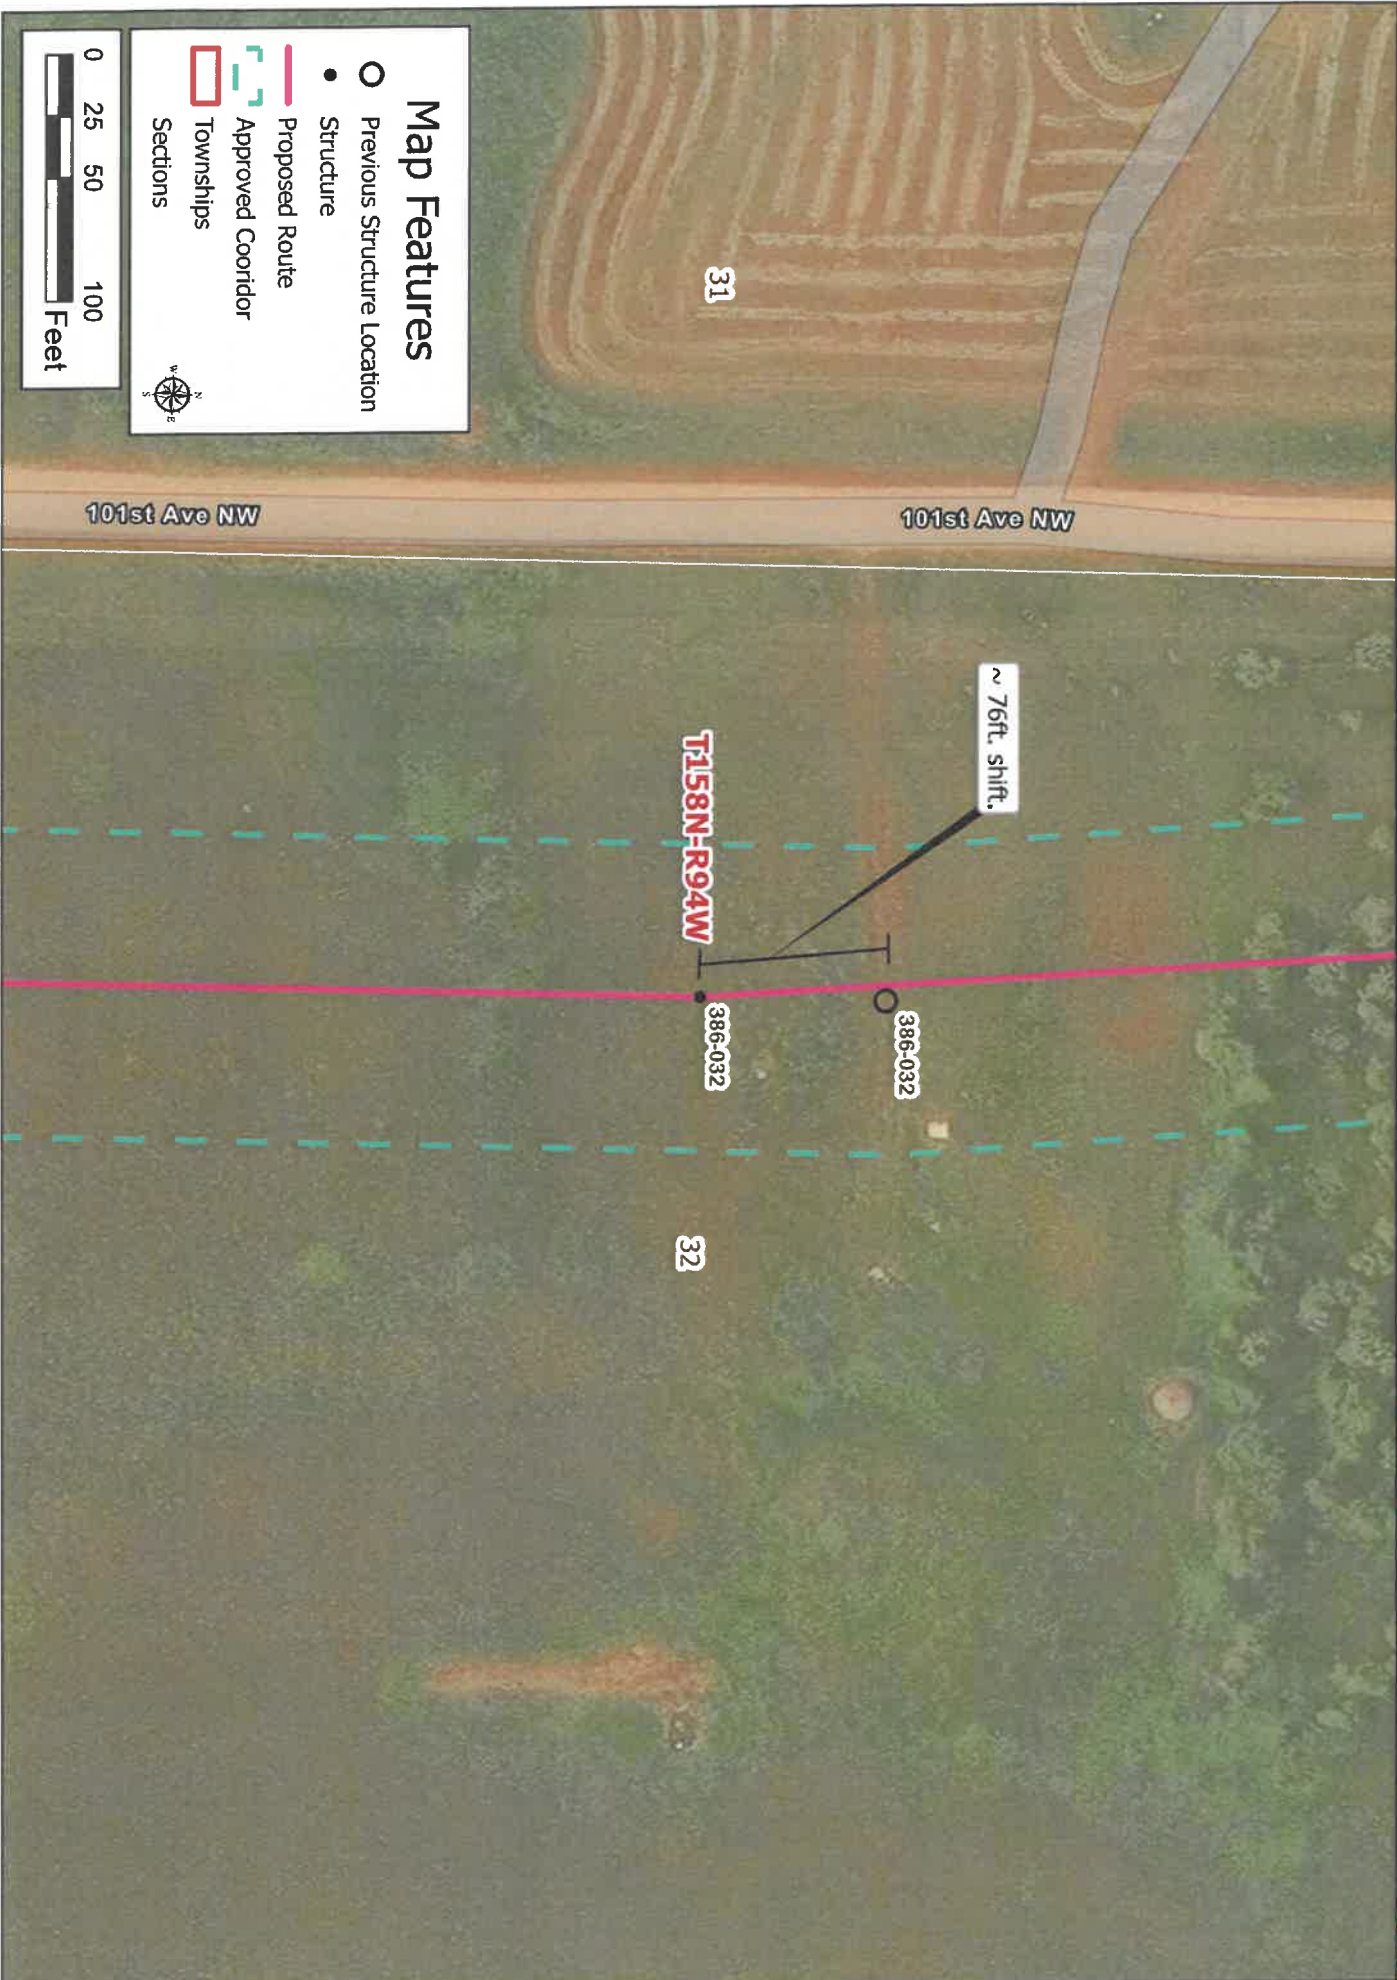


Tande-to-Saskatchewan 230-kV Transmission Project

Update Structure Location: 386-049



**BASIN ELECTRIC
POWER COOPERATIVE**
A Touchstone Energy® Cooperative

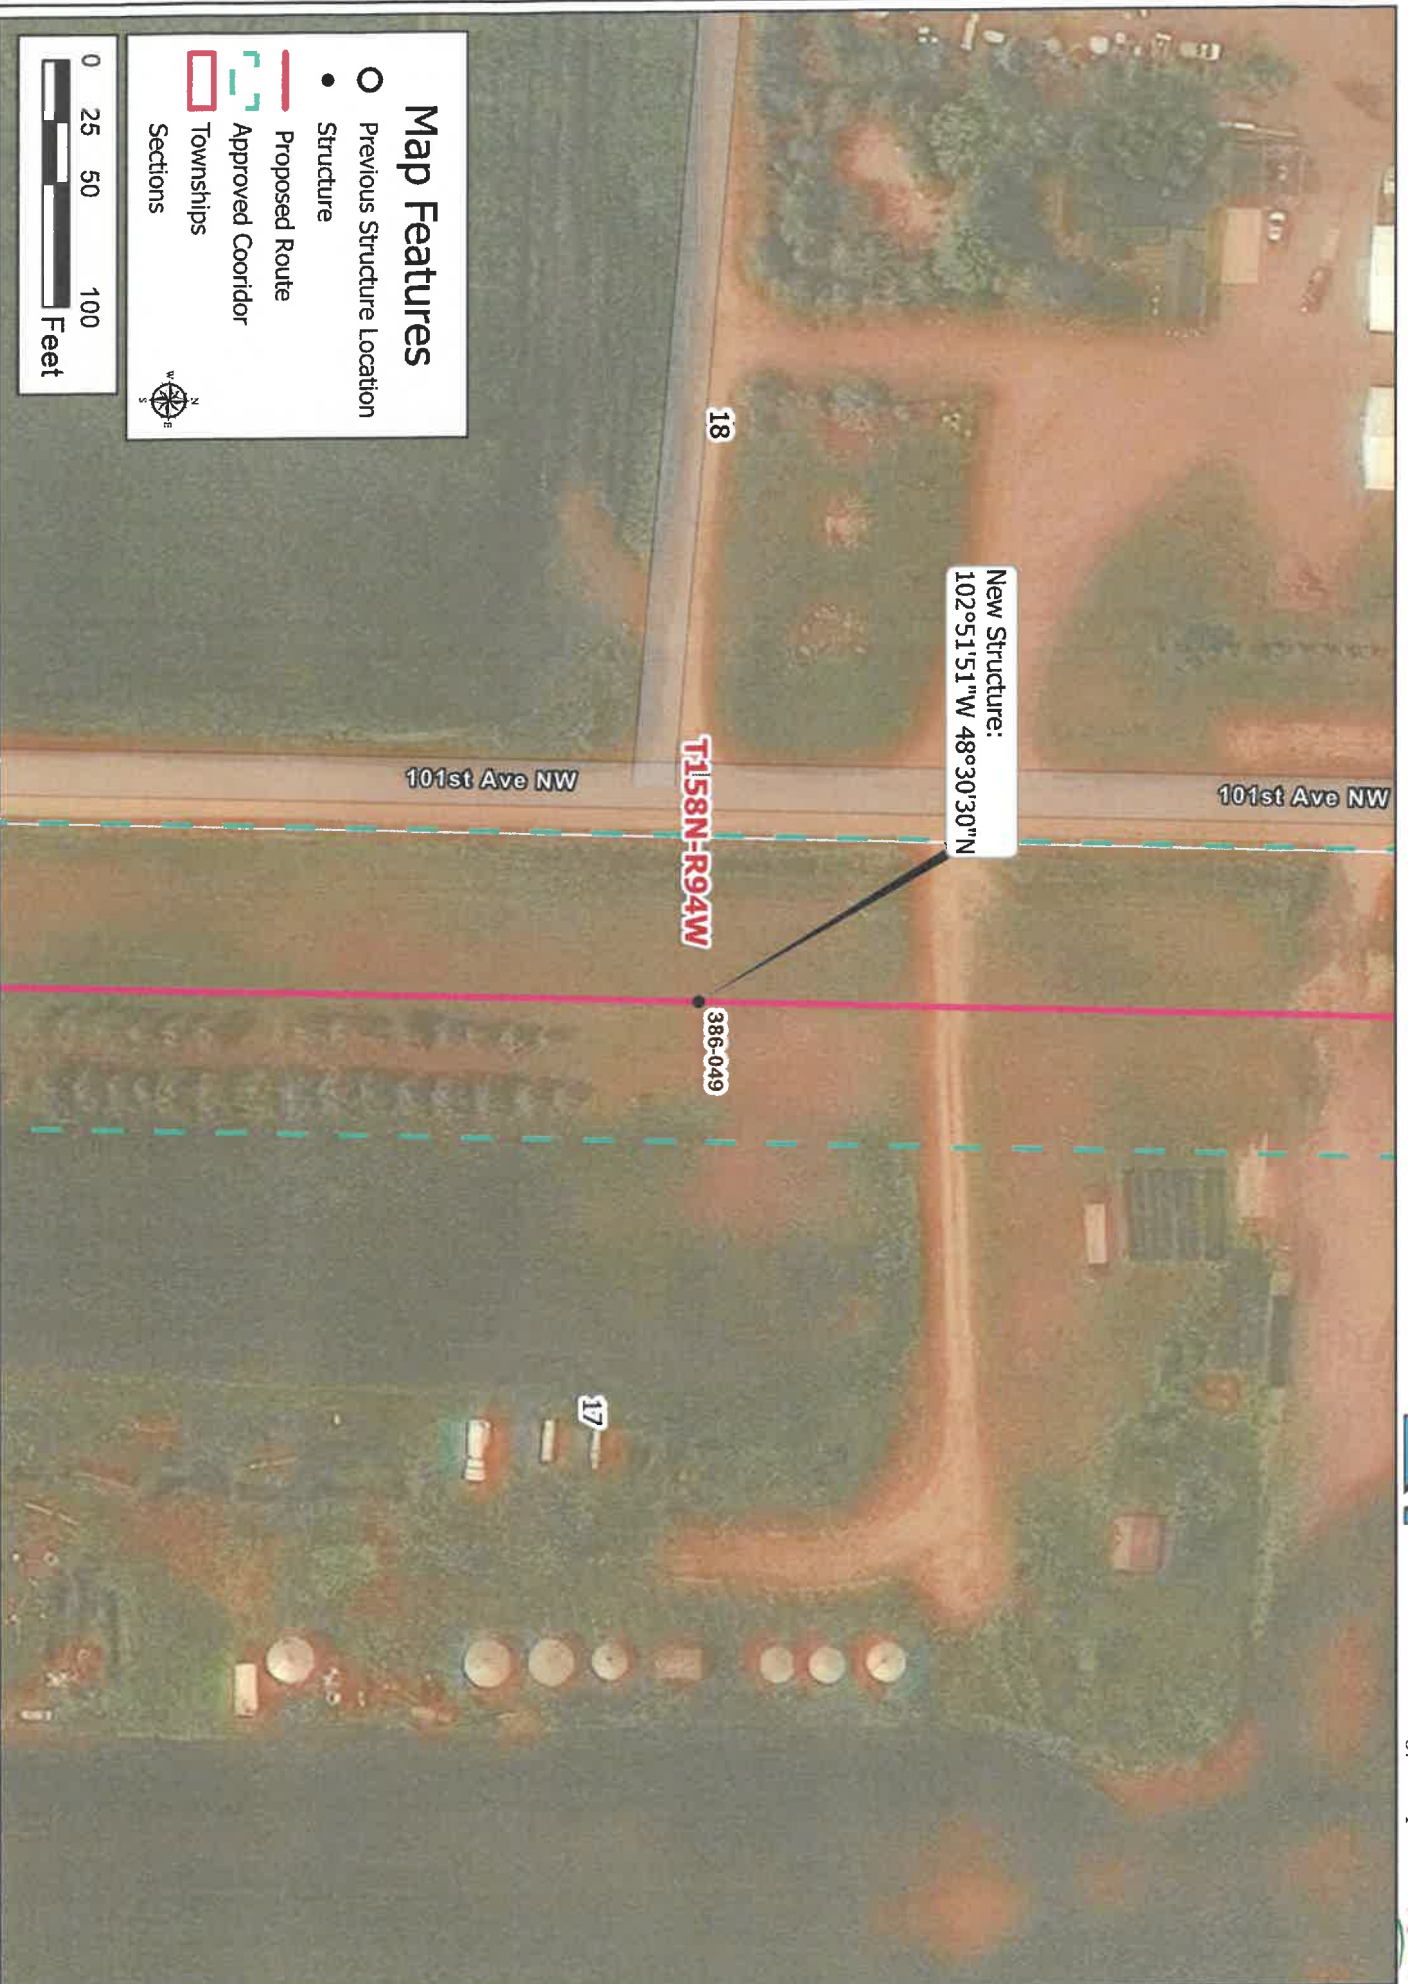


Tande-to-Saskatchewan 230-kV Transmission Project

Update Structure Location: 386-050



**BASIN ELECTRIC
POWER COOPERATIVE**
A Touchstone Energy® Cooperative

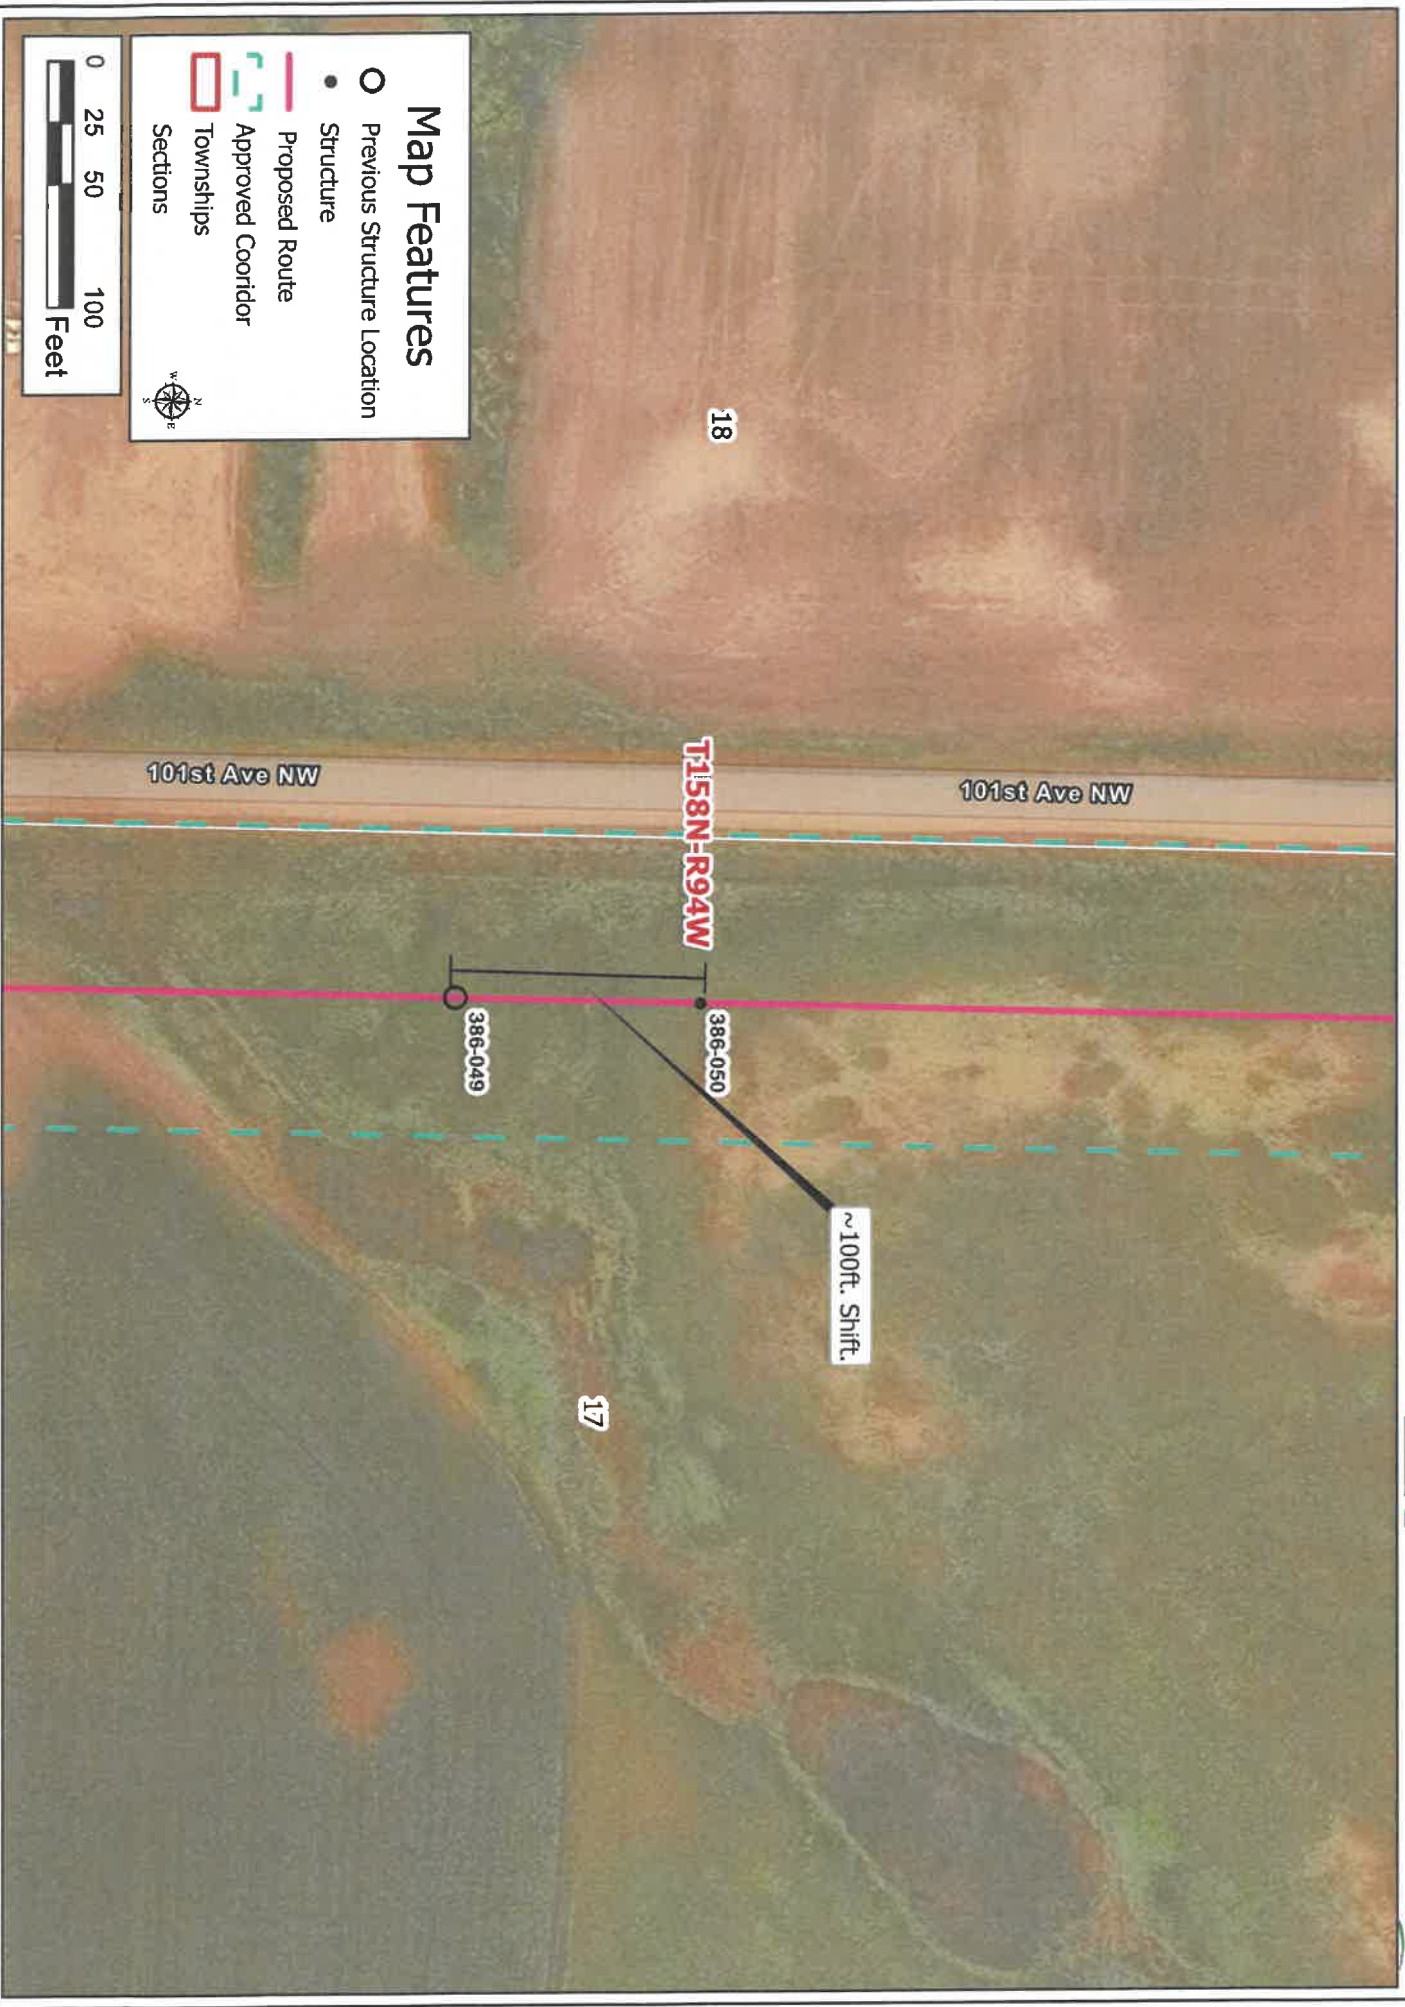


Tande-to-Saskatchewan 230-kV Transmission Project

Update Structure Location: 386-052



**BASIN ELECTRIC
POWER COOPERATIVE**
A Touchstone Energy® Cooperative

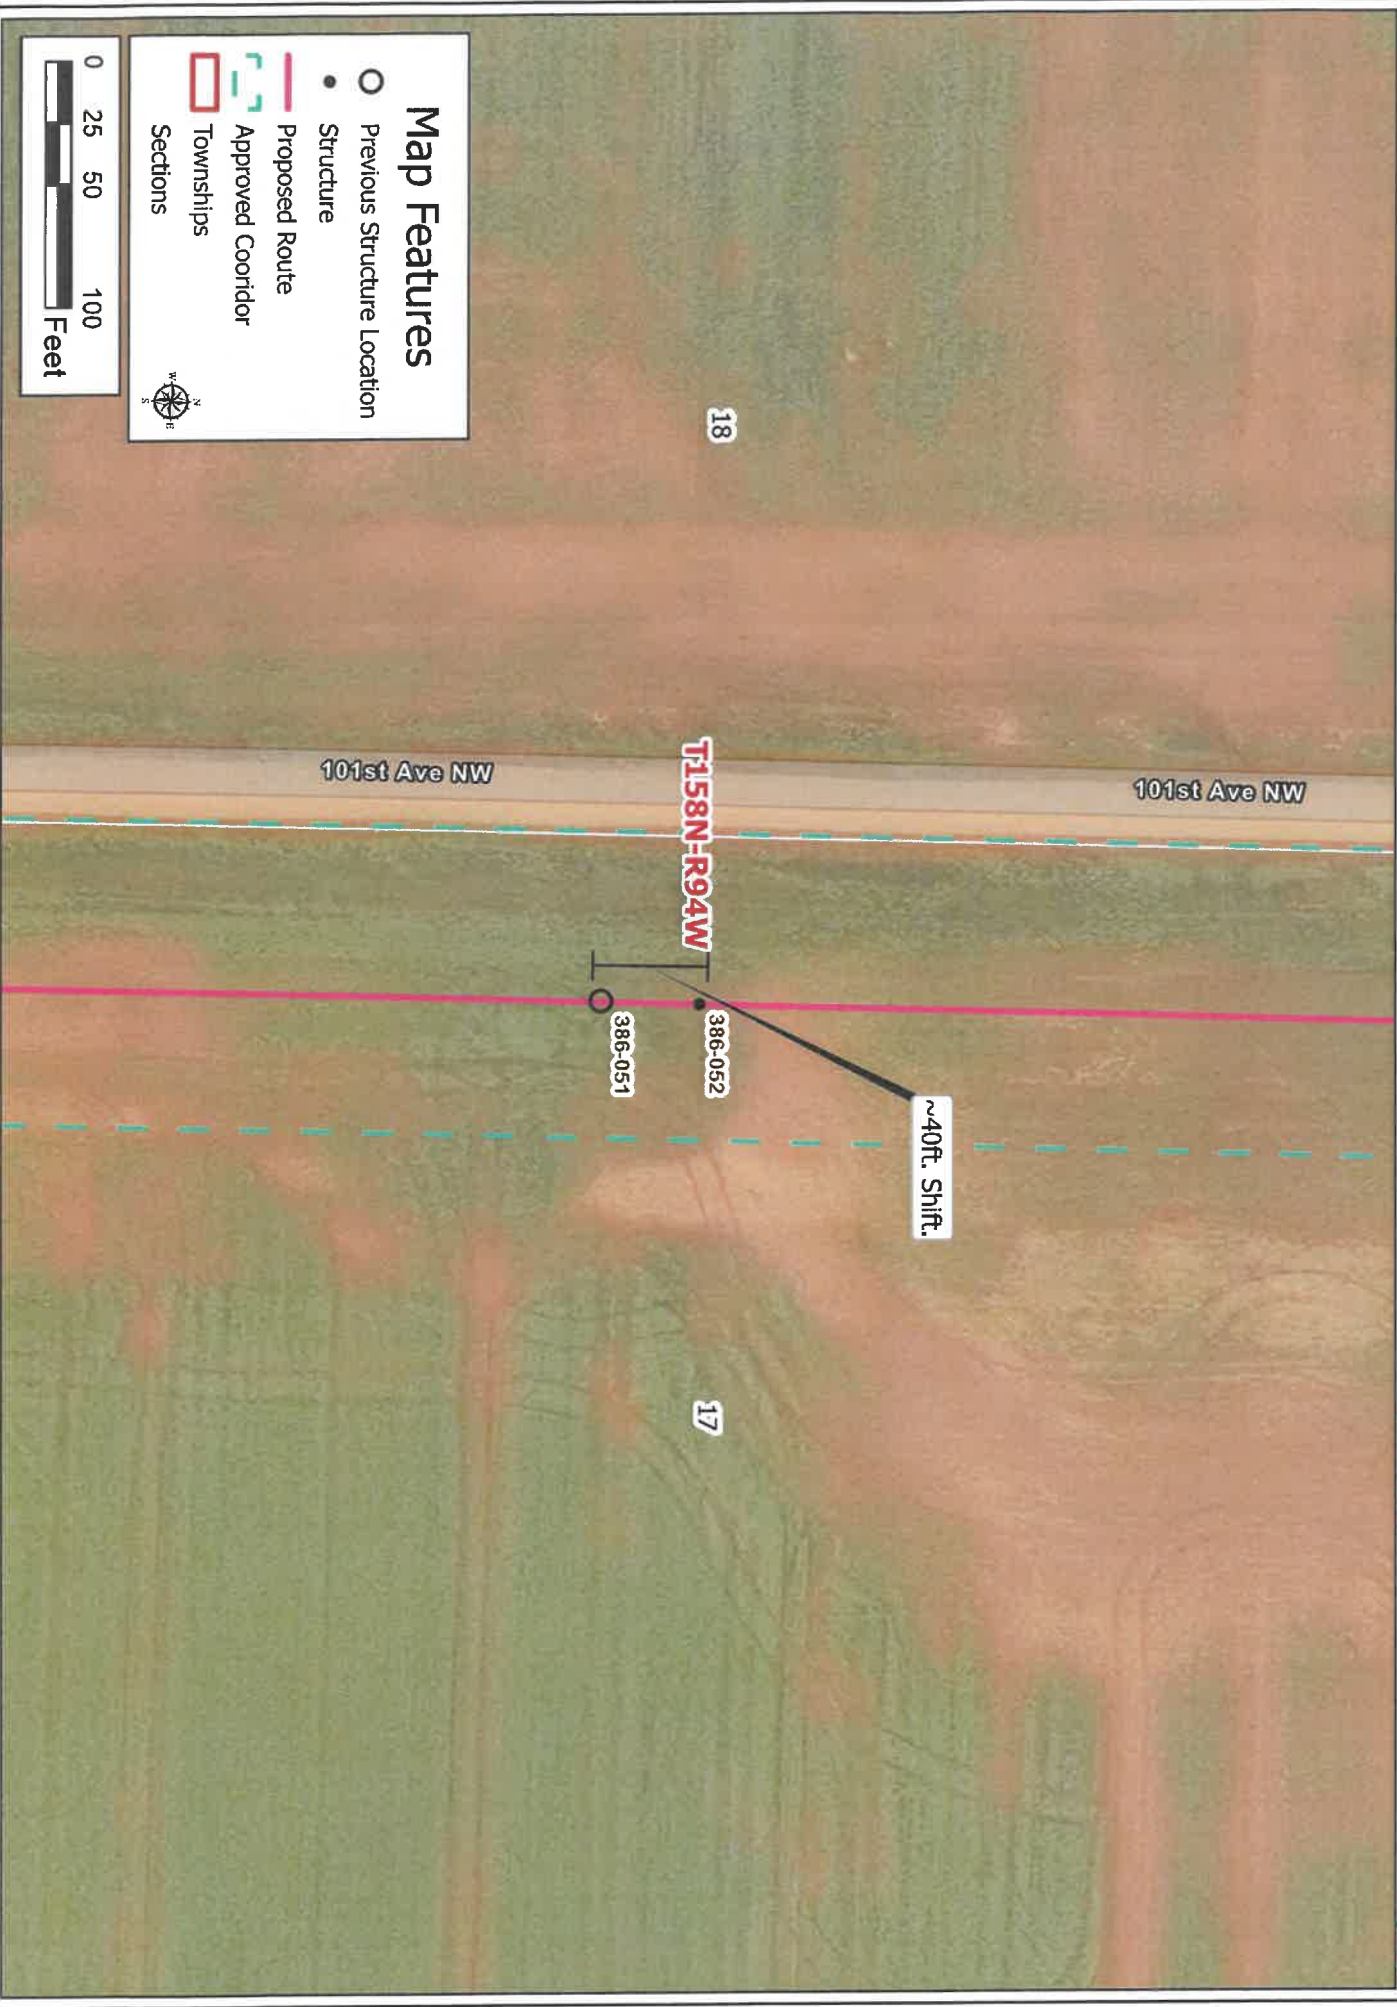

Map Features

- Previous Structure Location
- Structure
- Proposed Route
- - - Approved Corridor
- Townships
- Sections




Tande-to-Saskatchewan 230-kV Transmission Project

Update Structure Location: 386-058




**BASIN ELECTRIC
POWER COOPERATIVE**
A Touchstone Energy Cooperative

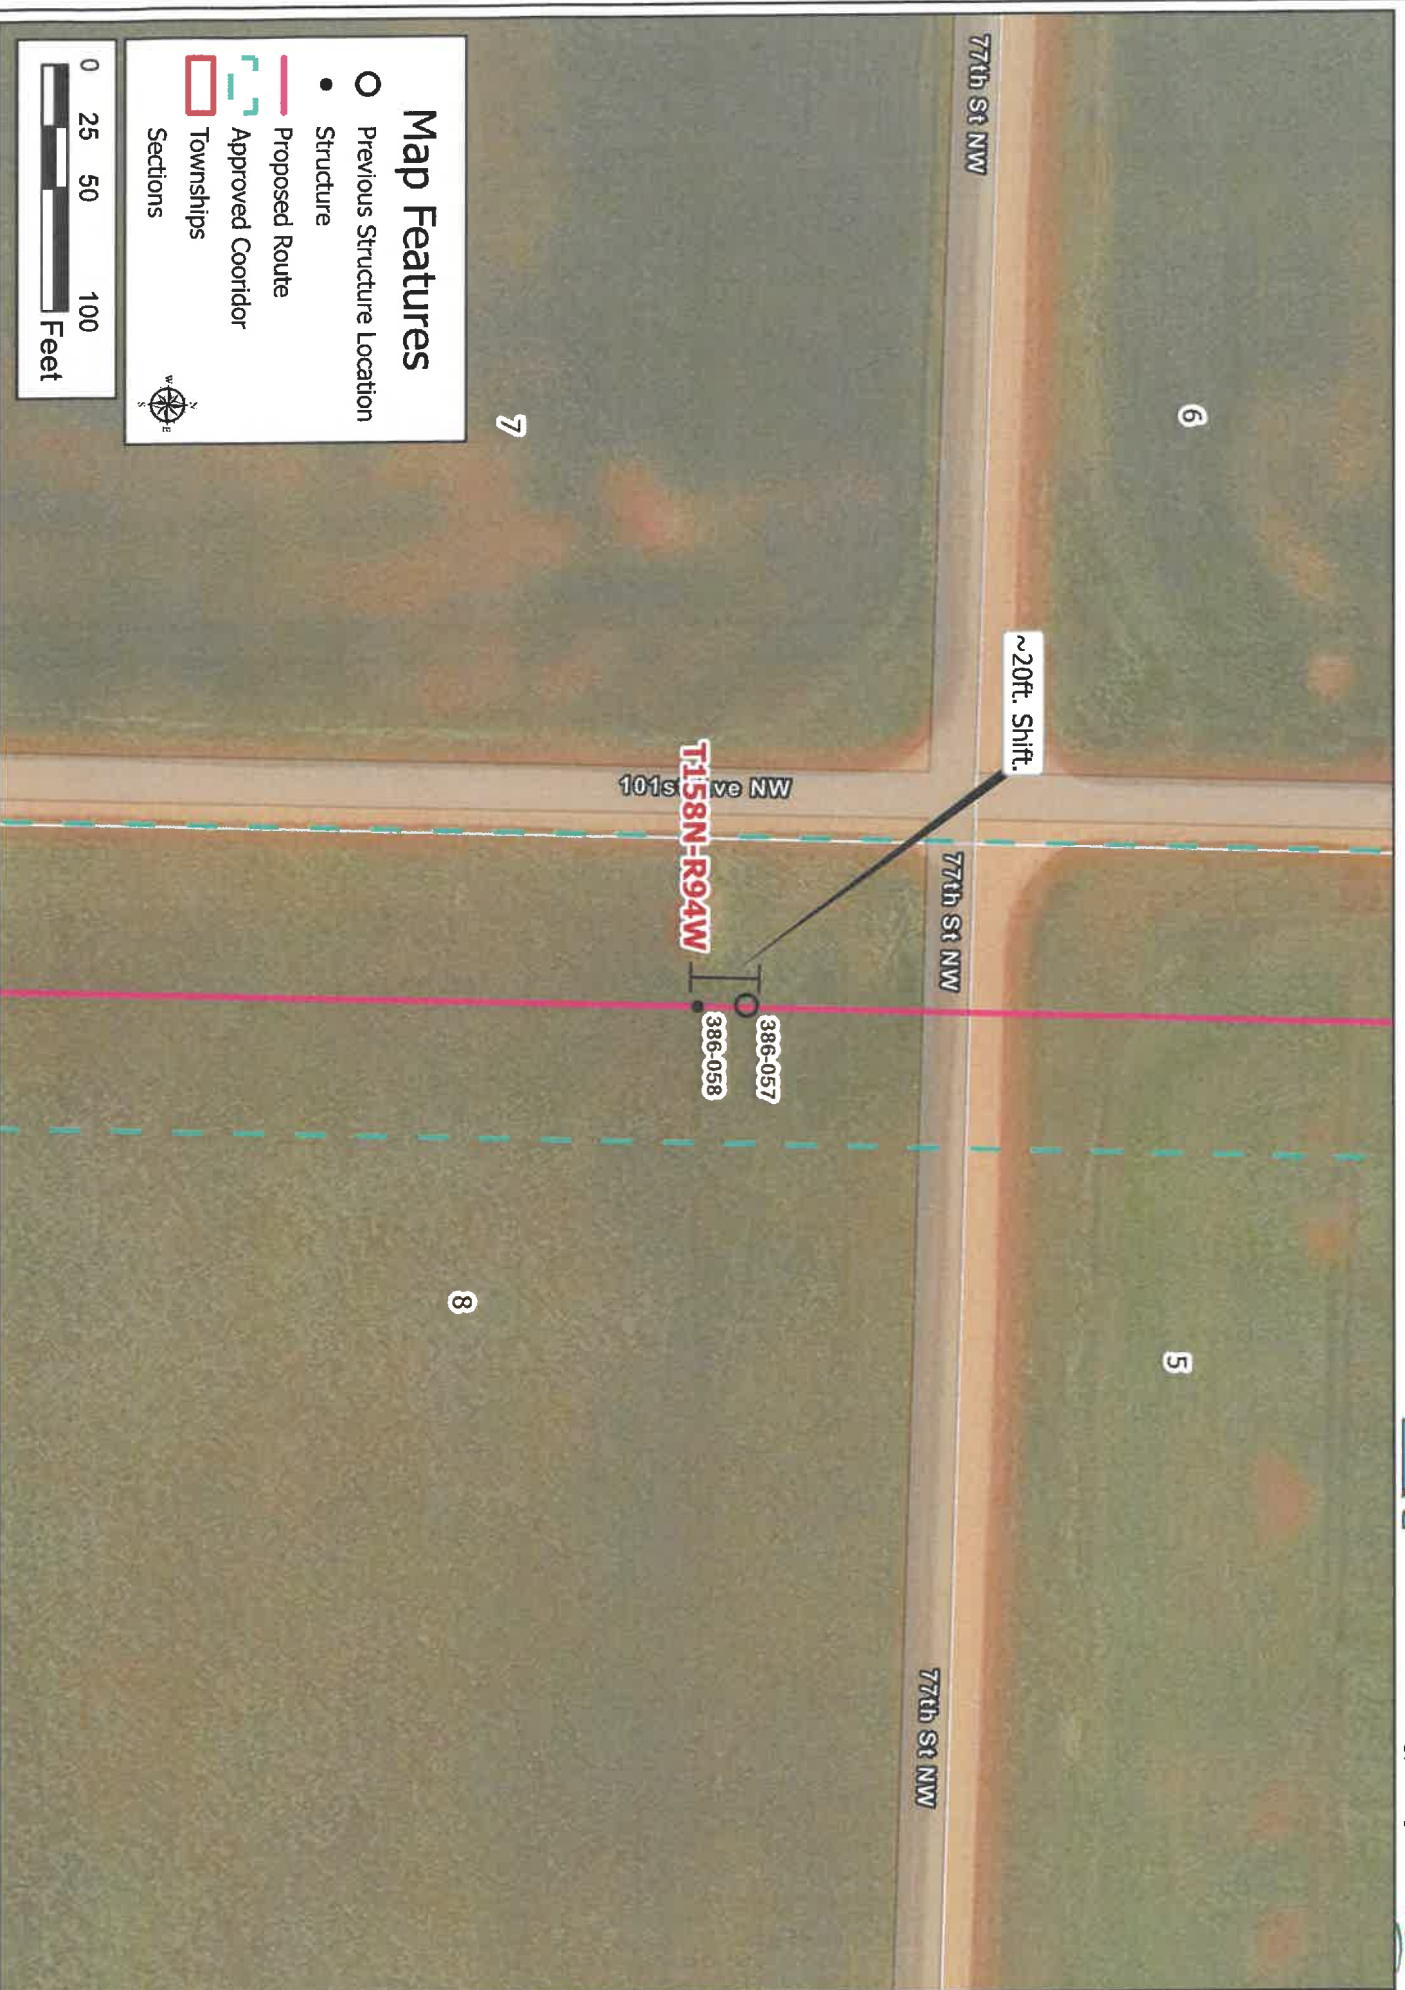

Tande-to-Saskatchewan 230-kV Transmission Project

Update Structure Location: 386-085

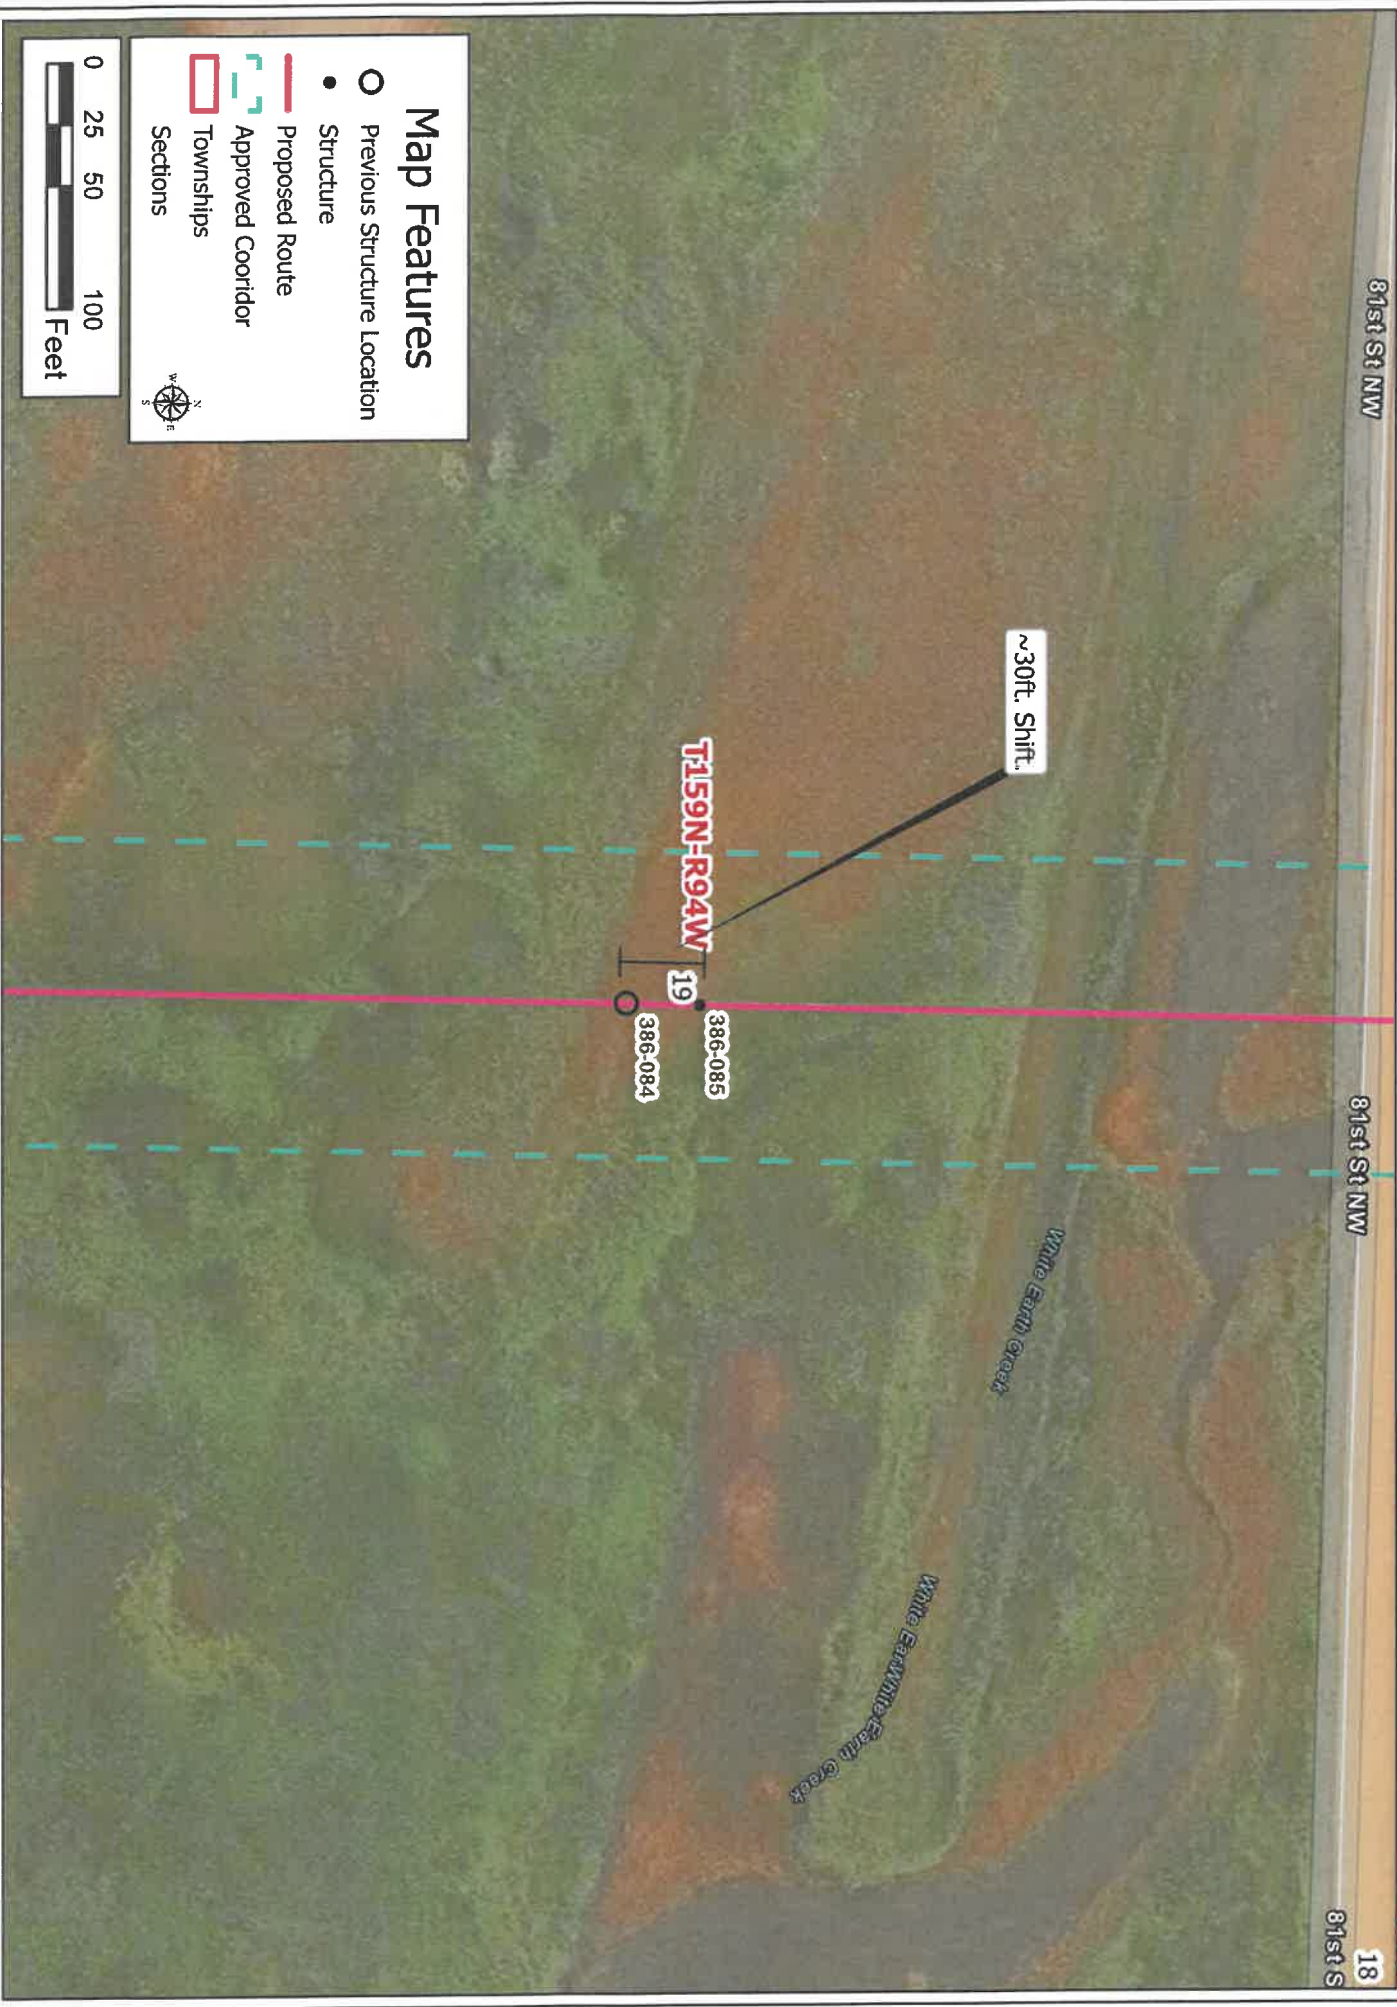


Tande-to-Saskatchewan 230-kV Transmission Project

Update Structure Location: 386-086



**BASIN ELECTRIC
POWER COOPERATIVE**
A Touchstone Energy® Cooperative

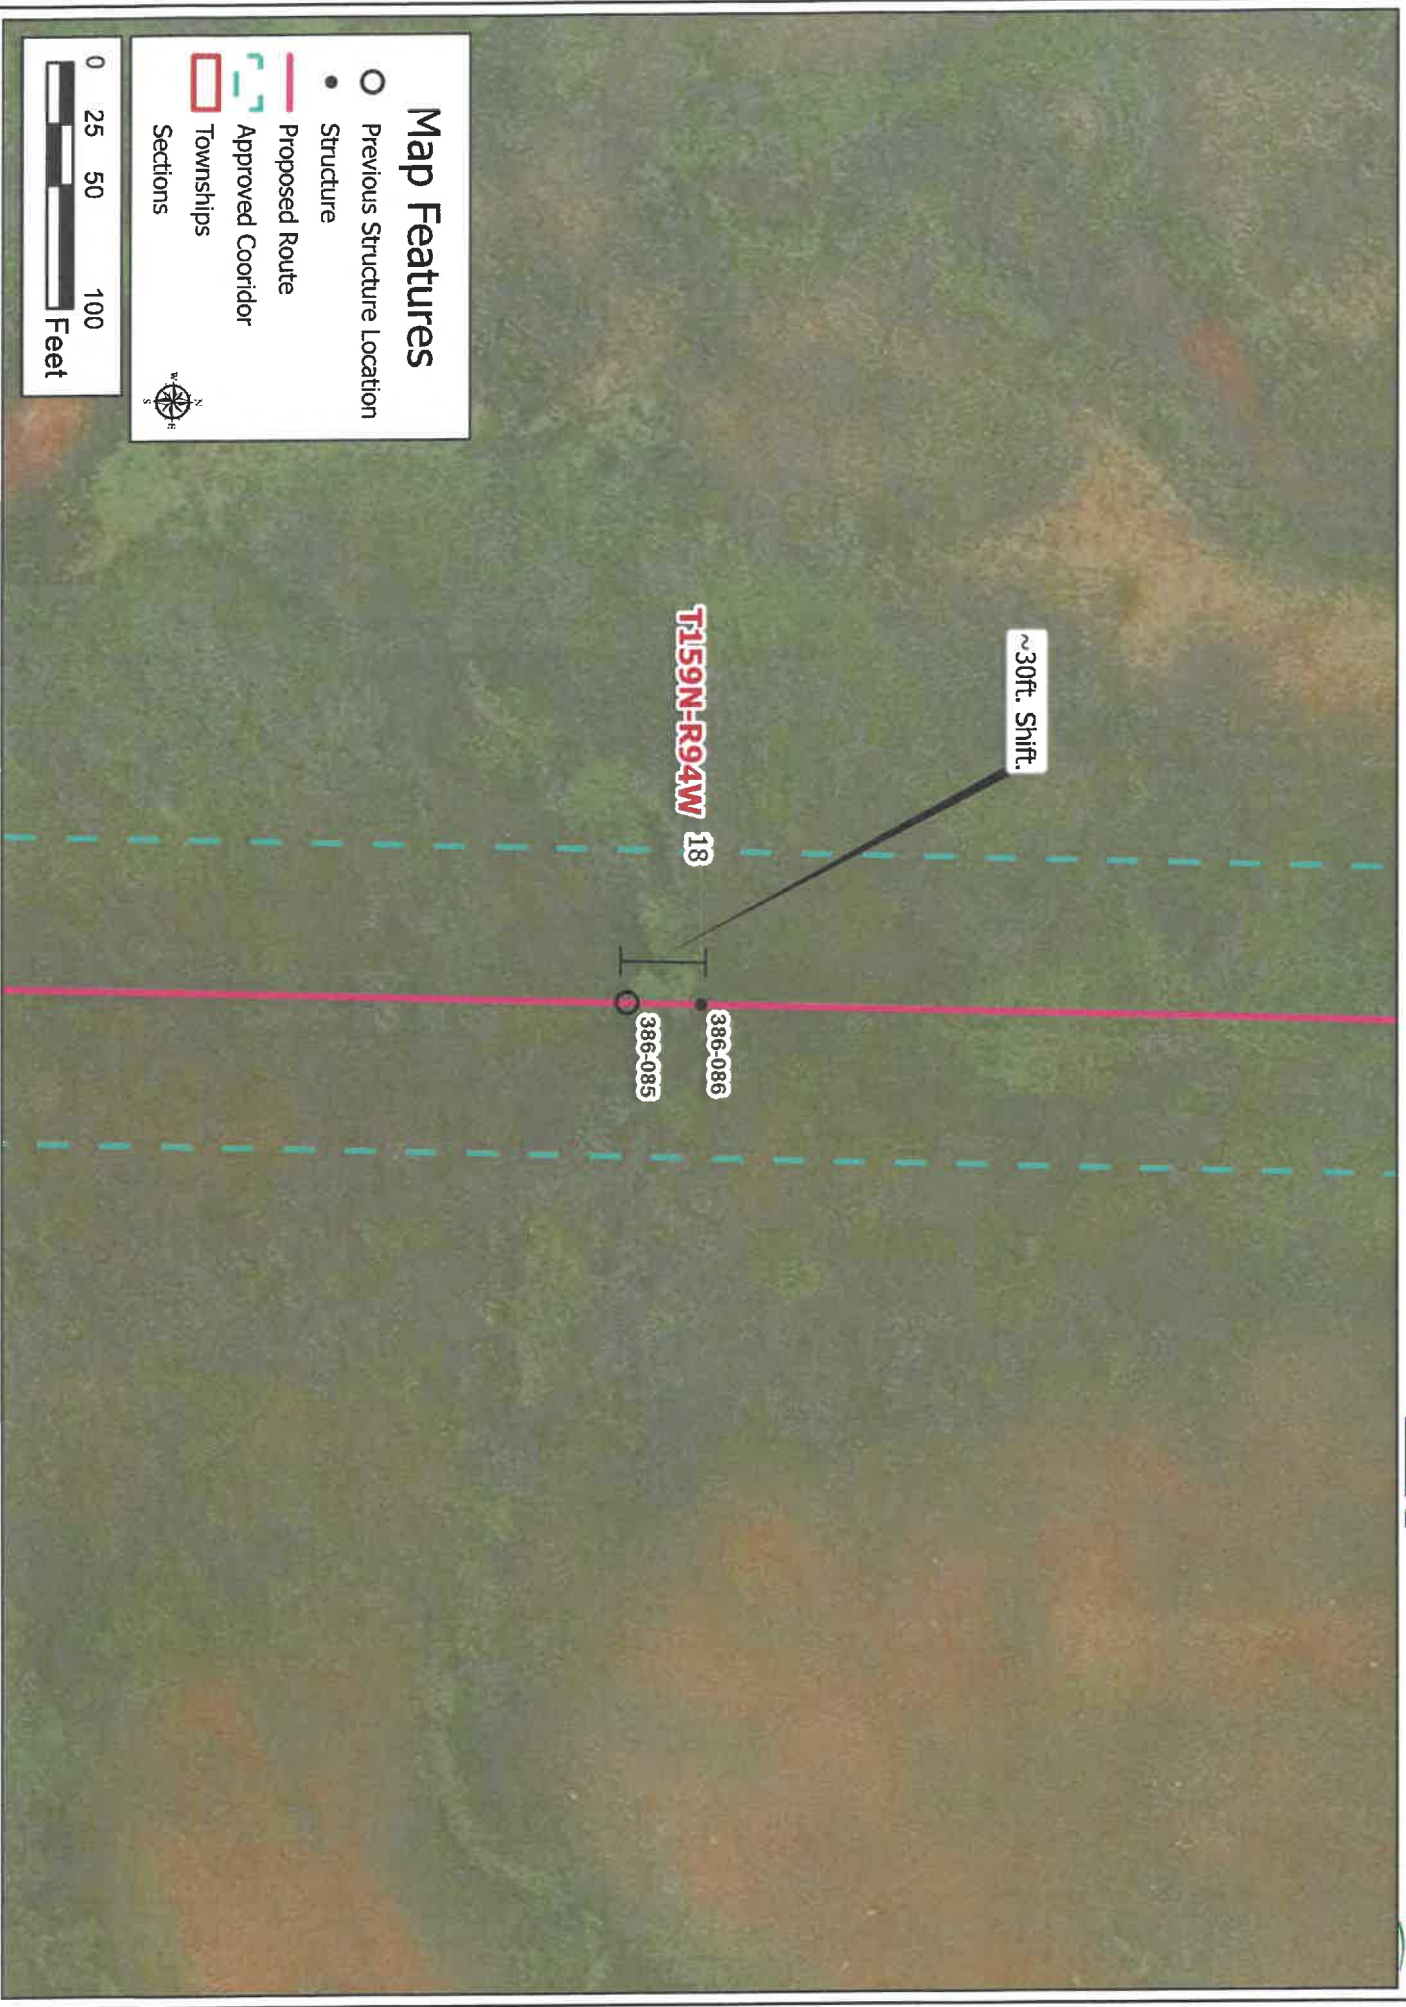

T159N-R94W

18

~30ft. Shift.

386-086


386-085

Tande-to-Saskatchewan 230-kV Transmission Project

Update Structure Location: 386-099



**BASIN ELECTRIC
POWER COOPERATIVE**
A Touchstone Energy® Cooperative

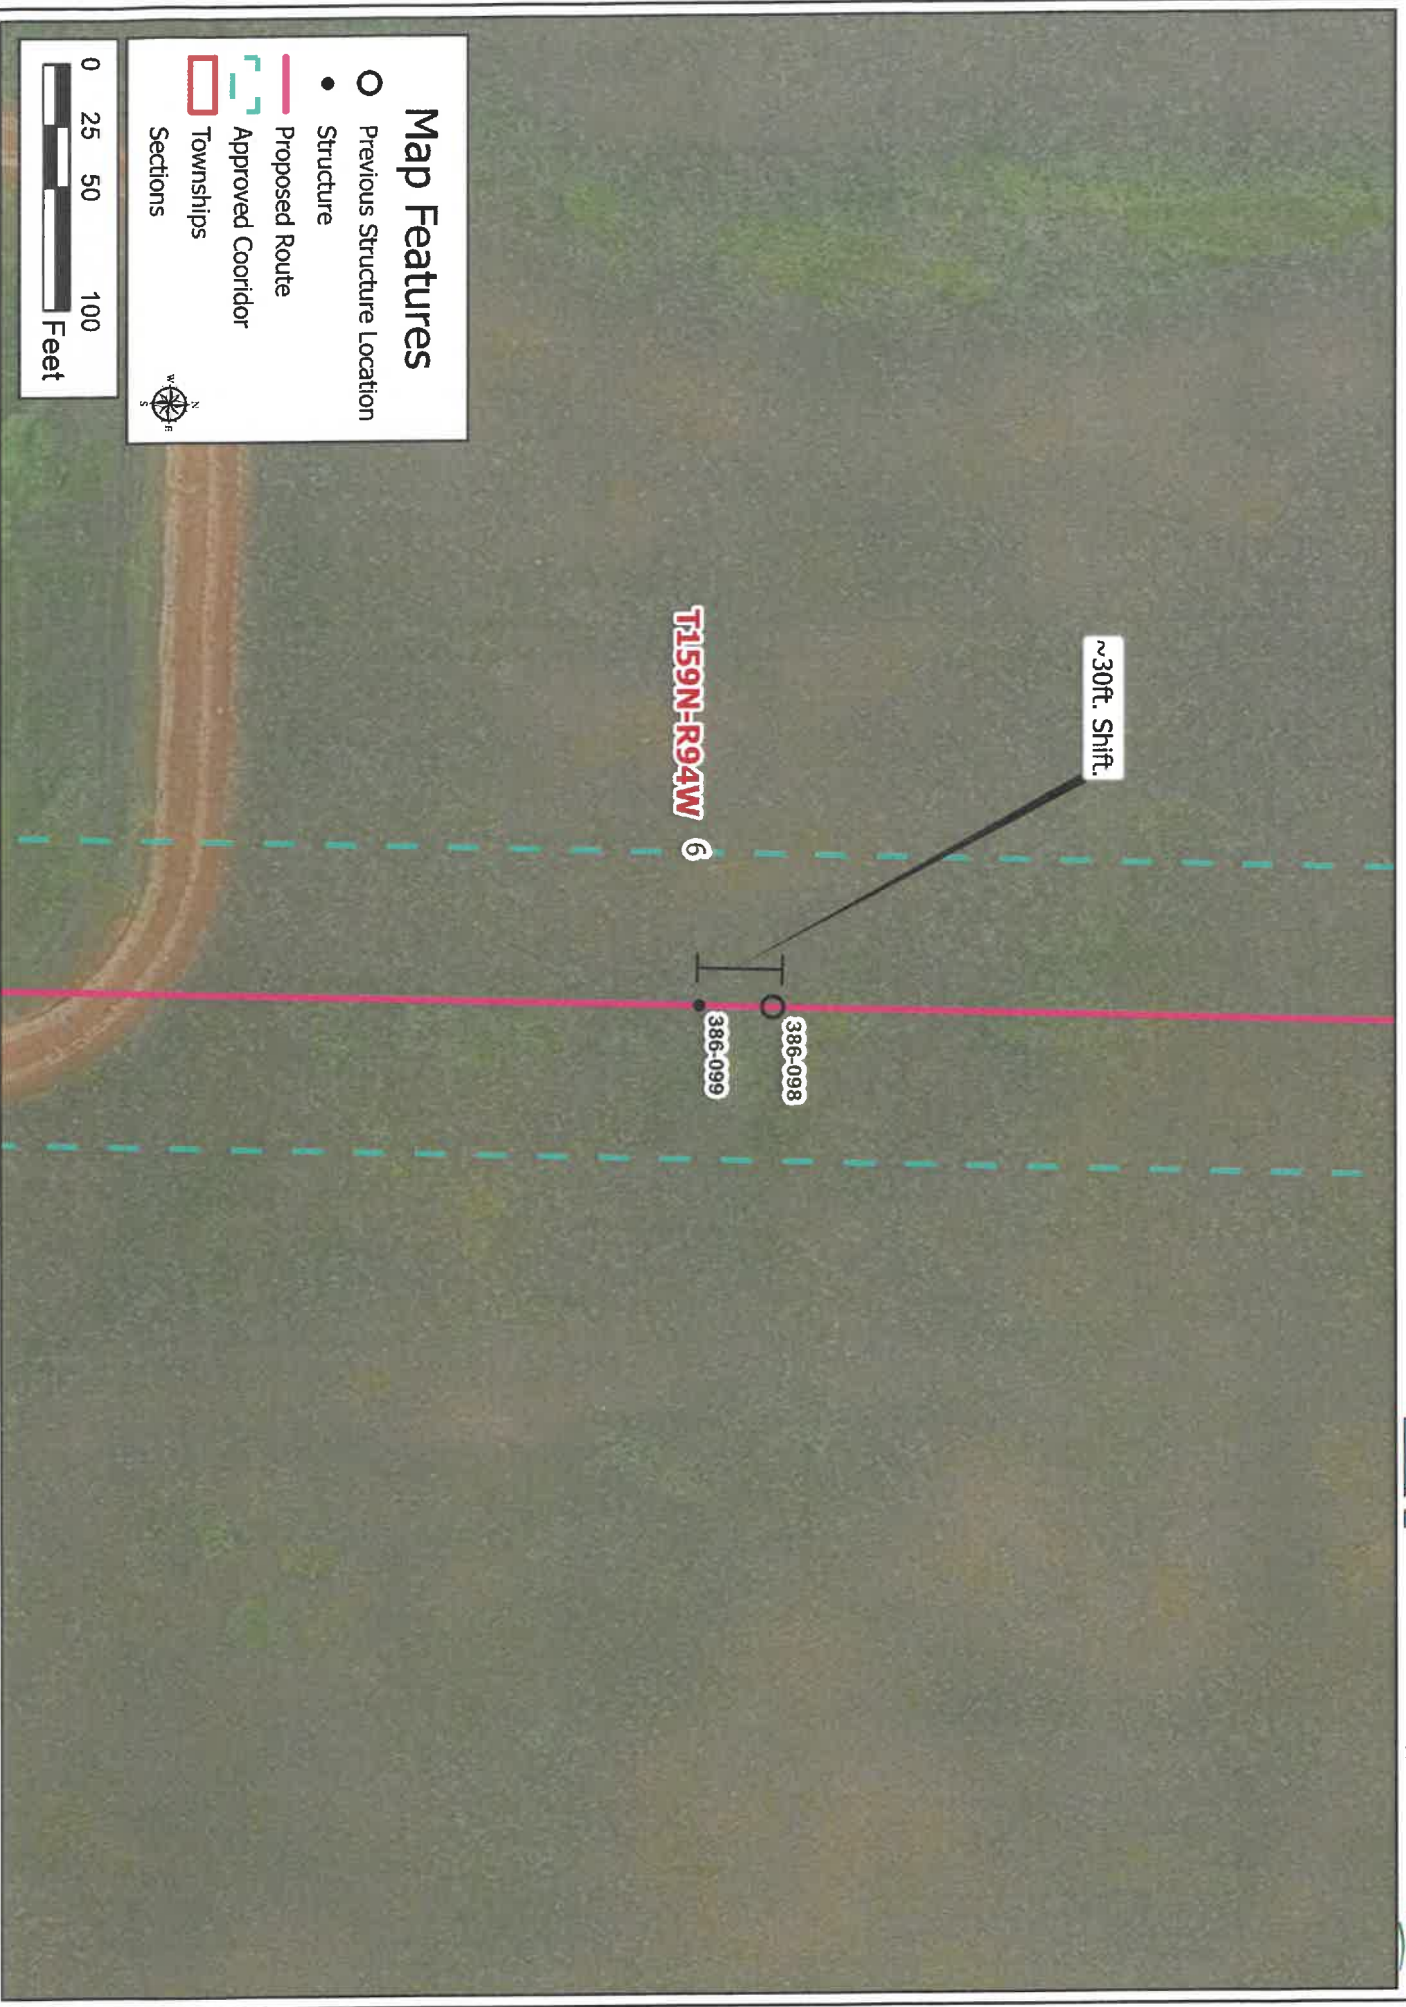

Map Features

- Previous Structure Location
- Structure
- Proposed Route
- - - Approved Corridor
- ▭ Townships
- ▭ Sections




0 25 50 100
Feet

Tande-to-Saskatchewan 230-kV Transmission Project

Update Structure Location: 386-100



**BASIN ELECTRIC
POWER COOPERATIVE**
A Touchstone Energy® Cooperative

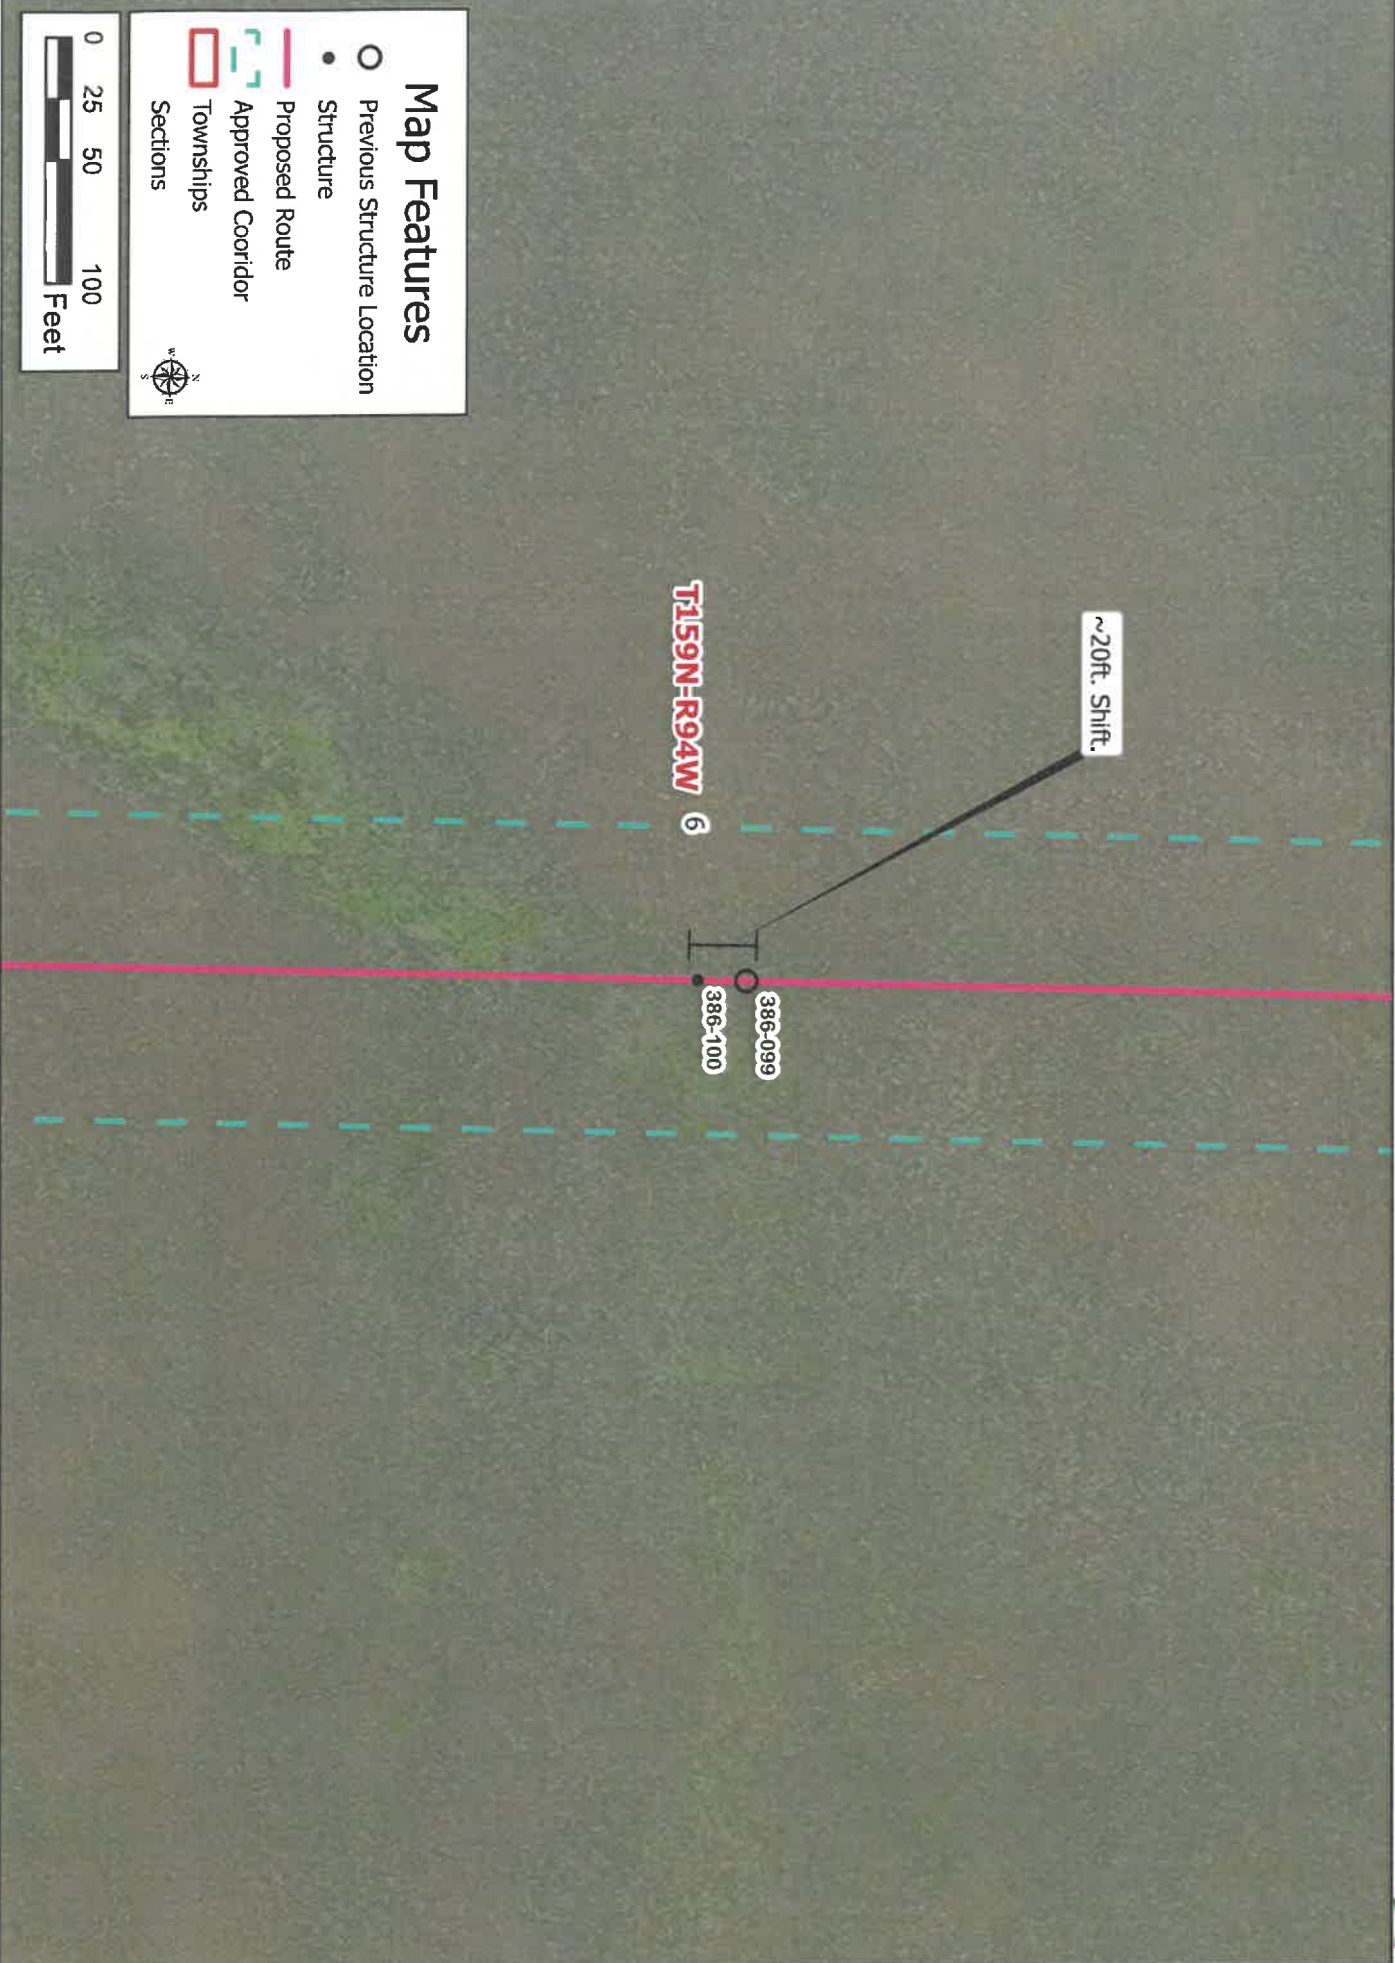


Tande-to-Saskatchewan 230-kV Transmission Project

Update Structure Location: 386-101



**BASIN ELECTRIC
POWER COOPERATIVE**
A Touchstone Energy® Cooperative

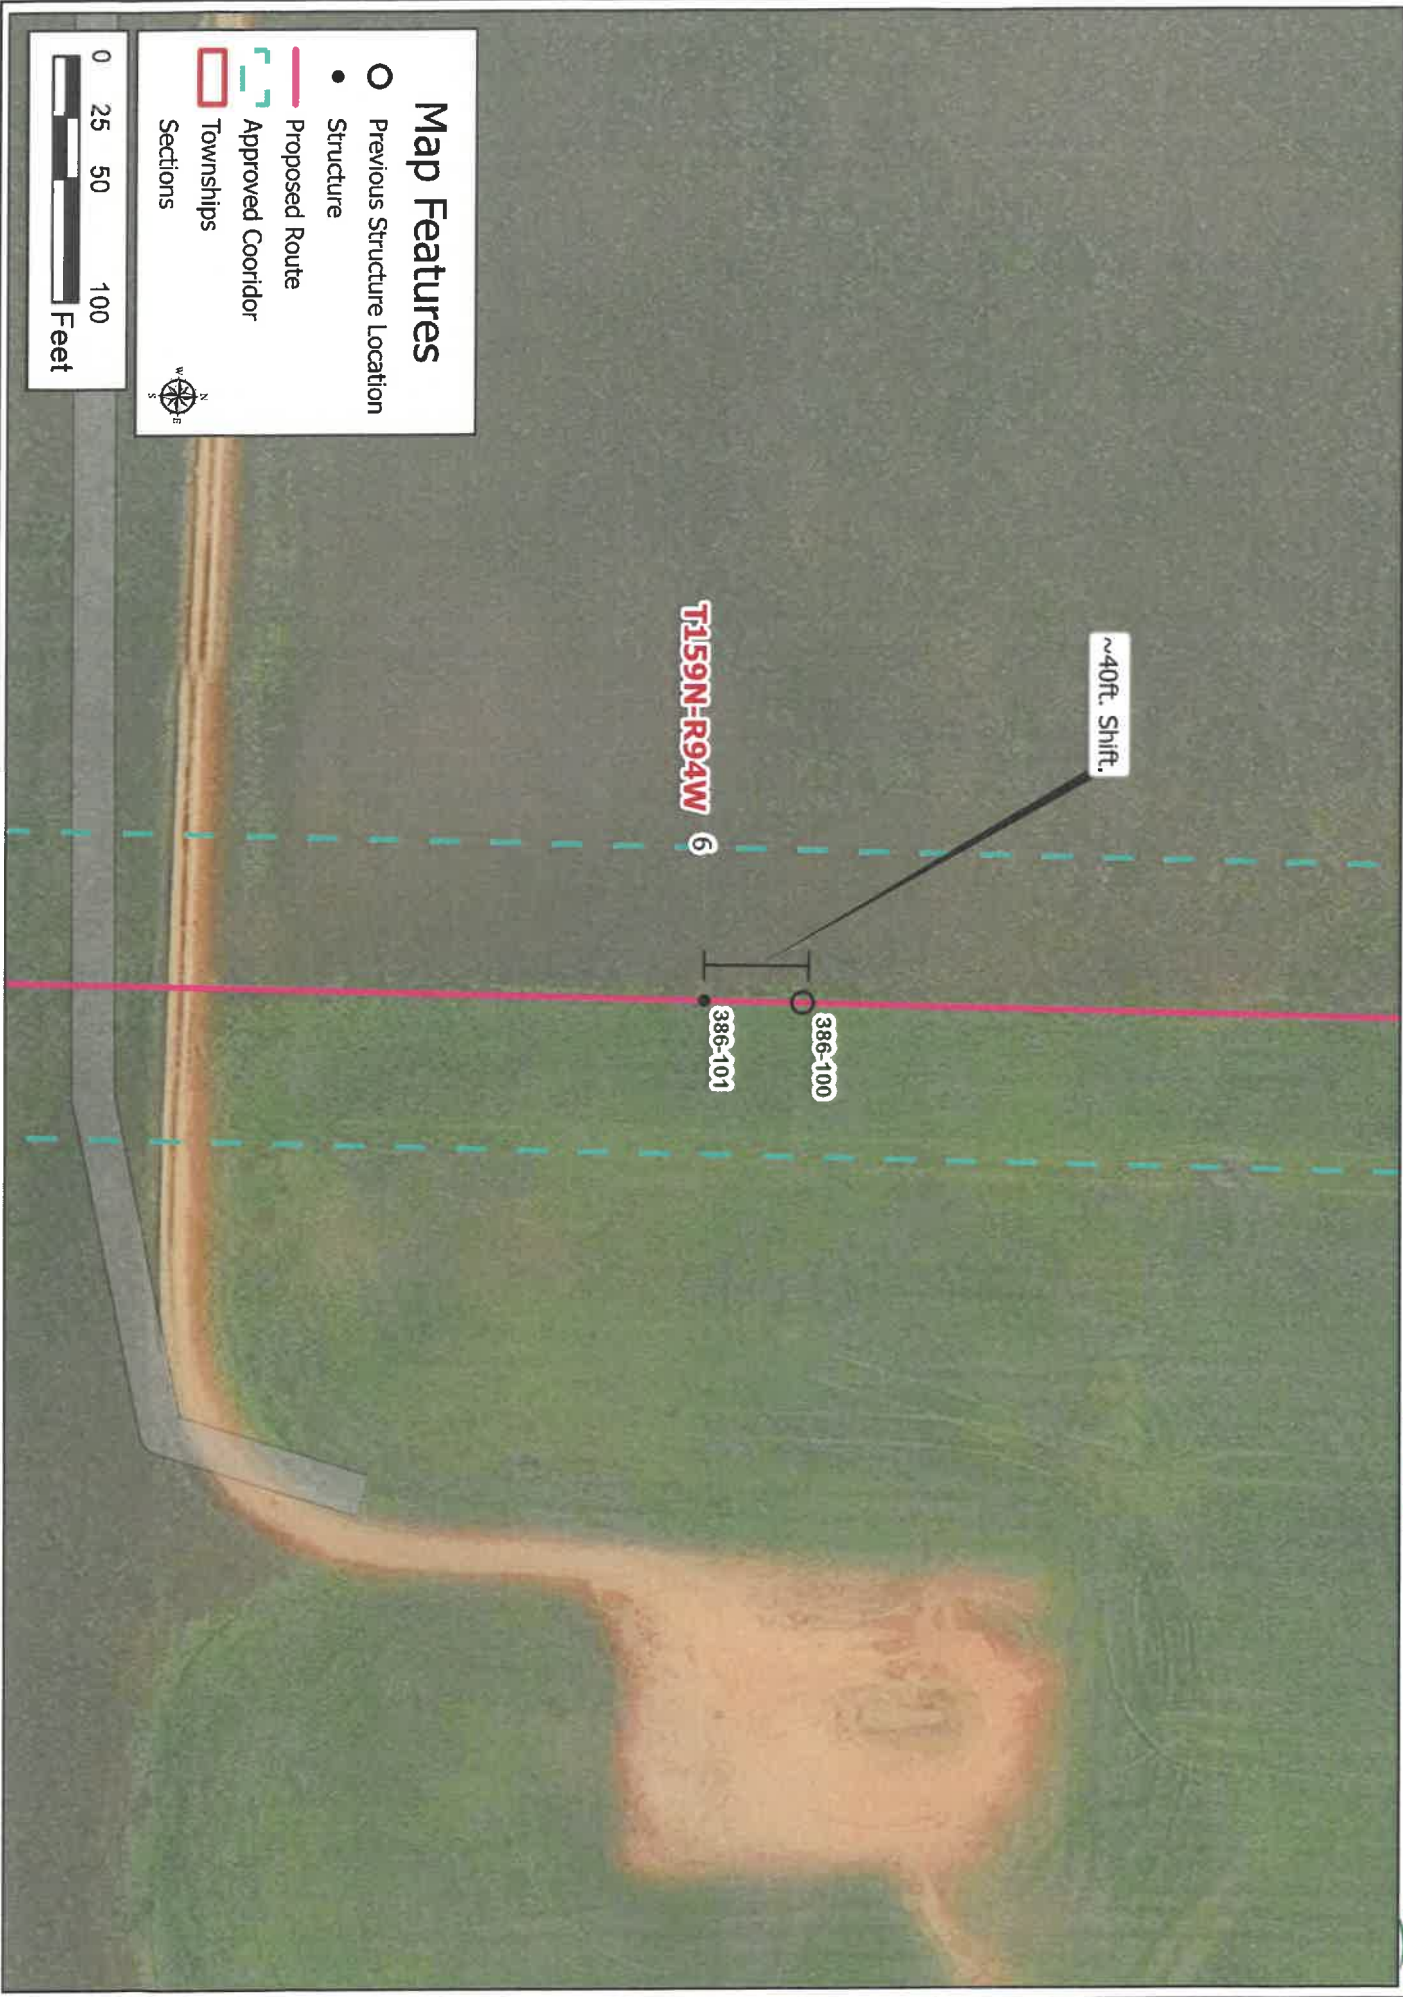


Tande-to-Saskatchewan 230-kV Transmission Project

Update Structure Location: 386-111



**BASIN ELECTRIC
POWER COOPERATIVE**
A Touchstone Energy® Cooperative

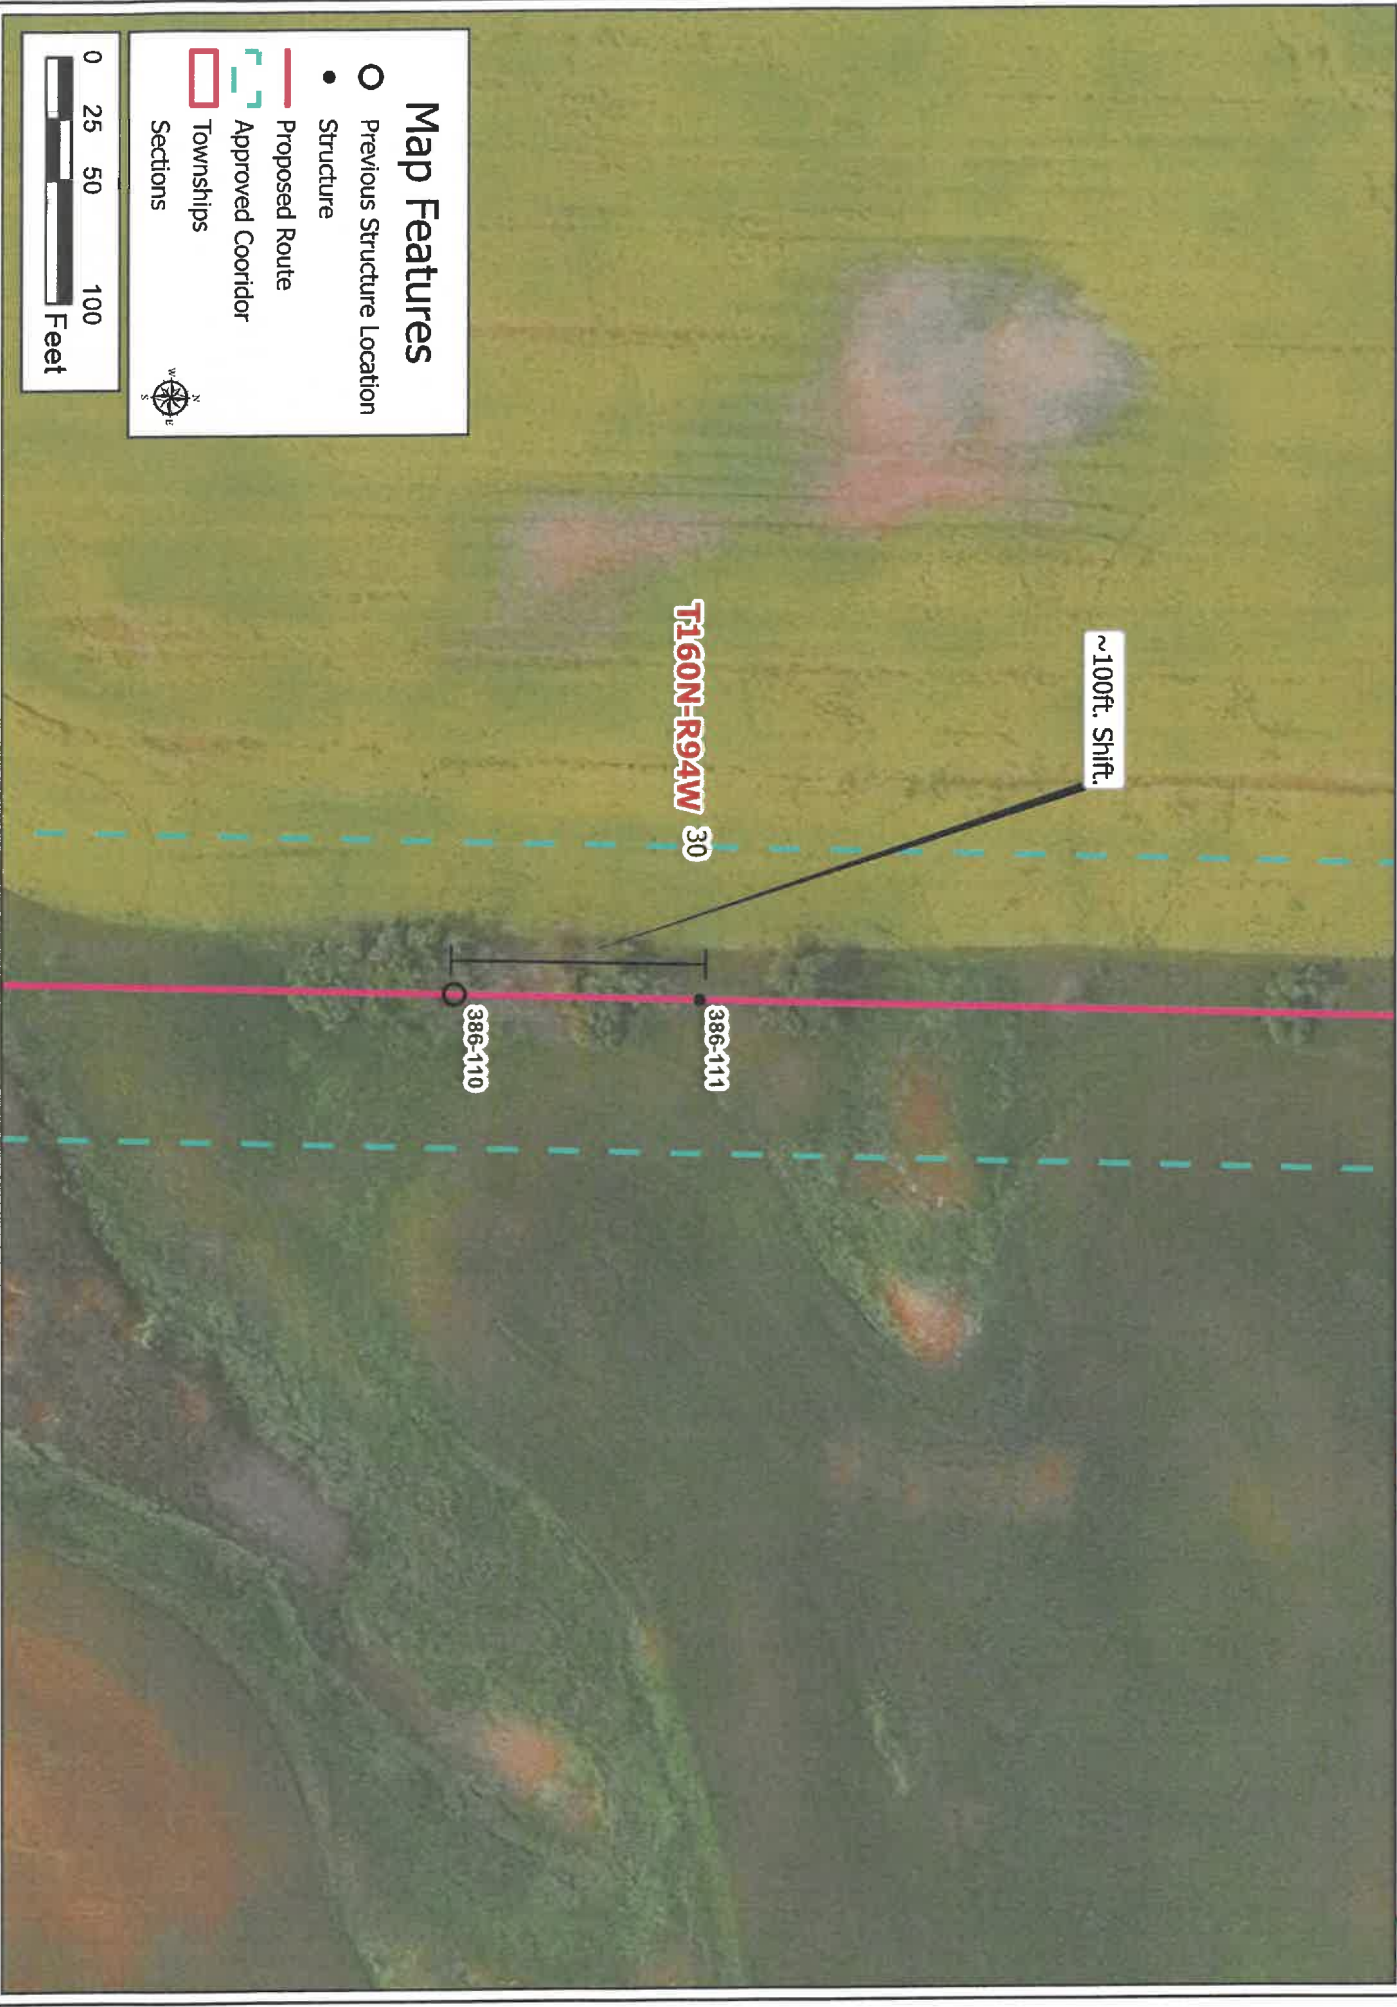

Map Features

- Previous Structure Location
- Structure
- Proposed Route
- - - Approved Corridor
- Townships
- Sections

0 25 50 100 Feet



Tande-to-Saskatchewan 230-kV Transmission Project

Update Structure Location: 386-115



**BASIN ELECTRIC
POWER COOPERATIVE**
A Touchstone Energy® Cooperative



Map Features

- Previous Structure Location
- Structure
- Proposed Route
- - - Approved Corridor
- Townships
- Sections




0 25 50 100
Feet

Tande-to-Saskatchewan 230-kV Transmission Project

Update Structure Location: 386-147



**BASIN ELECTRIC
POWER COOPERATIVE**
A Touchstone Energy® Cooperative

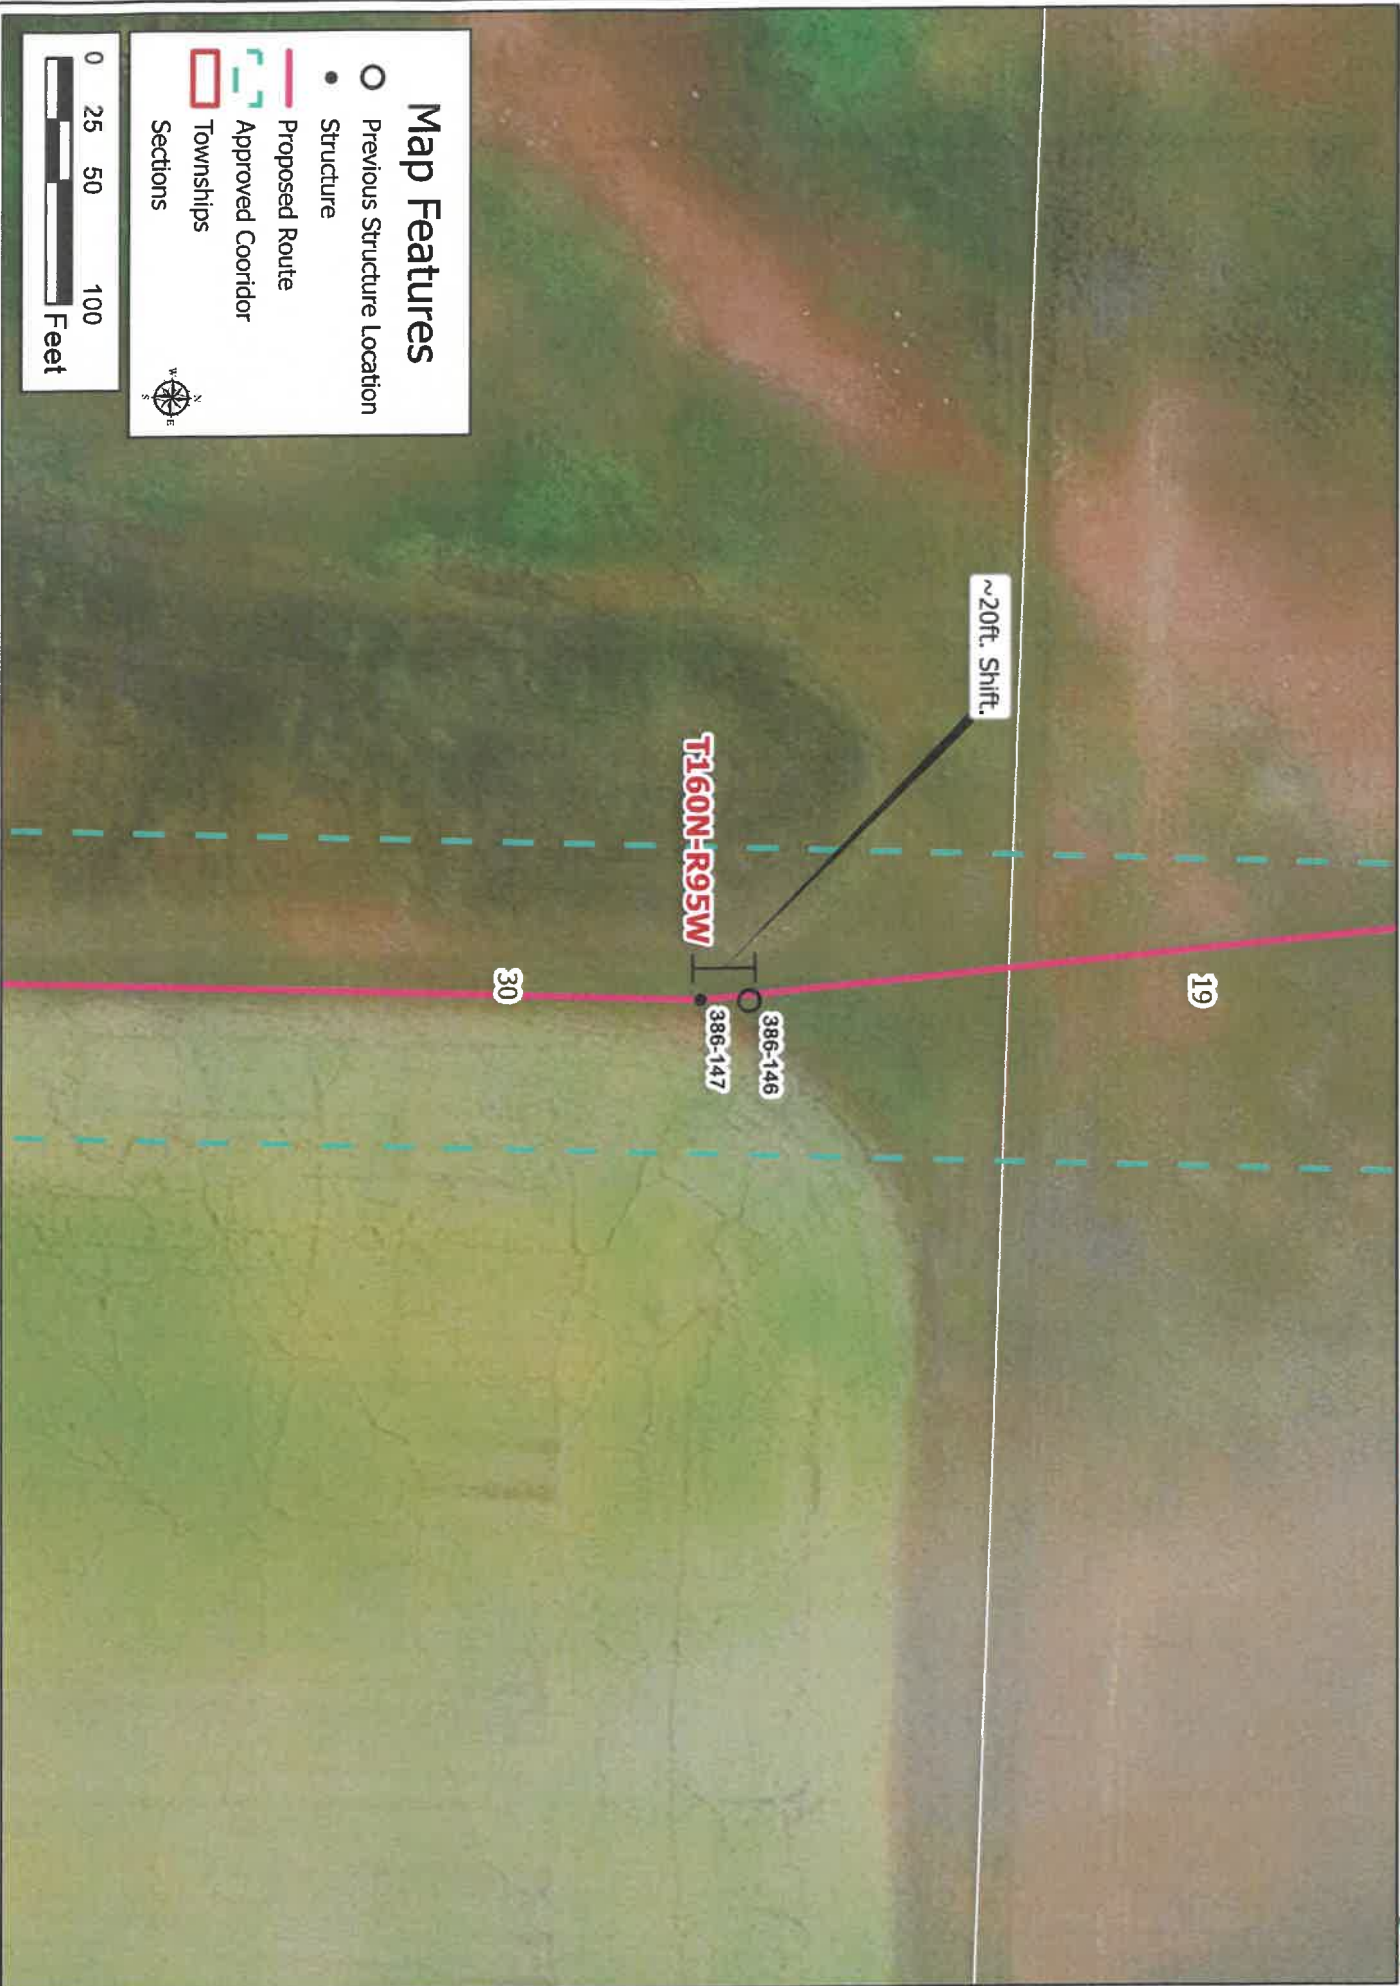

- ### Map Features
- Previous Structure Location
 - Structure
 - Proposed Route
 - - - Approved Corridor
 - Townships
- Sections




Tande-to-Saskatchewan 230-kV Transmission Project

Update Structure Location: 386-148



**BASIN ELECTRIC
POWER COOPERATIVE**
A Touchstone Energy® Cooperative

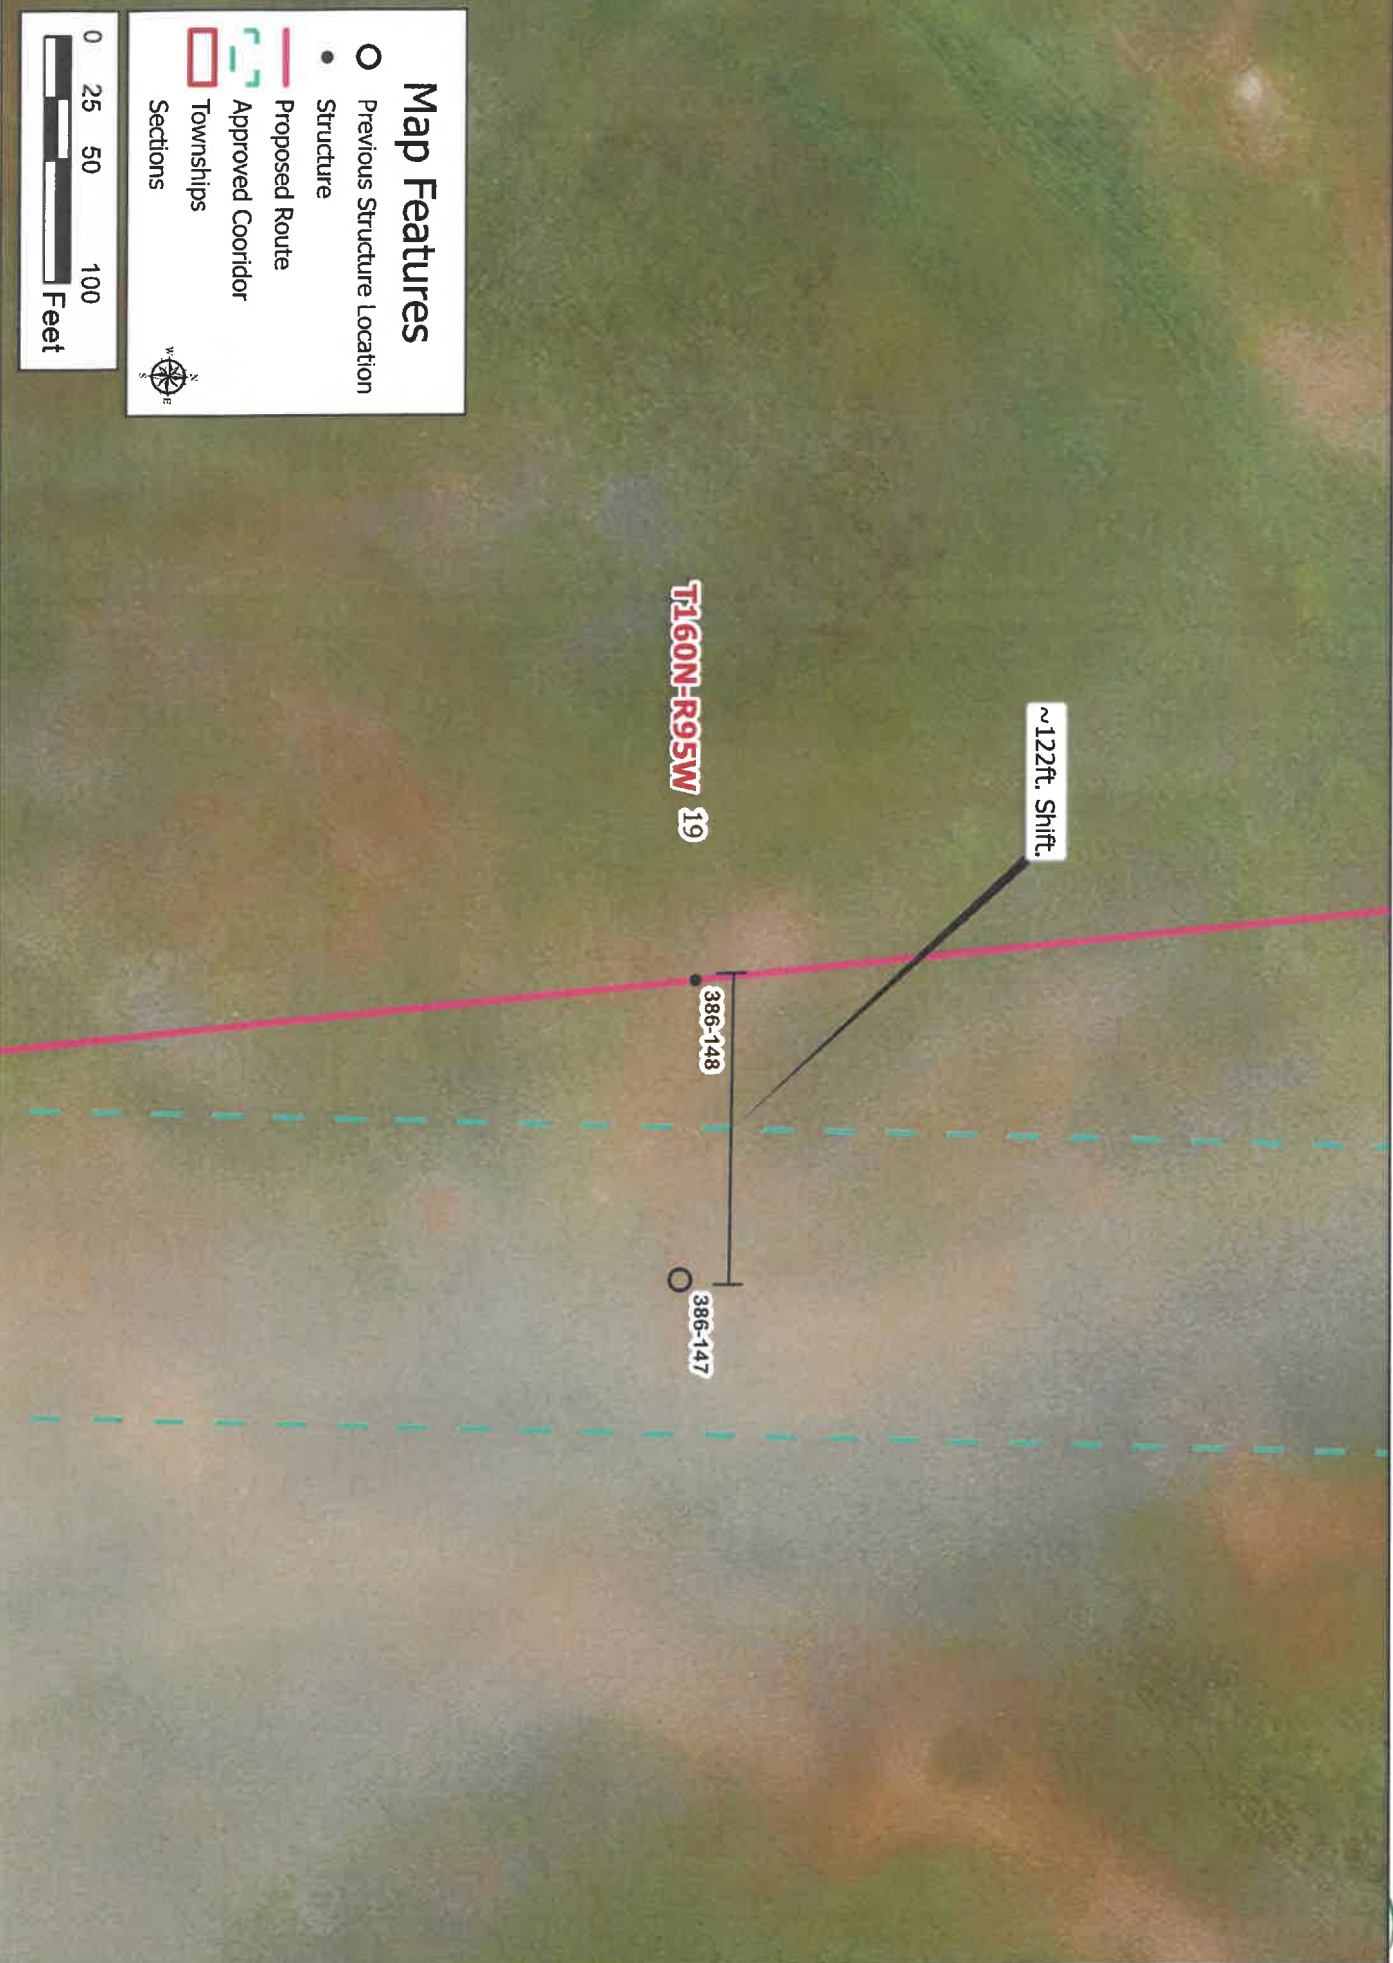

Tande-to-Saskatchewan 230-kV Transmission Project


Update Structure Location: 386-153



**BASIN ELECTRIC
POWER COOPERATIVE**
A Touchstone Energy® Cooperative

Map Features

- Previous Structure Location
- Structure
- Proposed Route
- - - Approved Corridor
- ▭ Townships
- ▭ Sections

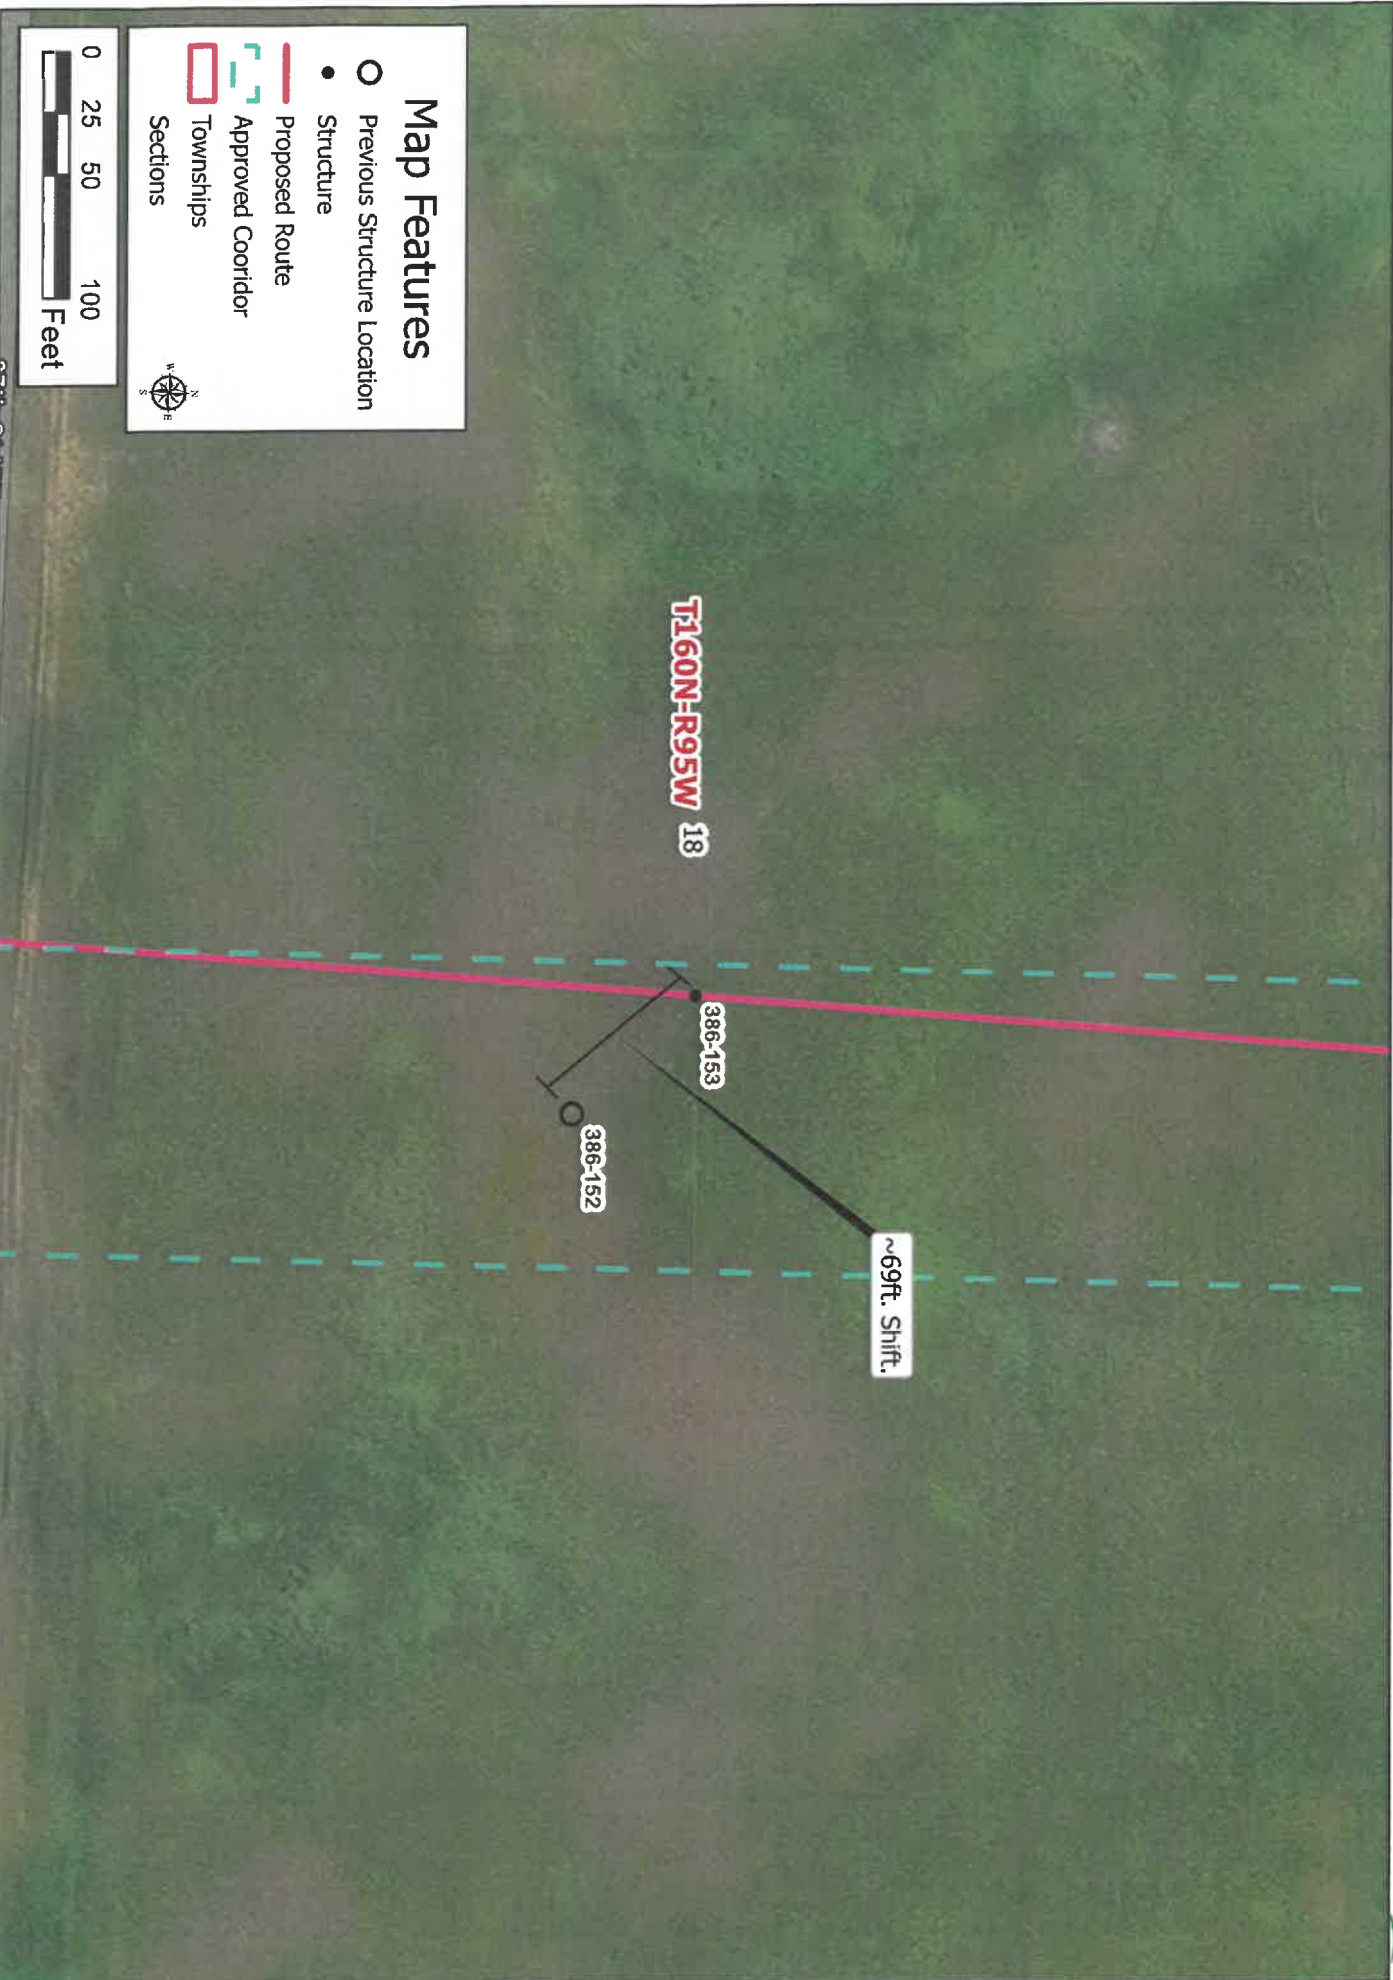

Tande-to-Saskatchewan 230-kV Transmission Project

Update Structure Location: 386-166



**BASIN ELECTRIC
POWER COOPERATIVE**
A Touchstone Energy® Cooperative



Map Features

- Previous Structure Location
- Structure
- Proposed Route
- - - Approved Corridor
- ▭ Townships
- Sections



0 25 50 100
Feet

Tande-to-Saskatchewan 230-kV Transmission Project

Update Structure Location: 386-180



**BASIN ELECTRIC
POWER COOPERATIVE**
A Touchstone Energy® Cooperative



Tande-to-Saskatchewan 230-kV Transmission Project

Update Structure Location: 386-226



**BASIN ELECTRIC
POWER COOPERATIVE**
A Touchstone Energy® Cooperative



Map Features

- Previous Structure Location
- Structure
- Proposed Route
- - - Approved Corridor
- Townships
- Sections




Tande-to-Saskatchewan 230-kV Transmission Project

Update Structure Location: 386-243



**BASIN ELECTRIC
POWER COOPERATIVE**
A Touchstone Energy® Cooperative

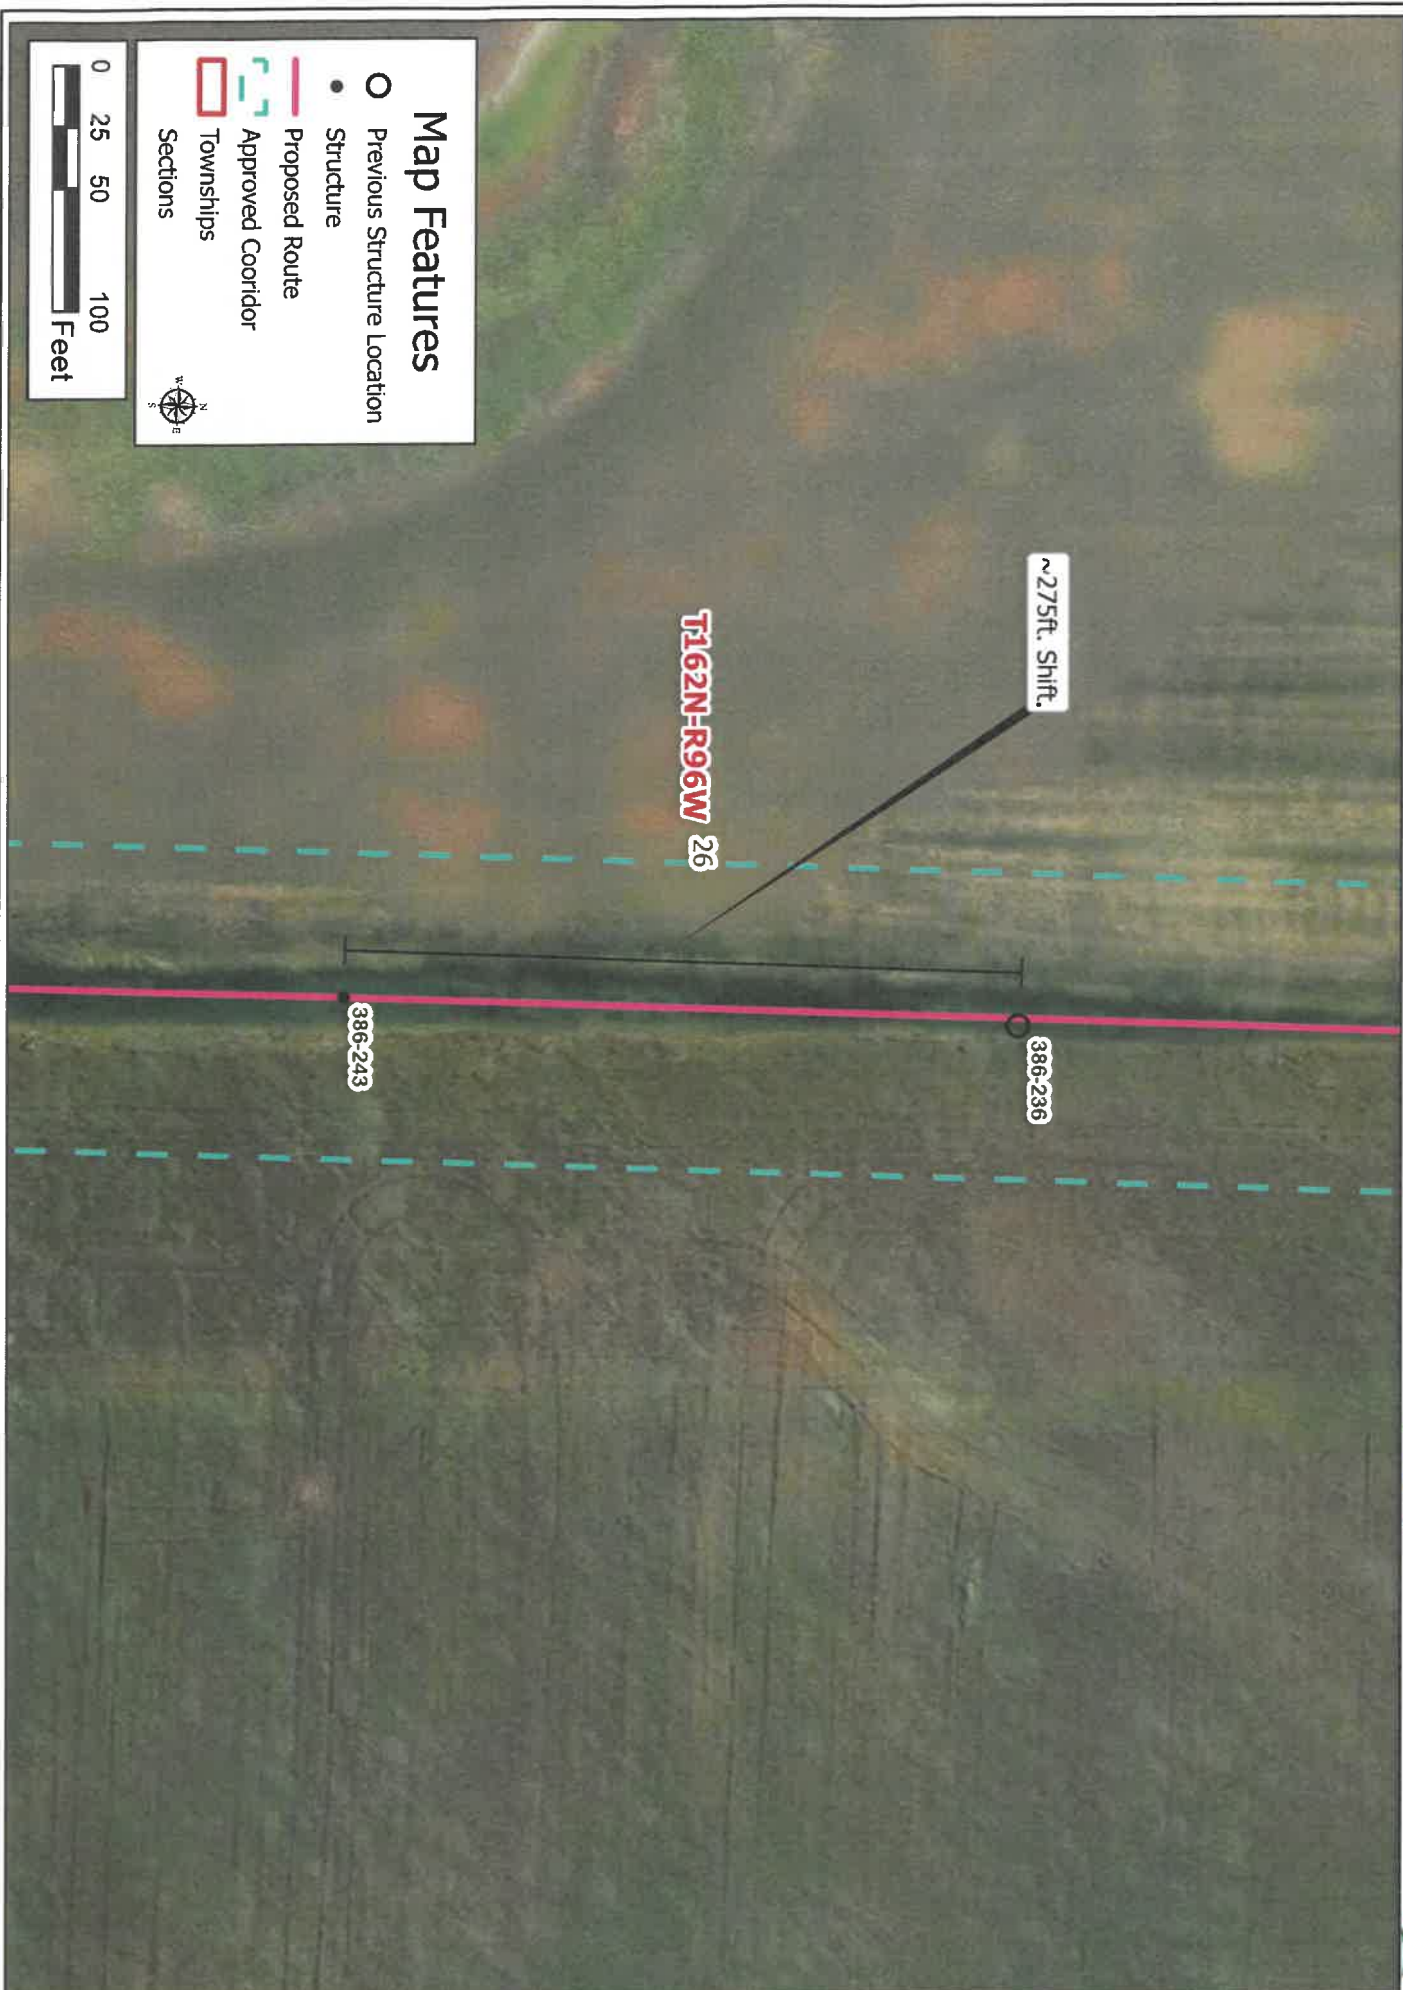

Map Features

- Previous Structure Location
 - Structure
 - Proposed Route
 - - - Approved Corridor
 - Townships
- Sections

0 25 50 100
Feet



Tande-to-Saskatchewan 230-kV Transmission Project

Update Structure Location: 386-244



**BASIN ELECTRIC
POWER COOPERATIVE**
A Touchstone Energy® Cooperative




Map Features

- Previous Structure Location
- Structure
- Proposed Route
- - - Approved Corridor
- Townships

0 25 50 100
Feet

Tande-to-Saskatchewan 230-kV Transmission Project

Update Structure Location: 386-245

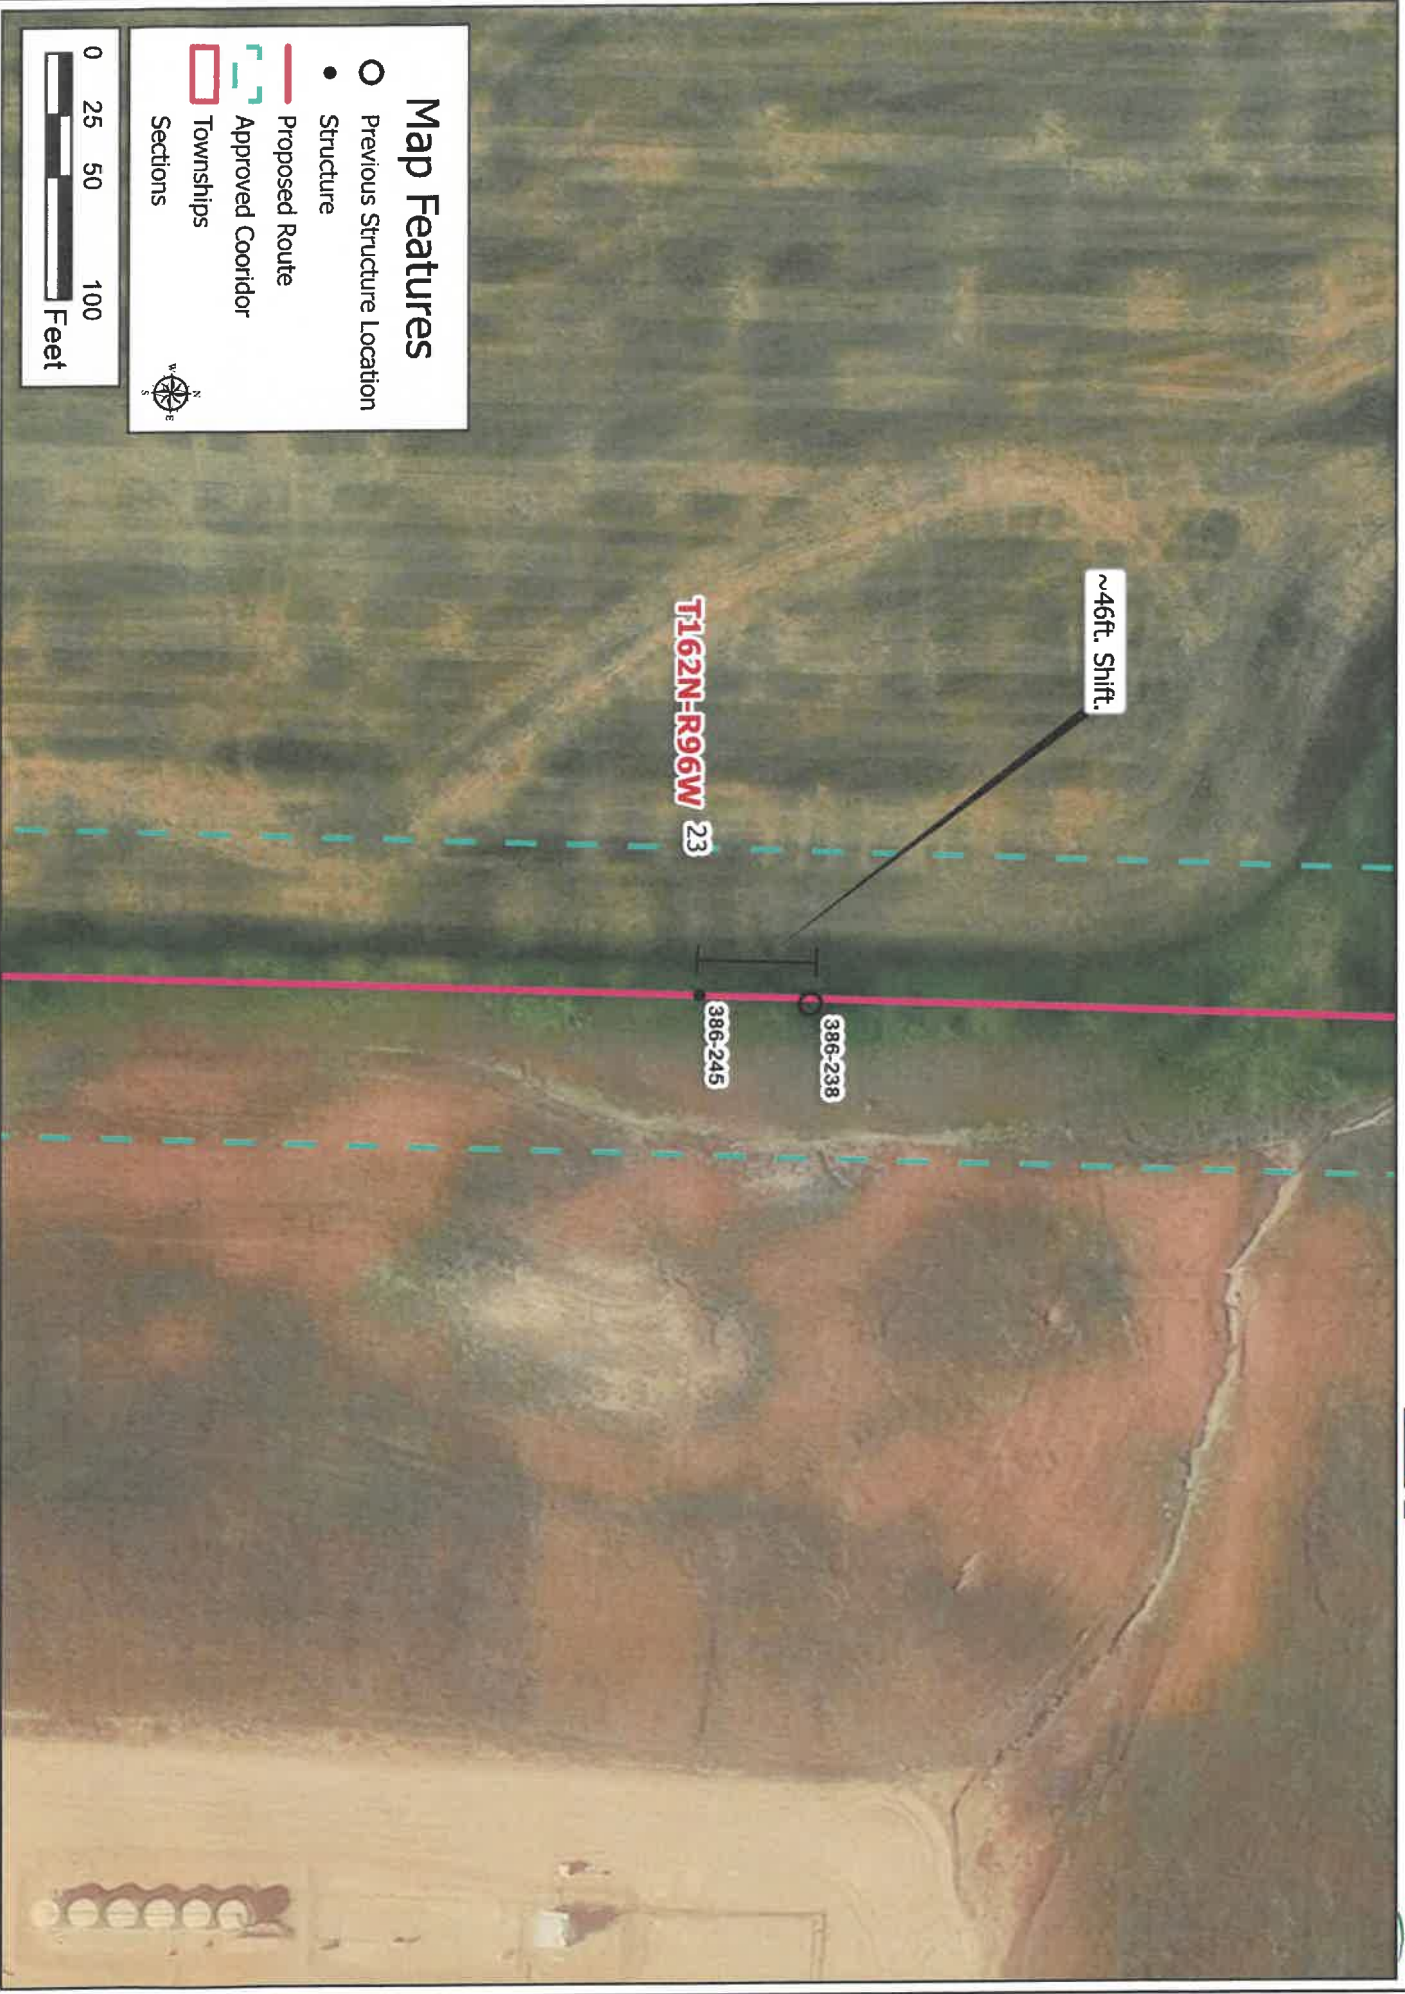


Tande-to-Saskatchewan 230-kV Transmission Project

Update Structure Location: 386-260



**BASIN ELECTRIC
POWER COOPERATIVE**
A Touchstone Energy® Cooperative

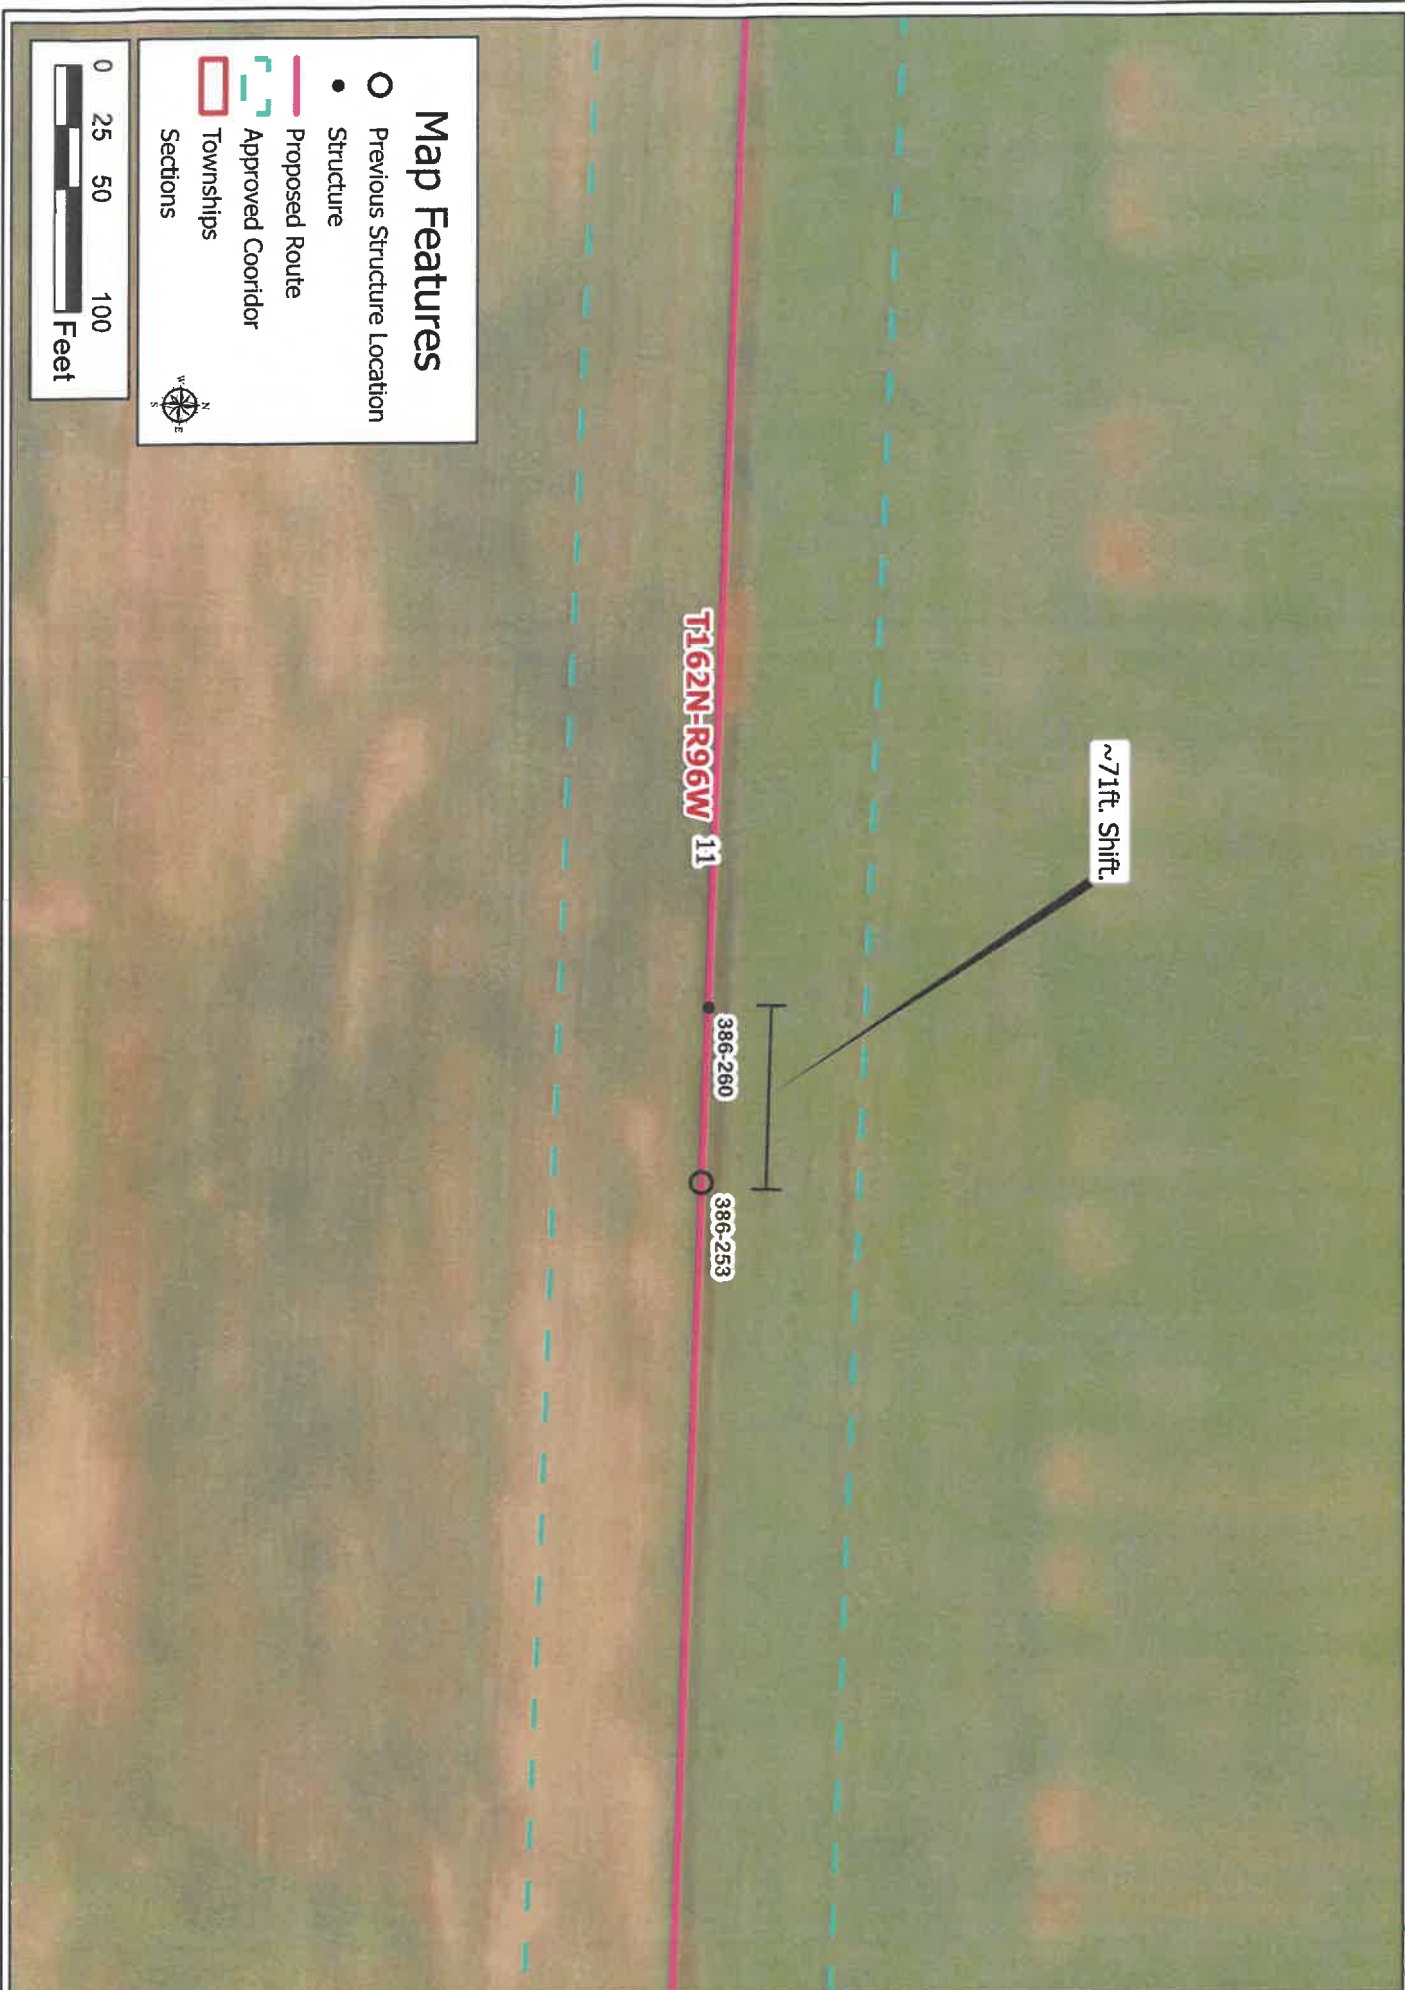


Tande-to-Saskatchewan 230-kV Transmission Project

Update Structure Location: 386-261



**BASIN ELECTRIC
POWER COOPERATIVE**
A Touchstone Energy® Cooperative

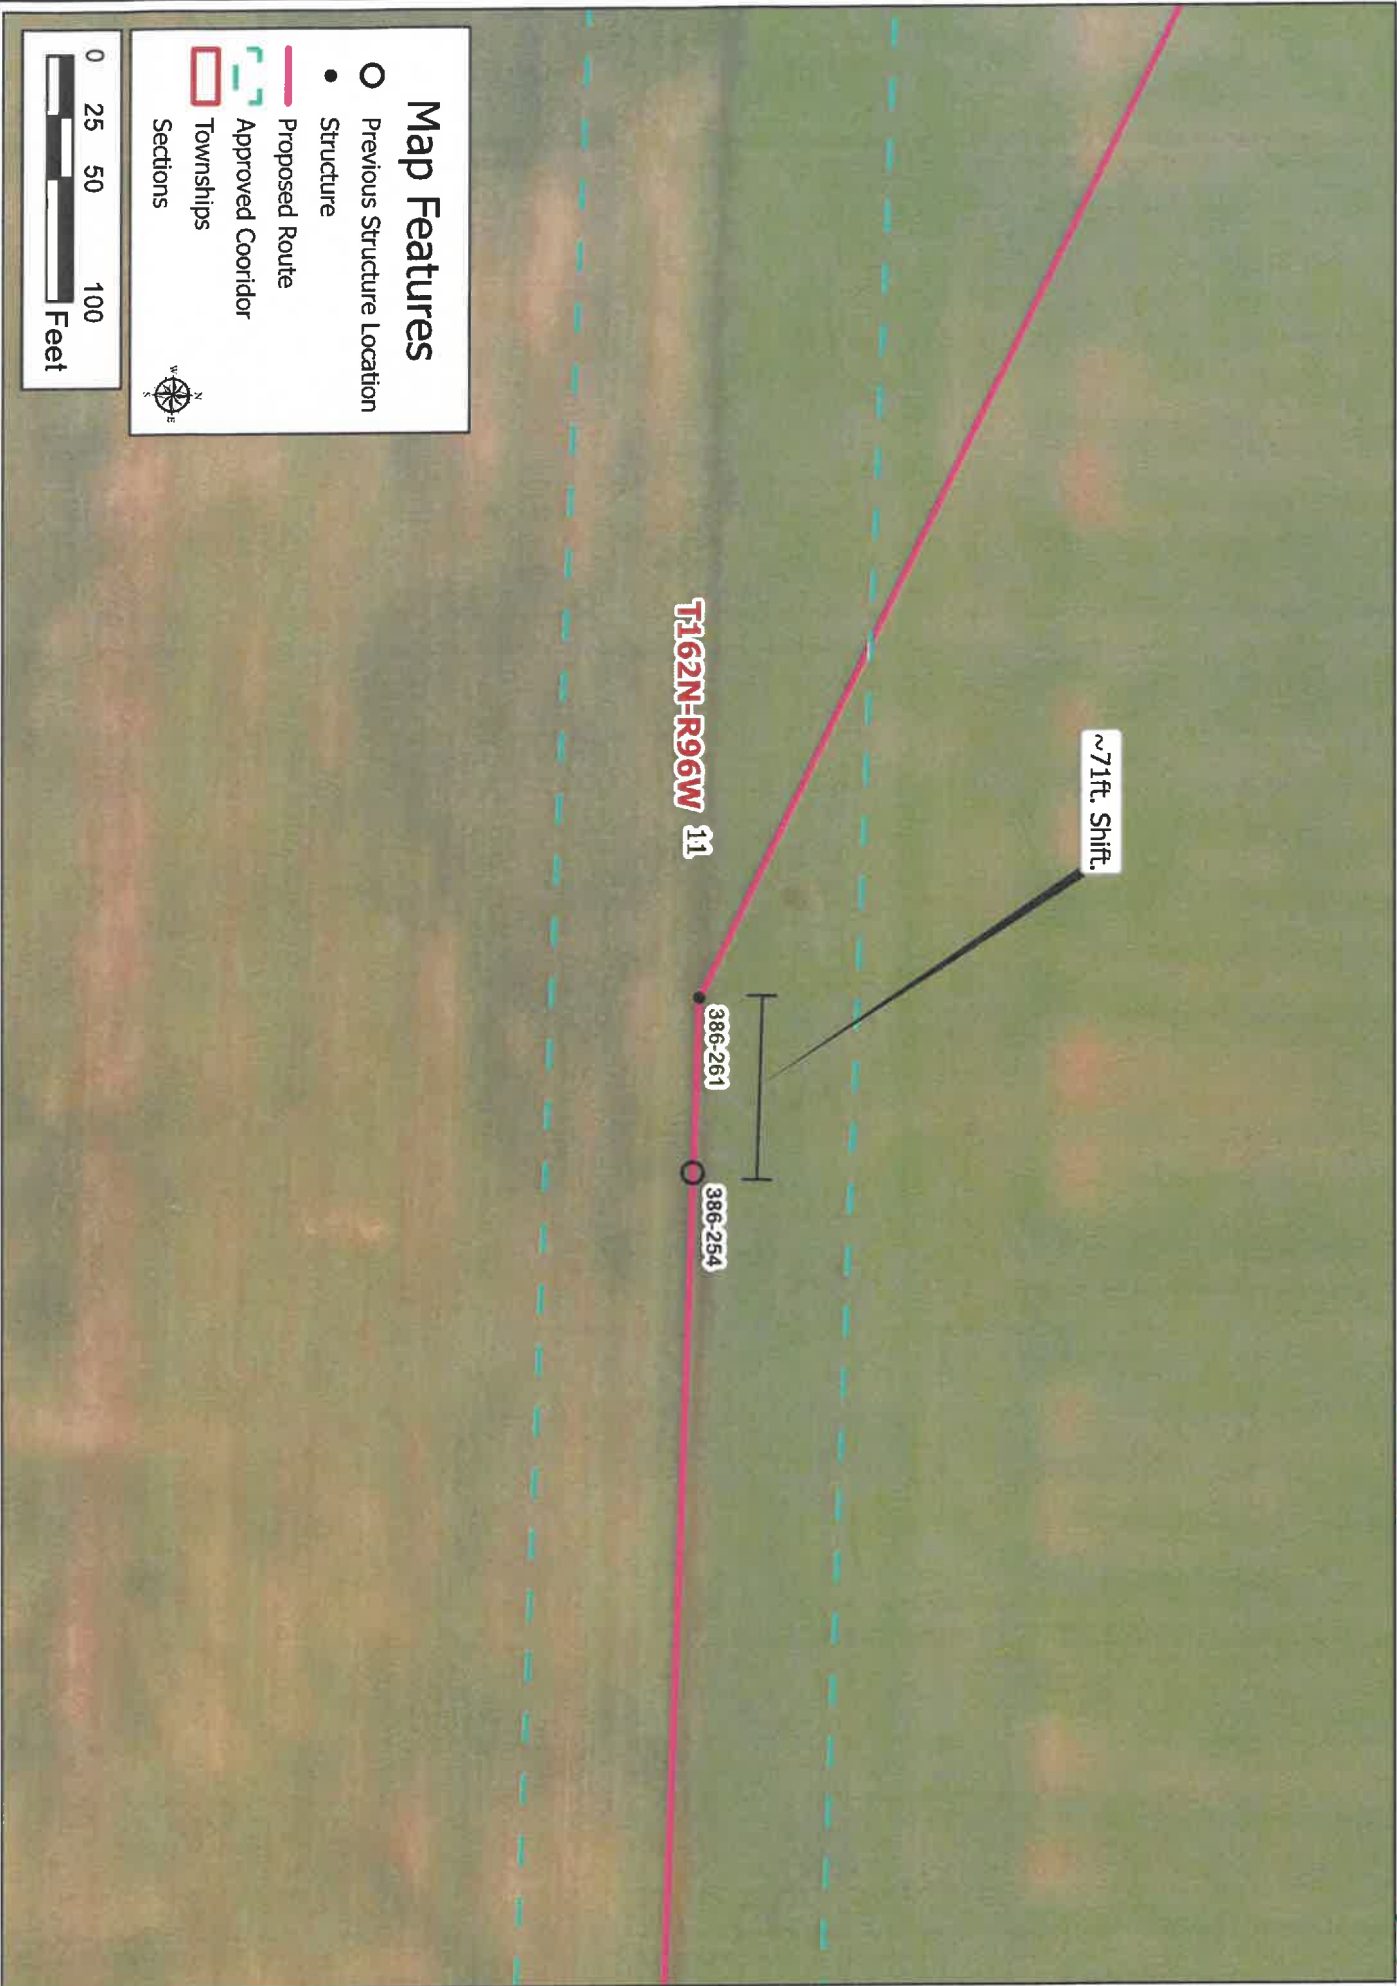


Map Features

- Previous Structure Location
- Structure
- Proposed Route
- - - Approved Corridor
- Townships
- Sections




Tande-to-Saskatchewan 230-kV Transmission Project

Update Structure Location: 386-262

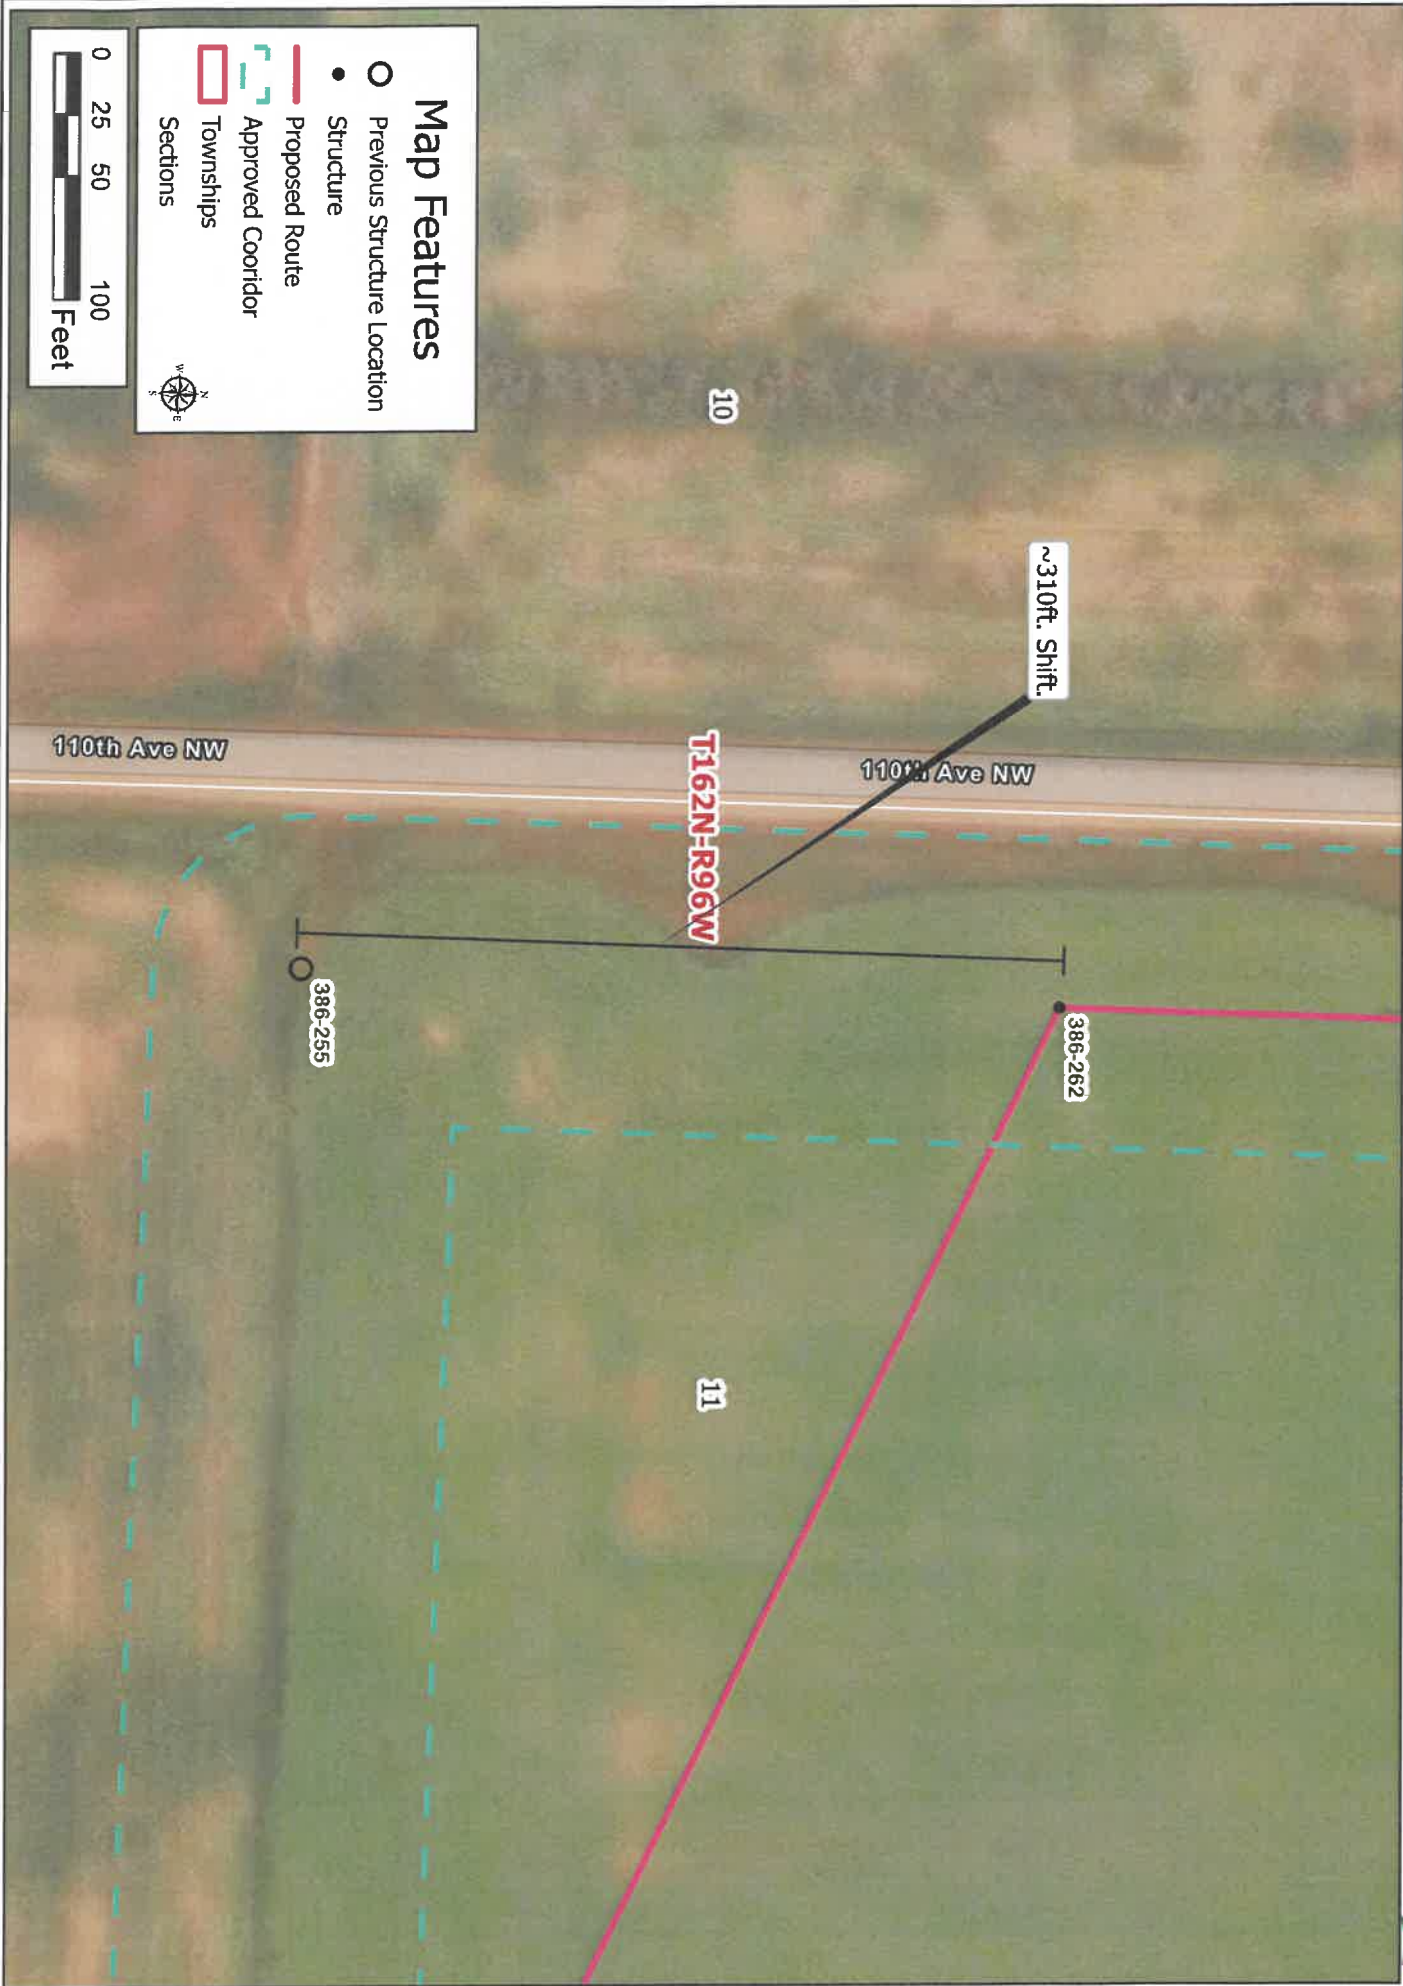

Tande-to-Saskatchewan 230-kV Transmission Project

Update Structure Location: 386-263

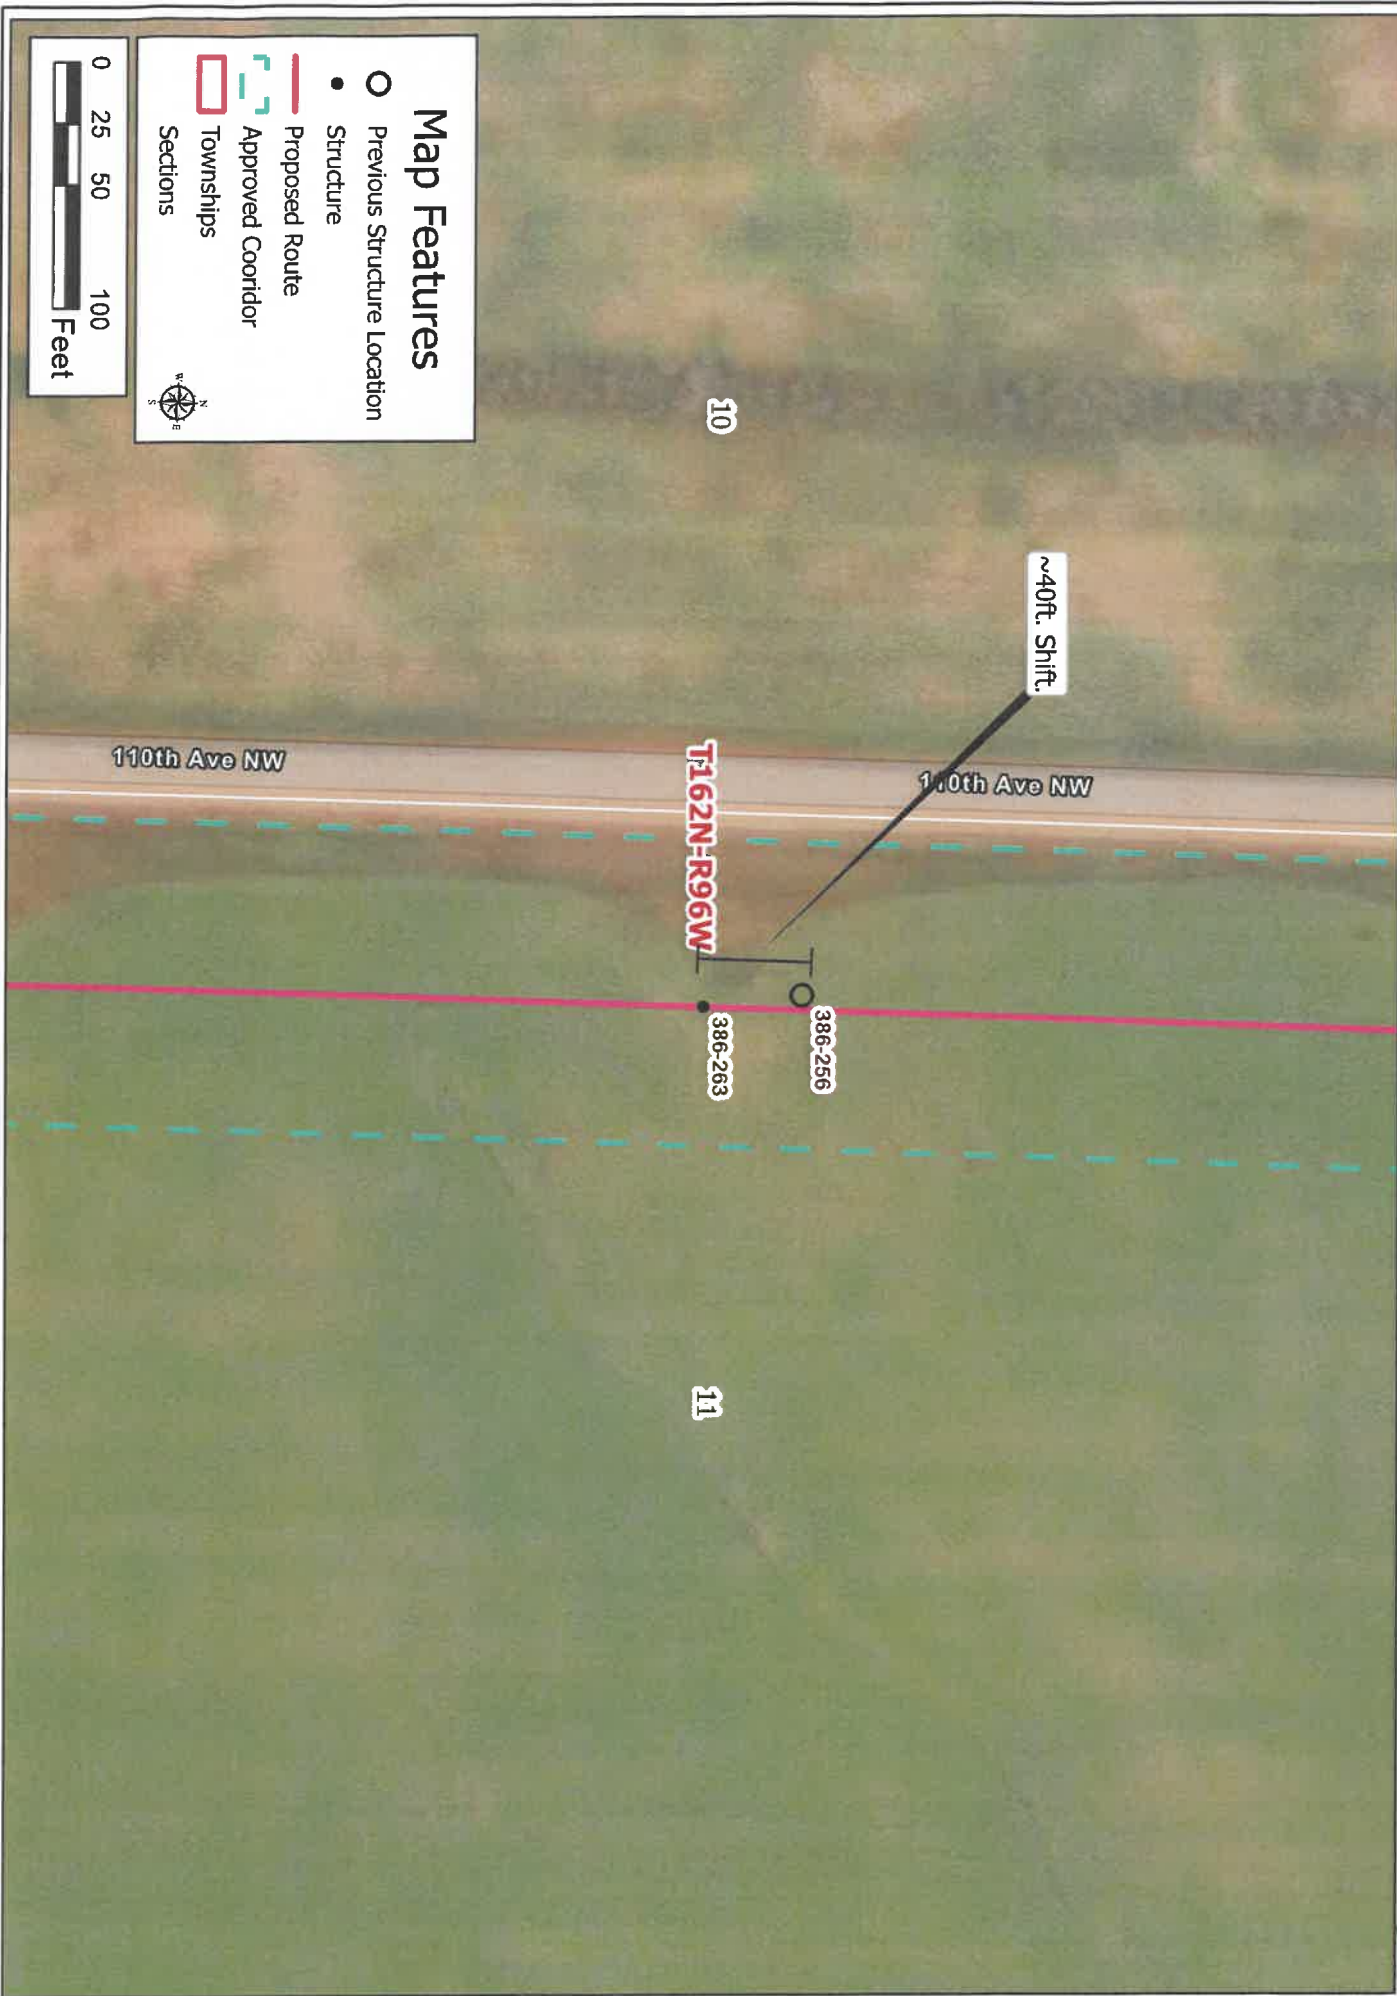

Tande-to-Saskatchewan 230-kV Transmission Project

Update Structure Location: 386-306



**BASIN ELECTRIC
POWER COOPERATIVE**
A Touchstone Energy® Cooperative



Map Features

- Previous Structure Location
- Structure
- Proposed Route
- - - Approved Corridor
- Townships
- Sections




0 25 50 100
Feet

Tande-to-Saskatchewan 230-kV Transmission Project


Update Structure Location: 386-310



**BASIN ELECTRIC
POWER COOPERATIVE**
A Touchstone Energy® Cooperative

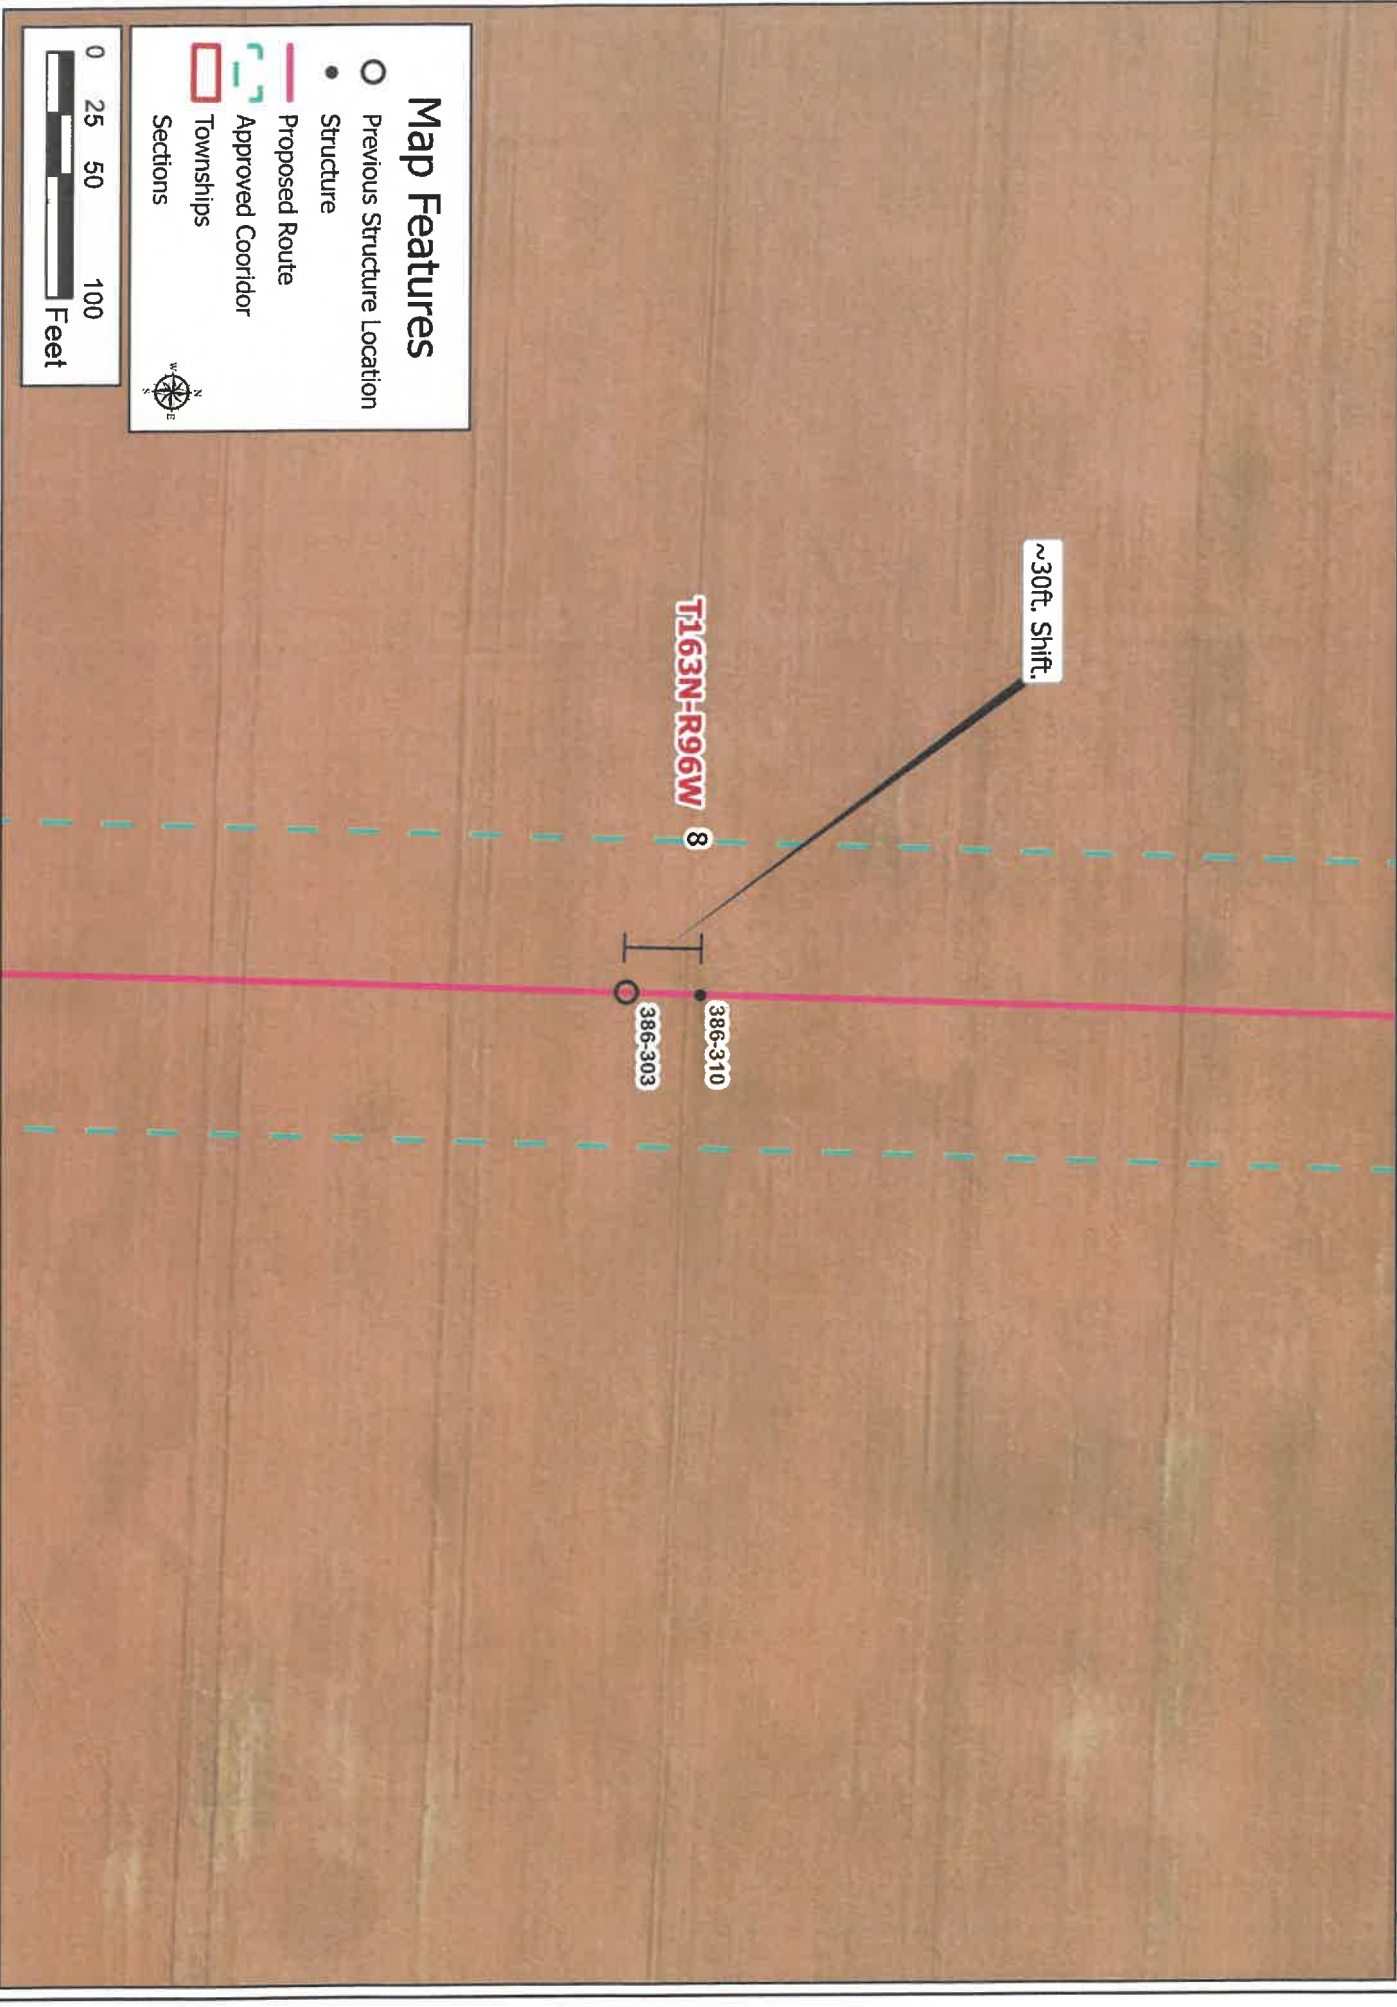

A Touchstone Energy® Cooperative

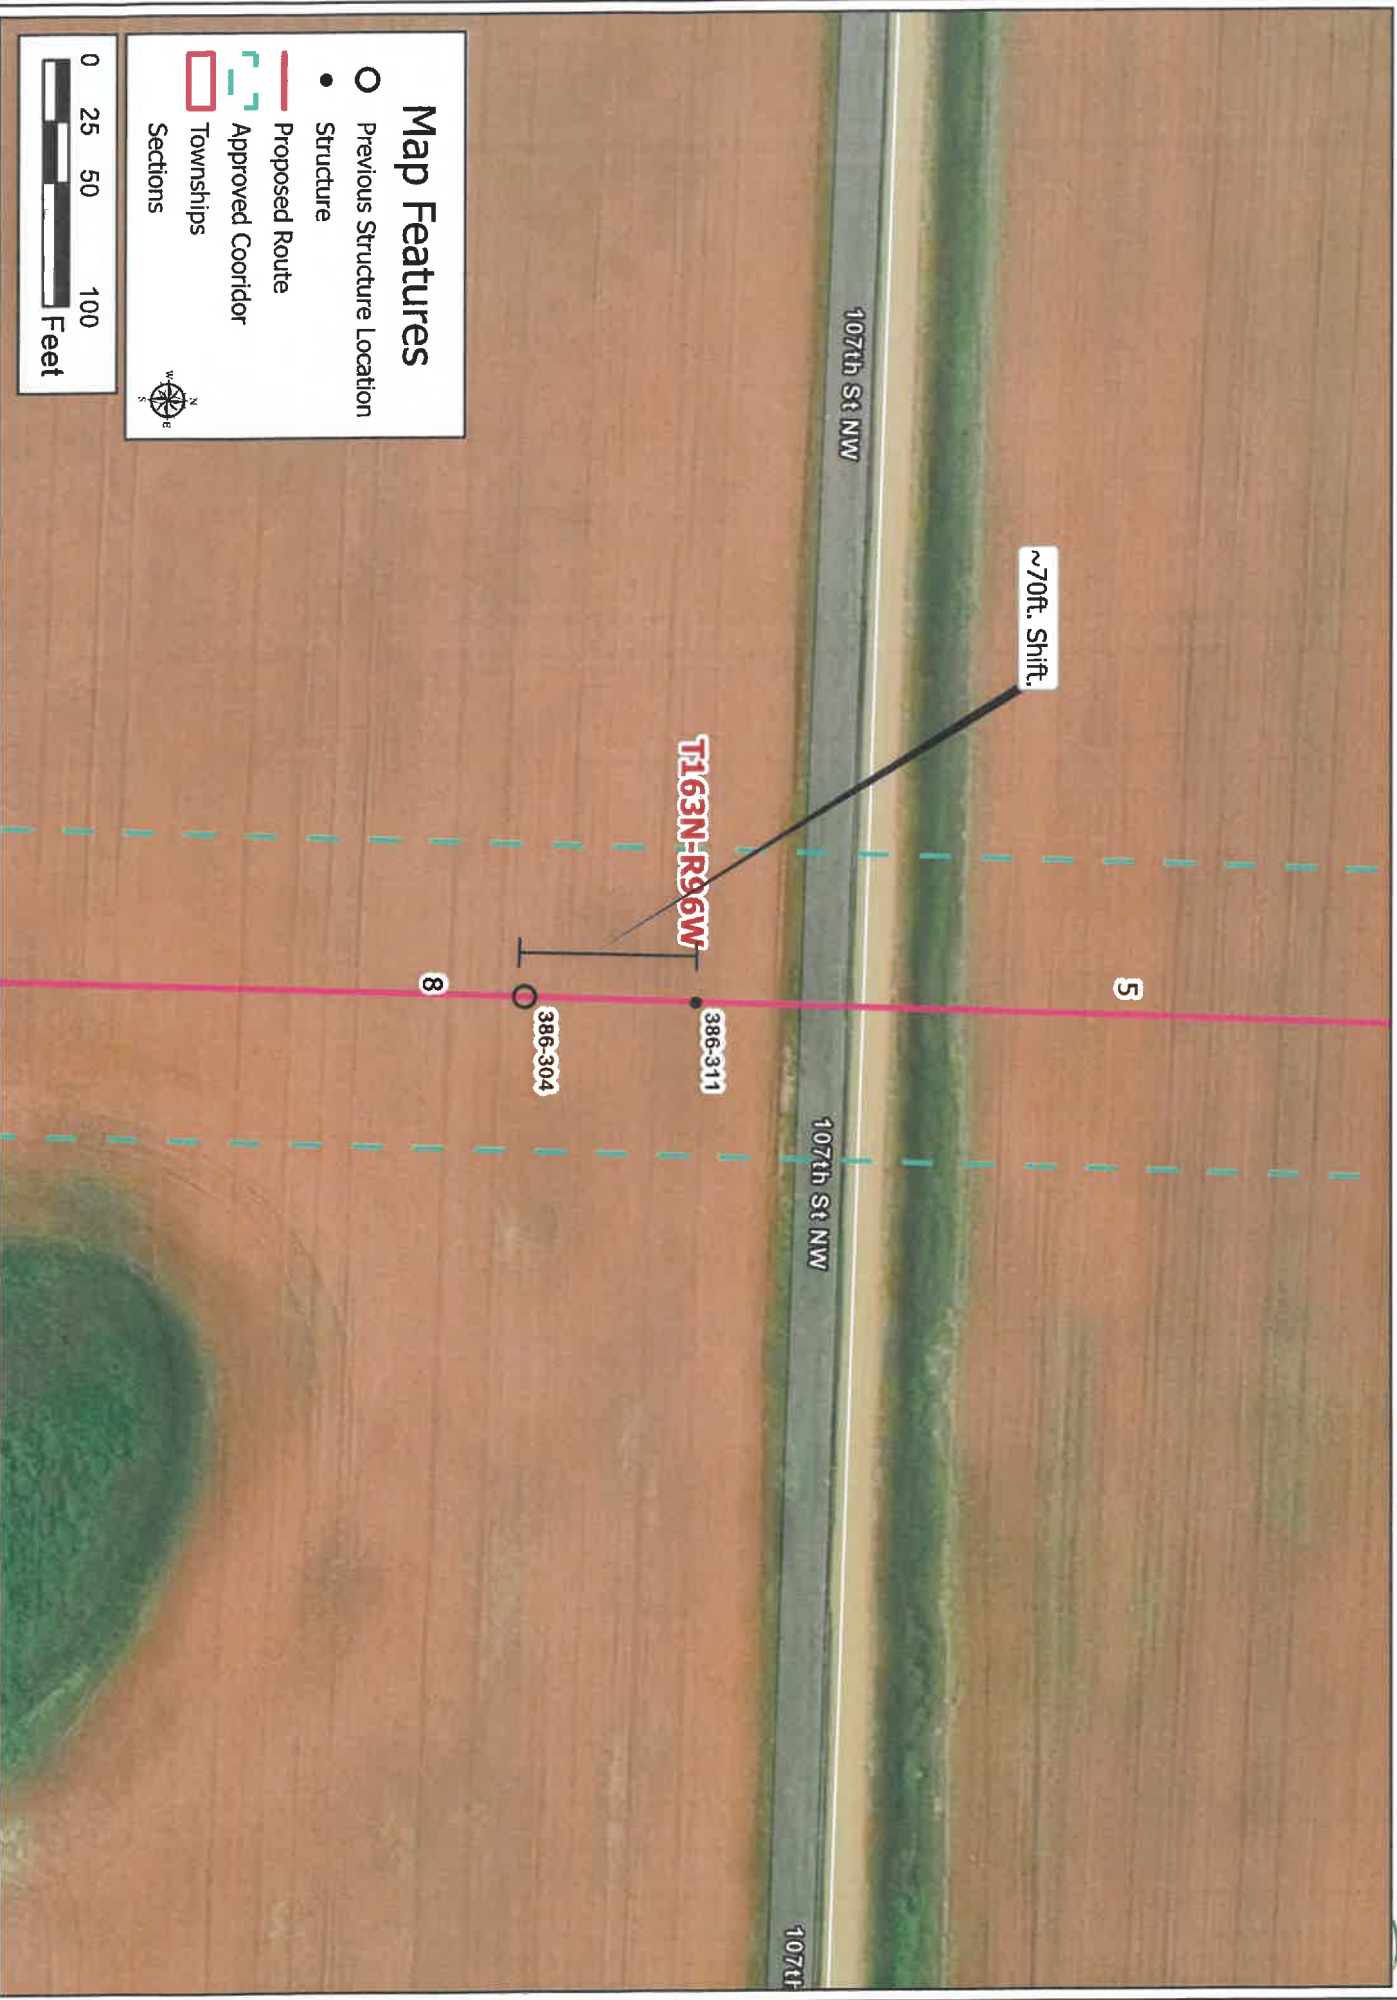

Tande-to-Saskatchewan 230-kV Transmission Project

Update Structure Location: 386-312



**BASIN ELECTRIC
POWER COOPERATIVE**
A Touchstone Energy® Cooperative

Map Features

- Previous Structure Location
- Structure
- Proposed Route
- - - Approved Corridor
- ▭ Townships
- ▭ Sections

