

October 2, 2026

Mr. Brian Johnson
 Executive Director
 North Dakota Public Service Commission
 600 East Boulevard: Department 408
 Bismarck, ND 58505-0480

Re: Case No. PU-25-284
 Basin Electric Power Cooperative
 Tande to Saskatchewan 230-kV Transmission Line Project

Dear Mr. Johnson:

In accordance with item 40 of the Certification Relating to Order Provisions, please accept this Structure Relocation request for Basin Electric Power Cooperative's (Basin Electric) Tande to Saskatchewan 230-kV Transmission Line Project (PU-25-284); eight structures within two reroutes are being relocated outside of the established corridor, as reflected in the Certificate of Corridor Compatibility Number 247. Reroute 1 is approximately 1,910 feet in length and includes three structures. Reroute 2 is approximately 5,000 feet in length and includes five structures. All structure locations are within the original survey area for cultural resources and natural resources. The North Dakota State Historic Preservation Office (NDSHPO) has agreed with the mitigation measures proposed for all sites within the original corridor and within these reroute areas. NDSHPO concurrence letters were filed with the original application. The attached Exhibit A and Exhibit B illustrate the exclusion and avoidance areas that will be avoided within the reroute areas. All landowner easements have been adjusted accordingly and have been signed and received.

As previously explained in a separate route adjustment filing, Basin Electric added a structure, causing the structure numbers to increase by one in both reroute locations. Please see the table below and attached figures showing the adjusted structure locations and numbers.

Previous Structure Number	New Structure Number	Location	Relocation (ft)	Reason for Relocation
386-111	386-112	T160N, R94W, S30	203	Landowner Request
386-112	386-113	T160N, R94W, S30	148	Landowner Request
386-113	386-114	T160N, R94W, S30	97	Landowner Request
386-147	386-148	T160, R95W, S19	122	Landowner Request
386-148	386-149	T160, R95W, S19	246	Landowner Request
386-149	386-150	T160, R95W, S19	211	Landowner Request
386-150	386-151	T160, R95W, S19	171	Landowner Request
386-151	386-152	T160, R95W, S19	141	Landowner Request

A notarized Certification that Basin Electric Power Cooperative will comply with the Commissioner's order, law and rules designating the corridor and route is attached. If you have

October 1, 2026

Page 2

any questions or require additional information for this submittal, please contact me at rking@bepc.com or 701-557-5558.

Sincerely,



Ryan King
Environmental Coordinator

Attachments: Certification of Applicant
Exhibit A
Exhibit B



CERTIFICATION OF APPLICANT – TRANSMISSION FACILITY SITING

Case No. PU-25-284

BASIN ELECTRIC POWER COOPERATIVE

I, Bobby Nasset, Manager, Civil & Transmission Line Engineering, a duly authorized agent of Basin Electric Power Cooperative that has authority to bind the company in these matters, do hereby certify under oath:


1. That the relocation of the structures on the Tande to Saskatchewan 230-kV Transmission Line (PU-25-284) will not affect any known exclusion or avoidance areas as defined under the North Dakota Administrative Code § 69-06-08-02(1) and (2).
2. That supporting documents including maps meeting the requirements of North Dakota Administrative Code § 69-06-04-01(2)(n) identifying the designated corridor, corridor adjustment, designated route and the route adjustment are included as Exhibit A and Exhibit B.
3. That each owner of real property on which the adjustment is to be located and any applicable governmental entity with an interest in the same adjustment area do not oppose the adjustment.
4. That Basin Electric Power Cooperative will comply with all applicable conditions and protections in North Dakota siting laws and rules and the Commission's previously issued order, law and rules designating the corridor and route.

Dates at Bismarck, North Dakota this 2nd day of October, 2026.

Bobby Nasset
Manager, Civil & Transmission Line Engineering

STATE OF NORTH DAKOTA)
)ss.
COUNTY OF BURLEIGH)

This instrument was acknowledged before me this 2nd day of October, 2026 by Bobby Nasset on behalf of Basin Electric Power Cooperative.

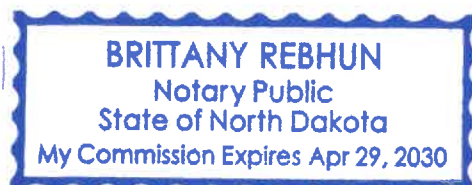
Notary Public

Tande-to-Saskatchewan 230-kV Transmission Project

Update Structure Location: 386-112 thru 386-114


Length of Route Adjustment : 1,909.5ft

Exhibit A



**BASIN ELECTRIC
POWER COOPERATIVE**

A Touchstone Energy® Cooperative

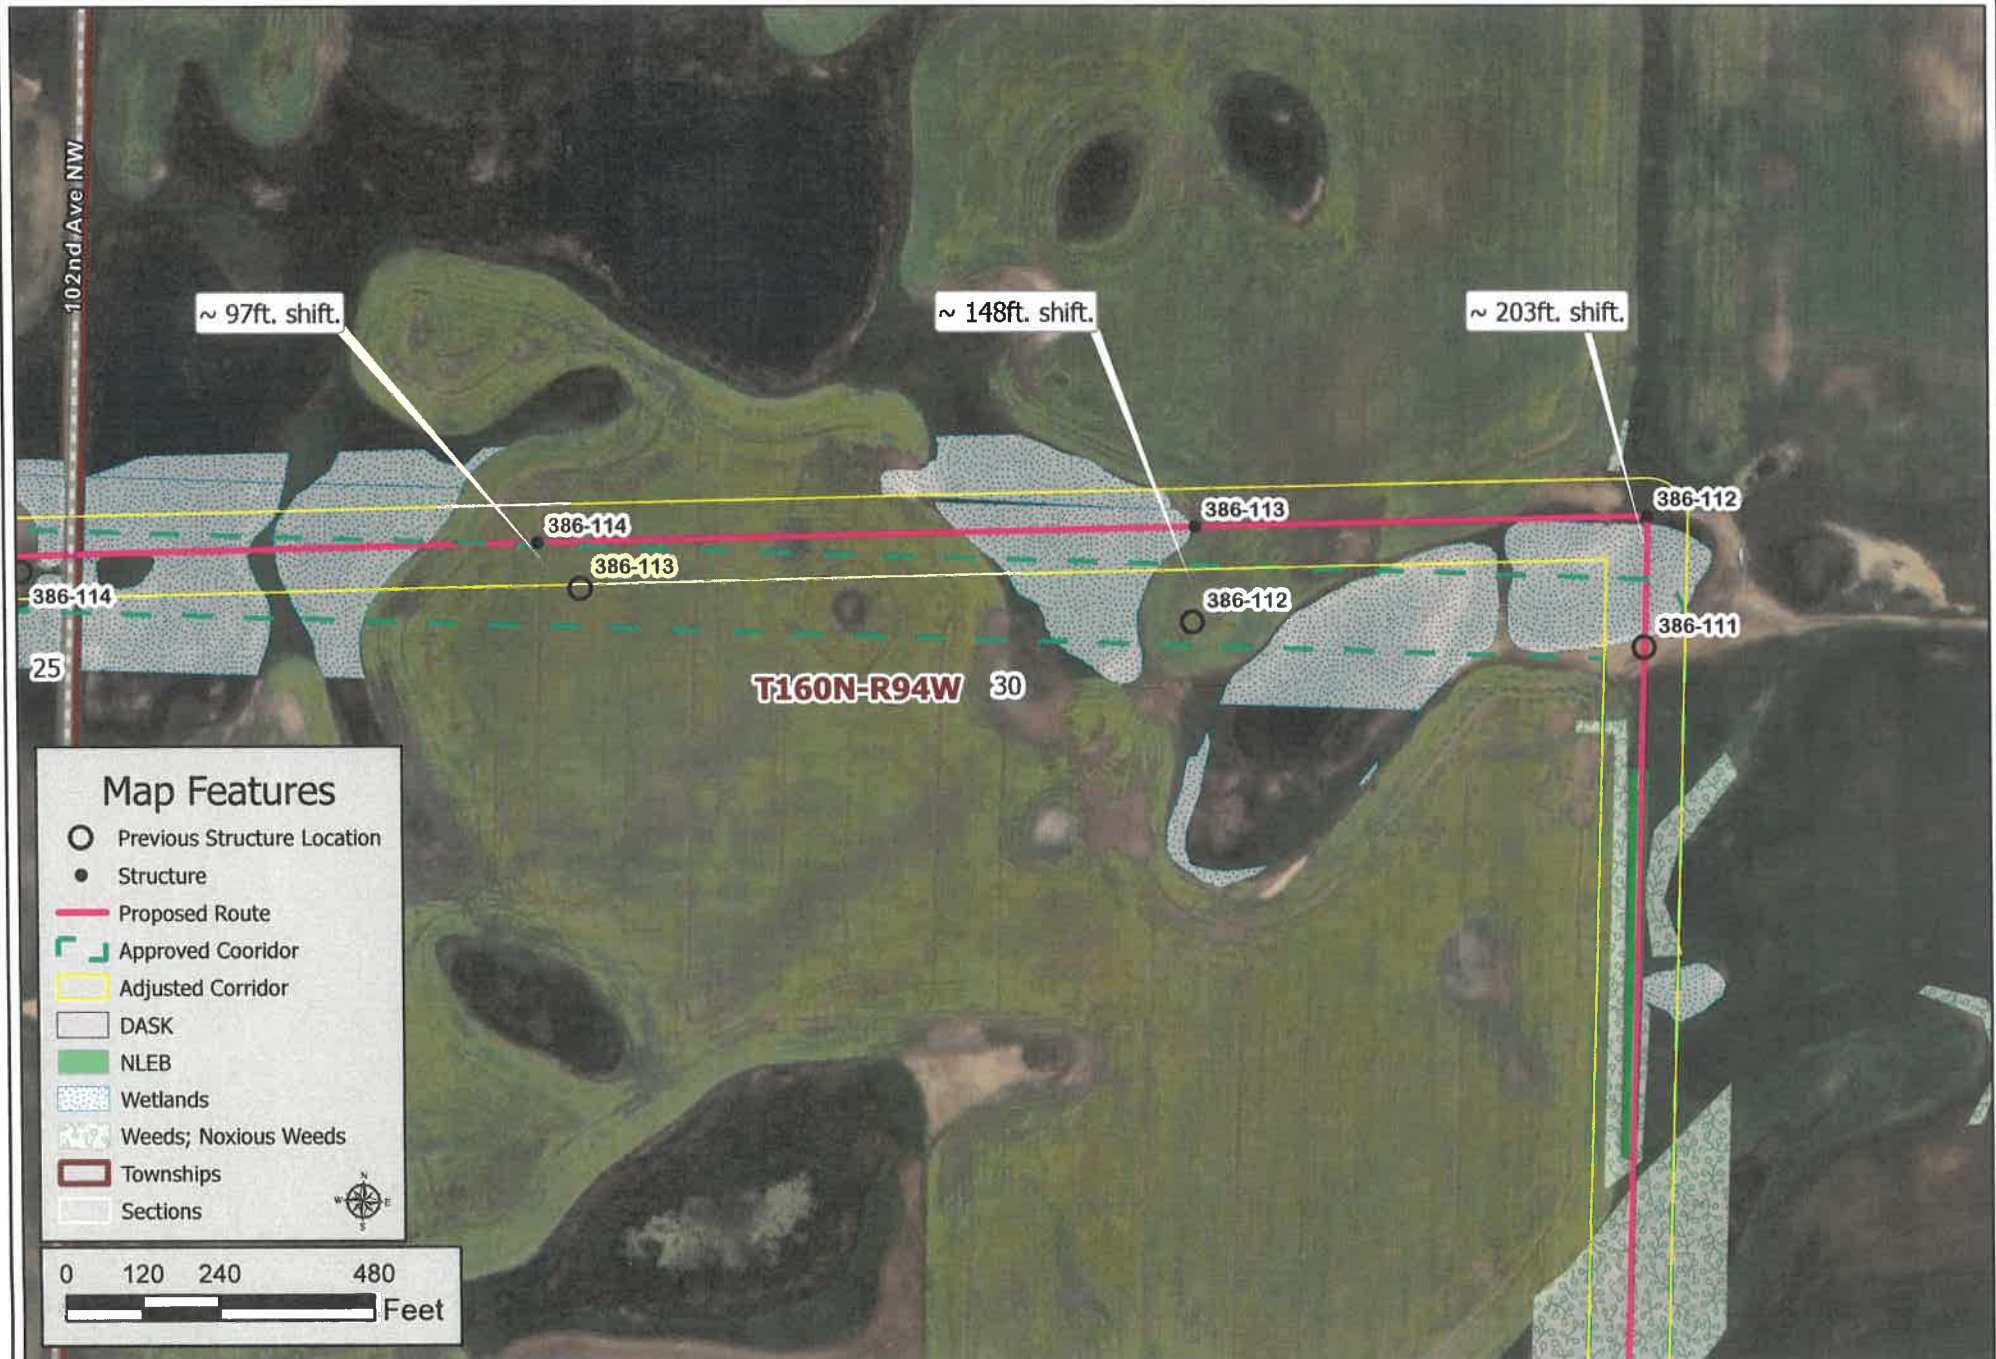

Tande-to-Saskatchewan 230-kV Transmission Project

Update Structure Location: 386-148 thru 386-152

Length of Route Adjustment : 4,998.8ft

Exhibit B



**BASIN ELECTRIC
POWER COOPERATIVE**

A Touchstone Energy® Cooperative

