

Exhibit 4

Route and Corridor Adjustment Maps



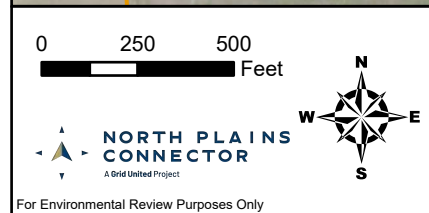


Exhibit 4 **Site Plan Revision – Converter Station Design** **North Plains Connector Project** **Oliver County, North Dakota**

- | | | | |
|---|---|---|--|
| <ul style="list-style-type: none"> ○ Milepost ◇ Structure — HVDC Transmission Line ▭ Project Corridor ▭ Pulling Site | <ul style="list-style-type: none"> ▭ Morton County Converter Station (Exact location to be determined)* Site Plan Revision <ul style="list-style-type: none"> ◇ Revised Structure — Revised Project Route | <ul style="list-style-type: none"> ▭ Revised Project Corridor ▭ Revised Pulling Site Public Lands, Easements, and Recreation ▭ Private Land Open to Sportsmen | <ul style="list-style-type: none"> Water Resources <ul style="list-style-type: none"> ▭ Delineated Wetlands Vegetation Resources <ul style="list-style-type: none"> ▭ Wooded Areas |
|---|---|---|--|

For Environmental Review Purposes Only

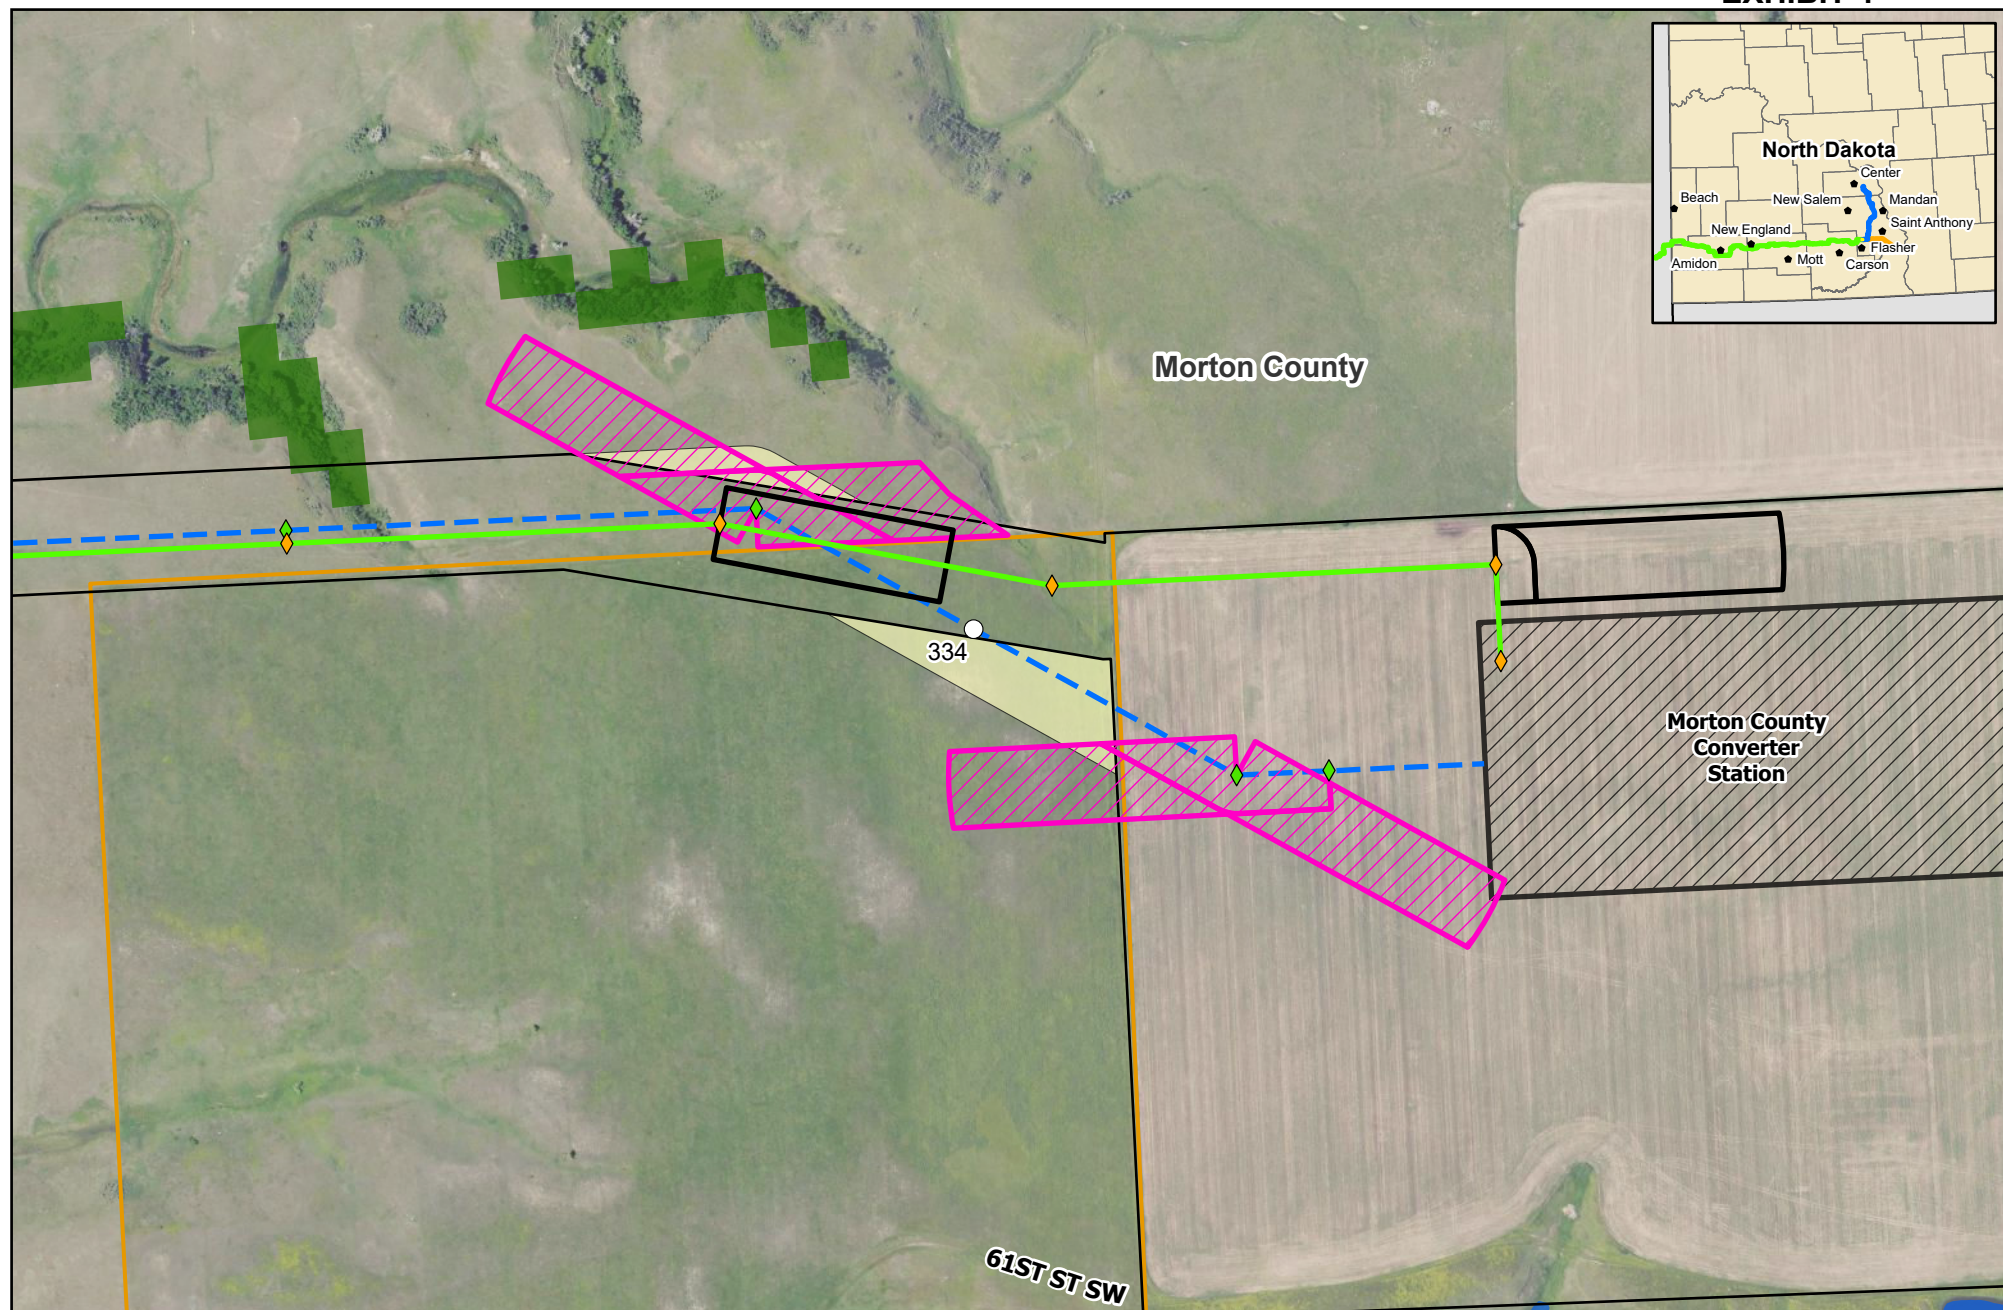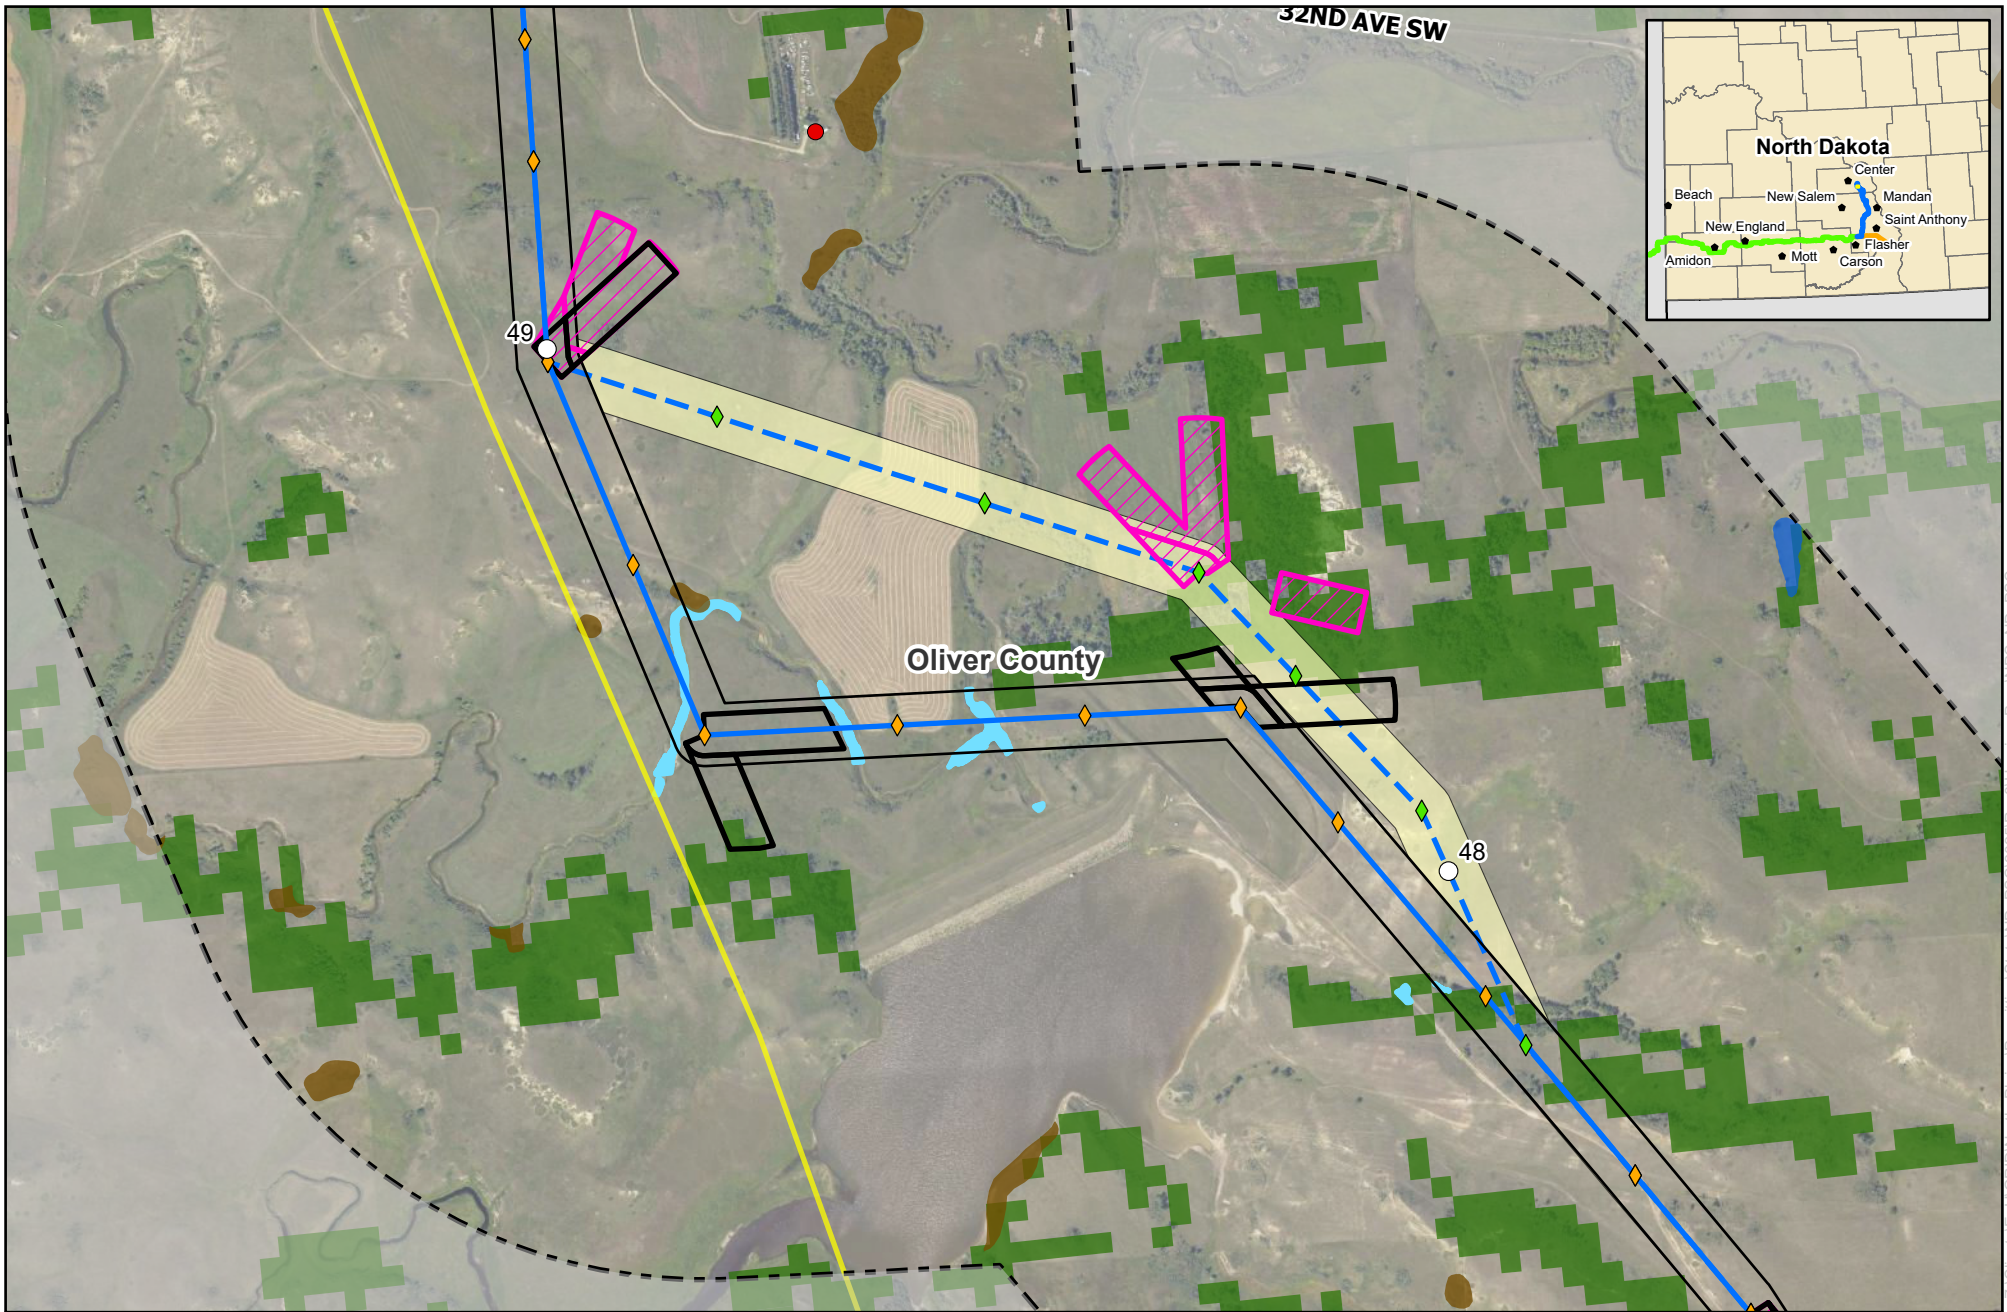

0 500 1,000 Feet



Exhibit 4 **Site Plan Revision - Square Butte 5 Dam** **North Plains Connector Project** **Oliver County, North Dakota**

- | | | | |
|---|--|--|--|
| <ul style="list-style-type: none"> Milepost Structure Oliver Transmission Line Pulling Site Project Corridor Study Area | <ul style="list-style-type: none"> Revised Structure Revised Project Route Revised Project Corridor Revised Pulling Site Residences, Schools, and Places of Business Residence | <ul style="list-style-type: none"> Public Services Existing Transmission Line Geological and Soil Resources Landslide Deposits | <ul style="list-style-type: none"> Water Resources Delineated Waterbody Delineated Wetlands Vegetation Resources Wooded Areas |
|---|--|--|--|