


Exhibit 4

Route and Corridor Adjustment Maps

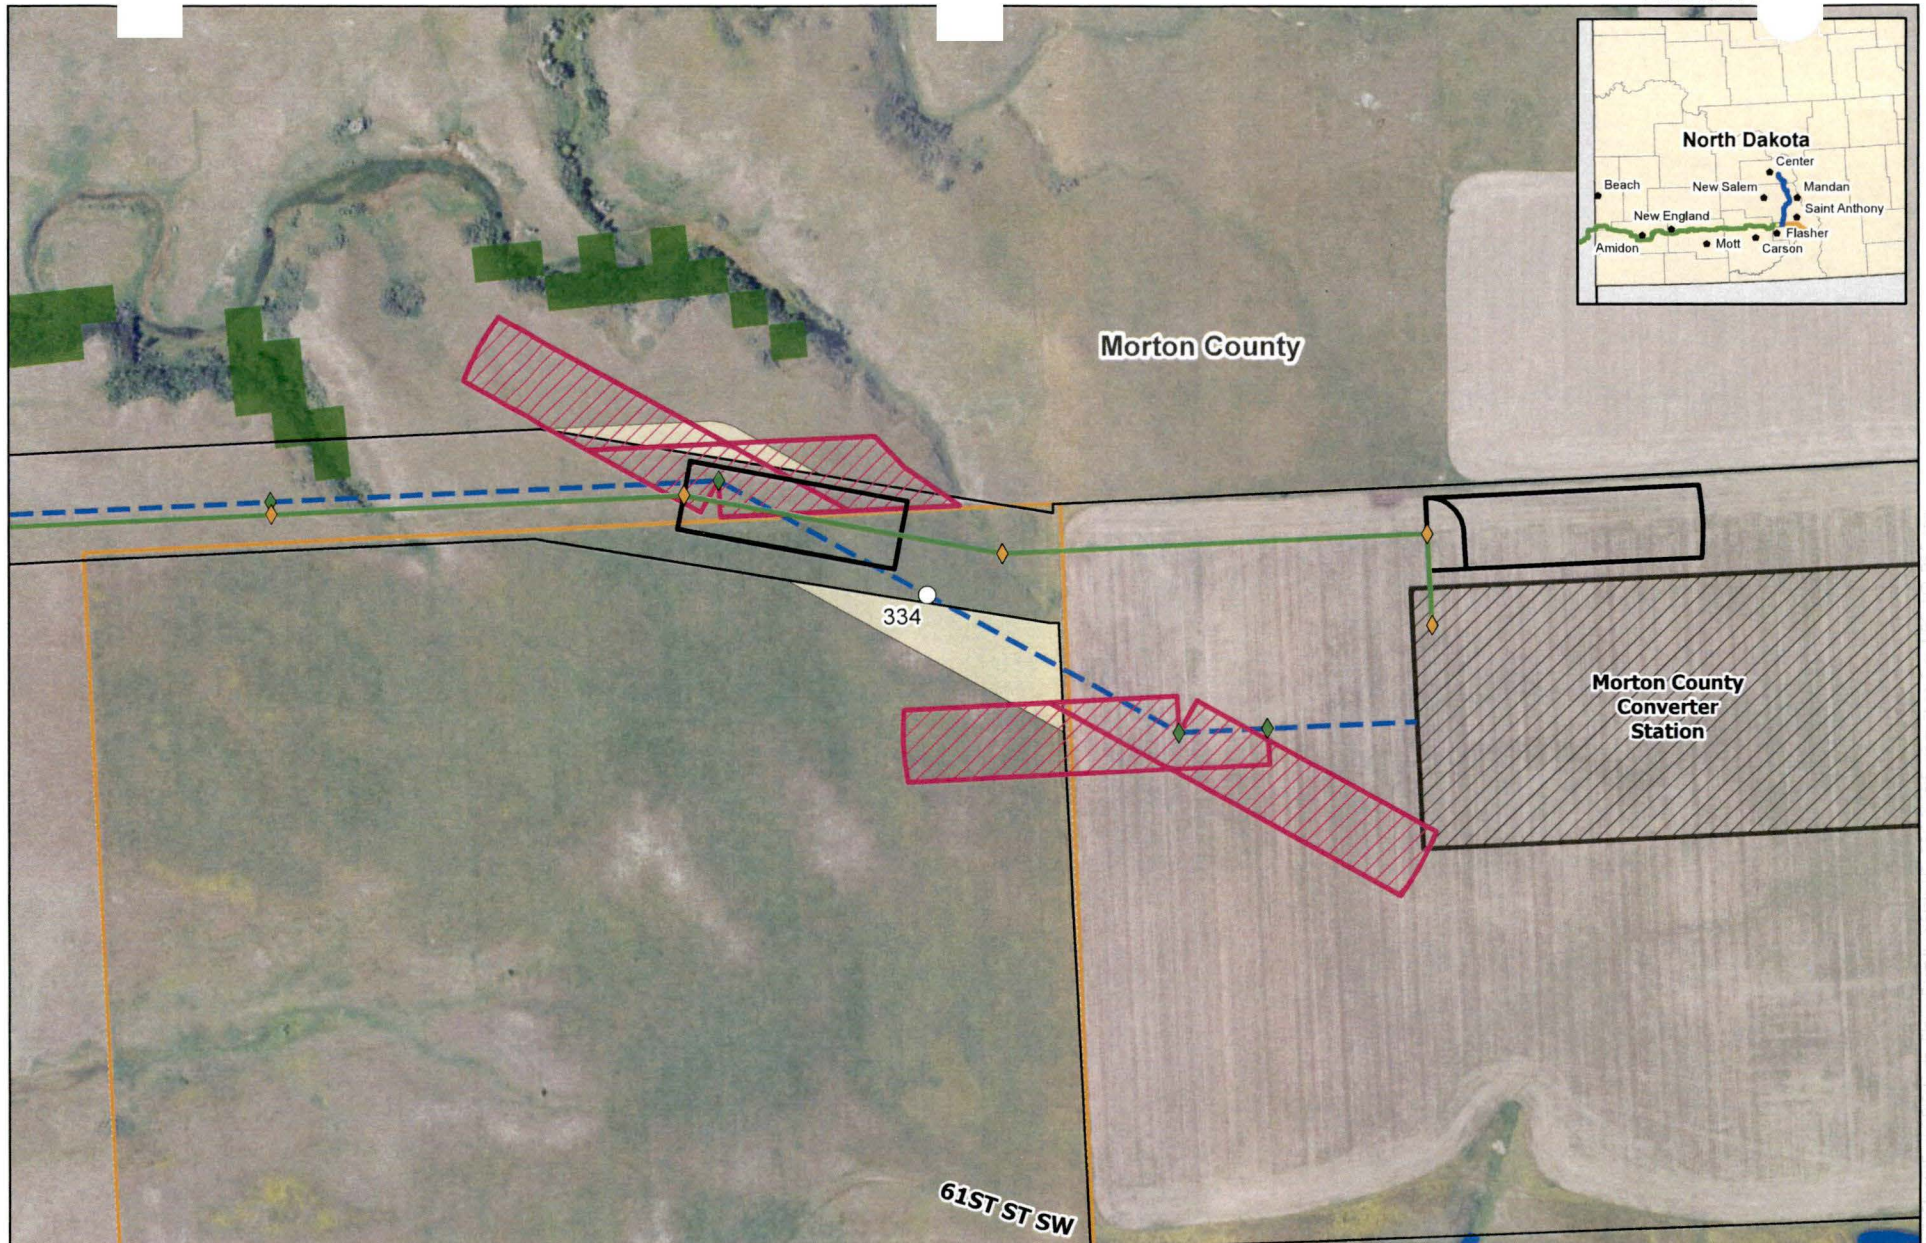

0 250 500 Feet



NORTH PLAINS CONNECTOR
A Braid United Project

For Environmental Review Purposes Only


Exhibit 4

Site Plan Revision – Converter Station Design

North Plains Connector Project


- | | | | |
|---|--|---|--|
| <ul style="list-style-type: none"> ○ Milepost ◇ Structure — HVDC Transmission Line ▭ Project Corridor ▭ Pulling Site | <ul style="list-style-type: none"> Morton County Converter Station (Exact location to be determined)* Site Plan Revision ◇ Revised Structure — Revised Project Route | <ul style="list-style-type: none"> ▭ Revised Project Corridor ▭ Revised Pulling Site Public Lands, Easements, and Recreation ▭ Private Land Open to Sportsmen | <ul style="list-style-type: none"> Water Resources ▭ Delineated Wetlands Vegetation Resources ▭ Wooded Areas |
|---|--|---|--|

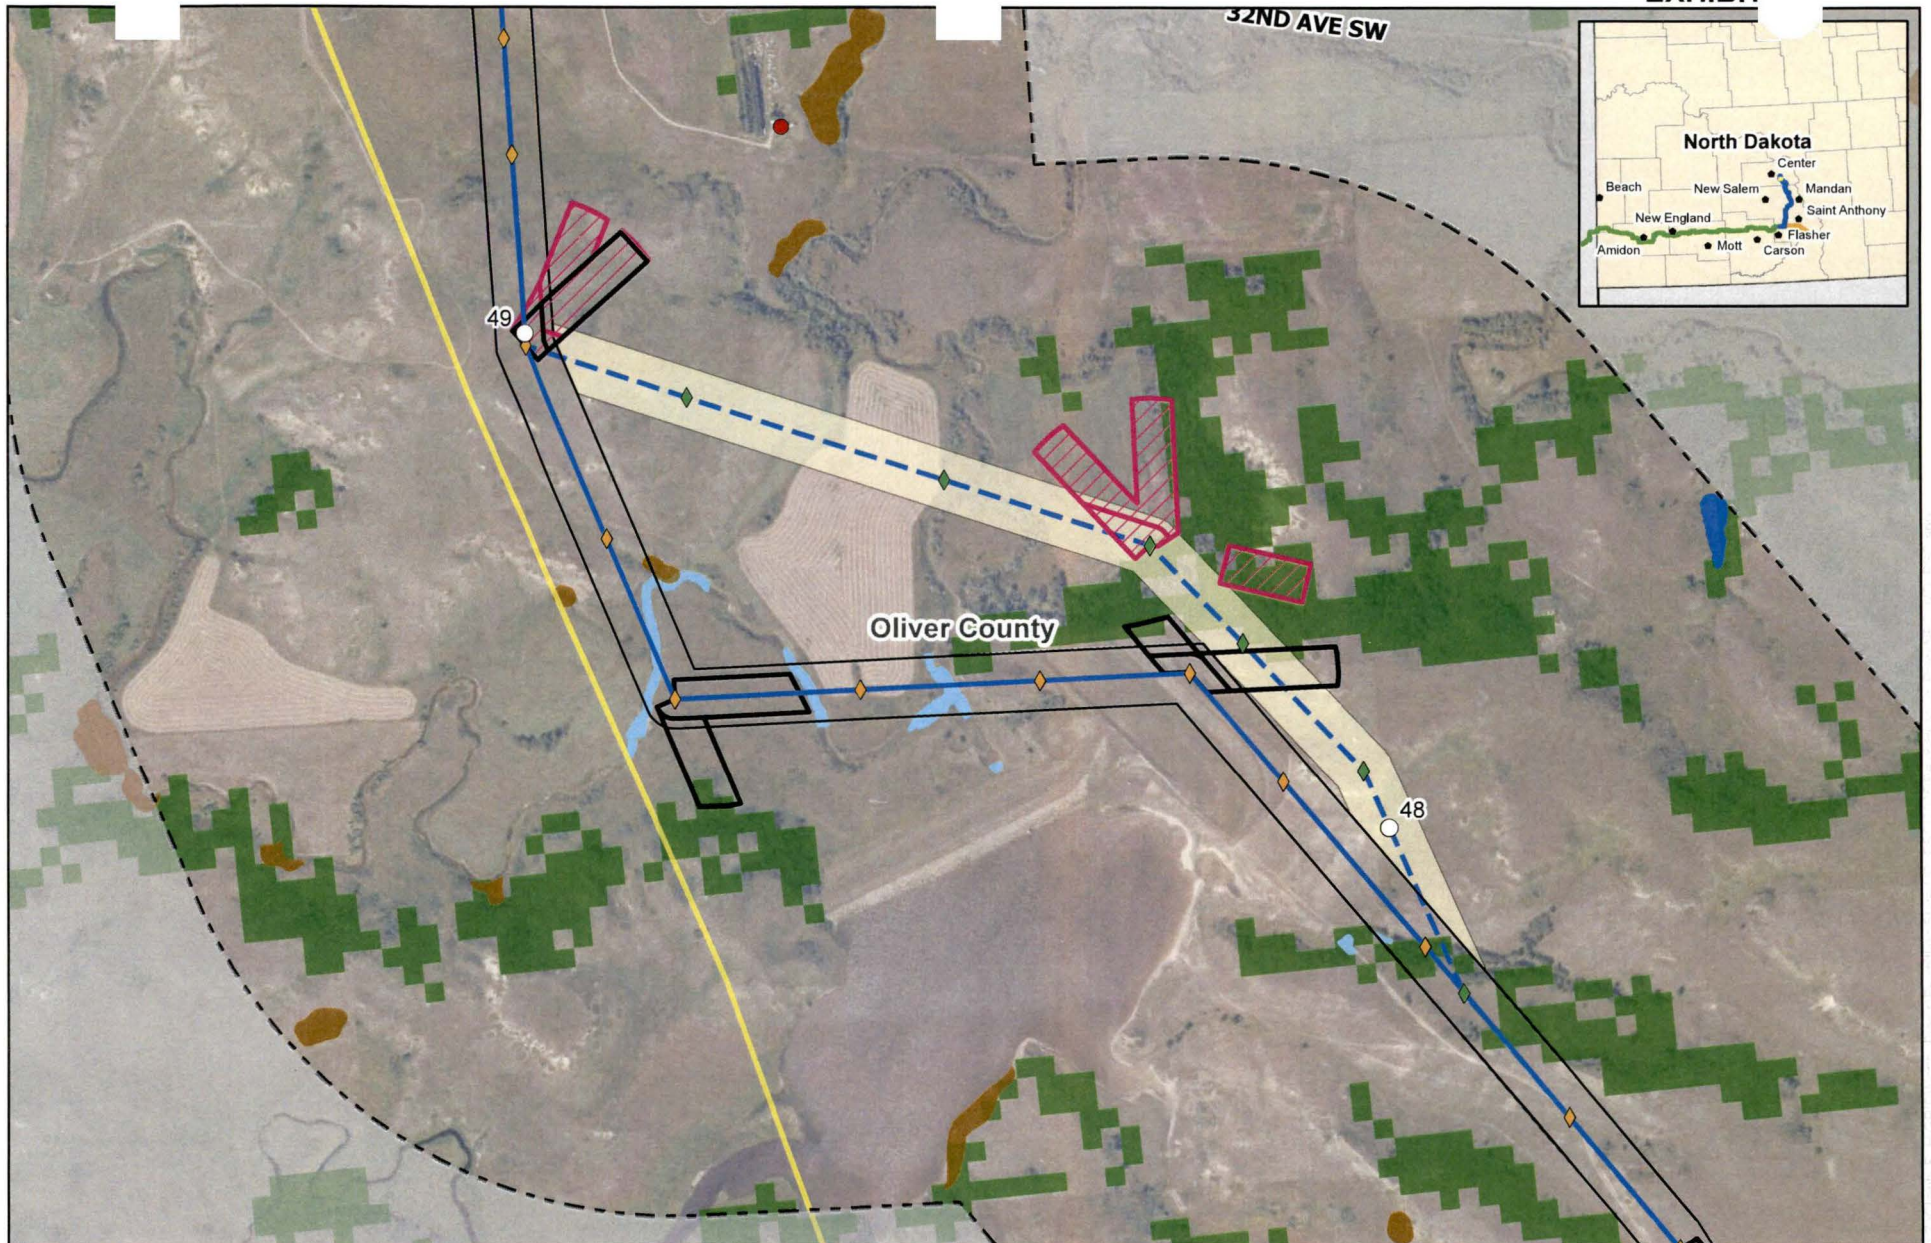

0 500 1,000 Feet

NORTH PLAINS CONNECTOR
A GRID United Project



For Environmental Review Purposes Only

Exhibit 4 **Site Plan Revision - Square Butte 5 Dam** **North Plains Connector Project** **Oliver County, North Dakota**

- | | | | |
|---|---|---|---|
| <ul style="list-style-type: none"> ○ Milepost ◇ Structure — Oliver Transmission Line ▭ Pulling Site ▭ Project Corridor ▭ Study Area | <p>Site Plan Revision</p> <ul style="list-style-type: none"> ◇ Revised Structure — Revised Project Route ▭ Revised Project Corridor ▭ Revised Pulling Site <p>Residences, Schools, and Places of Business</p> <ul style="list-style-type: none"> ● Residence | <p>Public Services</p> <ul style="list-style-type: none"> — Existing Transmission Line <p>Geological and Soil Resources</p> <ul style="list-style-type: none"> ■ Landslide Deposits | <p>Water Resources</p> <ul style="list-style-type: none"> ■ Delineated Waterbody ■ Delineated Wetlands <p>Vegetation Resources</p> <ul style="list-style-type: none"> ■ Wooded Areas |
|---|---|---|---|