

Johnson, Monty L.

From: Frye, Jason J <jason.frye@nacoal.com>
Sent: Thursday, October 8, 2026 11:42 AM
To: Johnson, Monty L.
Subject: Re: Falkirk Mine\Permits\NAFK - 9503\Revisions\No. 41

***** **CAUTION:** This email originated from an outside source. Do not click links or open attachments unless you know they are safe. *****

Ok, will do. Thanks for catching that.


Jason

Sent via the Samsung Galaxy S23 5G, an AT&T 5G smartphone
Get [Outlook for Android](#)

From: Johnson, Monty L. <moljohnson@nd.gov>
Sent: Thursday, 08 October 2026 09:35:01
To: Frye, Jason J <jason.frye@nacoal.com>
Cc: Burke, Stephen J <steve.burke@nacoal.com>; Voigt, Tara J <tara.voigt@nacoal.com>; Emmer, Jonathan W. <jemmer@nd.gov>; Ripplinger, Preston <prippinger@nd.gov>; Myran, Brandon S. <bmyran@nd.gov>; Roerick, Jeffrey A. <jroerick@nd.gov>; Swenson, Warren <swensonwarren@nd.gov>; DeVries, Taylor L. <taldevries@nd.gov>; Craig, Alexis <alcraig@nd.gov>; Welch, Guy A. <gwelch@nd.gov>
Subject: RE: Falkirk Mine\Permits\NAFK - 9503\Revisions\No. 41

Jason,

I just noticed that the “Topo From Approved Regrade” map layer is obscuring the section lines and number labels on Section 4.2.6b (Post-Mining Contour Map). Please make the required edits to the map when addressing our deficiency Item No. 17.

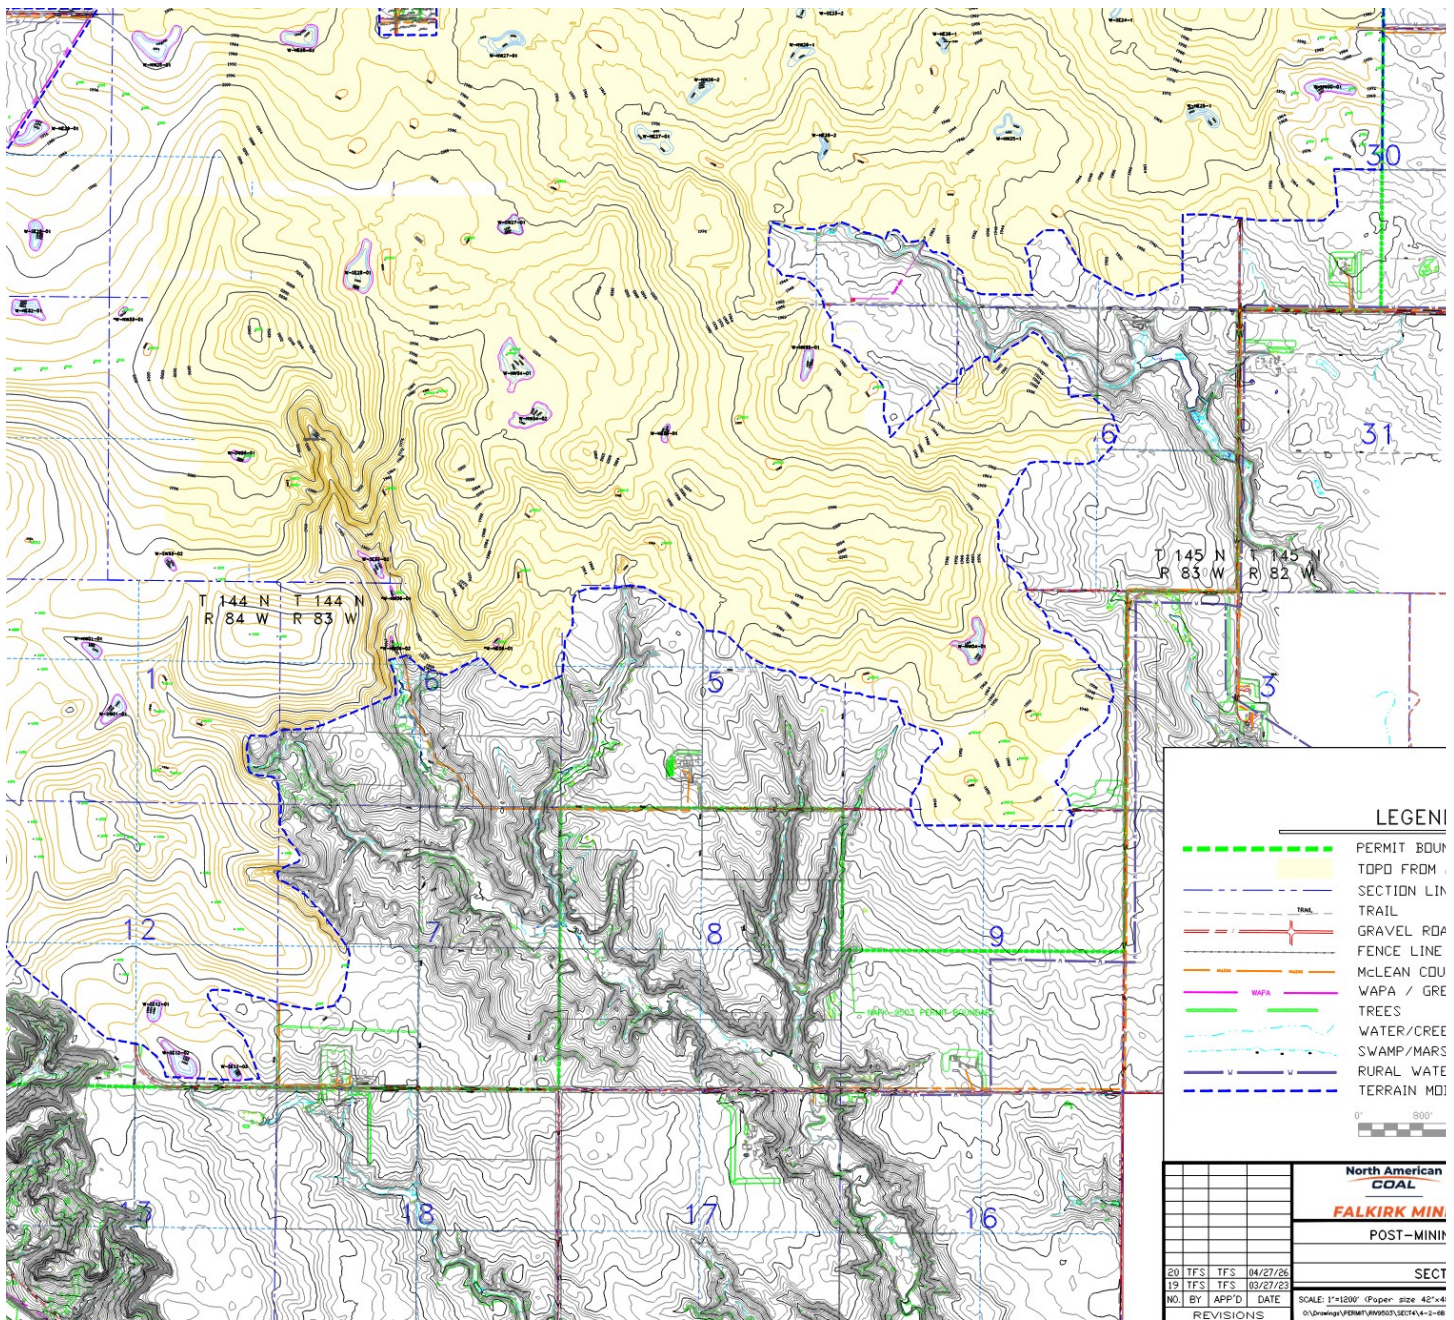

Thanks,

Monty Johnson
Assistant Director
 NDPSC - Reclamation Division
 Email: moljohnson@nd.gov
 Phone: 701-328-4035
 600 E Boulevard Ave, Dept. 408
 Bismarck, ND 58505

This transmission, email and any files transmitted with it, may be: (1) subject to the Attorney-Client Privilege, (2) an attorney work product, or (3) strictly confidential under federal or state law. If you are not the intended recipient of this message, you may not use, disclose, print, copy or disseminate this information. If you have received this transmission in error, notify the sender (only) and delete the message. This message may also be subject to disclosure under the North Dakota Open Records Laws.

From: Aslakson, Christine M. <cmaslakson@nd.gov>

Sent: Wednesday, October 7, 2026 1:06 PM


To: Jason Frye <jason.frye@nacoal.com>

Cc: Steve Burke <steve.burke@nacoal.com>; Tara Voigt <tara.voigt@nacoal.com>; Emmer, Jonathan W. <jemmer@nd.gov>; Johnson, Monty L. <moljohnson@nd.gov>; Ripplinger, Preston <priplinger@nd.gov>; Myran, Brandon S. <bmyran@nd.gov>; Roerick, Jeffrey A. <jroerick@nd.gov>; Swenson, Warren <swensonwarren@nd.gov>; DeVries, Taylor L. <taldevries@nd.gov>; Craig, Alexis <alcraig@nd.gov>; Welch, Guy A. <gwelch@nd.gov>

Subject: Falkirk Mine\Permits\NAFK - 9503\Revisions\No. 41

Christine Aslakson

Administrative Assistant
North Dakota Public Service Commission
600 E Boulevard Ave, Dept. 408
Bismarck, ND 58505-0480
(701) 328-7875
cmaslakson@nd.gov

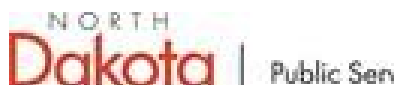

This transmission, email and any files transmitted with it, may be: (1) subject to the Attorney-Client Privilege, (2) an attorney work product, or (3) strictly confidential under federal or state law. If you are not the intended recipient of this message, you may not use, disclose, print, copy or disseminate this information. If you have received this transmission in error, notify the sender (only) and delete the message. This message may also be subject to disclosure under the North Dakota Open Records Laws.

NOTICE: If you have received this communication in error, please advise the sender by reply e-mail and immediately delete the message and any attachments without copying or disclosing the contents.